



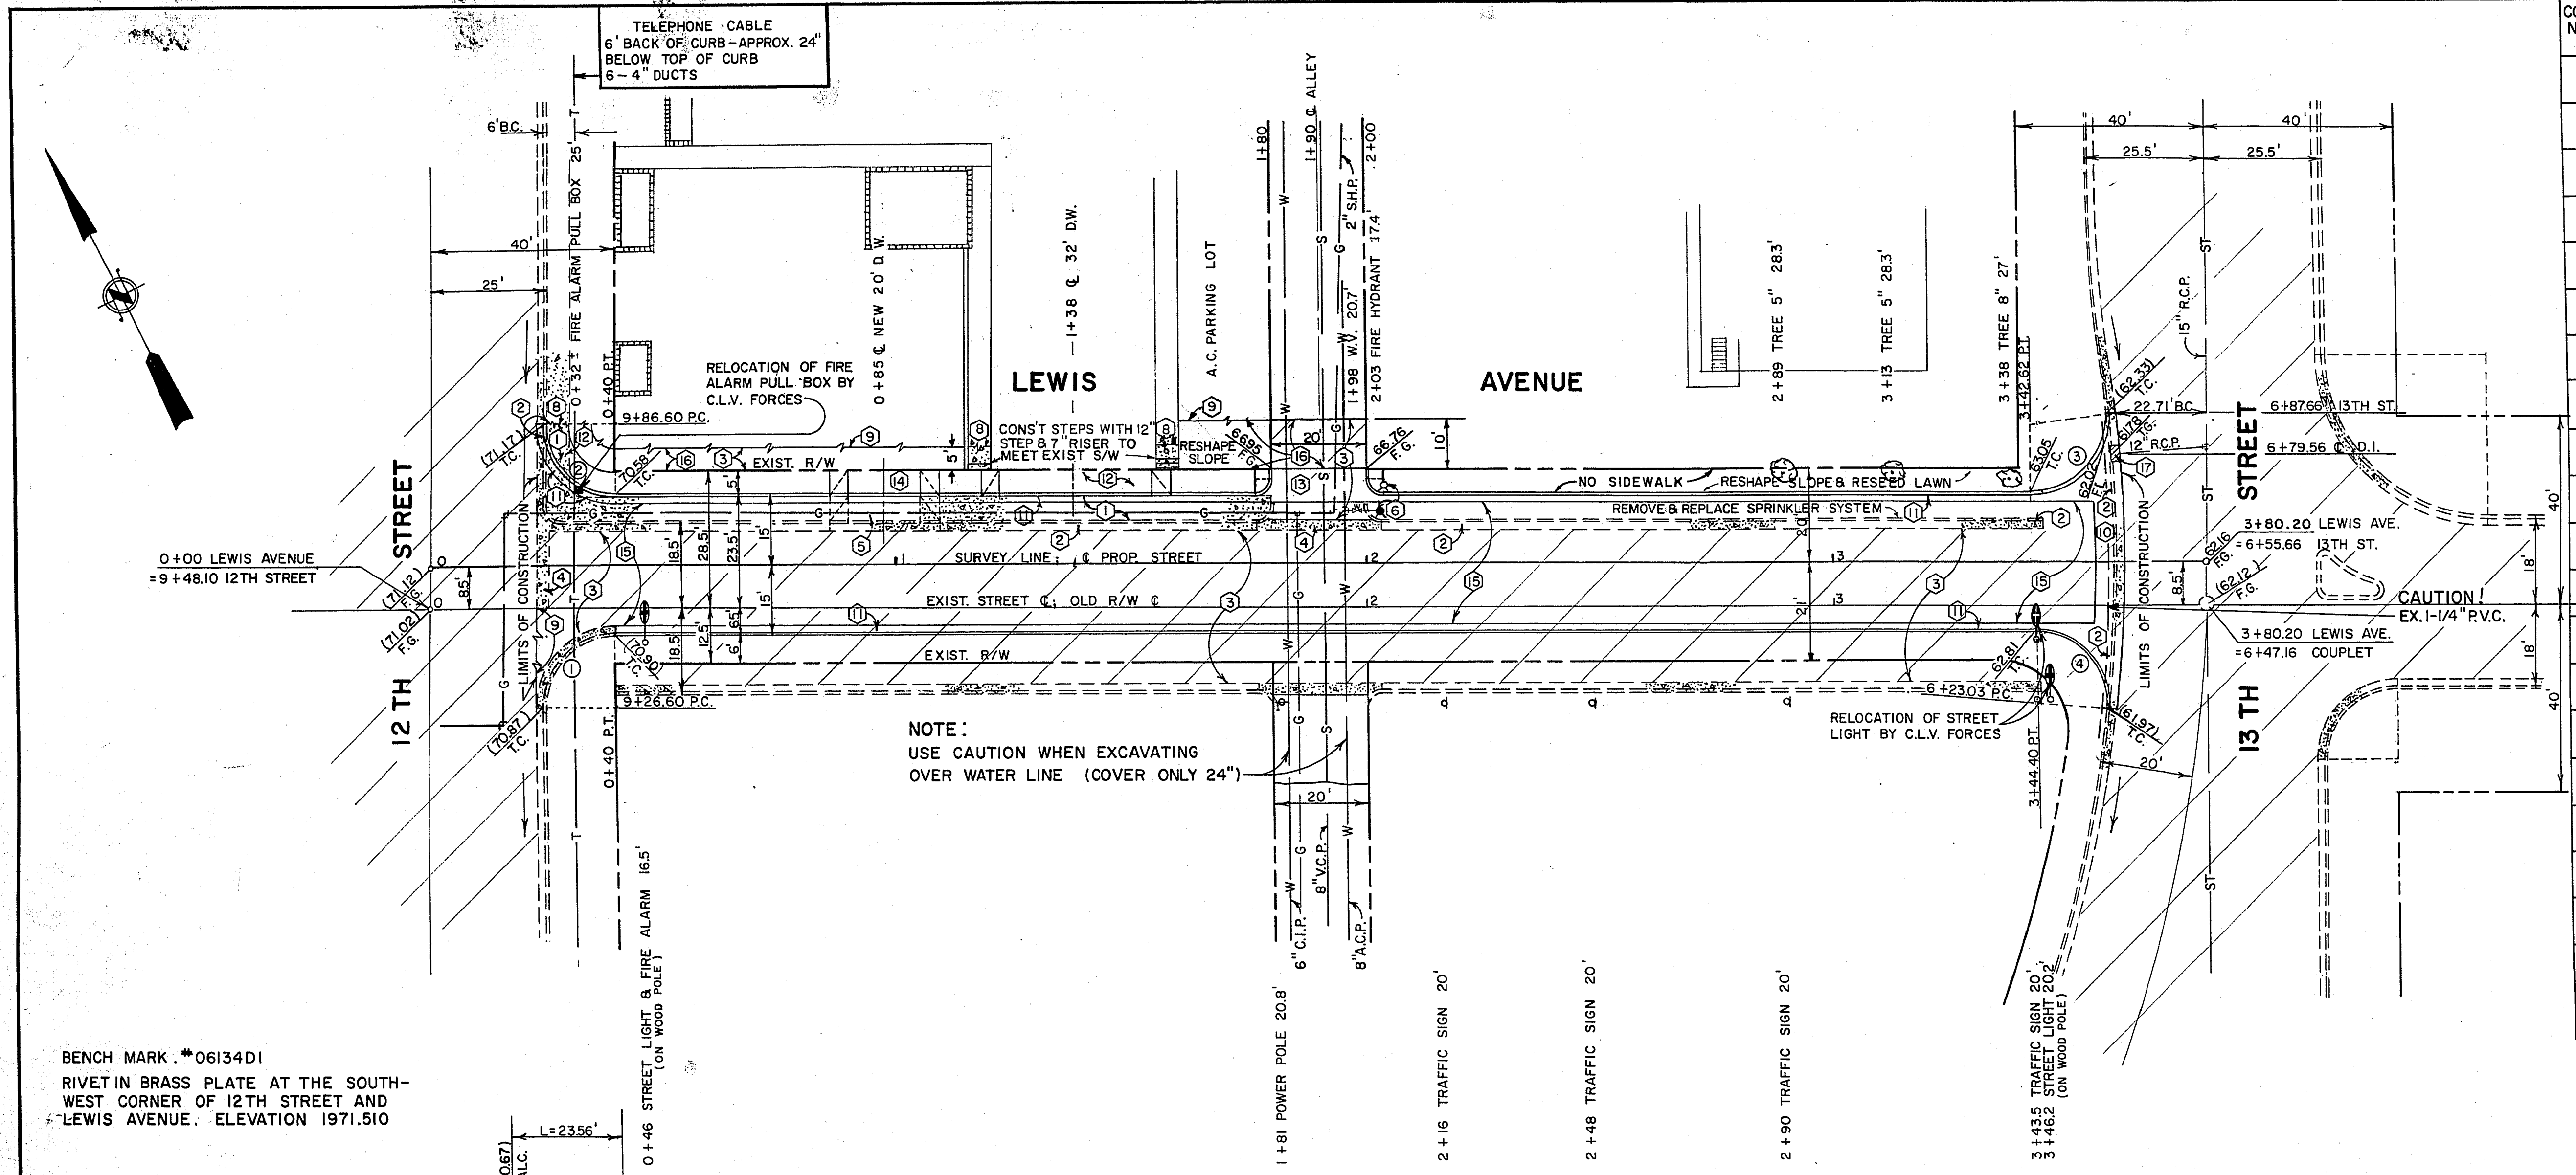

CONST. NOTE NO.	APPROXIMATE QUANTITIES - THIS SHEET			
	ITEM	DESCRIPTION	UNIT	QUANTITY
	201.100	EXCAVATION	C.Y.	697
①	200.110	REMOVE CONC. SIDEWALK	S.F.	788
②	200.110	REMOVE CONC. CURB & GUTTER	L.F.	367
③	201.100	REMOVE ASPHALT PAVEMENT	S.Y.	1374
④	200.110	REMOVE CONC. ALLEY GUTTER	S.F.	120
⑤	200.110	REMOVE CONC. DRIVEWAY	S.F.	165
⑥	560080	RELOCATE FIRE HYDRANT	EA.	1
⑧	200.110	SAWCUT CONCRETE SIDEWALK	L.F.	115
⑨	201.100	SAWCUT ASPHALT PAVEMENT	L.F.	97
⑩	340.319	CONST. CONC. VALLEY GUTTER 6'	S.F.	436
⑪	340.014	CONST. "L" TYPE CURB & GUTTER	L.F.	580
⑫	340.114	CONST. CONC. SIDEWALK & STEPS	S.F.	735
⑬	340.326	CONST. CONC. ALLEY GUTTER	S.F.	189
⑭	340.226	CONST. CONC. COMM. DRIVEWAY	S.F.	165
⑮	334.004	CONST. 2" ASPHALT PAVEMENT	S.Y.	976
⑯	334.003	CONST. 1-1/2" ASPHALT PAVEMENT	S.Y.	65
⑰	500201	MODIFY DROP INLET	EA.	1
⑱	302.200	TYPE II GRAVEL	C.Y.	134
⑲	302.100	TYPE I GRAVEL	C.Y.	300

BENCH MARK. *06134D1
RIVET IN BRASS PLATE AT THE SOUTH-
WEST CORNER OF 12TH STREET AND
LEWIS AVENUE. ELEVATION 1971.510

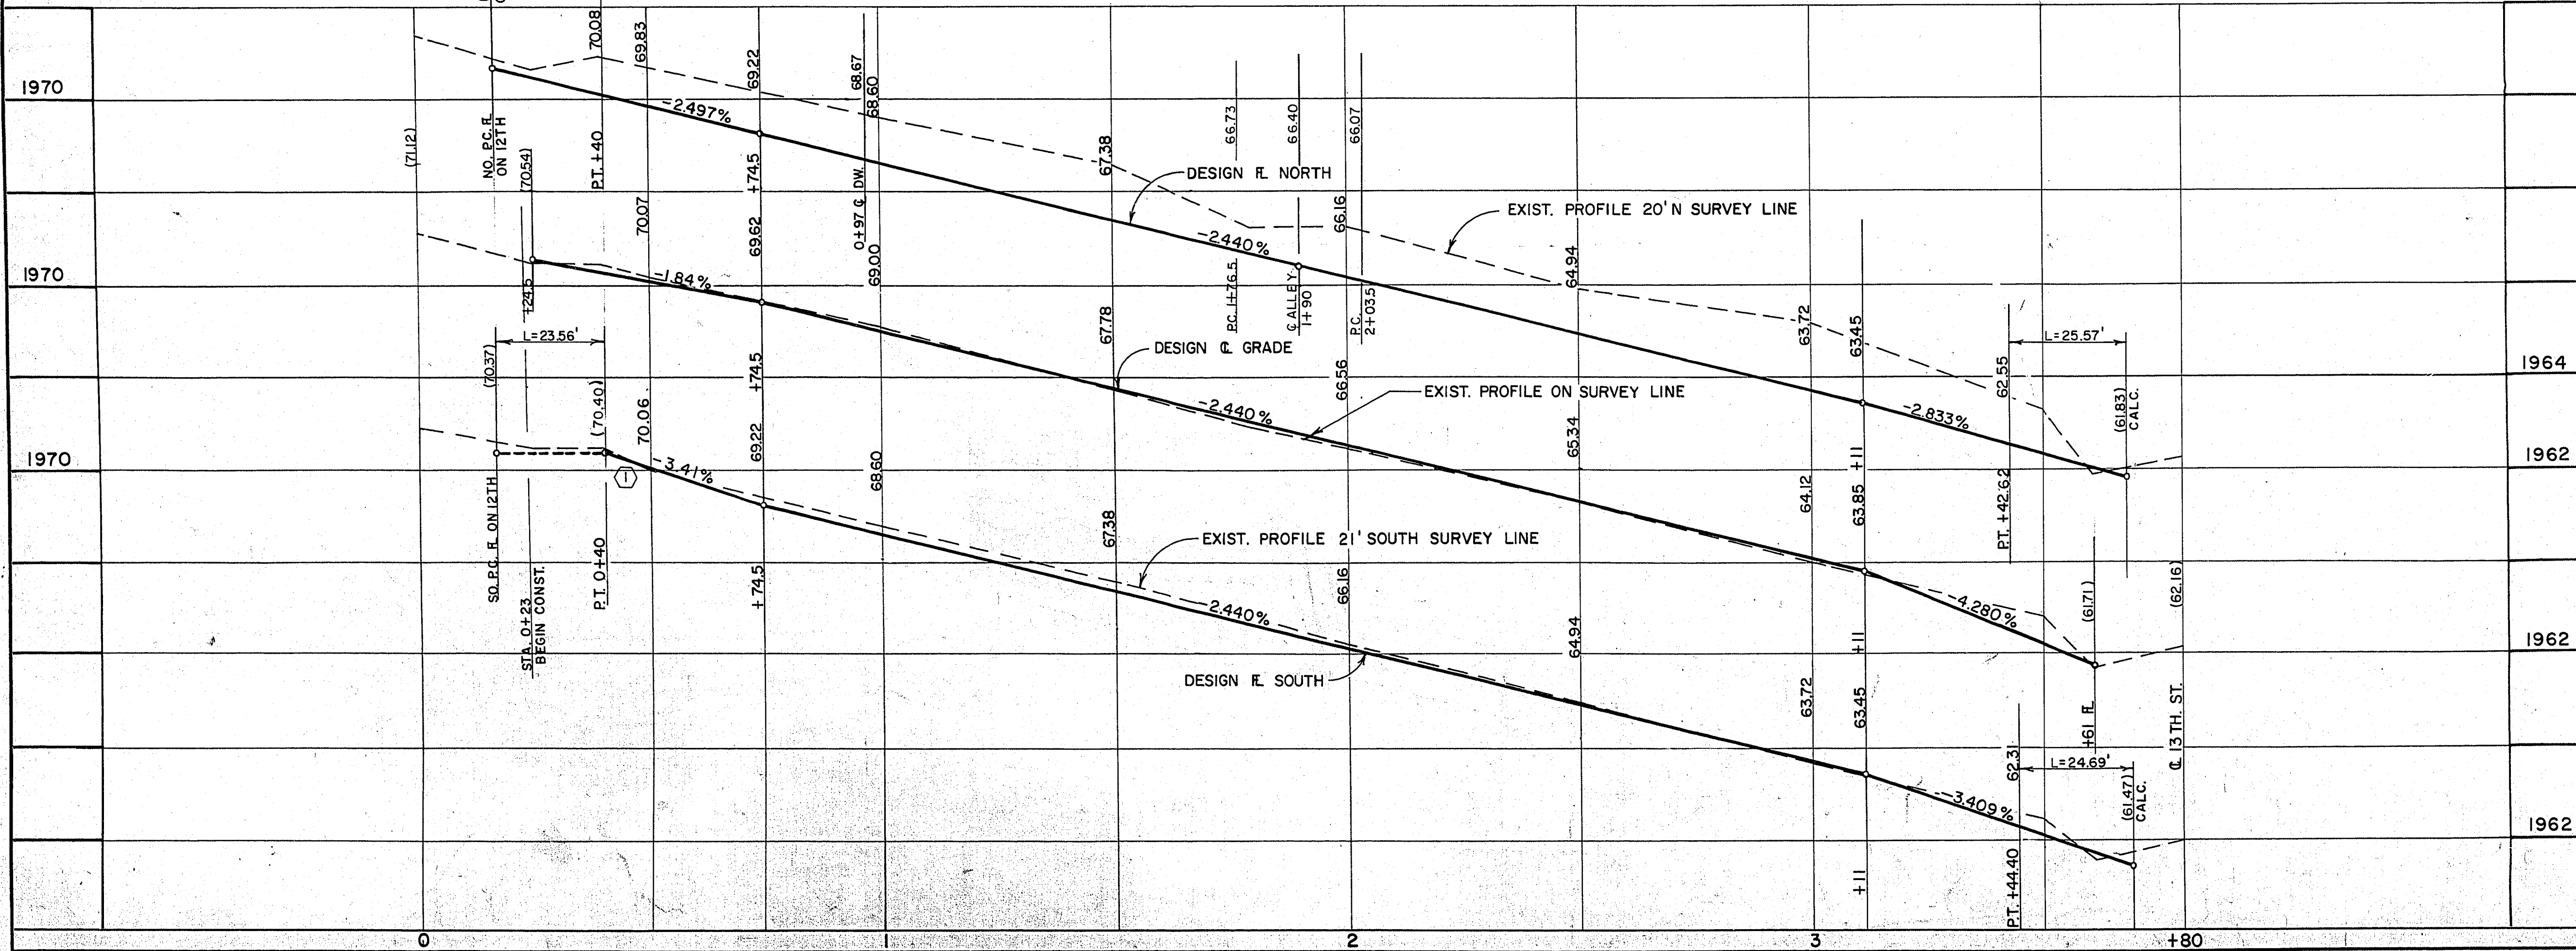

CURVE DATA AT BACK OF CURVE				
NO.	Δ	L	T	R
①	90°00'00"	23.56'	15.00'	15.00'
②	90°00'00"	23.56'	15.00'	15.00'
③	97°39'13"	25.57'	17.15'	15.00'
④	94°15'55"	24.69'	16.16'	15.00'

I CERTIFY THAT THIS PLAN
WAS PREPARED UNDER MY
SUPERVISION.

James J. Bassler
JAMES J. BASSELER
R.P.E. 1684
DATE: 3-17-70

AS BUILT

CONTRACT
DRAWING
APR 3 1970

REVISIONS				
REVISION NO.	DESCRIPTION	BY	DATE	APPROVAL
①	CHANGED GRADE & ELEV. S.E. COR. 12TH & LEWIS	M.P.	5/19/70	<i>Hubb</i>

CITY OF LAS VEGAS NEVADA
DEPARTMENT OF PUBLIC WORKS
SERVICES DIVISION

LEWIS AVENUE 12TH STREET
TO 13TH STREET

W.O. NO. 3041	F.B.K. NO. 63-18X 66-7X	DATE	DRAWING NO.
SC. (H) 1" = 20'	SC. (V) 1" = 2'		107 V 809
DES. W. JAUBERT	NOV. 1969	FILE NO.	
DR. H. FRAZIER			
APPROVED BY DIRECTOR OF PUBLIC WORKS	MAR 26 1970		

SHEET 3 OF 3