
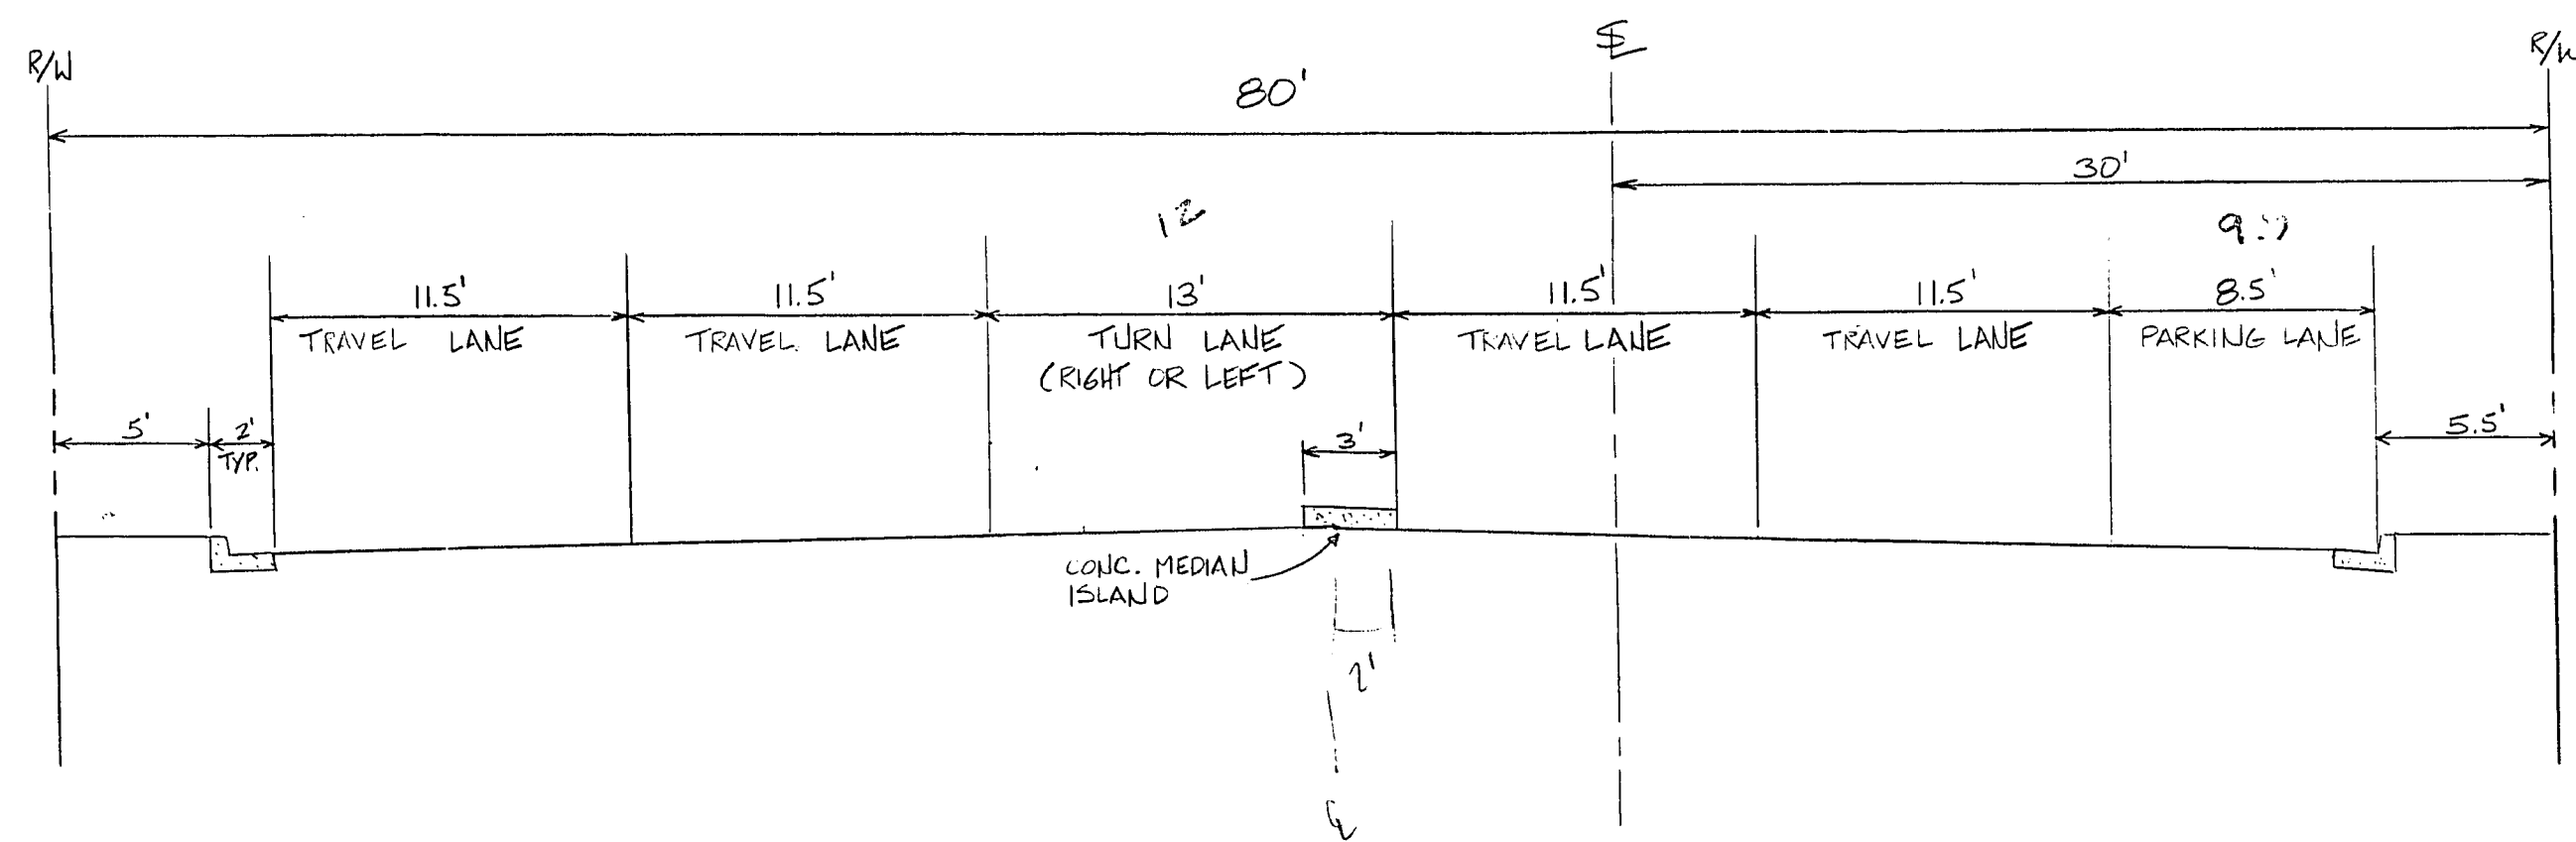


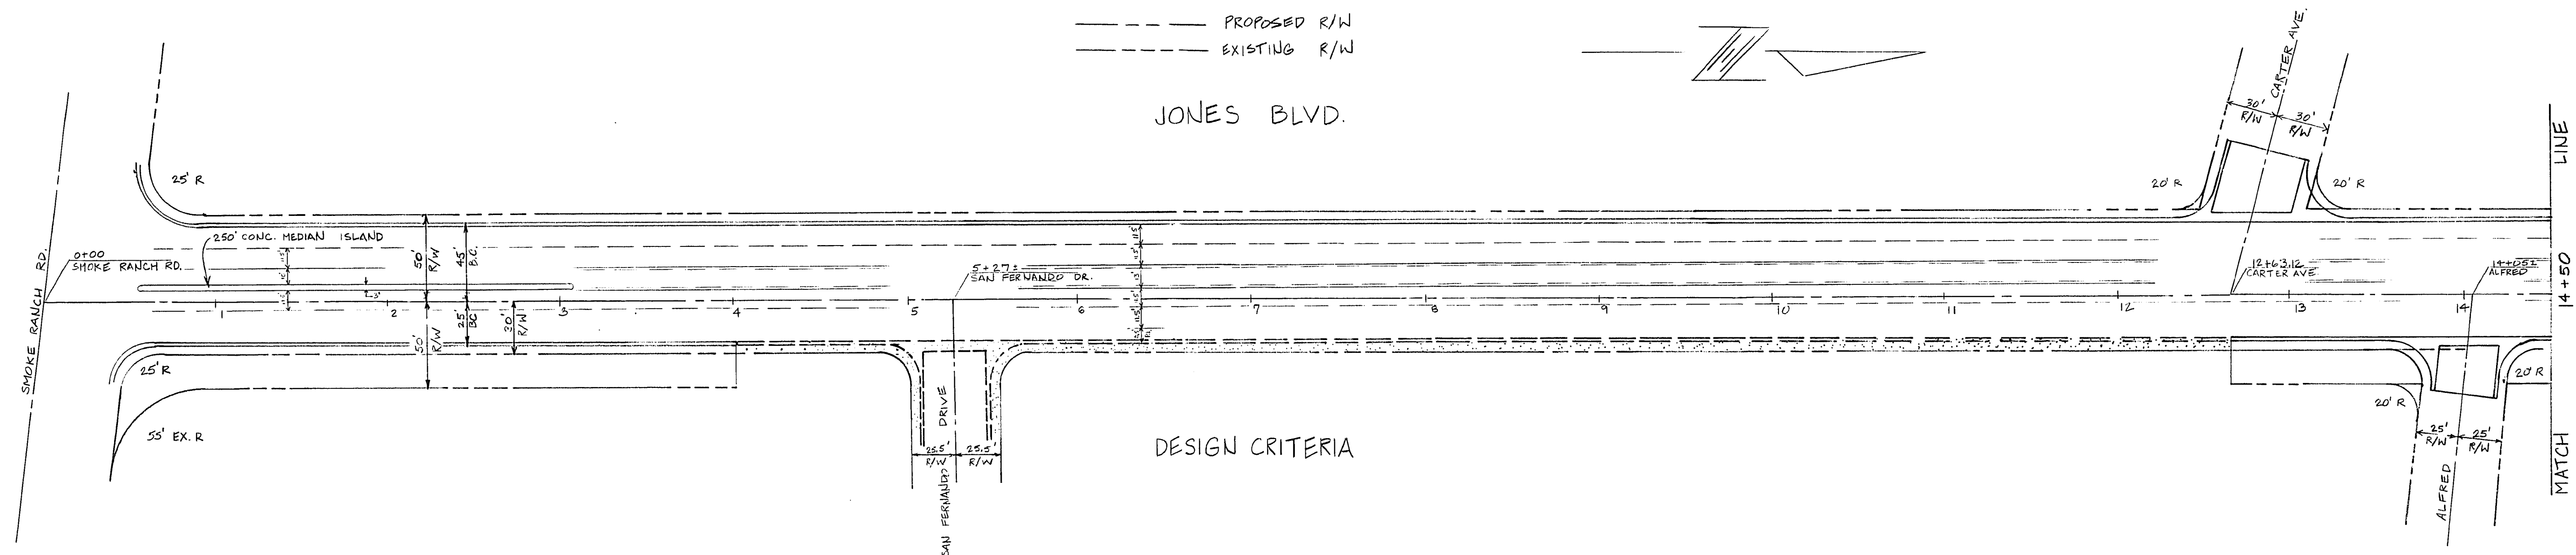

TRAFFIC DELINEATION
SCALE: 1"=6'-0"

DESIGN CRITERIA

APPROVAL
ASSIST. SUPERVISOR ENGINEERING DESIGN
James M. Hansen
DATE
6-28-93

Department of Public Services Engineering Design Division		Scale (H) 1" = 50'	Scale (V) —	W.A.
		Fid. bk. no.	Date JULIE 83	
JONES BLVD. SMOKE RANCH RD. - RANCHO RD.		Design by C. KREHNLOVI, U.S. Drawn by N. STONE L.H.		
		Approved by the _____ Date _____		
Drawing no. 107V-948B		Revisions _____ Date _____		