


**PROFILE**  
 SCALE: HORIZ. 1"=30'  
 VERT. 1"=3'

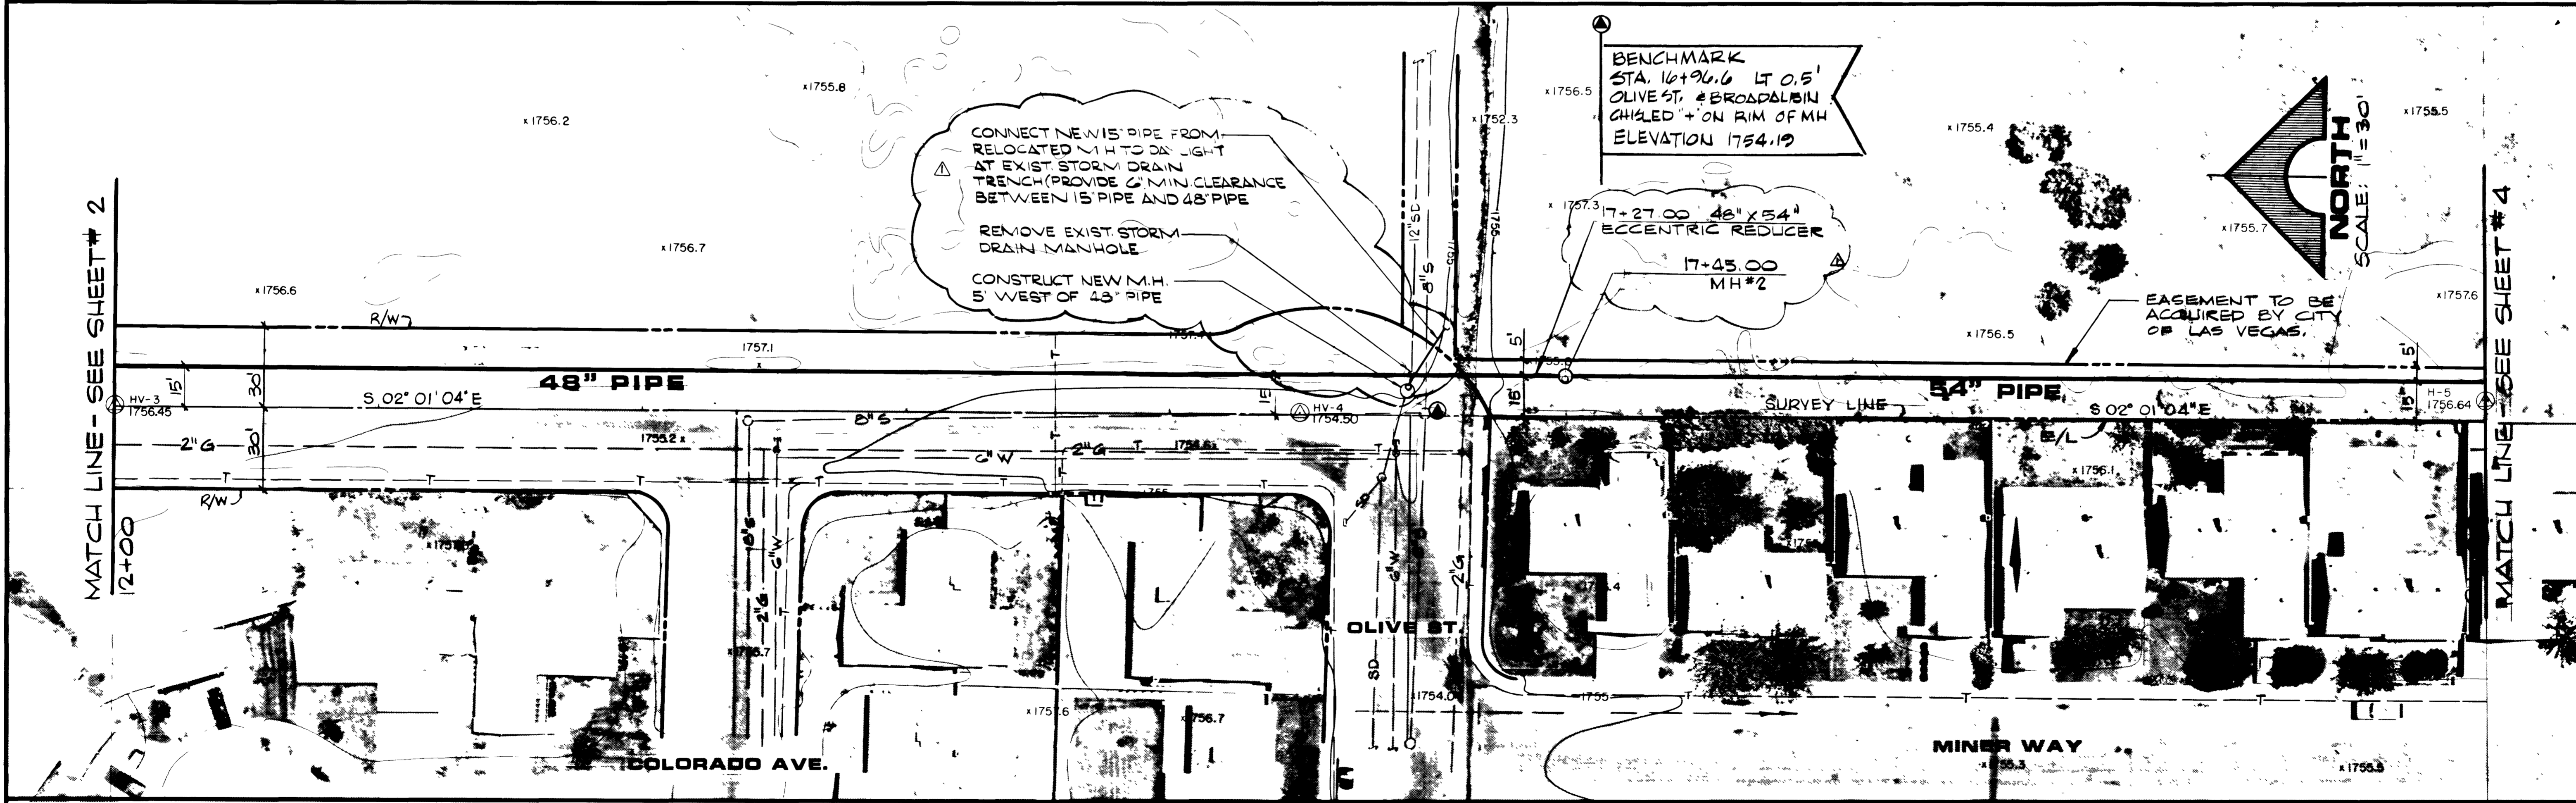

**BROADALBIN DRIVE**

RECORD DRAWING  
 307-V602

RECOMMENDED	REVISION	DATE	DESCRIPTION
	1	12/28/97	RECORD DRAWING
	2	12/21/97	REVISED
	3	12/21/97	REVISED

**G. C. WALLACÉ**  
 Consulting Engineers, Inc.  
 1100 East Sahara Ave. • Las Vegas, Nevada 89104 • 752-3300



DEPARTMENT OF ENGINEERING SERVICES  
 LAMB BLVD. RELIEF SEWER  
 PLAN & PROFILE 12+00 TO 21+00

SHEET  
**3**  
 OF 13 SHEETS

JOB NO. 412.200

C.A.N. 050484

03-1-98

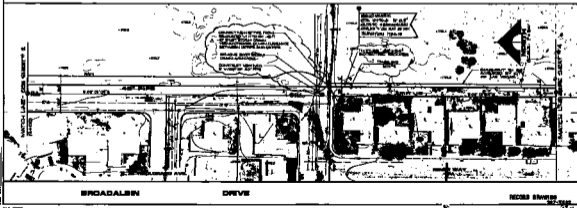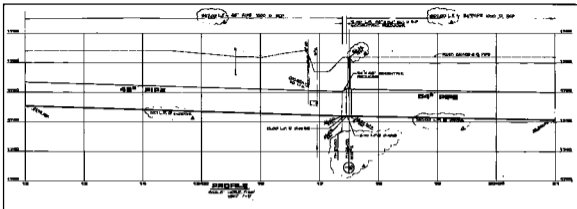

G. C. WALLACE  
 Consulting Engineers, Inc.  
 1000 PLYMOUTH BUILDING  
 PLAINFIELD, NEW JERSEY

3