


900.00 L.F. ~ 54" PIPE


203.00 L.F. ~ 54" 1250 D RCP

697.00 L.F. ~ 54" 1100 D RCP

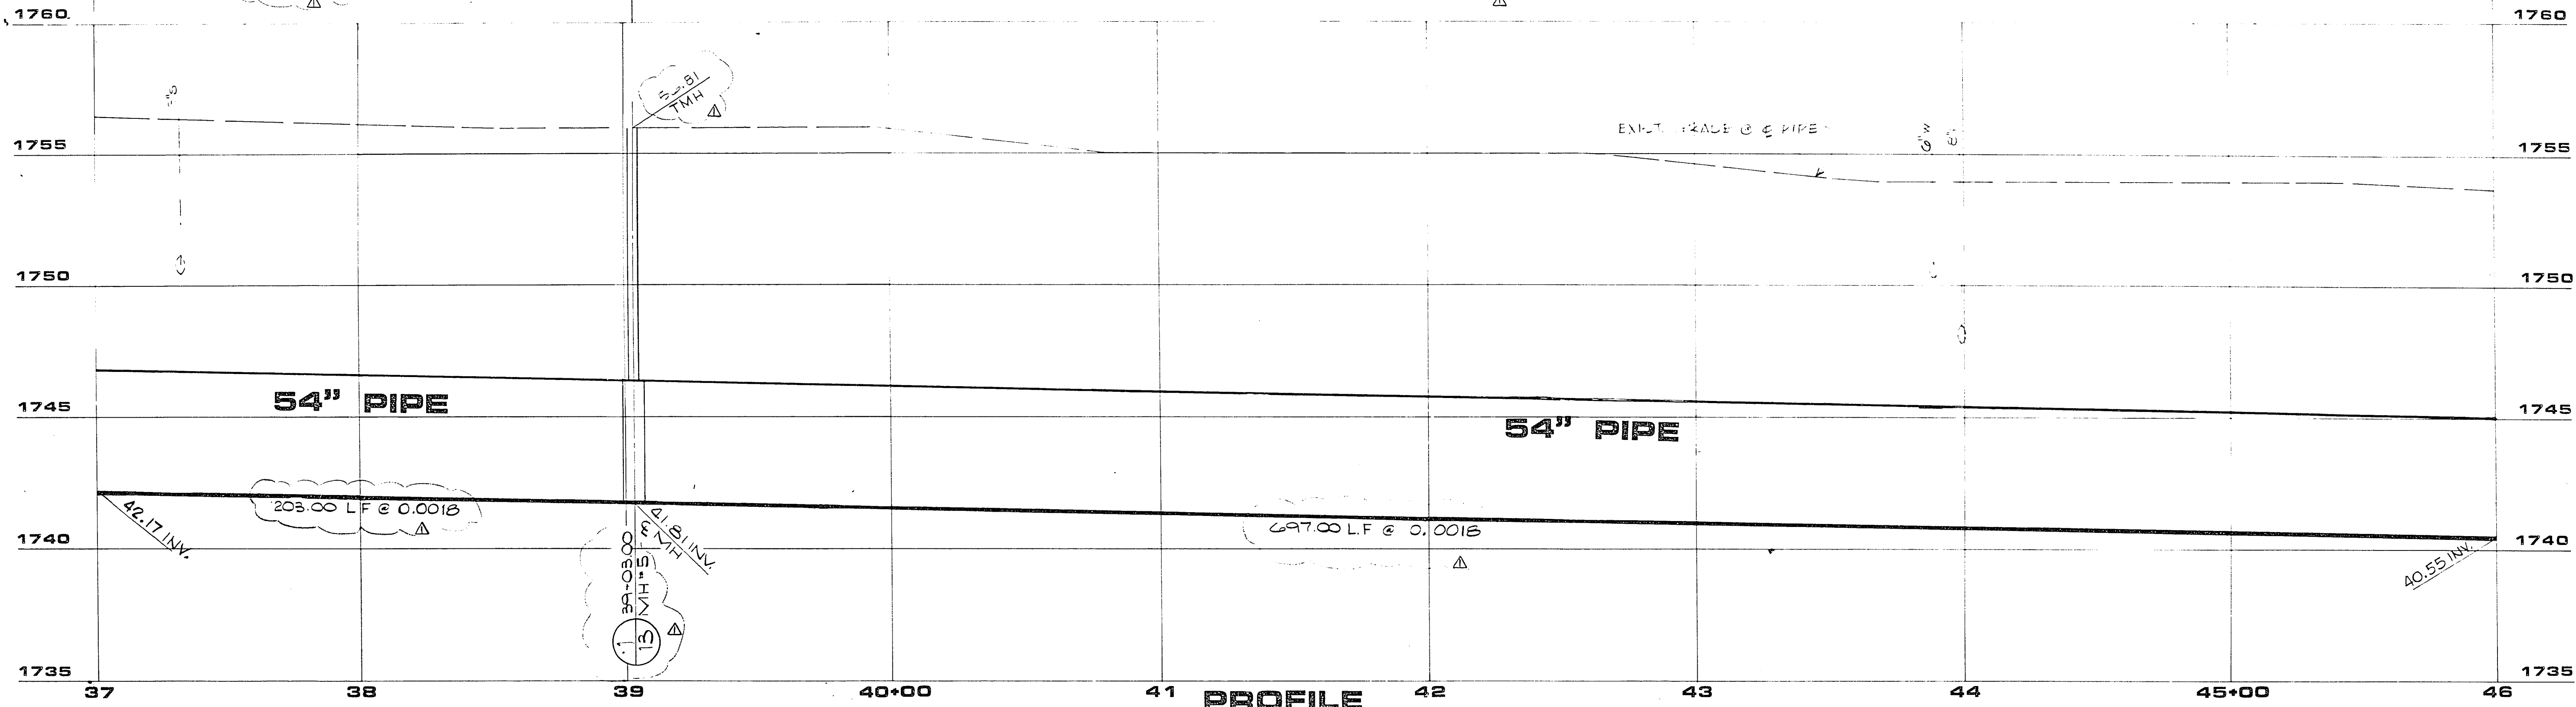

PROFILE

SCALE: HORIZ. 1"=30' VERT. 1"=6'

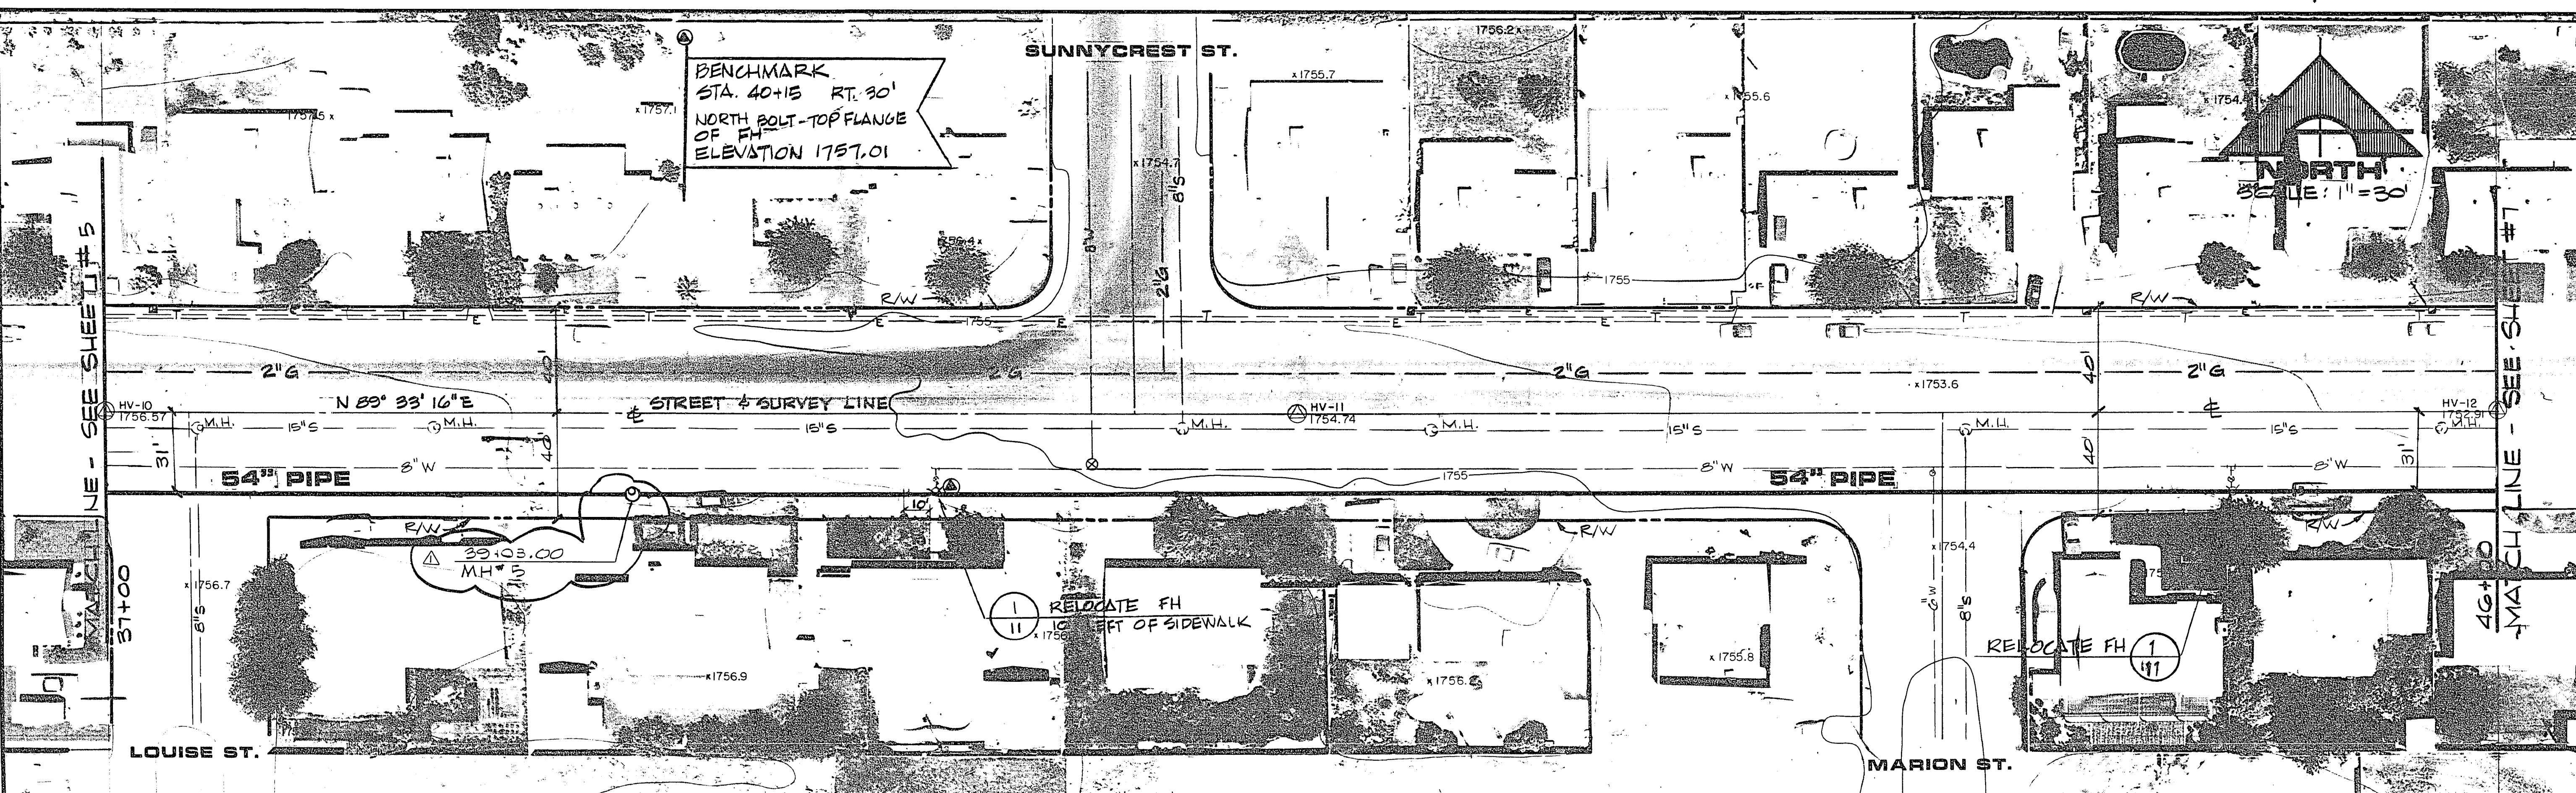

WYOMING AVENUE

RECORD DRAWING 307-V602

DESCRIPTION	RECORD DRAWING
DATE	12/18/87
REV	
RECOMMENDED	M. A. B. R. R. E. NO. DATE
<b>G. C. WALLACE</b> Consulting Engineers, Inc. 1100 East Sahara Ave. - Las Vegas, Nevada 89104 - 732-3330	
DEPARTMENT OF ENGINEERING SERVICES LAMB BLVD. RELIEF SEWER PLAN & PROFILE 37+00 TO 46+00	
SHEET	6
OF 18 SHEETS	

JOB NO. 412.200

C.A.N. 050484

23-1-121