

REV	DATE	DESCRIPTION
1	08/11/04	RECORD DRAWING

G. C. WALLACE
 Consulting Engineers, Inc.
 1100 East Sahara Ave. • Las Vegas, Nevada 89104 • 732-3330

DEPARTMENT OF ENGINEERING SERVICES
 LAMB BLVD. RELIEF SEWER
 PLAN & PROFILE 55+00 TO 63+00

SHEET
8
 OF 3 SHEETS

JOB NO. 412.200

C.A.N. 050484



90

307-V602

RECORD DRAWING

307-V602

23-1-03

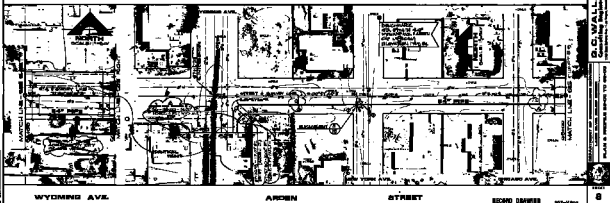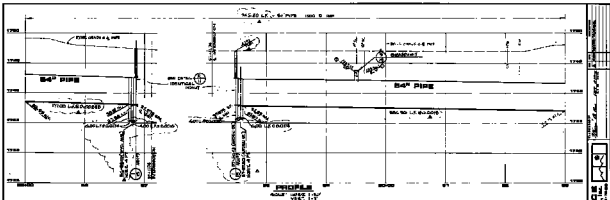

WYOMING AVE. ARDEN STREET SECOND DAVIES 8

PROJECT NO. 101-102
 SHEET NO. 8
 DATE: 10-1-54
 DRAWN BY: J. W. BROWN
 CHECKED BY: J. W. BROWN
 APPROVED BY: J. W. BROWN
 D. C. WALLACE
 Consulting Engineers, Inc.
 101-102
 MATCH LINE - SEE SHEET 101
 MATCH LINE - SEE SHEET 102