



900.00 L.F. 54" PIPE 1000 D R.P.

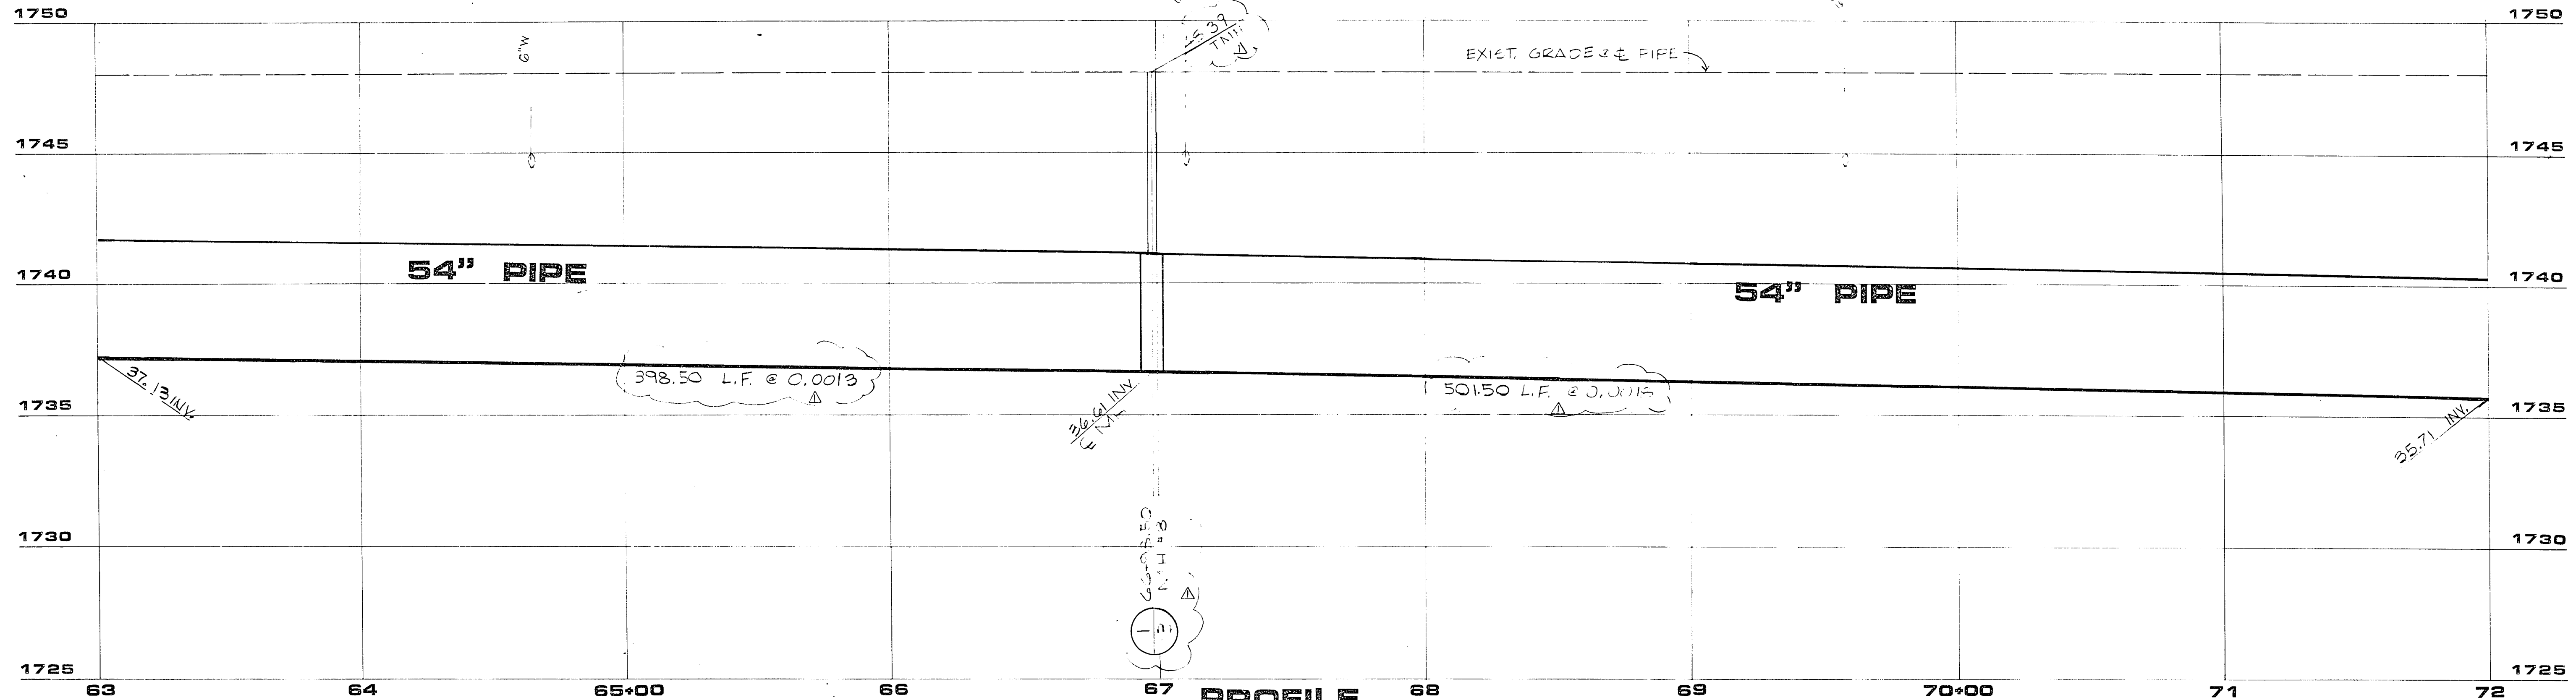

PROFILE


SCALE: HORIZ. 1"=50'
VERT. 1"=5'

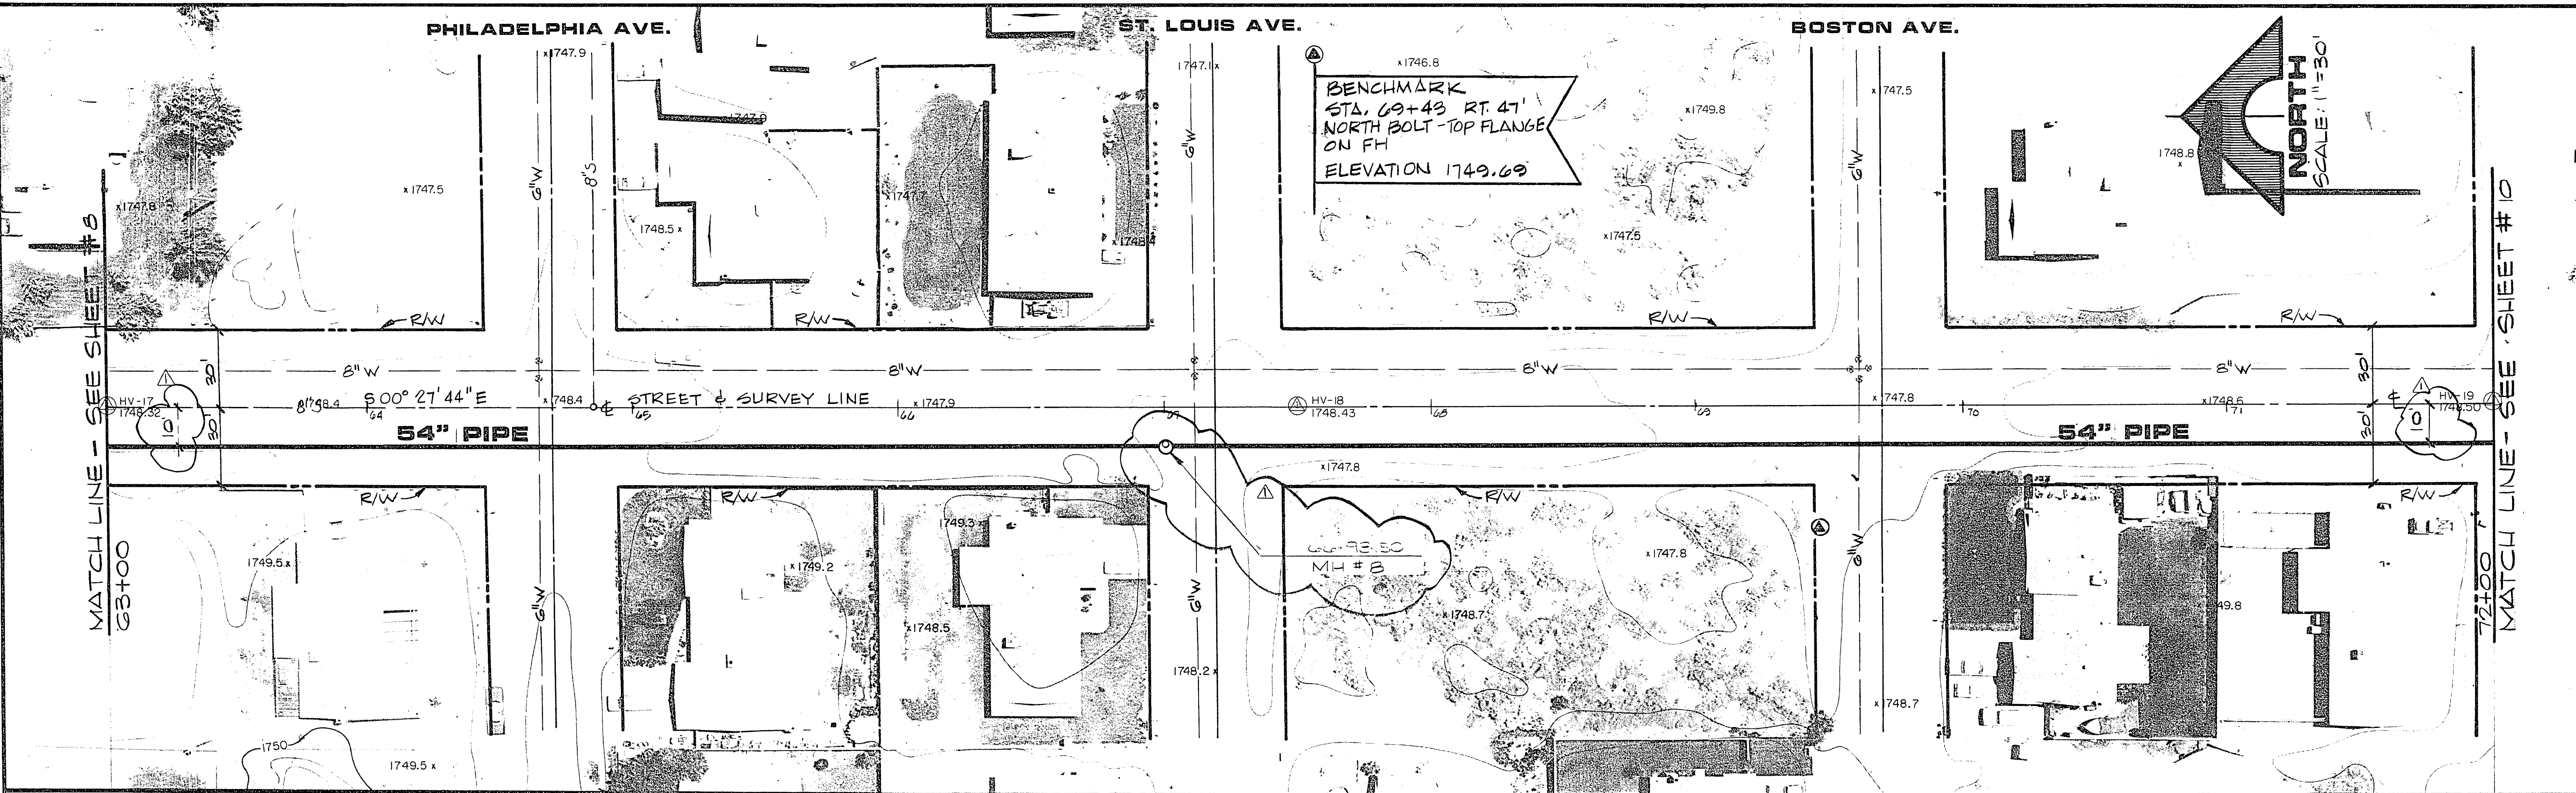

ARDEN STREET


RECORD DRAWING 307-V602

REV	DATE	DESCRIPTION
1	02/17/04	ISSUED RECORD DRAWING
2	02/17/04	R.E. NO. DATE

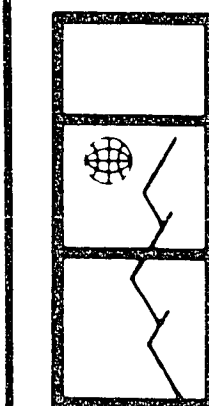

G.C. WALLACE
Consulting Engineers, Inc.
1100 East Sahara Ave. - Las Vegas, Nevada 89104 - 732-3330

DEPARTMENT OF ENGINEERING SERVICES
LAMB BLVD. RELIEF SEWER
PLAN & PROFILE 63+00 TO 72+00

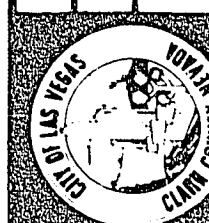

SHEET

9

OF 13 SHEETS

JOB NO. 412.200

C.A.N. 050484

23-1-04