


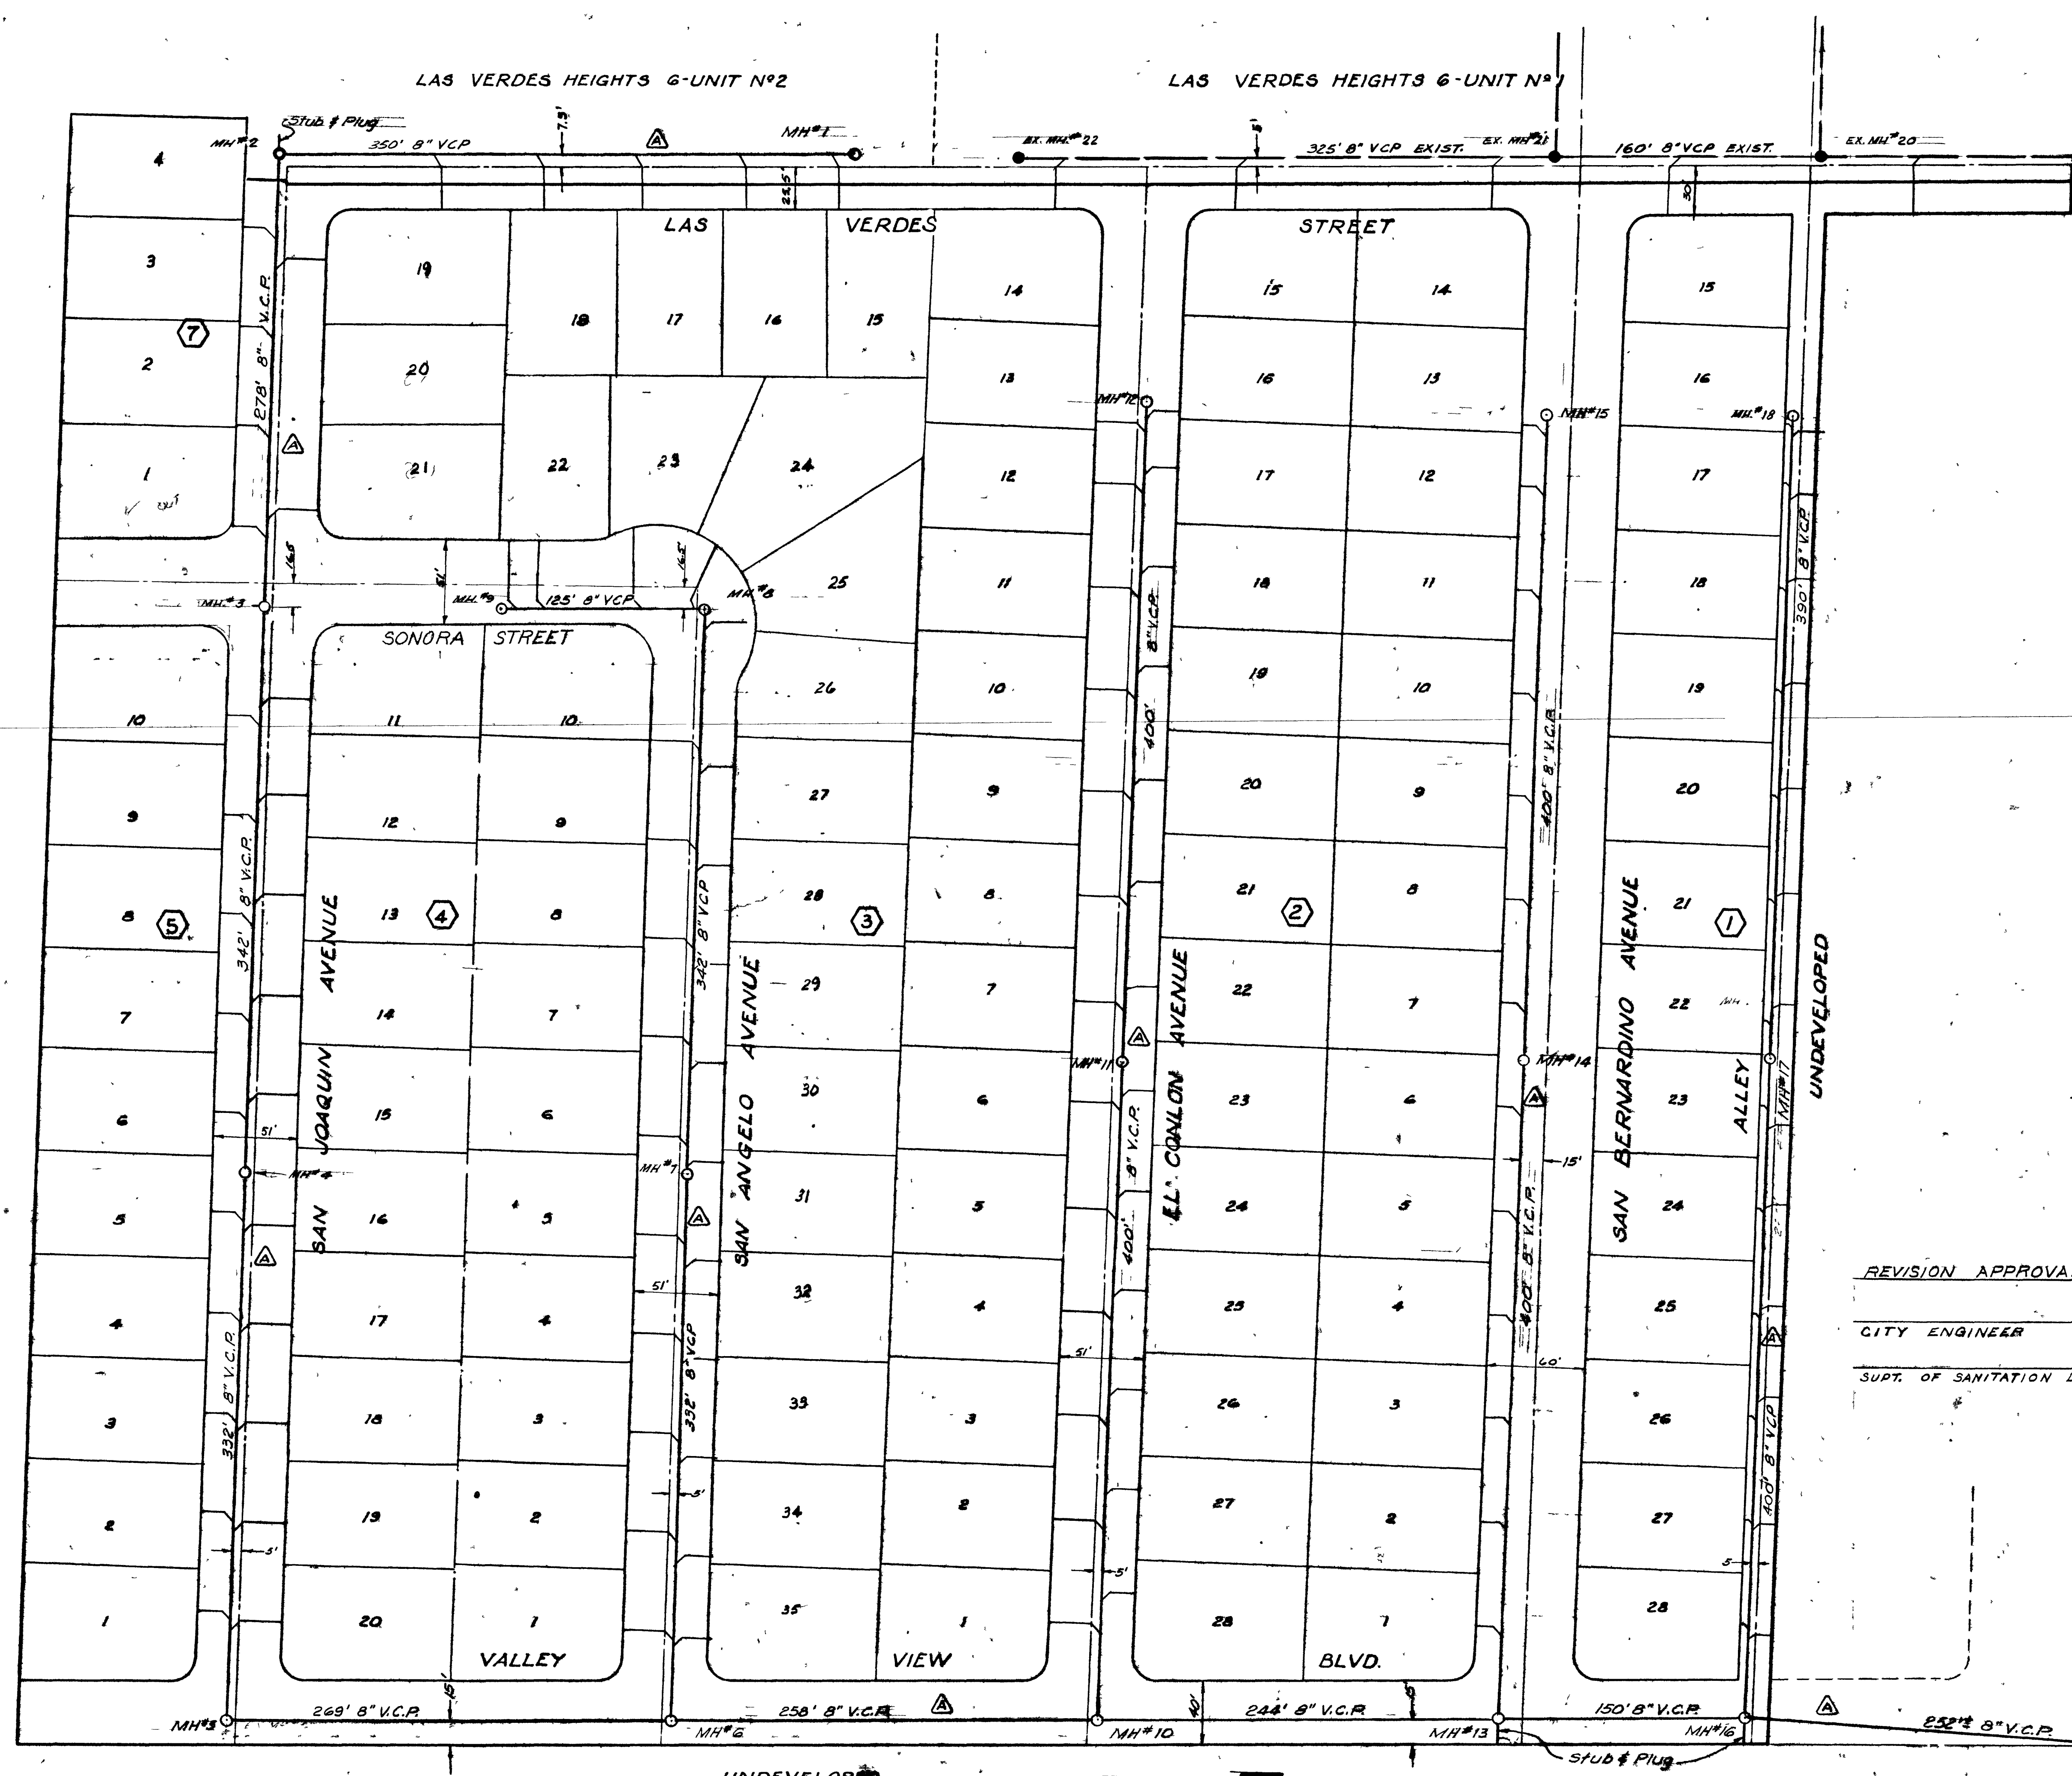

ESTIMATE OF QUANTITIES

8" V.C.P.	5712 LF
4" V.C.P.	2615 LF
MANHOLES	18 REQ'D.

NOTE: EXACT LOCATION OF LATERALS TO BE DETERMINED IN FIELD.

REVISION APPROVALS

CITY ENGINEER DATE

SUPT. OF SANITATION DATE

APPROVALS

CITY ENGINEER DATE

SUPT. OF SANITATION DATE

REV	DATE	DESCRIPTION	BY	APP
12-17-62		Relocated SONORA ST & Sewer on SONORA ST.		
10-12-62		Exist' to New 8" V.C.P. on Las Verdes St. Joaquin Valley View. Relocated MH's except on Sonora & Las Verdes. Relocated 8" V.C.P. on Valley View		H&R

LAS VERDES HEIGHTS UNIT 6-N23

SEWER PLAN

DESIGNED	HC	WESTERN ENGINEERS, INC.	NEVADA	SHEET 1
DRAWN	RCR	LAS VEGAS		
CHECKED		APPROVED		307Y-1980-6-3

