




SECTION C-C

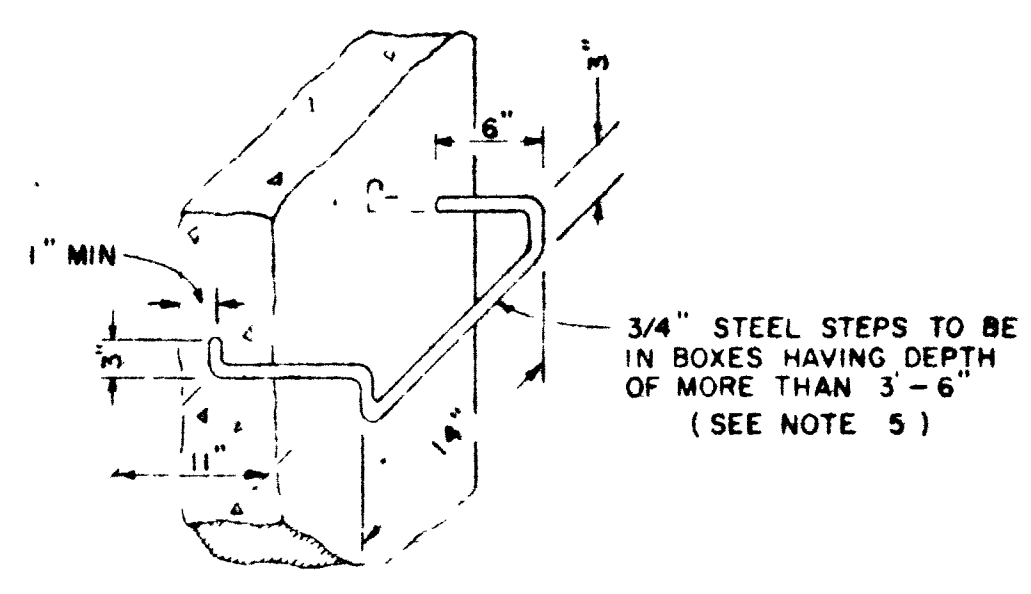

STEP DETAIL

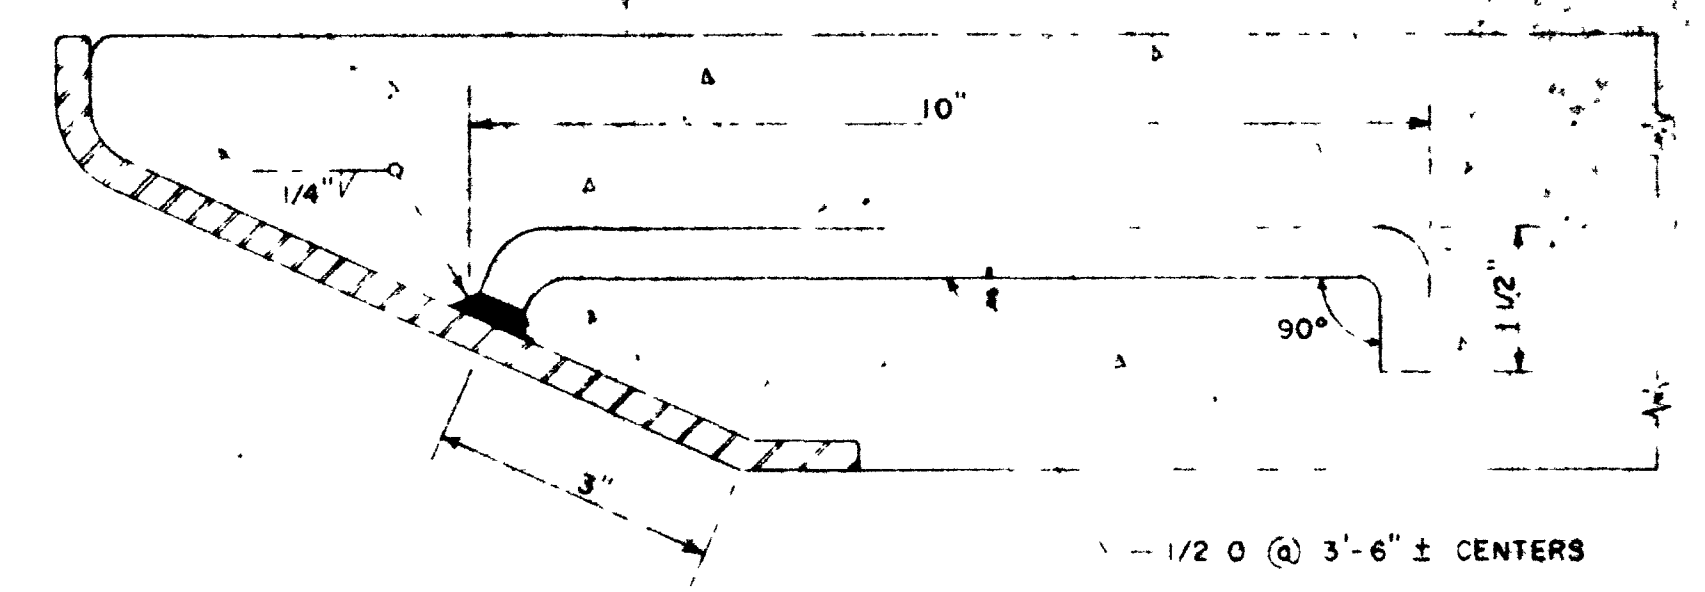


FACE ANGLE ANCHOR DETAIL

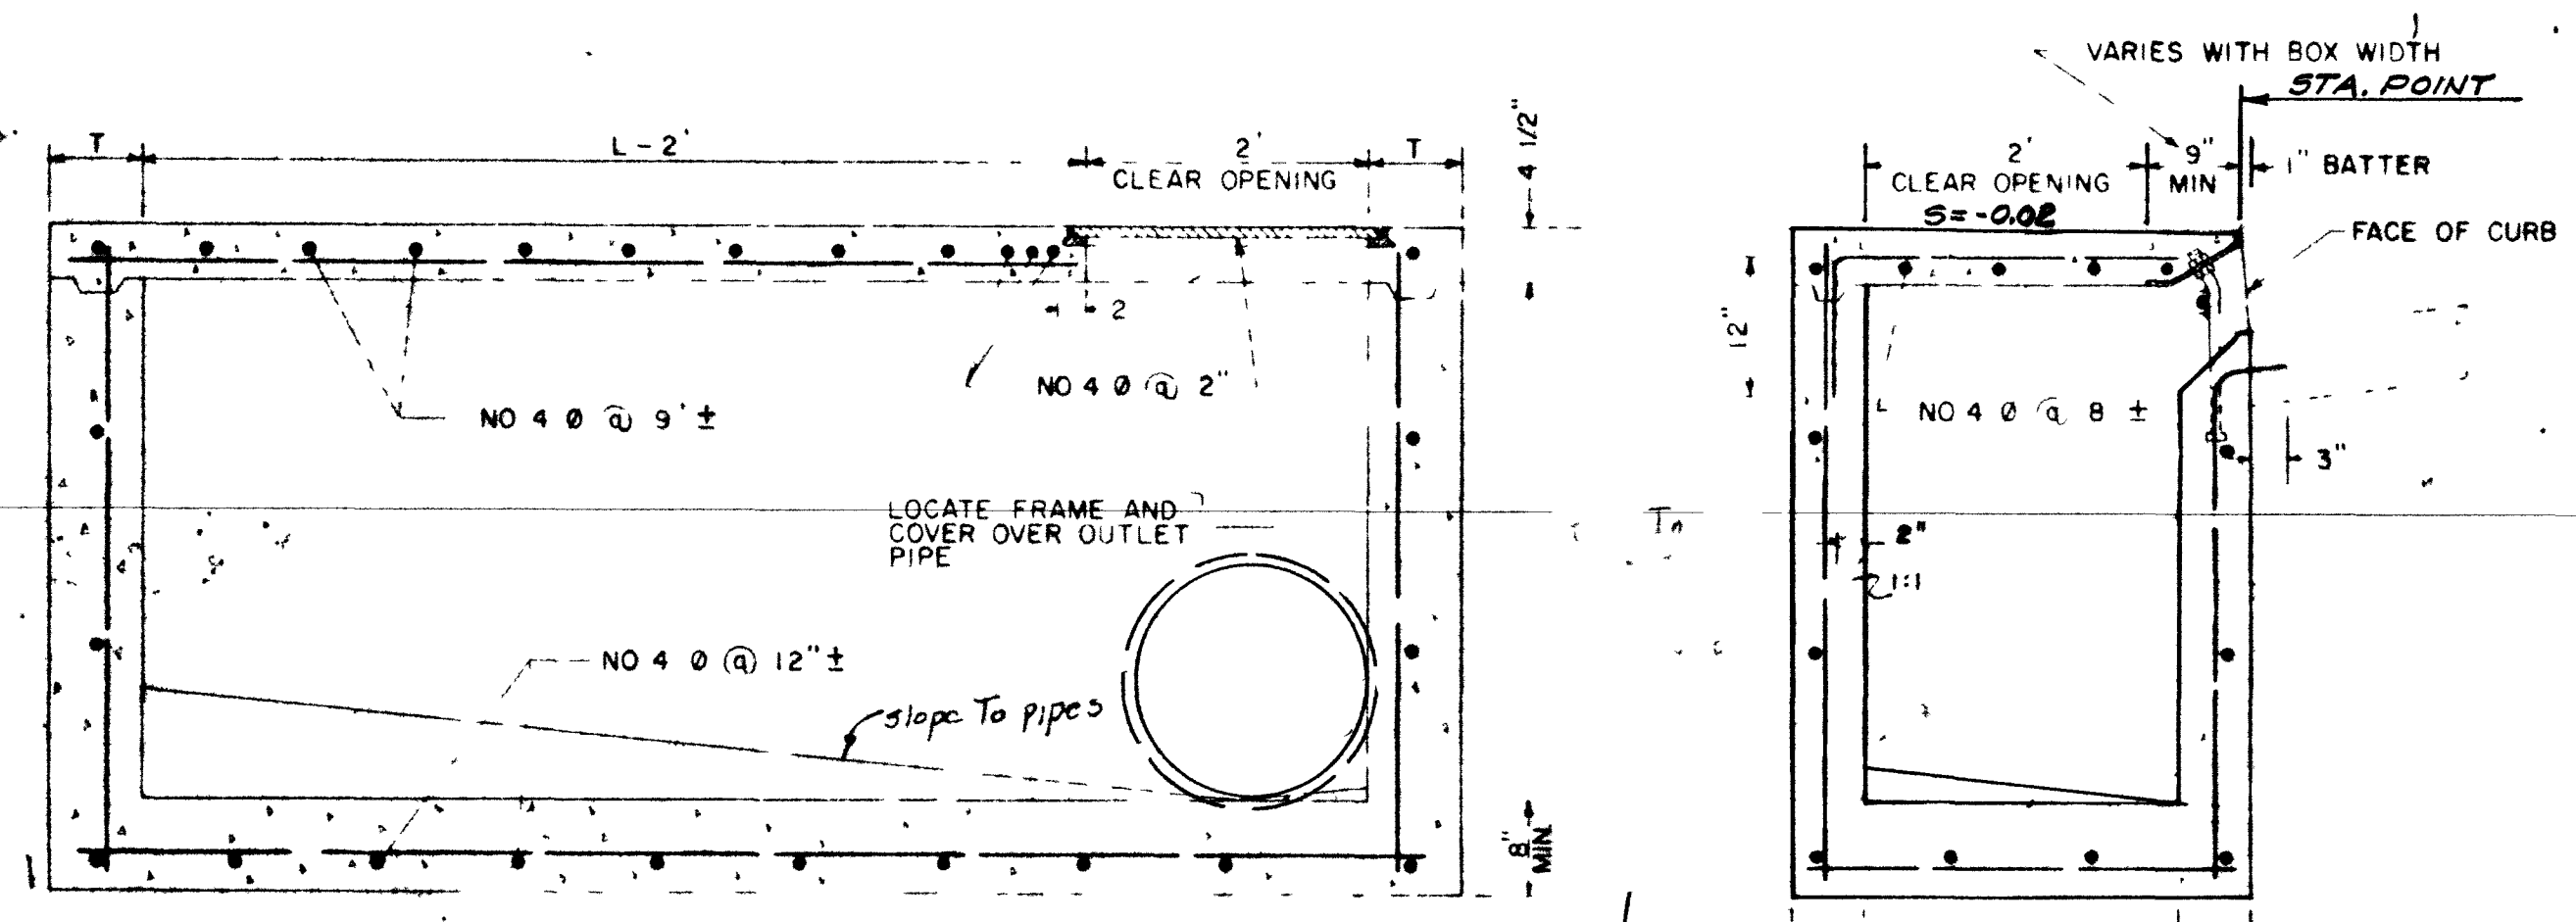

SECTION A-A

SECTION B-B

Both pipes and the frame & cover will be located in the Northend of the box

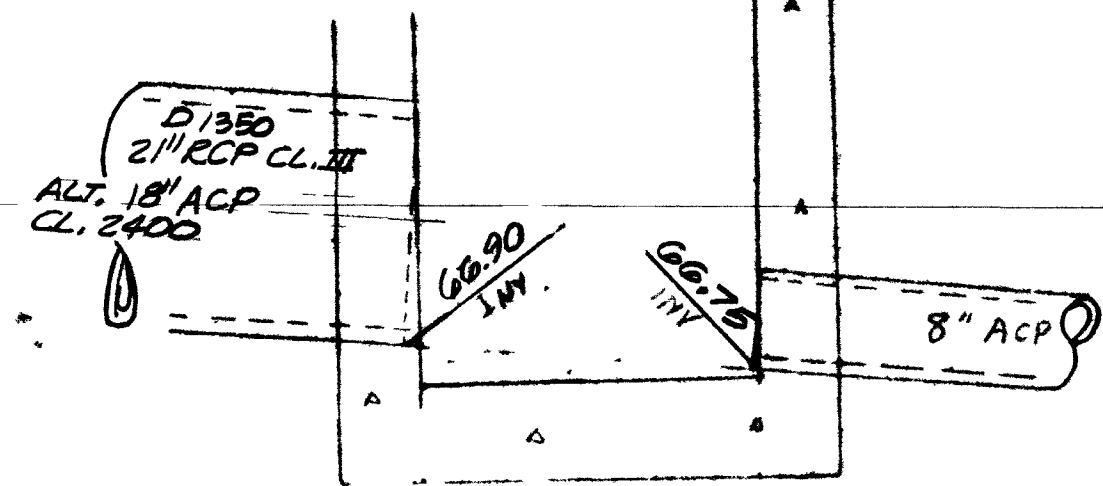


BUBBLER - INLET & OUTLET PIPE DETAIL

(L) LENGTH OF CURB OPENING	NO OF ANCHORS
3'-6" or less	2
7'-0"	3
10'-0"	4
14'-0"	5
21'-0"	7


TABLE	
H	T
8'-0" or less	6"
8'-1" to 20'-0"	8"

GENERAL NOTES

- "H" is the difference in elevation between the outlet pipe flow line and the normal gutter grade line undepressed at the curb face at center of box.
- For "T" wall thickness see Table
- Height of curb opening will vary with the type of curb and the depth of the local depression
- Reinforcing steel in walls shall be No 4 bars @ 18" ± centers placed 1/2" clear to inside of box unless otherwise shown
- Steps - None required where "H" is 3'-6" or less install one step 16" ± above floor when "H" is more than 3'-6" and less than 5'-0". Where "H" is more than 5'-0", steps shall be evenly spaced @ 12" ± intervals from 16" ± above floor to within 12" ± of the top of the box. Place steps in wall without pipe openings.
- Where pipe intersects drop inlet on a 12° or larger skew increase J to $\frac{J}{\cos \text{skew } Z}$
- Curb openings longer than 7' shall have one curb support for each 7' increment or fraction thereof, evenly spaced.
- Pipe(s) can be placed in any wall
- Curb section shall match adjacent curb.
- Basin floors shall have a minimum slope of 10/1 from all directions toward outlet pipe and shall have a wood trowel finish. Form basin with brick or concrete
- For backfill see section 202 of THE UNIFORM STANDARD SPECIFICATIONS

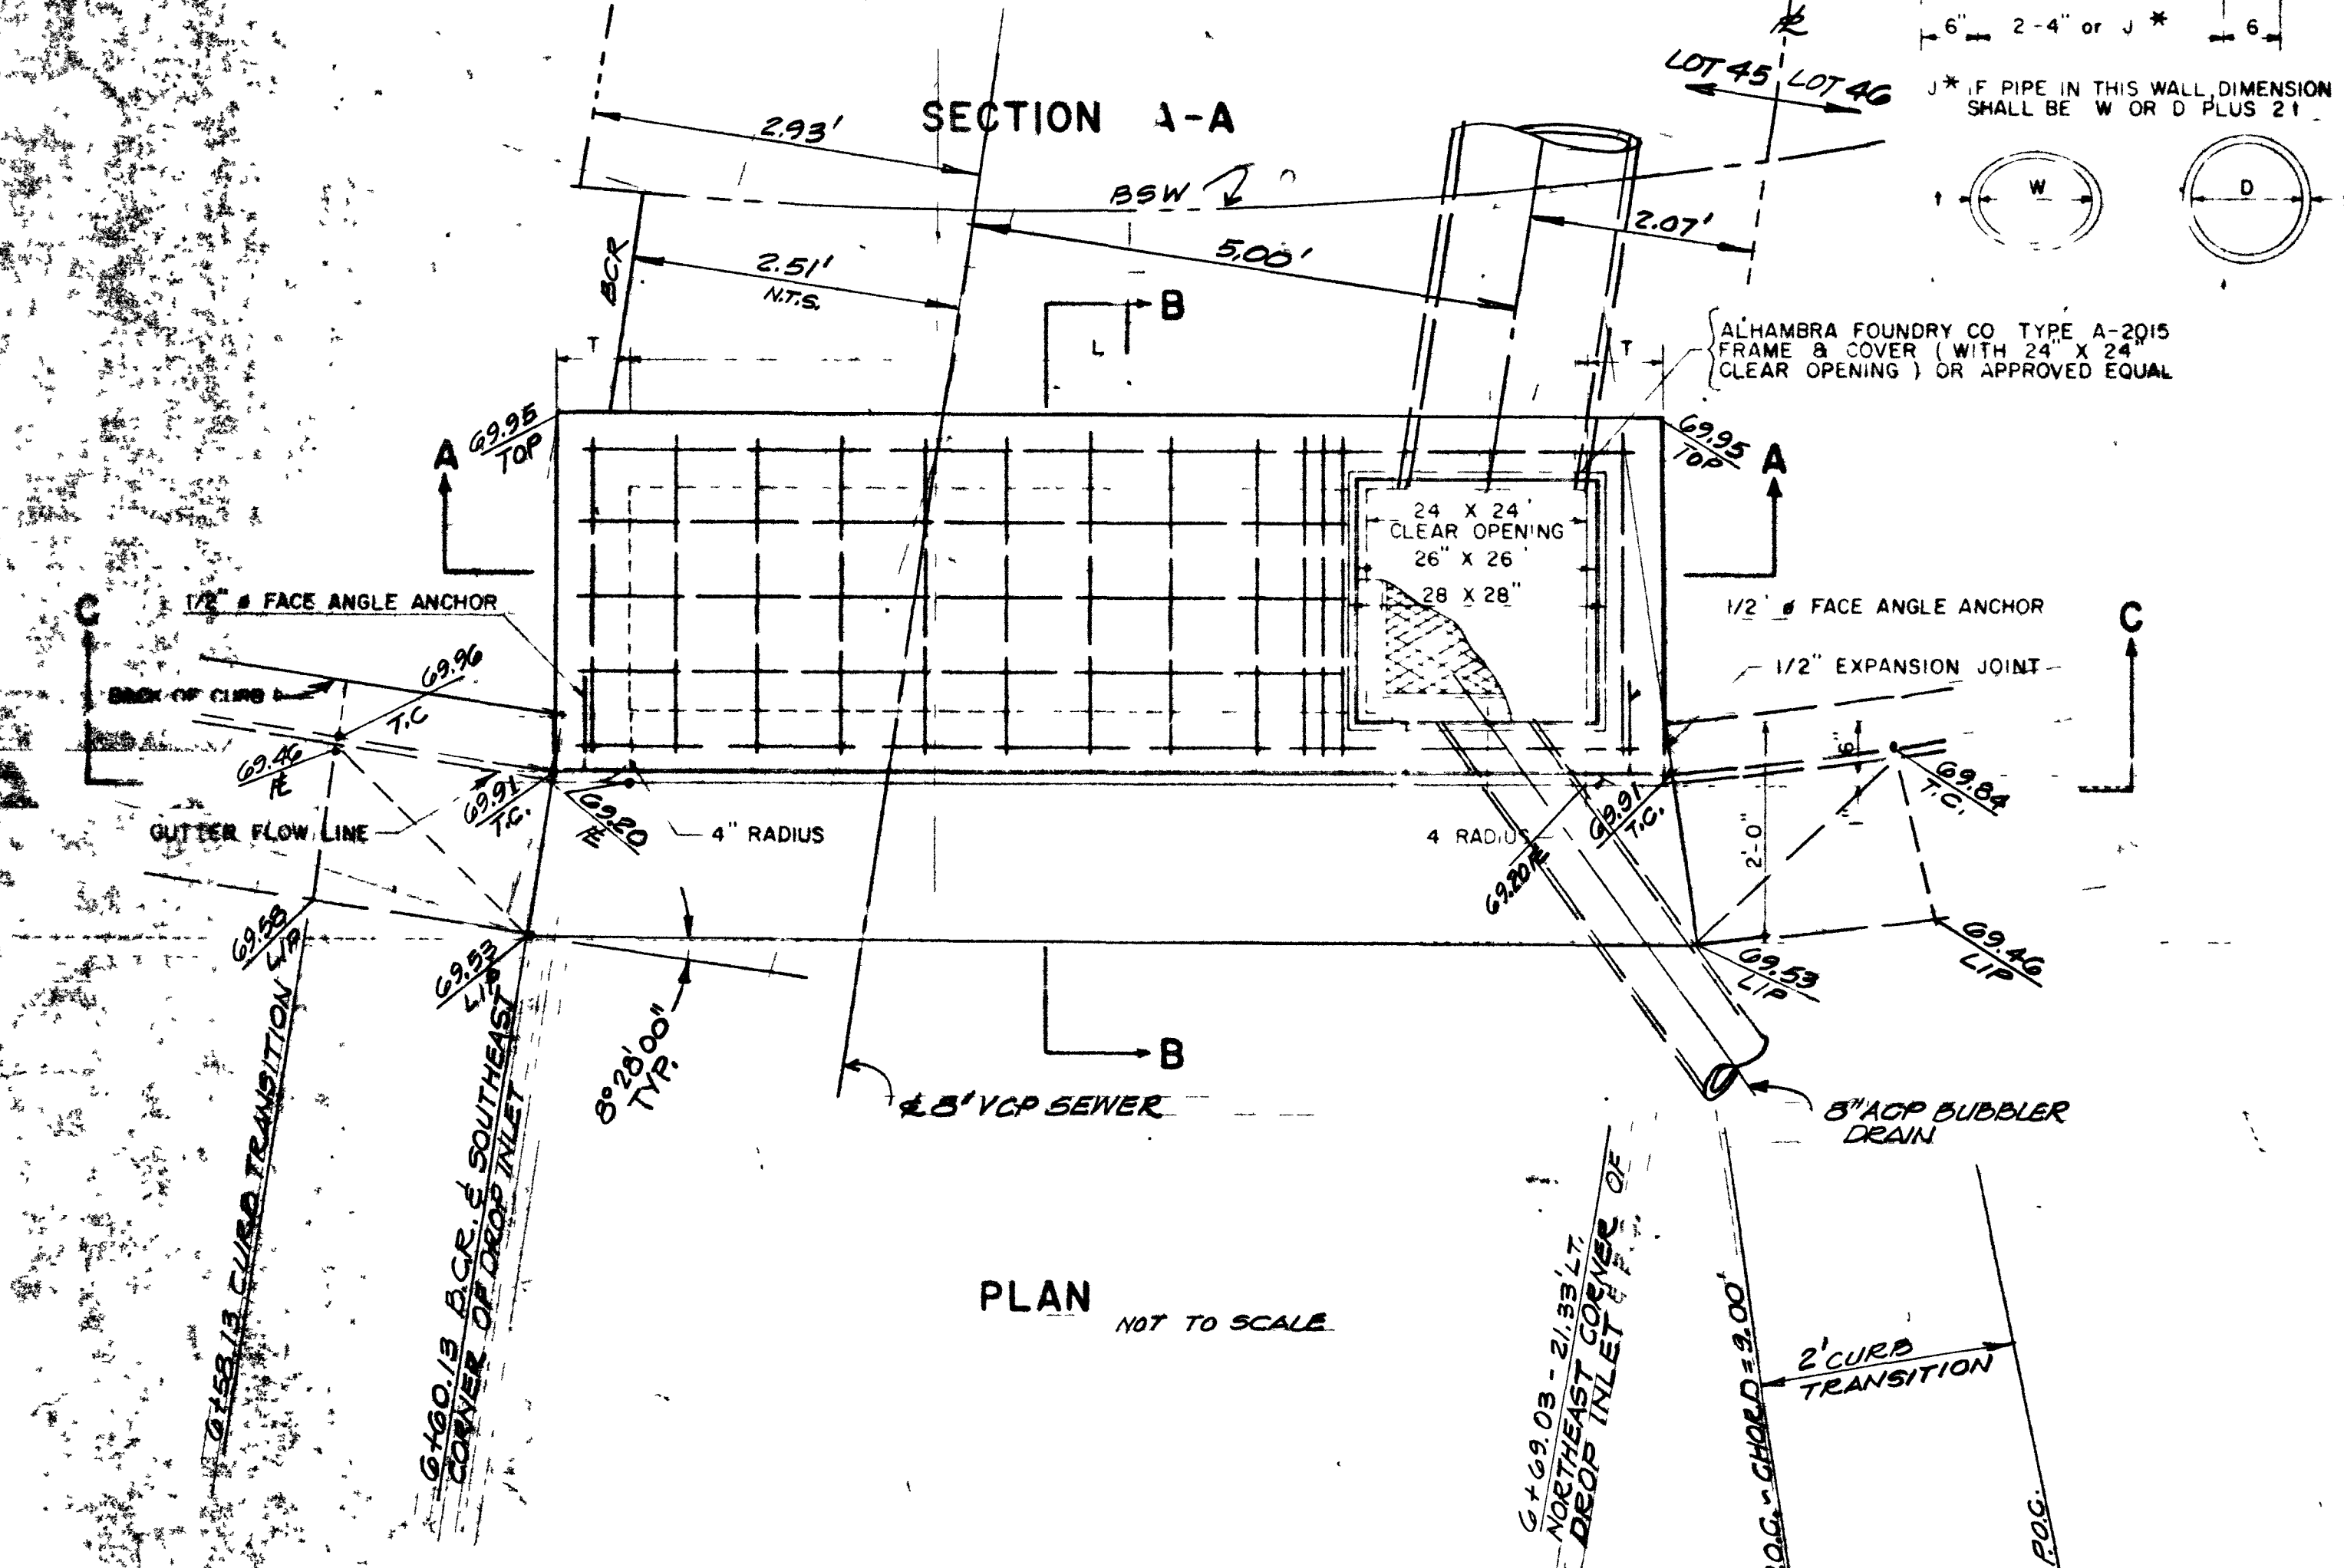

PLAN NOT TO SCALE

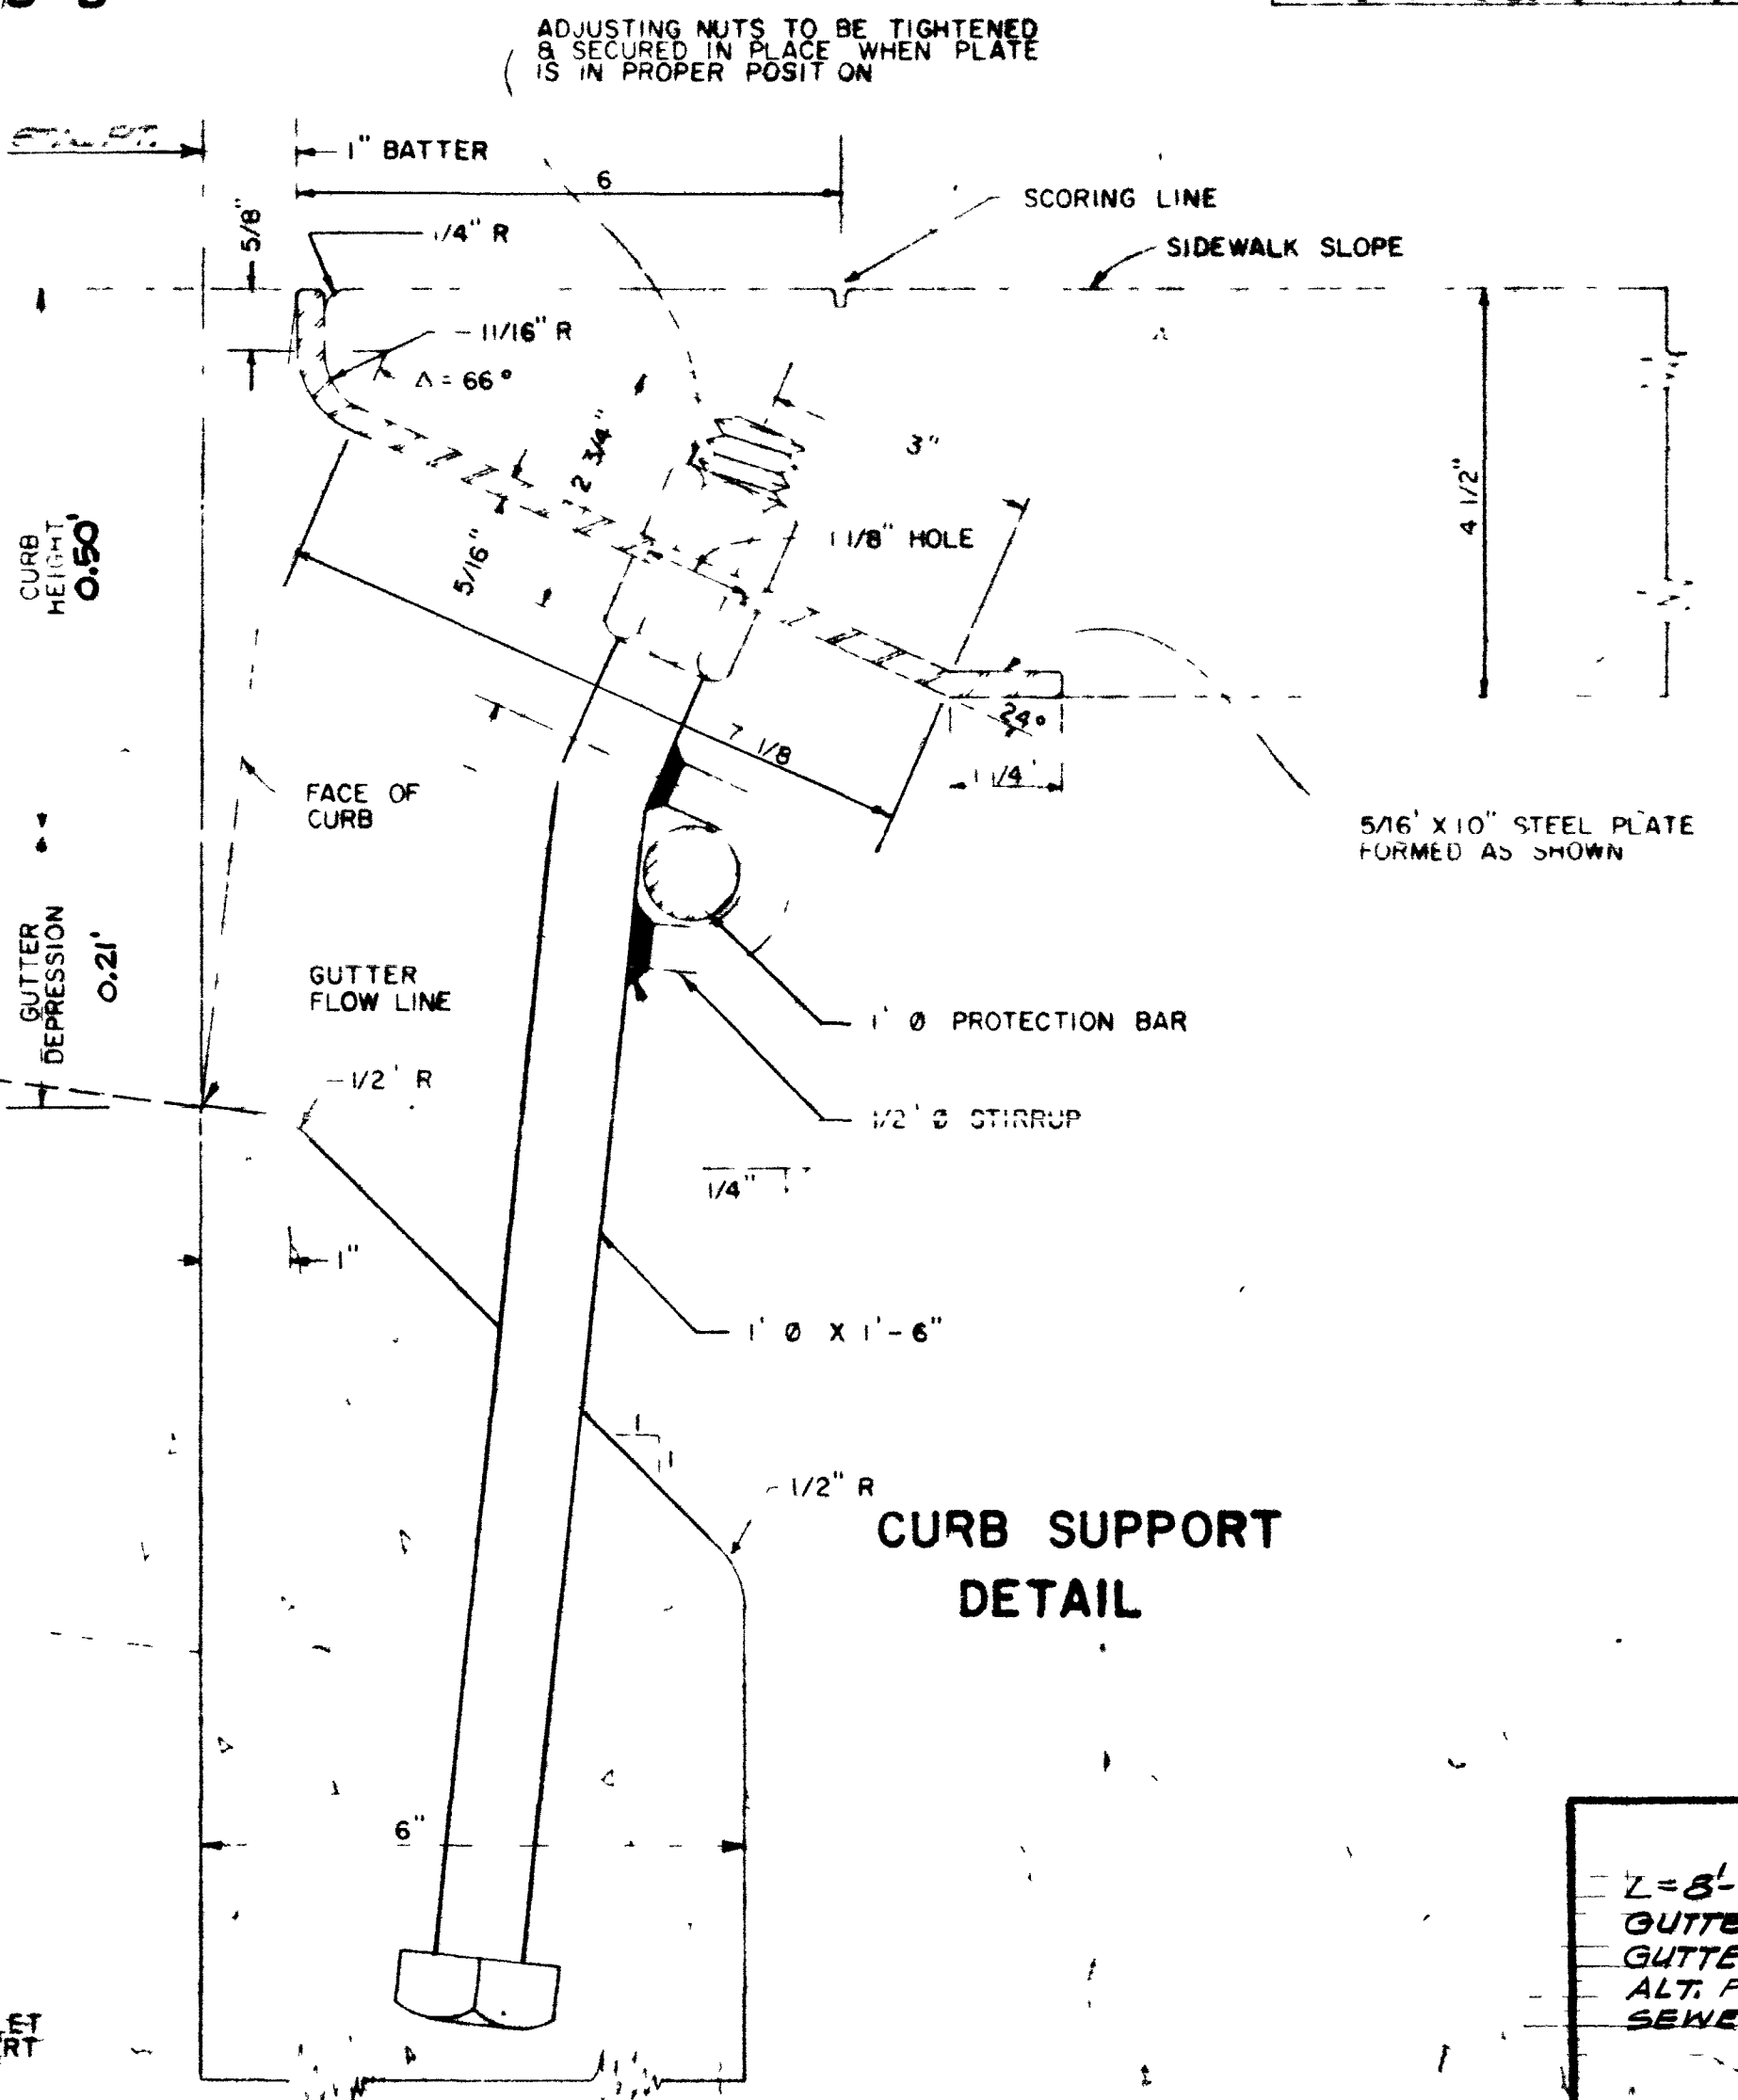

CURB SUPPORT DETAIL


12/11/74
12/11/74
12-10-74

Lawrence Hampton
CITY ENGINEER

J. D. Decker
FIELD ENGINEER

NOTE
L=5'-0" T=0" H=2'-0"
GUTTER DEPRESSION=2 1/2"
GUTTER TRANS.=2'-0"
ALT. PIPE=18" CL. 2400 ACP.
SEWER PIPE (NON-PRESSURE)

REVISION NO.	DESCRIPTION	BY	DATE	APPROVAL
REVISIONS				
LEWIS HOMES - CHAS. UNIT 7 LAS VEGAS, NEVADA DROP INLET DETAIL				
DMMJ DANIEL, MANN, JOHNSON, & MENDENHALL PLANNING & ARCHITECTURE & ENGINEERING & SYSTEMS & ECO-SYSTEMS 309 S. THIRD ST. LAS VEGAS, NEVADA 89101 & TELEPHONE (702) 596-0881				
SCALE (H) SCALE (V) DATE JOB NO.				
DES. K.A.S. 6743-10-10				
DR. SMALL SHEET 8 OF 8				

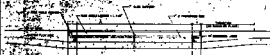

SECTION C-C



STEP DETAIL



FACE ANGLE ANCHOR DETAIL



SECTION 2-A

SECTION 2-B




WALL-ANGLE ANCHOR DETAIL

NO.	DESCRIPTION	QTY.	UNIT
1	ANCHOR BOLT	1	EA.
2	WALL ANGLE	1	EA.
3	CONCRETE	1	CU. YD.


NO.	DESCRIPTION	QTY.	UNIT
1	ANCHOR BOLT	1	EA.
2	WALL ANGLE	1	EA.
3	CONCRETE	1	CU. YD.

GENERAL NOTES

1. All of the dimensions in elevation between the center line and the face of the member shall be as shown. All dimensions in plan shall be to the center line of the member.
2. All dimensions shall be in feet and inches.
3. All dimensions shall be in feet and inches.
4. All dimensions shall be in feet and inches.
5. All dimensions shall be in feet and inches.
6. All dimensions shall be in feet and inches.
7. All dimensions shall be in feet and inches.
8. All dimensions shall be in feet and inches.
9. All dimensions shall be in feet and inches.
10. All dimensions shall be in feet and inches.

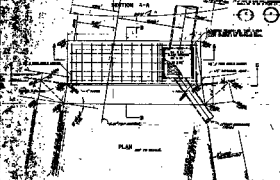

PLAN

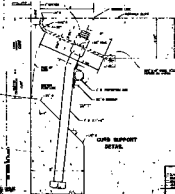

GRID SUPPORT DETAIL

Handwritten signature and date

NO.	DESCRIPTION	QTY.	UNIT
1	ANCHOR BOLT	1	EA.
2	WALL ANGLE	1	EA.
3	CONCRETE	1	CU. YD.

LEWIS HONER - CHAR. UNIT. 7
LAW OFFICE, MEMPHIS
DROP INLET DETAIL