


CITY OF LAS VEGAS GENERAL NOTES


- HOUSE SERVICES SHALL COMPLY WITH WESTERN PLUMBING CODE AS TO SEPARATION DISTANCE.
- ALL HOUSES TO BE SERVED INDIVIDUALLY AS PER SECTION 313 OF THE UNIFORM PLUMBING CODE.
- CONTRACTOR SHALL FURNISH THE ENGINEER WITH AS-BUILT DRAWINGS SHOWING THE EXACT LOCATIONS OF ALL HOUSE CONNECTIONS.
- CONCRETE COLLARS TO BE CONSTRUCTED AROUND ALL MANHOLES AND WATER VALVES ON 60, 80 AND 100 FOOT R/W'S. ASPHALT COLLARS MAY BE USED ON 51 FOOT R/W'S. CONCRETE COLLARS SHALL BE 1/8" TO 1/4" LOWER THAN ADJACENT FINISH GRADE.
- CHISEL S OR G WHEREVER SEWER OR GAS LINES PASS UNDER CURB.

CITY OF LAS VEGAS SEWER TRENCH NOTES

- BACKFILL SHALL BE ANY EXCAVATED IMPORTED OR TRANSPORTED MATERIAL WHICH IS FREE FROM LARGE LUMPS GREATER THAN 6" IN DIAMETER AND FREE OF ORGANIC MATERIAL. BACKFILL SHALL BE COMPACTED BY FLOODING OR TAMPING TO A DENSITY SPECIFIED BY THE SOILS ENGINEER.
- TRENCH NOTES FOR VCP SEWER PIPE ONLY. IF PVC ALTERNATE IS USED, THEN TRENCH BACKFILL TO COMPLY WITH CITY OF LAS VEGAS INTER-OFFICE MEMORANDUM DATED JANUARY 25, 1980.
- BACKFILL TO 12" MINIMUM COVER OVER PIPE WITH SELECTED SAND OR GRAVEL, NO LARGER THAN 2" DIAMETER. BACKFILL TO BE PLACED BY HAND FOR PIPES 27" IN DIAMETER AND SMALLER.

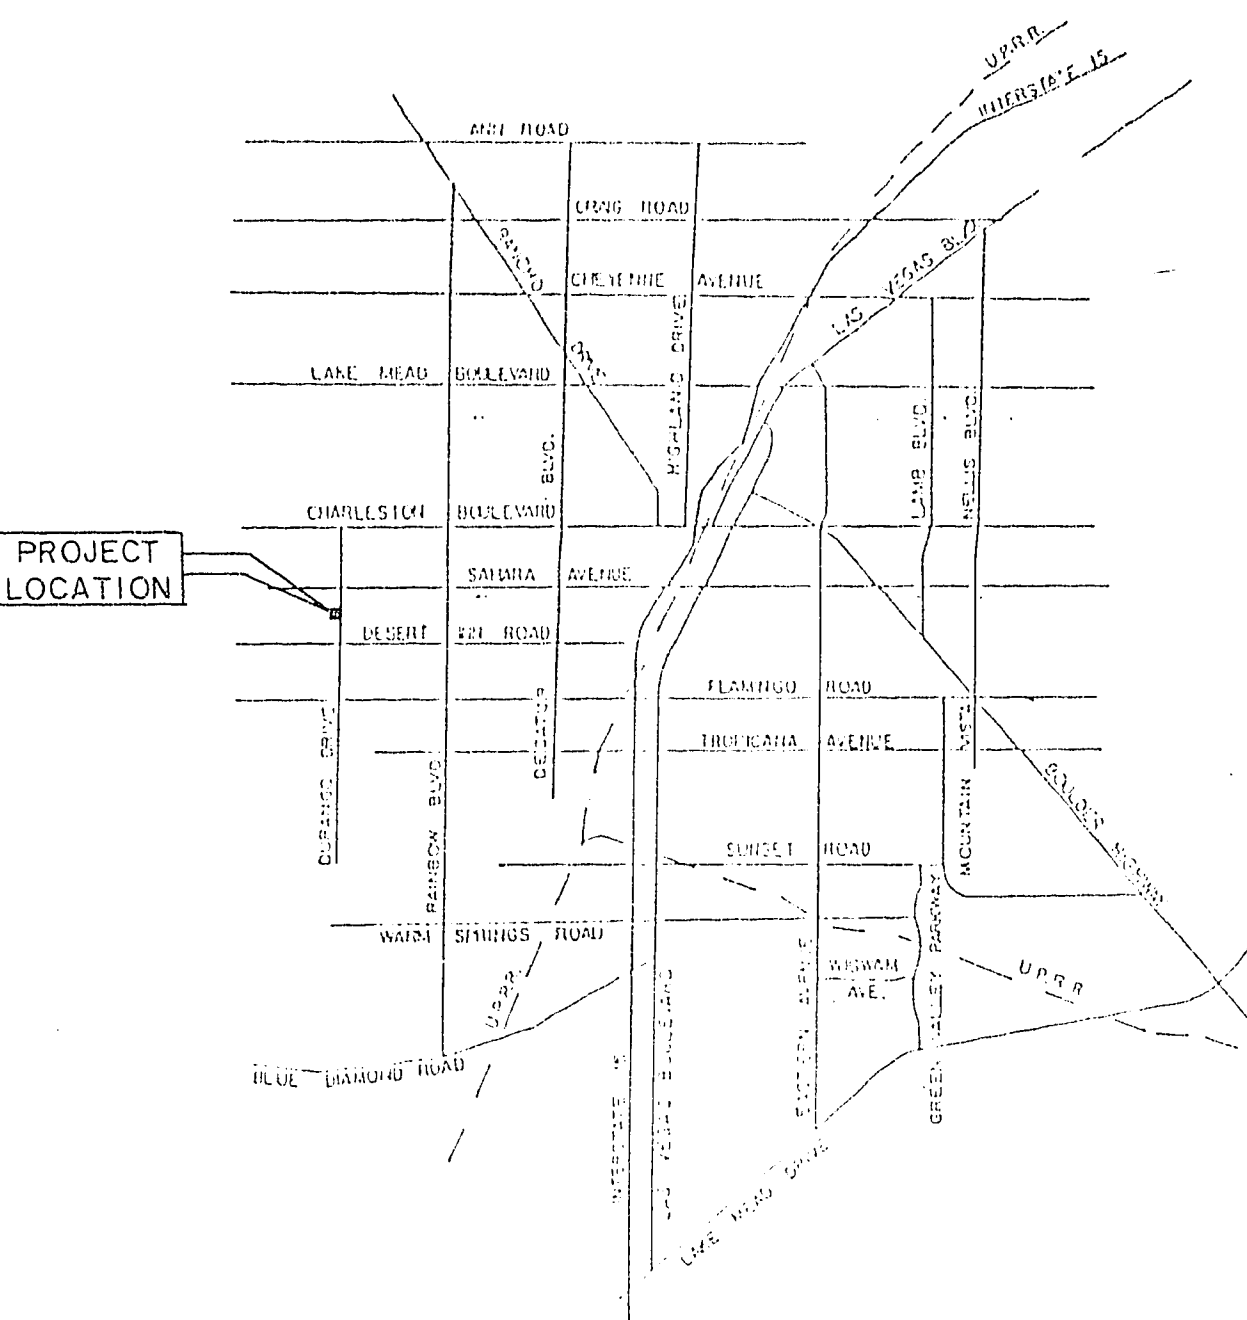

VICINITY MAP

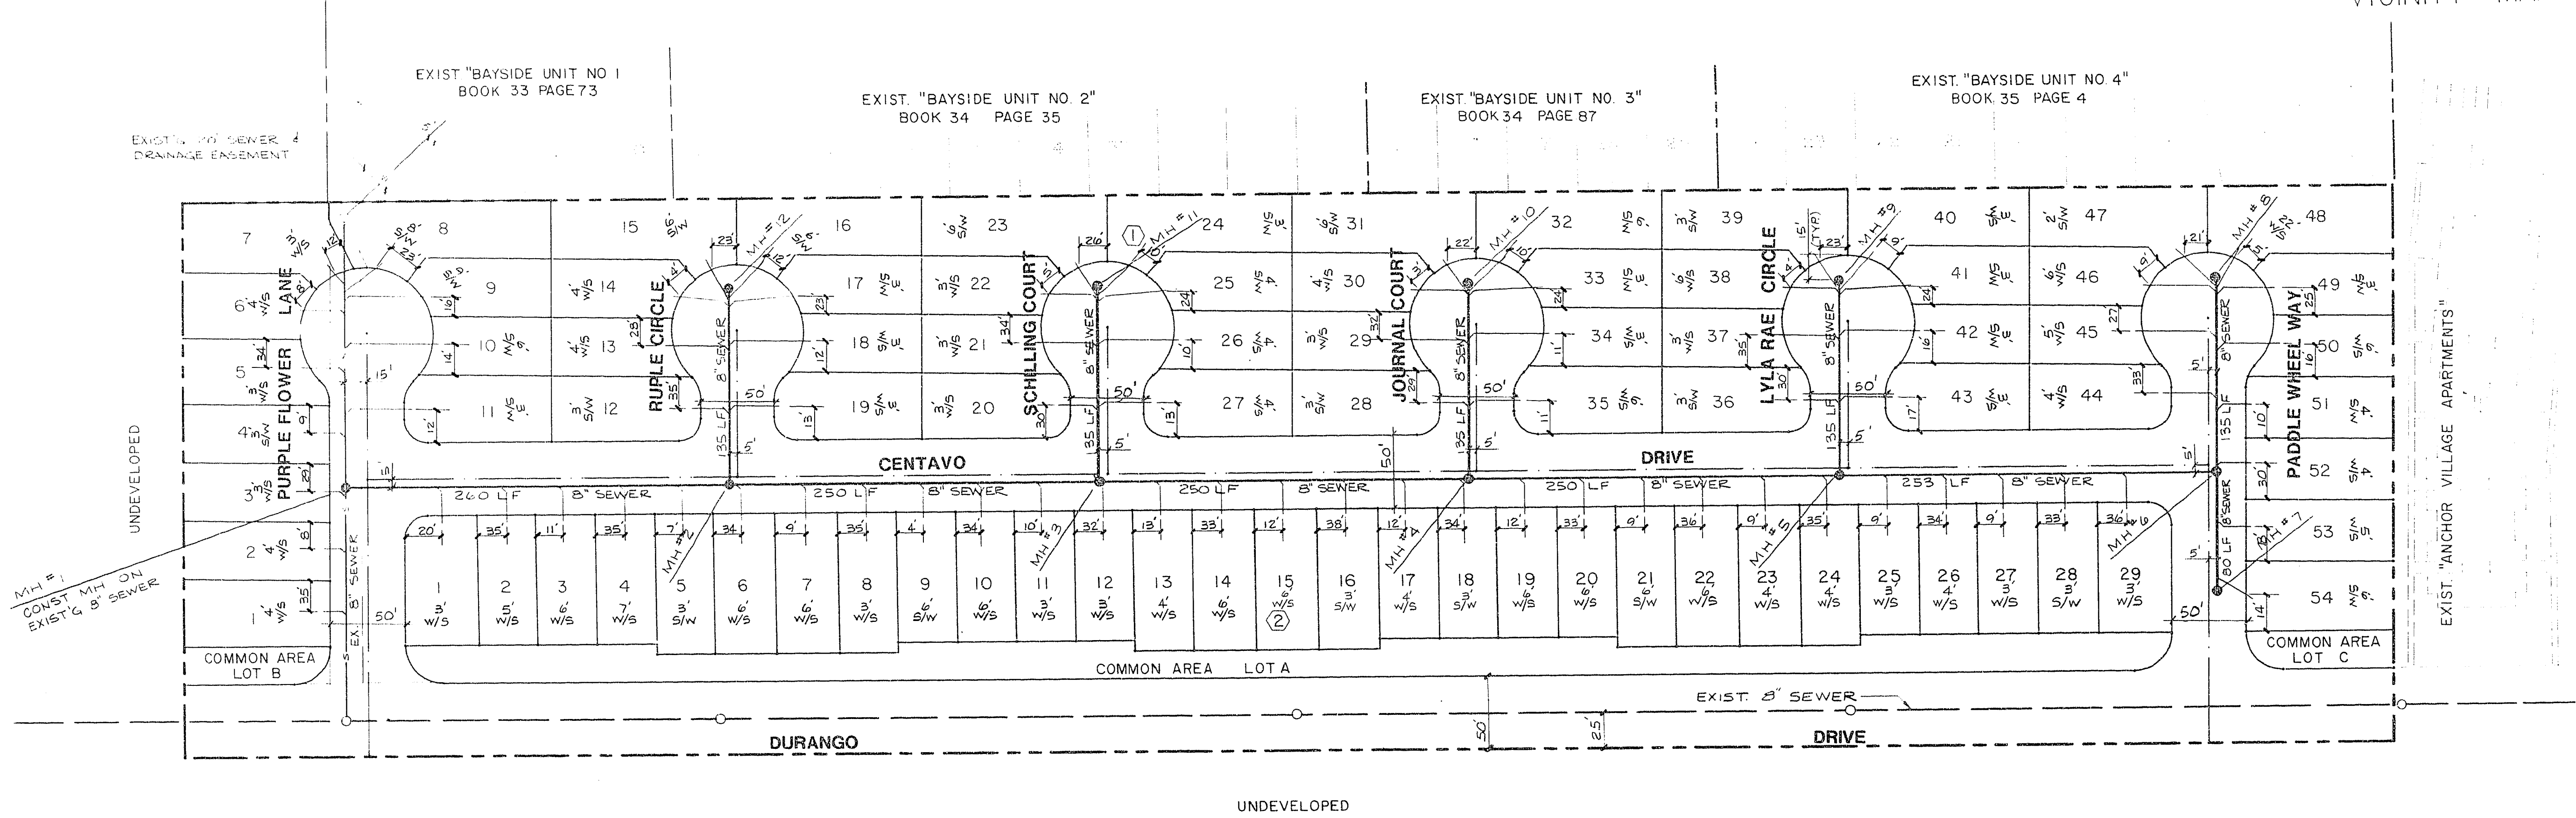

QUANTITY ESTIMATE

STD MANHOLE	12 EA
8" SEWER MAIN	2018 LF
4" SEWER LATERAL	2675 LF
WYES	83 EA

NOTE:
CONNECT LOTS 1 THRU 11, BLK 1
TO EXISTING 8" SEWER MAIN.

- NOTES:
- ALL LATERAL DIMENSIONS ARE TAKEN FROM THE RIGHT PROPERTY LINE WHILE FACING THE LOT.
 - SEPARATIONS OF WATER & SEWER ARE MEASURED FROM THE STREET, FACING THE LOT.
EXAMPLE:
LOT #28 SEWER IS 3' LEFT OF WATER SERVICE
LOT #44 SEWER IS 4' RIGHT OF WATER SERVICE

C.L.V. SANITATION ENGINEER
DATE 3-3-97

TITLE		PROJECT	
LOS LAGOS		307-Y2034	
WON NO 4072		BY RPF	
DATE 1/87		SCALE 1" = 60'	
SHEET 11		OF 13 SHEETS	

ES/ENGINEERS & SURVEYORS INC.
SUBMITTED BY: [Signature]
DATE: 1/87