

Federal Fair Housing Amendments Act, Americans With Disabilities Act, the Architectural Barriers Act and any applicable uniform standards, specifications or drawings. The person or entity performing the construction shall be solely responsible to make sure construction is in conformance with all local, state and federal statutes, laws, codes, regulations, standards, guidelines and ordinances and further, is in conformance with any applicable design criteria, including but not limited to soils reports, traffic studies, geotechnical reports, architectural plans and specifications, drainage plans or studies and any other criteria, standards or requirements listed in the plans or the general notes related to these plans or provided by anyone in reference to this project.

FIRE FLOW DATA

THE FIRE FLOW REQUIREMENTS IS 2500 GPM AT 20 PSI RESIDUAL PRESSURE.

BASED ON: GEORGE F. TIBSHERANY ARCHITECTURE PLANS

SQUARE FOOTAGE: 17,712 SF

LARGEST AREA BETWEEN 4-HOUR AREA SEPARATION WALLS: N/A

BUILDING HEIGHT: 35 FEET

NUMBER OF STORIES: 2 FLOORS

TYPE OF CONSTRUCTION: V-I

OCCUPANCY: R1

FULL AUTOMATIC FIRE

SPRINKLER SYSTEM: N/A

CLEAN OUT NOTES

1. ALL LATERALS ARE 6".
2. ALL CLEAN OUT CAPS ARE TO BE TRAFFIC RATED.

ALL SEWER LOCATED OUTSIDE OF ANY PUBLIC RIGHT-OF-WAY AND ANY PUBLIC SEWER EASEMENT IS PRIVATE SEWER PER UPC.

FOR ALL WATER MAINS/LATERALS THAT CROSS UNDER SEWER MAINS/LATERALS, OR WITH LESS THAN 18" ABOVE NEED TO BE BUILT PER UDACS/ 2.19.02B3a.

VTT


NORTH

GRAPHIC SCALE



1" = 30'

KEY MAP

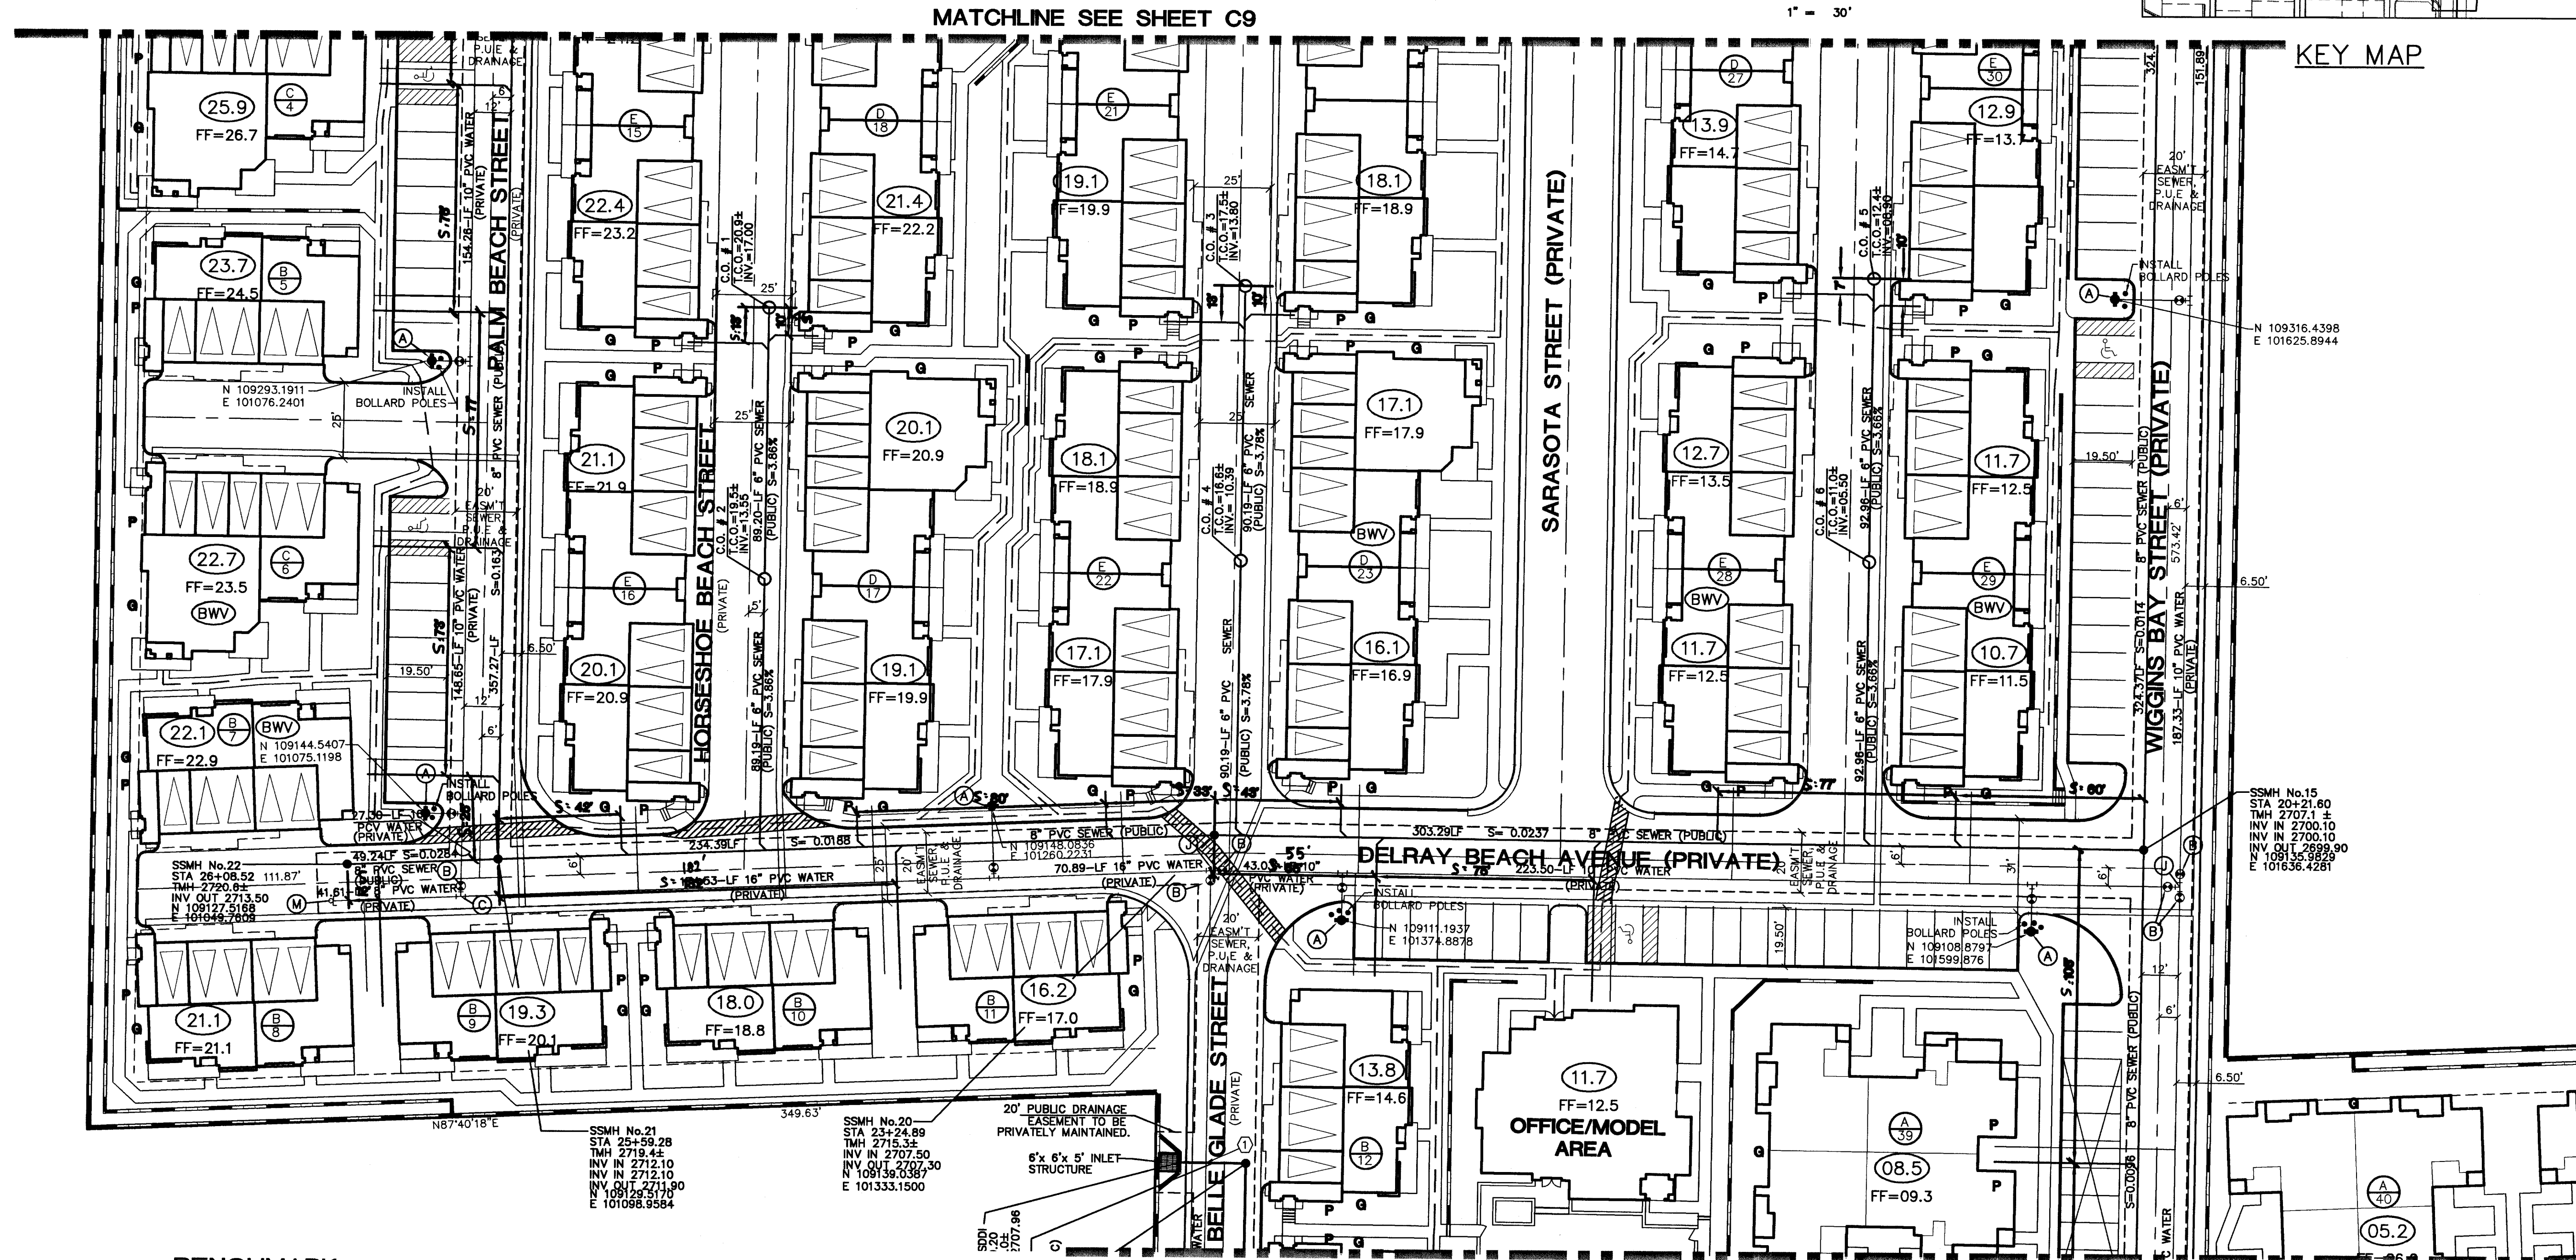

BENCHMARK

PROJECT VERTICAL DATUM: NAVD88
CLARK COUNTY BENCHMARK # 1000-654
NAVD88 ELEV: 782.992 METERS (2601.87 FEET)
(CONVERSION FACTOR 3937/1200 = US SURVEY FEET)

DESCRIPTION:
RIVET AND SQUARE ALUMINUM IN A CONCRETE MONUMENT 50 FEET NORTH AND 25 FEET WEST OF GRAND CANYON DRIVE AND ALEXANDER ROAD.

BASIS OF BEARINGS:

NORTH 00 42'58" EAST, BEING THE EAST LINE OF THE NORTHEAST QUARTER (NE 1/4) OF SECTION 12, TOWNSHIP 20 SOUTH, RANGE 59 EAST, M.D.M., CLARK COUNTY, NEVADA, AS SHOWN ON THAT CERTAIN MAP ON FILE IN THE OFFICE OF THE COUNTY RECORDER, CLARK COUNTY, NEVADA IN FILE 81 OF SURVEYS, AT PAGE 44.

Avoid overhead power line contact

Avoid cutting underground utility lines. It's costly.

Call before you OVERHEAD
1-702-593-6111

Call before you Dig
1-800-227-2600

MATCHLINE SEE SHEET C7

APPROVAL:

LAS VEGAS VALLEY WATER DISTRICT DATE

CITY OF LAS VEGAS FIRE MARSHAL DATE

NEVADA POWER COMPANY DATE

NEVADA POWER COMPANY APPROVAL IS ONLY FOR THE PLACEMENT AND CLEARANCE OF STREET LIGHT AND SIGNAL LIGHT INSTALLATION. AND CLEARANCE OF STREET LIGHT AND SIGNAL LIGHT INSTALLATION.

WARMINGTON HOMES

SEWER ASBUILT

DRAWN BY: 12/9/2004

DESIGNED BY:

CHECKED BY:

PROJECT NO: 5829

SCALE: 1"=30'

HORIZ. NA

VERT. NA

LONE MOUNTAIN CONDOMINIUMS

CITY OF LAS VEGAS

2727 SOUTH RAINBOW BOULEVARD LAS VEGAS, NEVADA 89146-5146
PH. (702) 873-7550 FAX (702) 362-2597

PLANNERS • LAND SURVEYORS

REVISION

DATE

BY

REV

1

2

4

6

7

8

272