

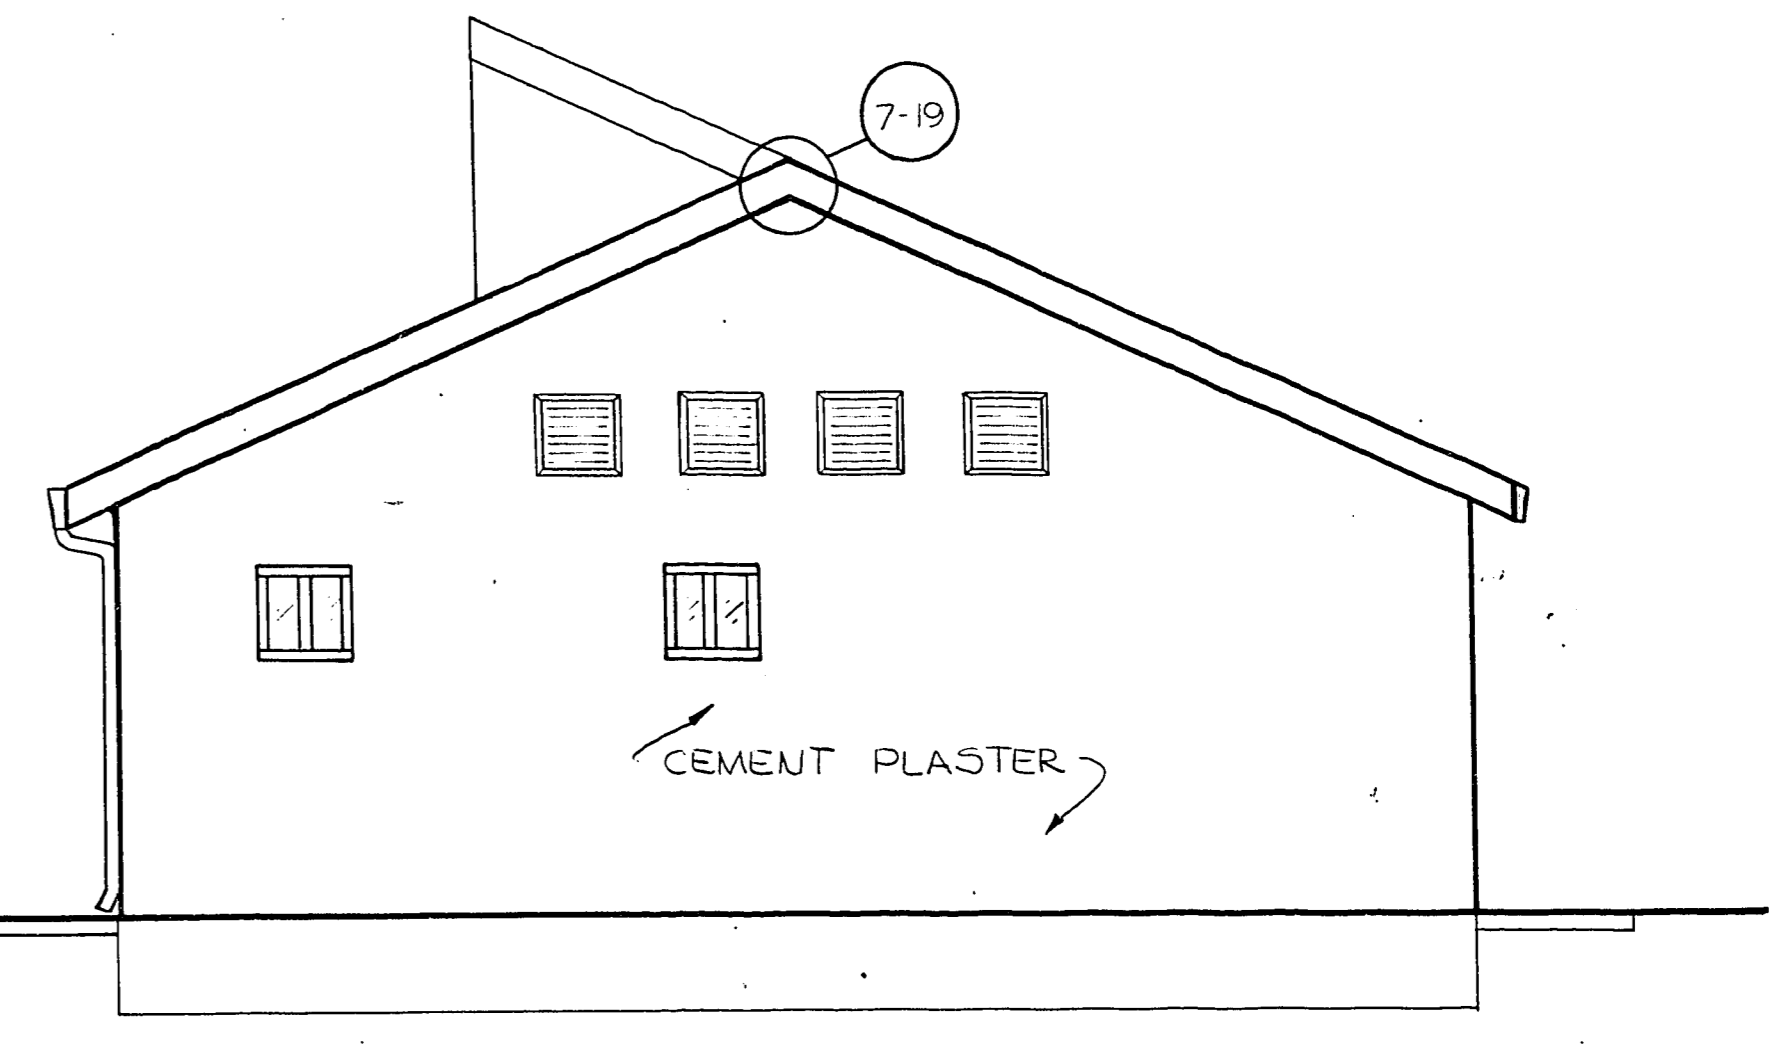



WEST ELEVATION
SCALE: 1/4" = 1'-0"

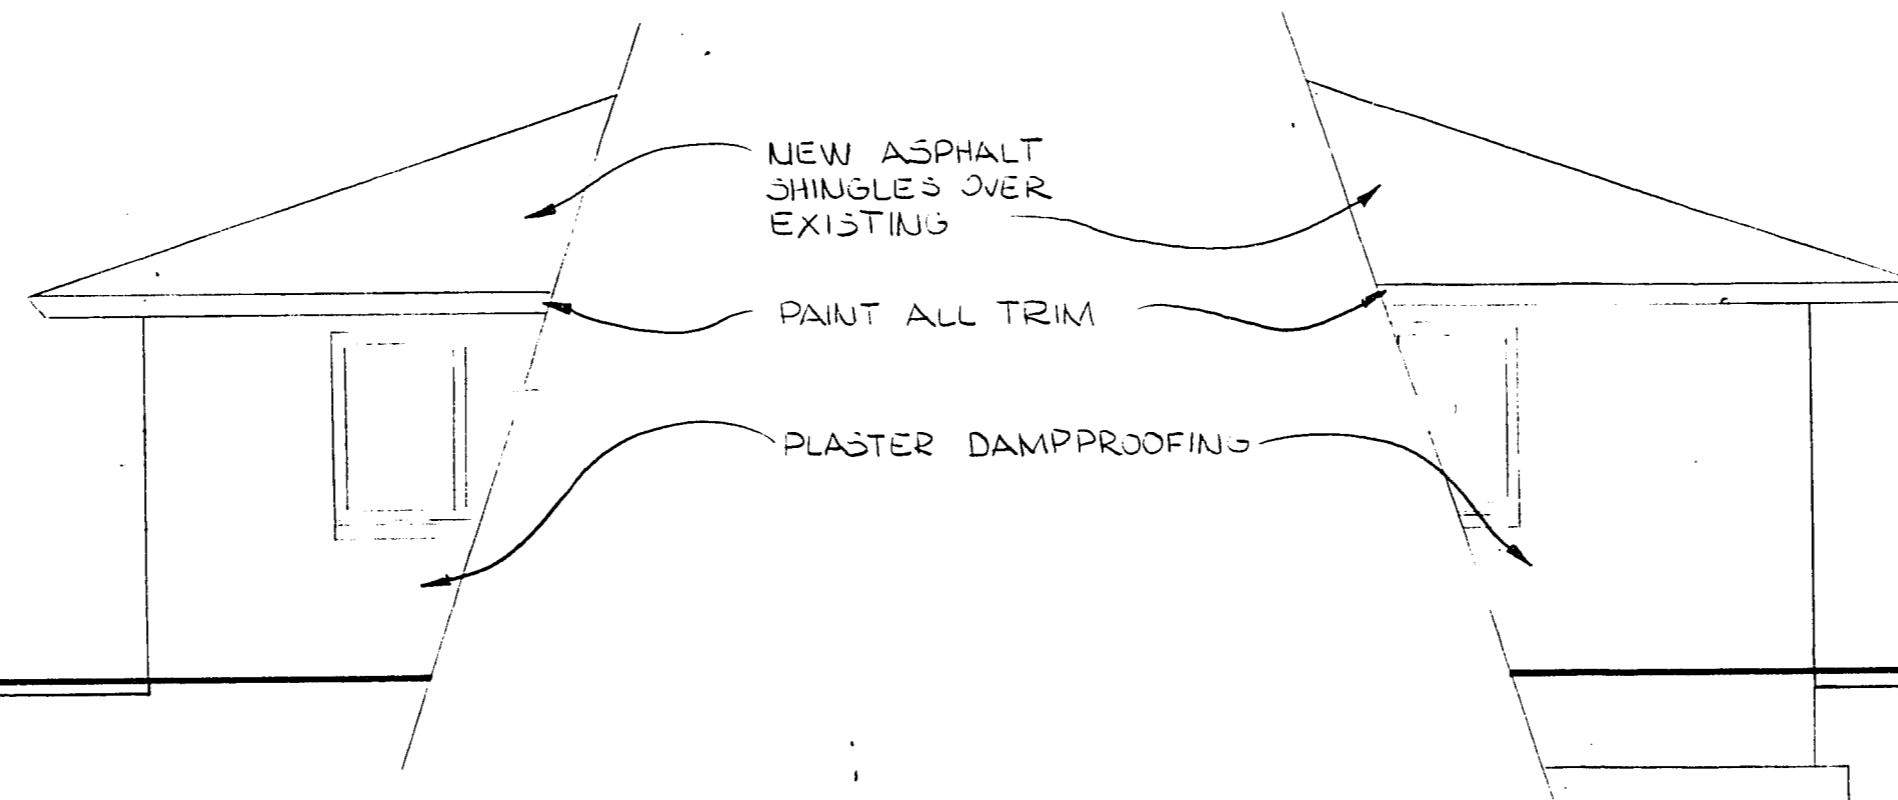



EAST ELEVATION
SCALE: 1/4" = 1'-0"

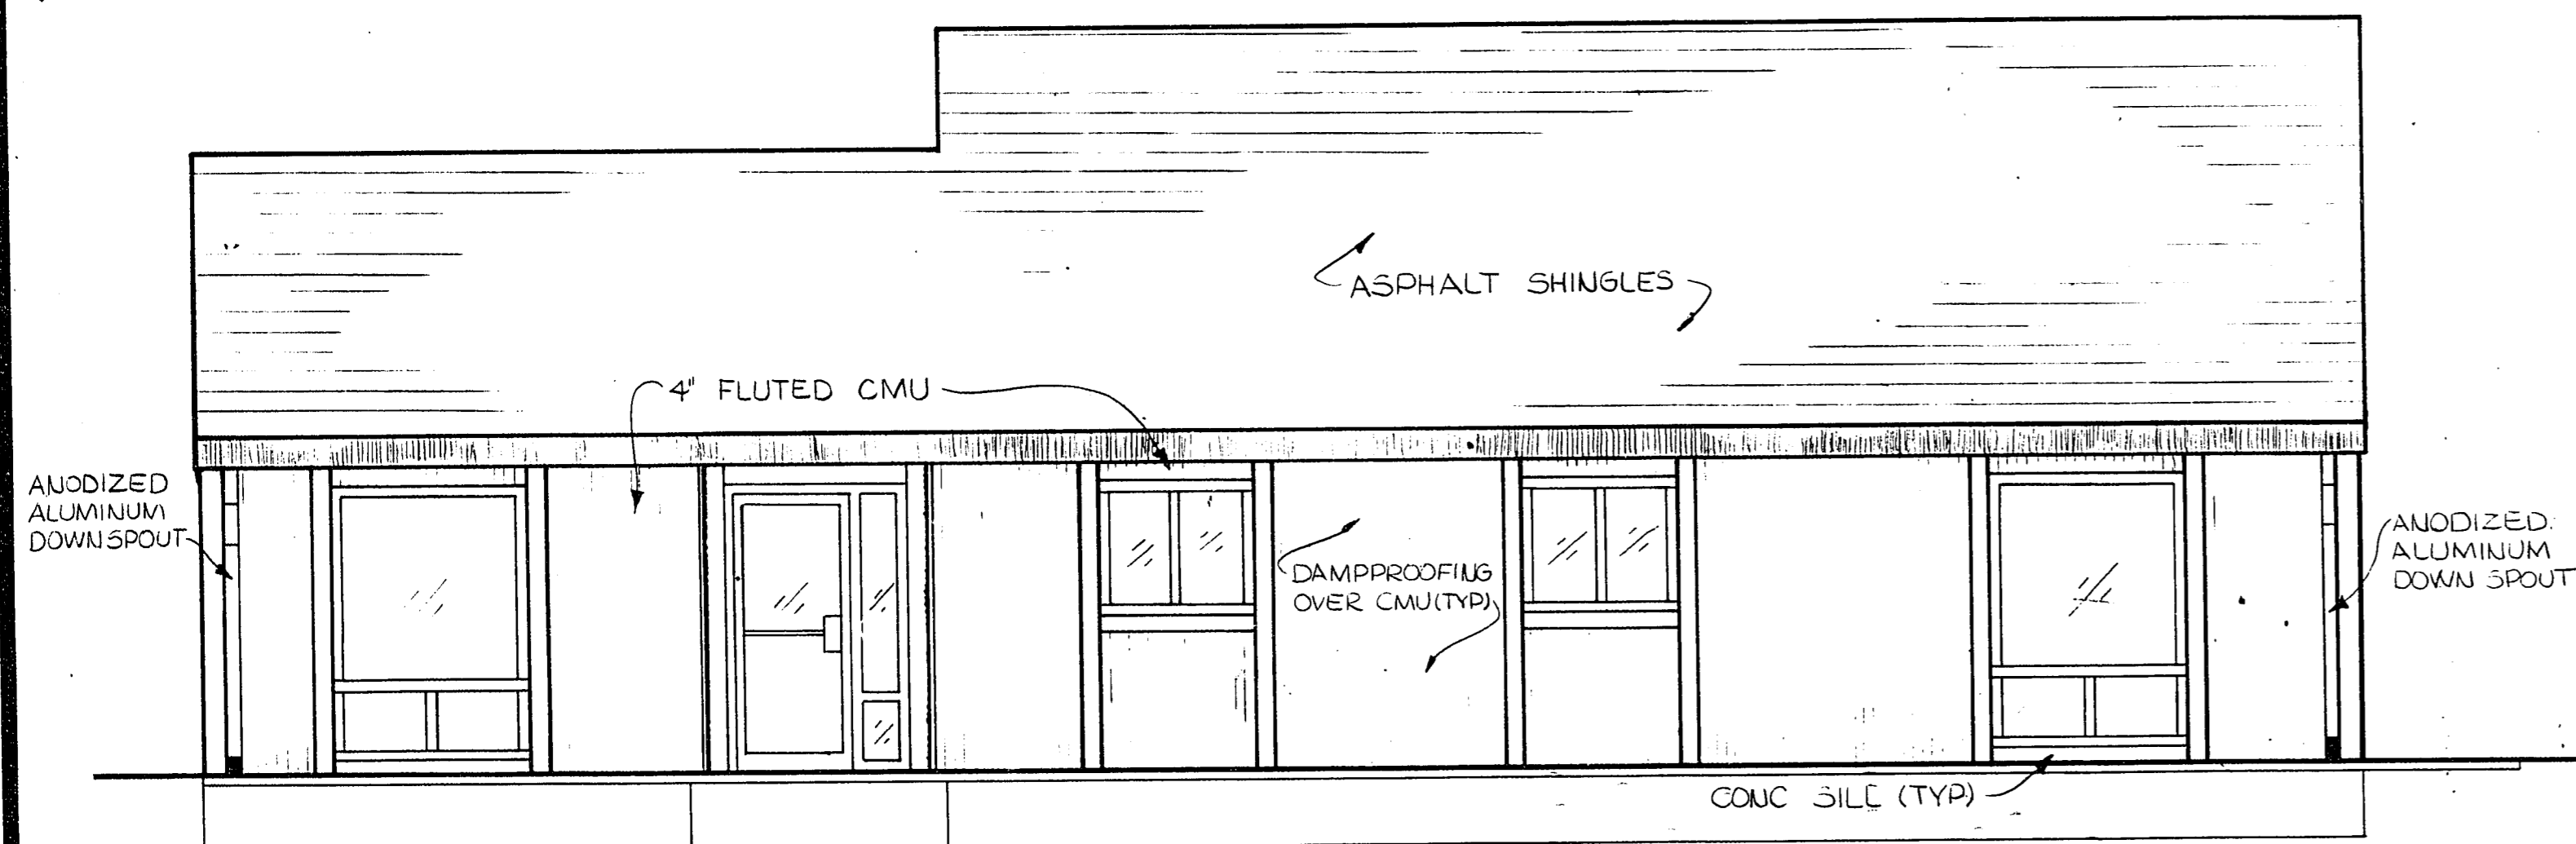

NORTH ELEVATION
SCALE: 1/4" = 1'-0"

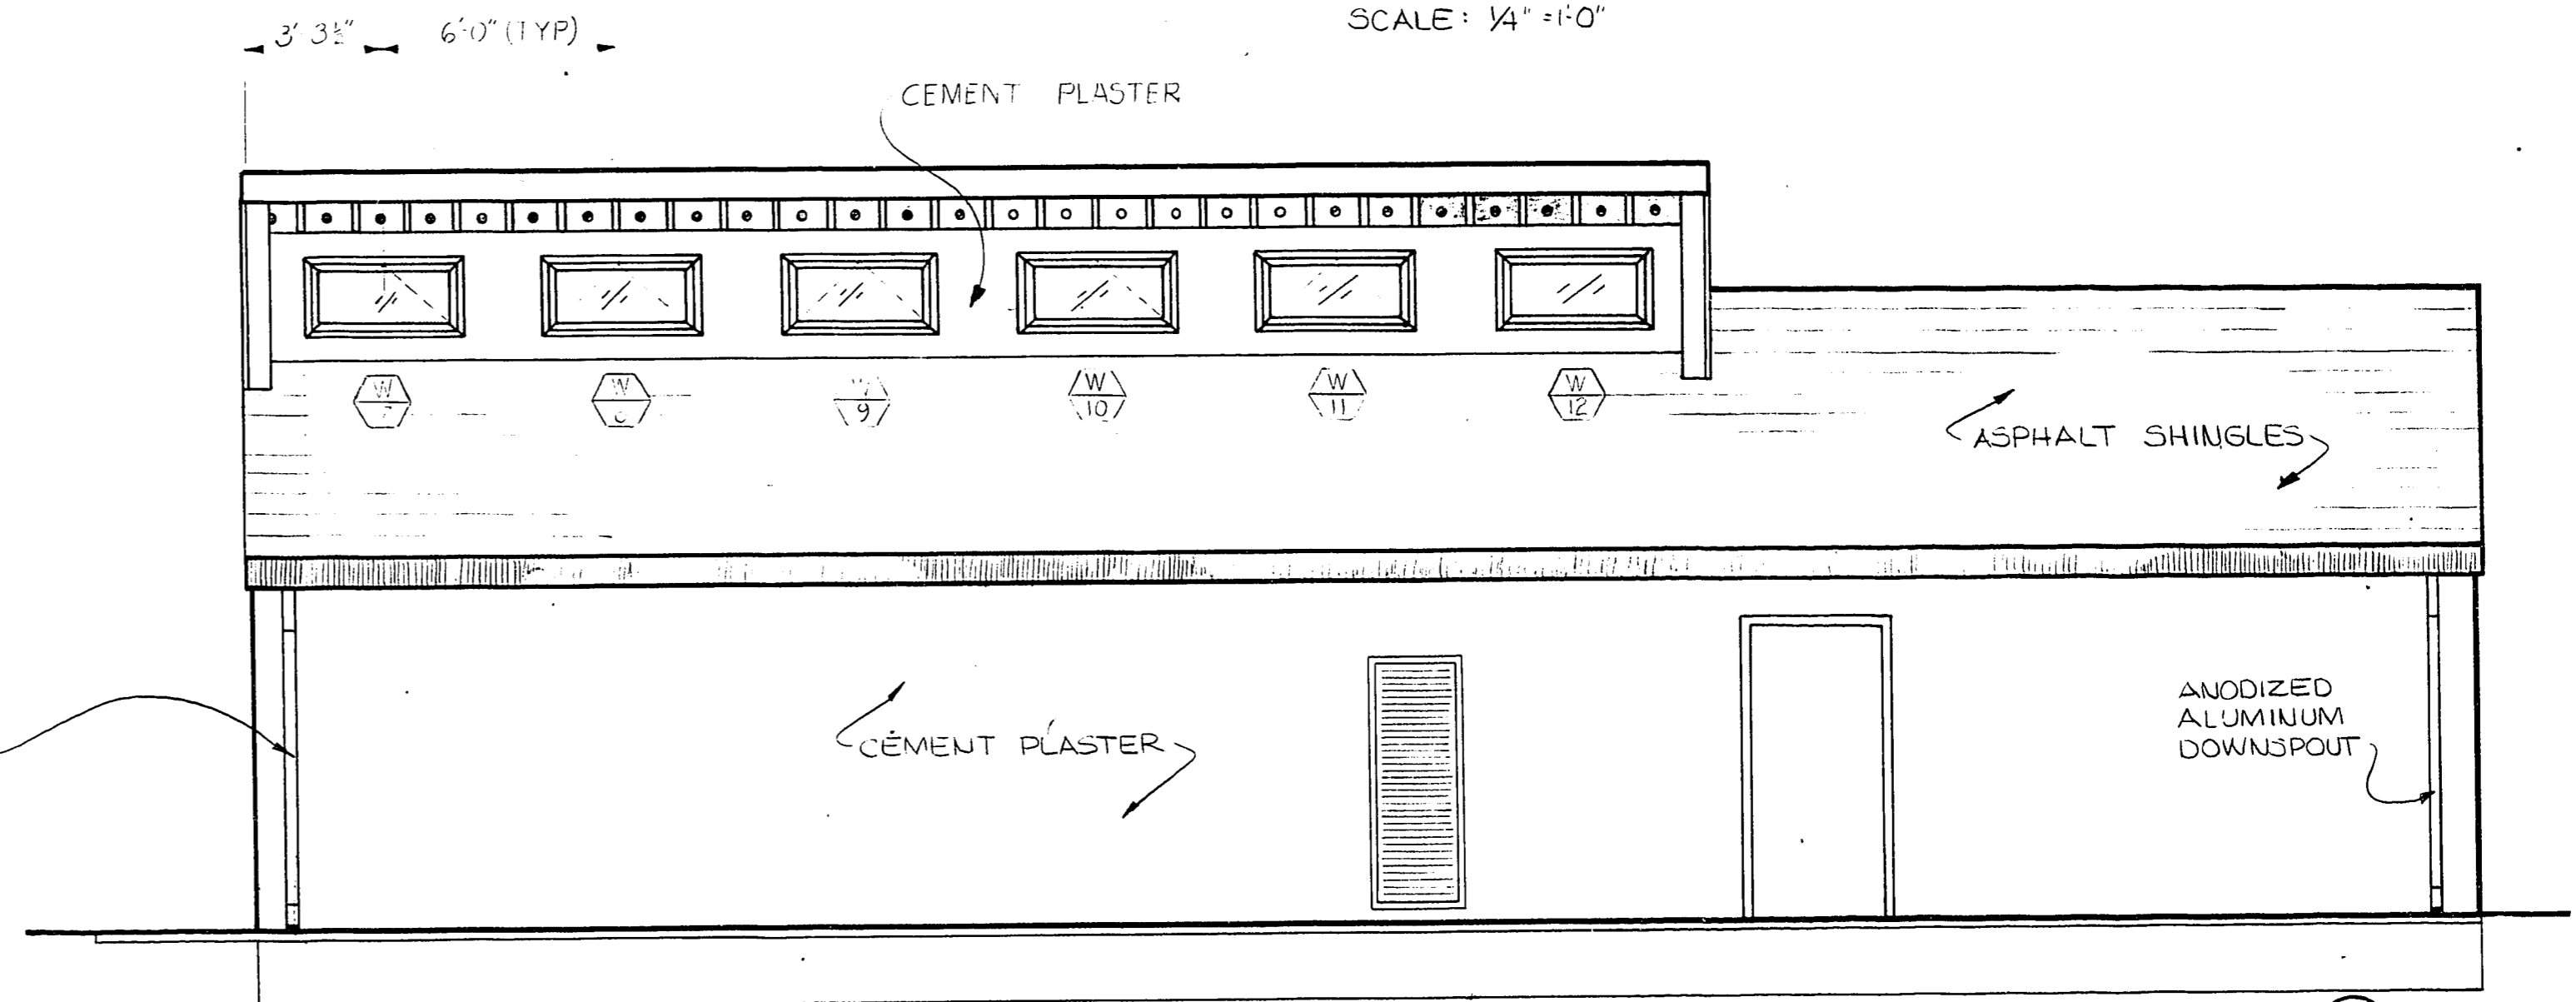


SOUTH ELEVATION
SCALE: 1/4" = 1'-0"

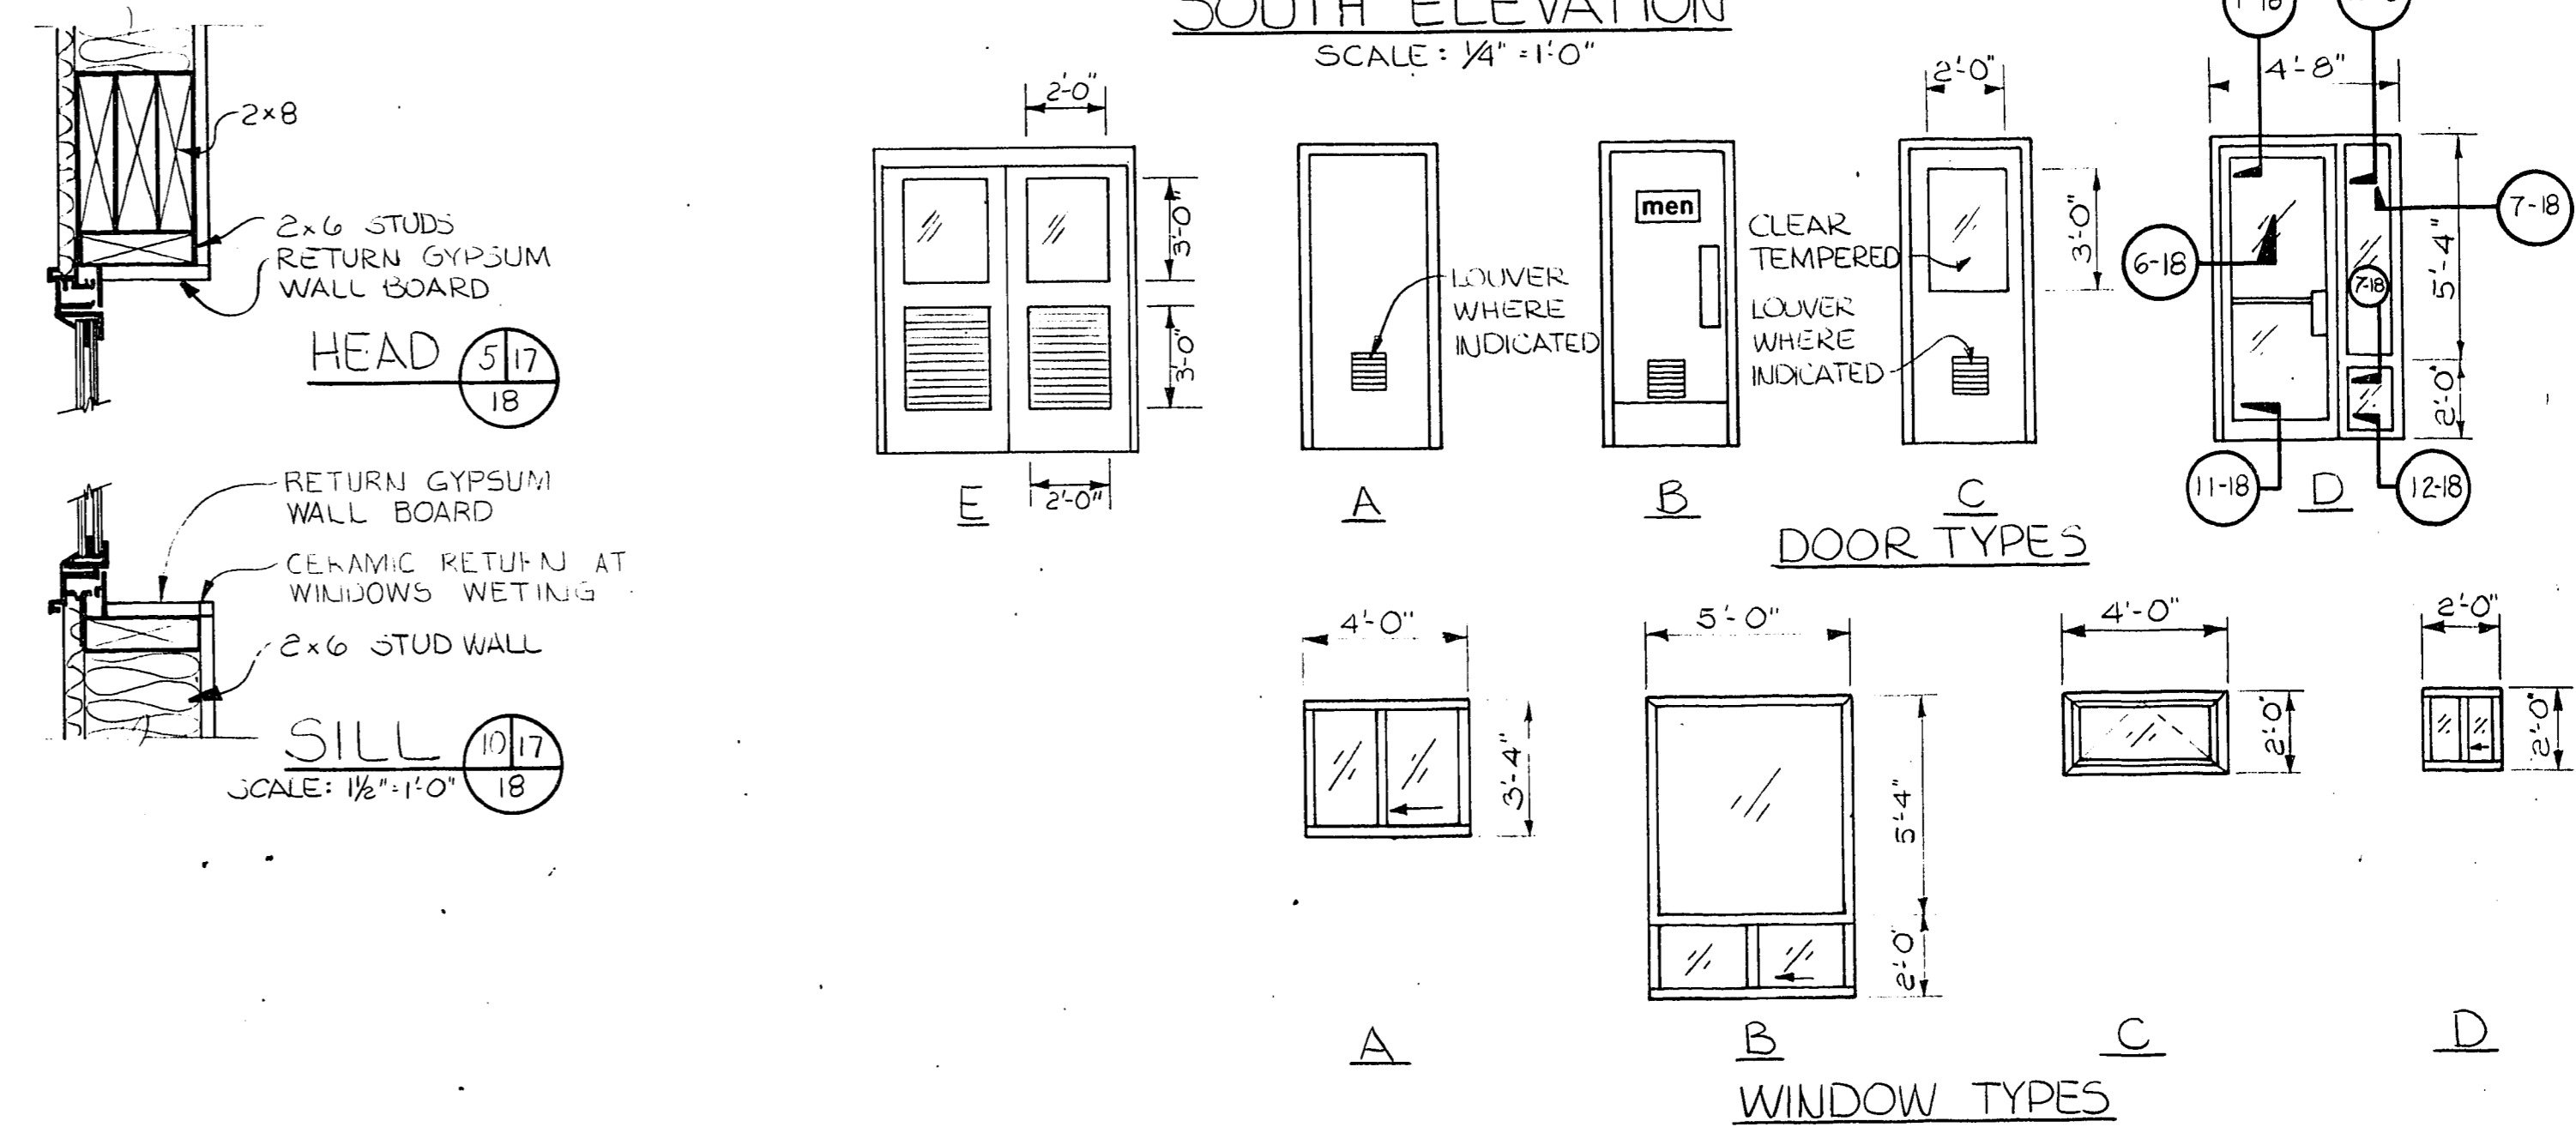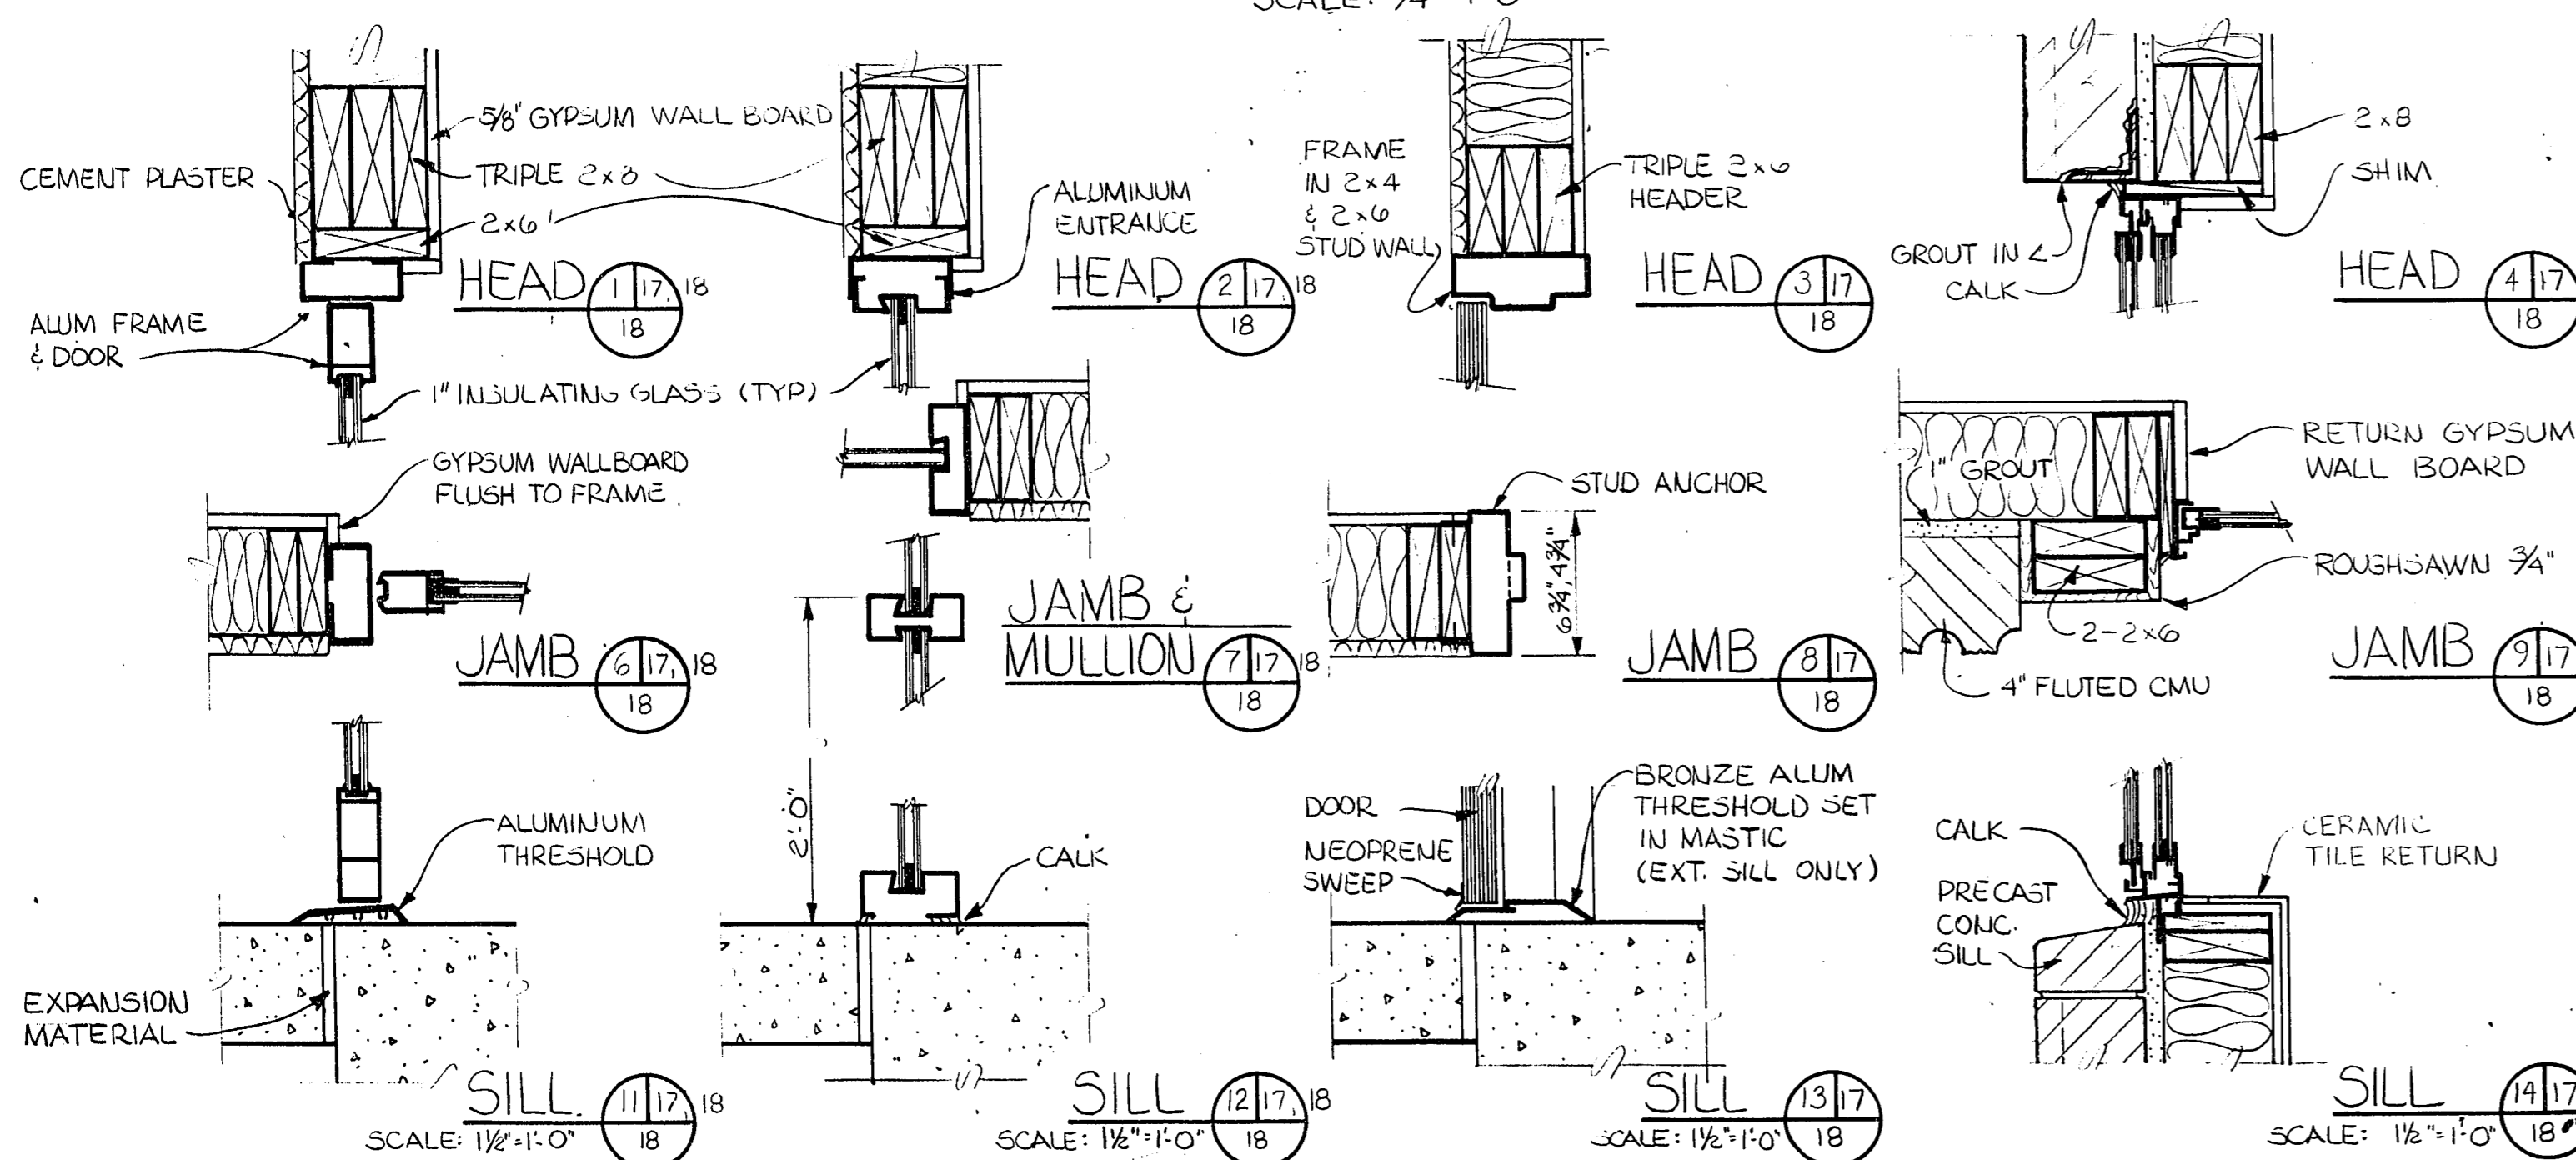

311.5 C

NO.	BY	REVISION	DATE
		AS BUILT	8-11-82
		REVIEW CORRECTIONS & UPDATING	9-8-80

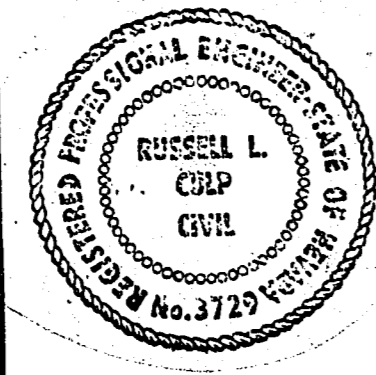

Designed DAP PROJECT NO. 396
 Drawn RRL
 Checked LOVO DATE JULY 28, 1980
 Approved [Signature]



CULP/WESNER/CULP
 EL DORADO HILLS, CALIFORNIA
 SANTA ANA, CALIFORNIA

CITY OF LAS VEGAS, NEVADA
 WASTEWATER TREATMENT PLANT
 EXPANSION - CONTRACT NO. 5
 MODIFICATION OF
 SECONDARY SETTLING BASINS,
 DIGESTERS, LABORATORY
 AND CHLORINATION FACILITIES

LABORATORY ADDITIONS
 ELEVATIONS
 DOOR & WINDOW DETAILS

SHEET
18
 OF 40

CONFORMS TO CONSTRUCTION RECORDS

3-1-19