
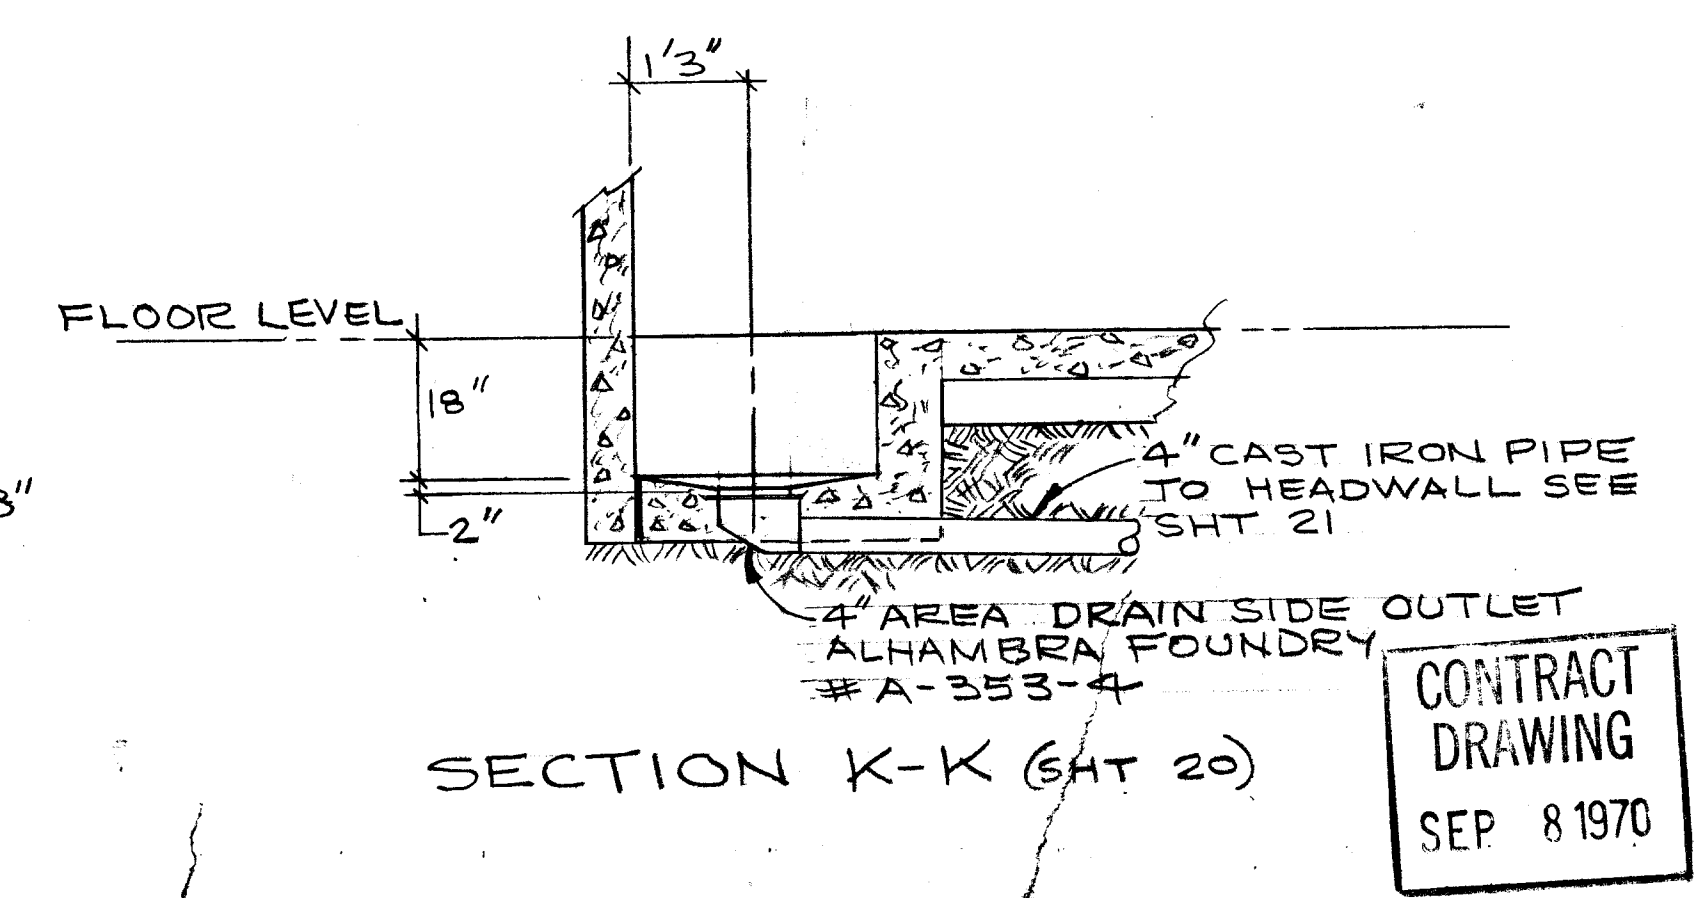
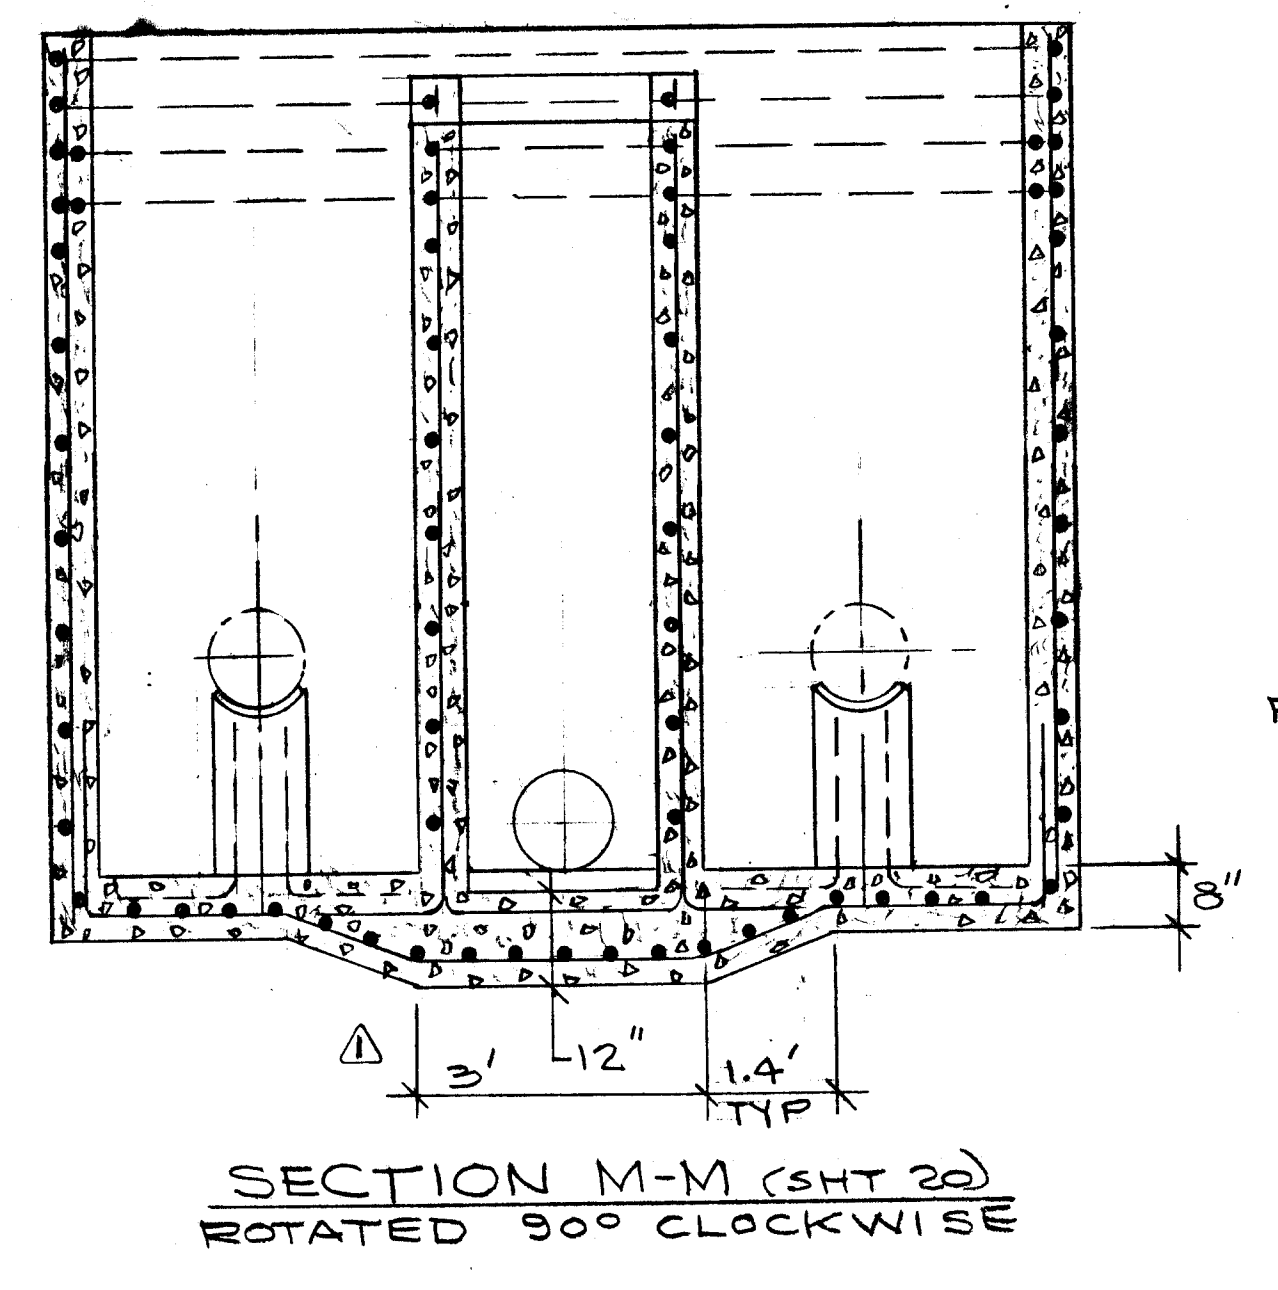
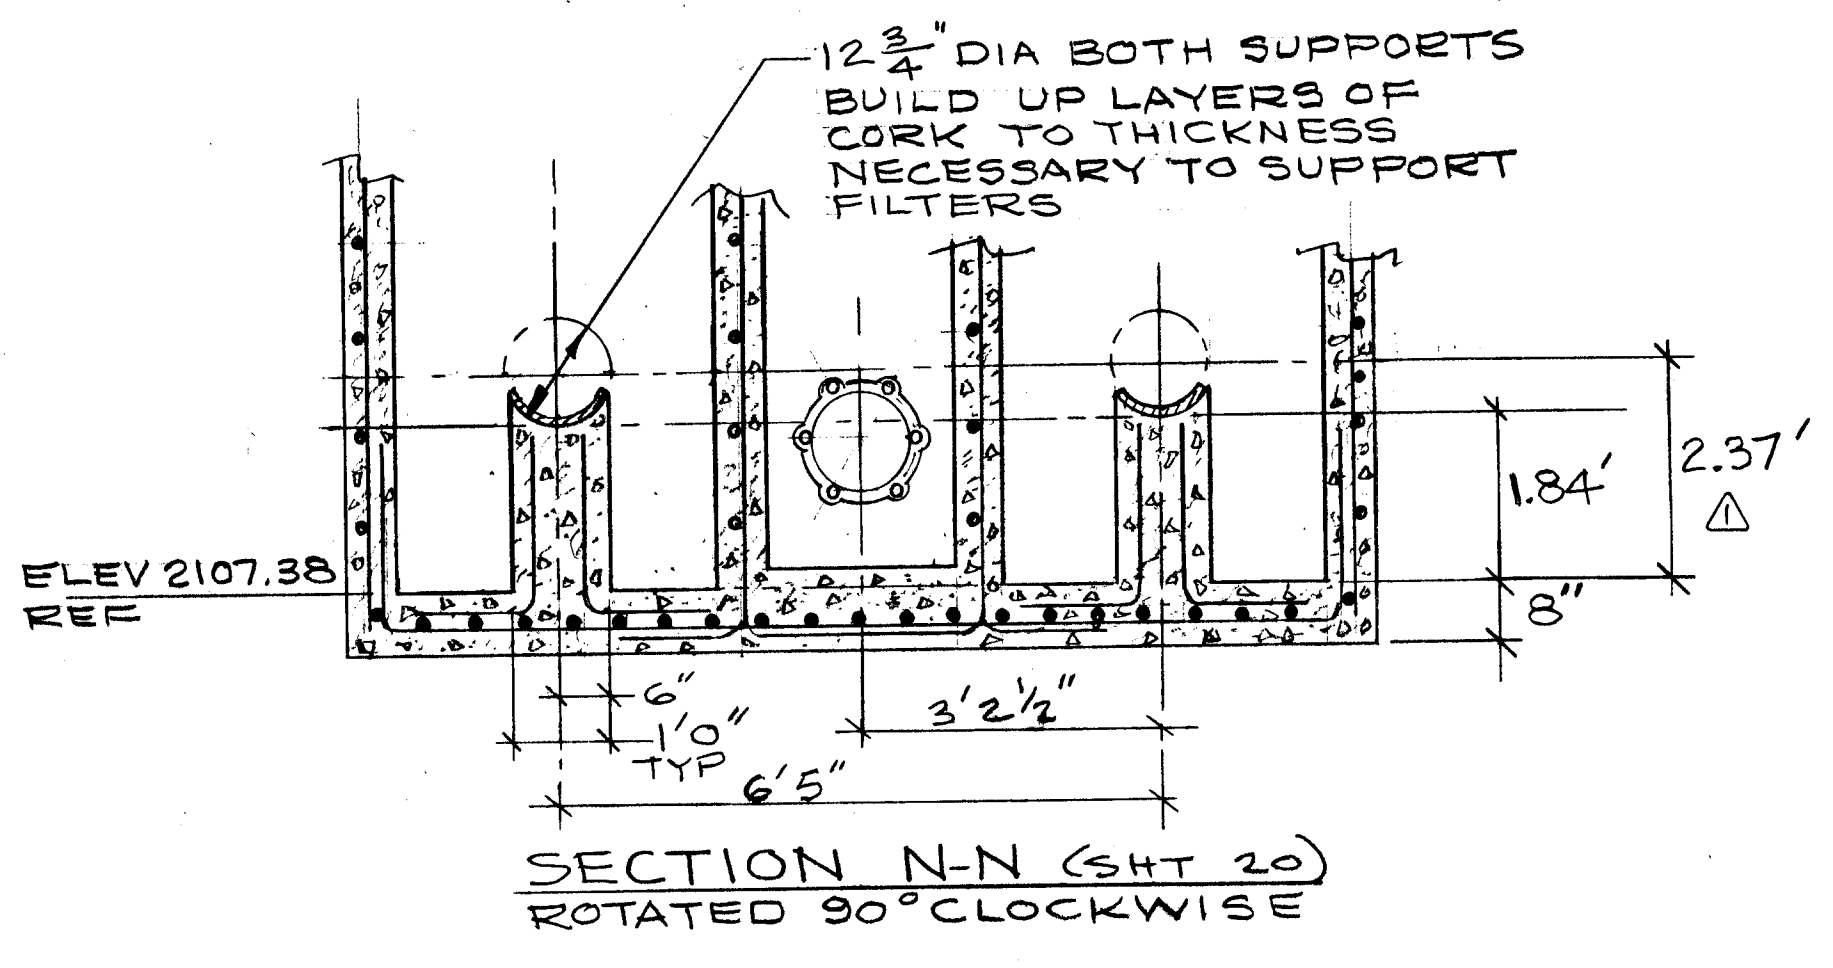
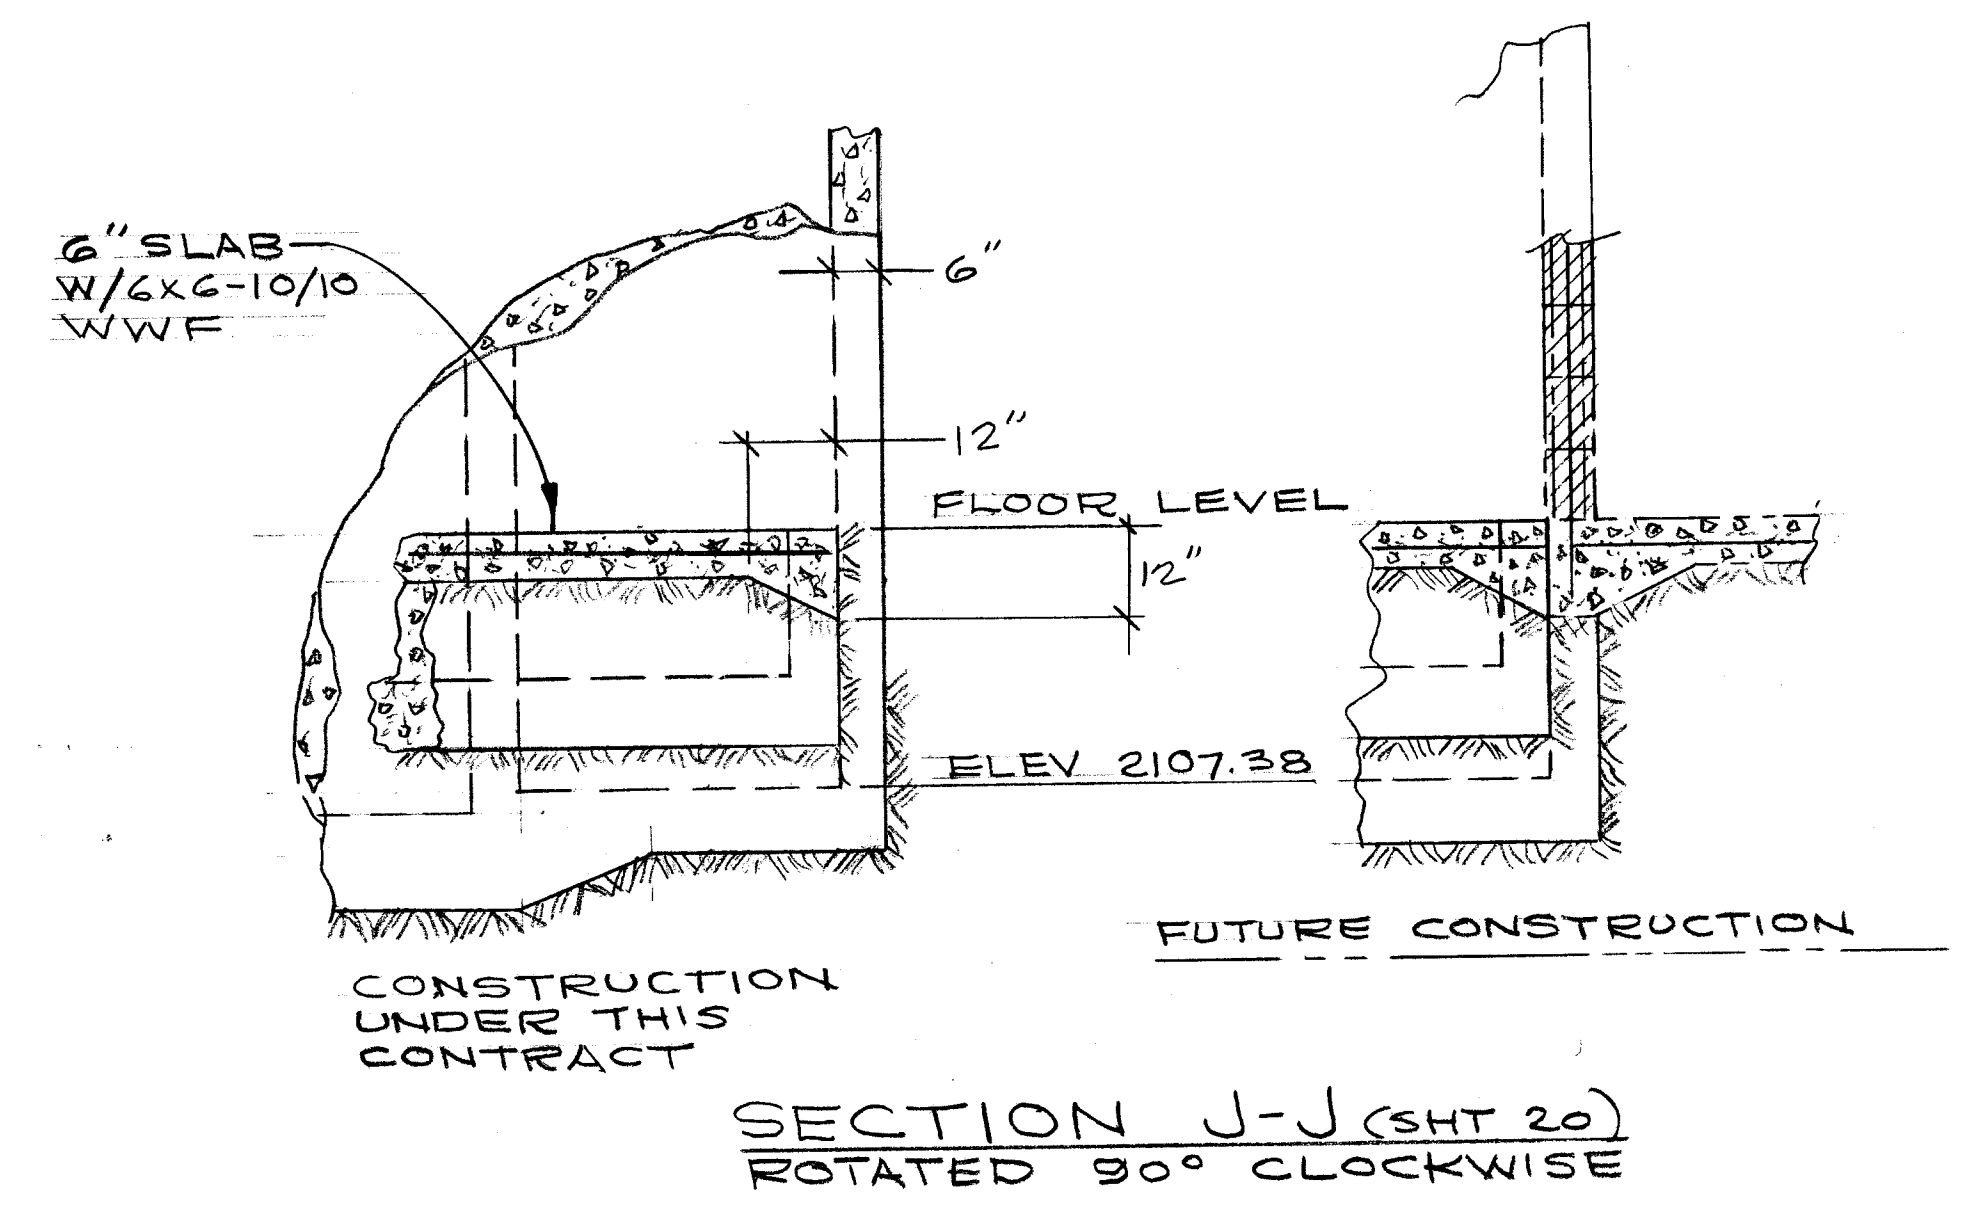


**TYP REINFORCEMENT AT OPENINGS**  
 BEND NORMAL REINFORCEMENT OUT TO CLEAR OPENING. ADD ROOT # UNLESS AS SHOWN. CLEARANCE TO BOTTOM OF BARS AS SHOWN. EXTEND BEYOND BOTTOM OF FLOOR SLAB, BACK INTO SLAB. NO SCALE.

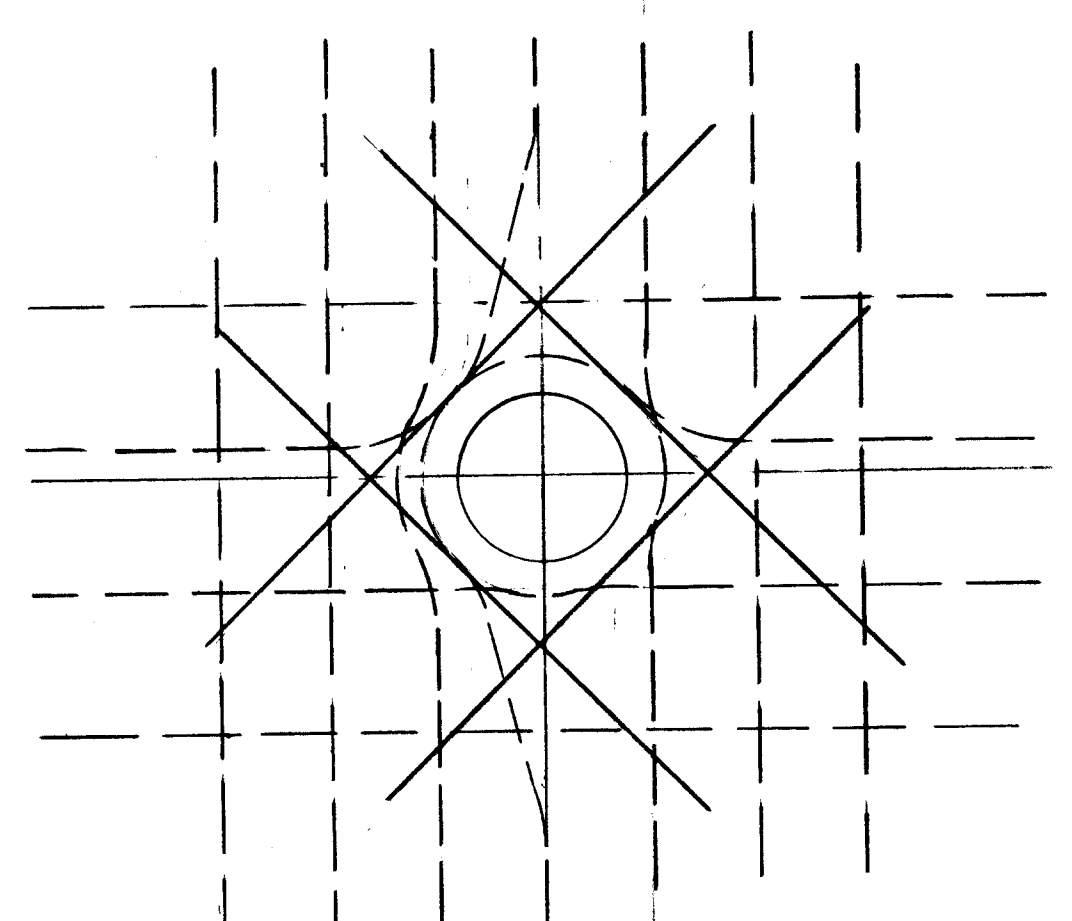

PHASE 1 27-00014  
 PHASE 2 NEV-OSD-7

NO.	DESCRIPTION	BY	DATE	APPROVAL
1	ADDED DIMS & CHG DIMS	DP	3/30/70	
REVISION				
<b>CITY OF LAS VEGAS NEVADA</b>				
DEPARTMENT OF PUBLIC WORKS				
SERVICES DIVISION				
<b>LORENZI PARK</b>				
IRRIGATION-PUMP SYSTEM DETAILS				
W.O. NO. 3111	F.B.K. NO.	DATE	DRAWING NO.	
SC. (H) 1/2" = 1'	SC. (V)	3/8/70	650-19-15	
DES. R. WHITNEY			FILE NO.	
DR. D. FIELDSON				
APPROVED BY DIRECTOR OF PUBLIC WORKS				
<i>DP</i>				
SHEET 23 OF 23				

**CONTRACT DRAWING**  
 SEP 8 1970