


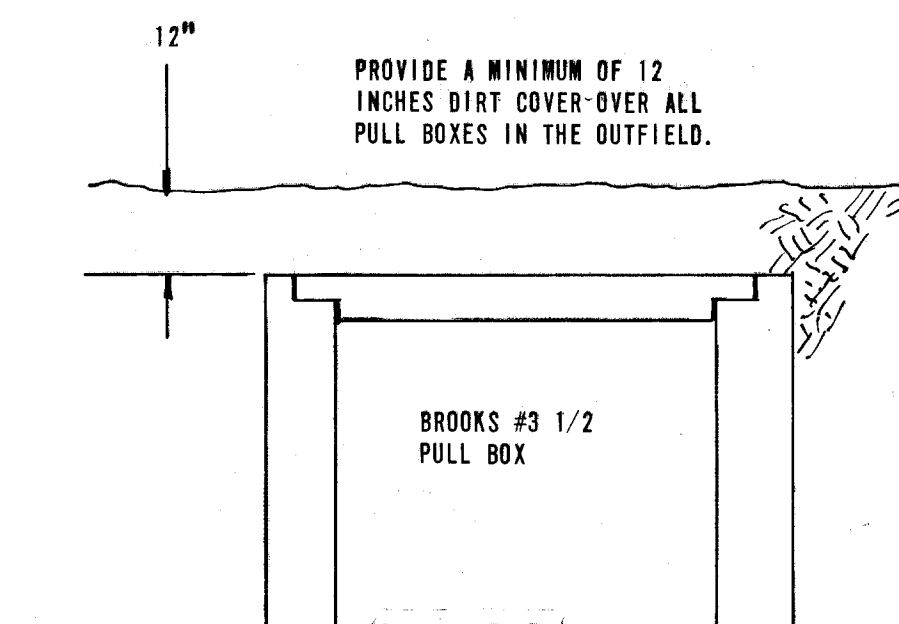


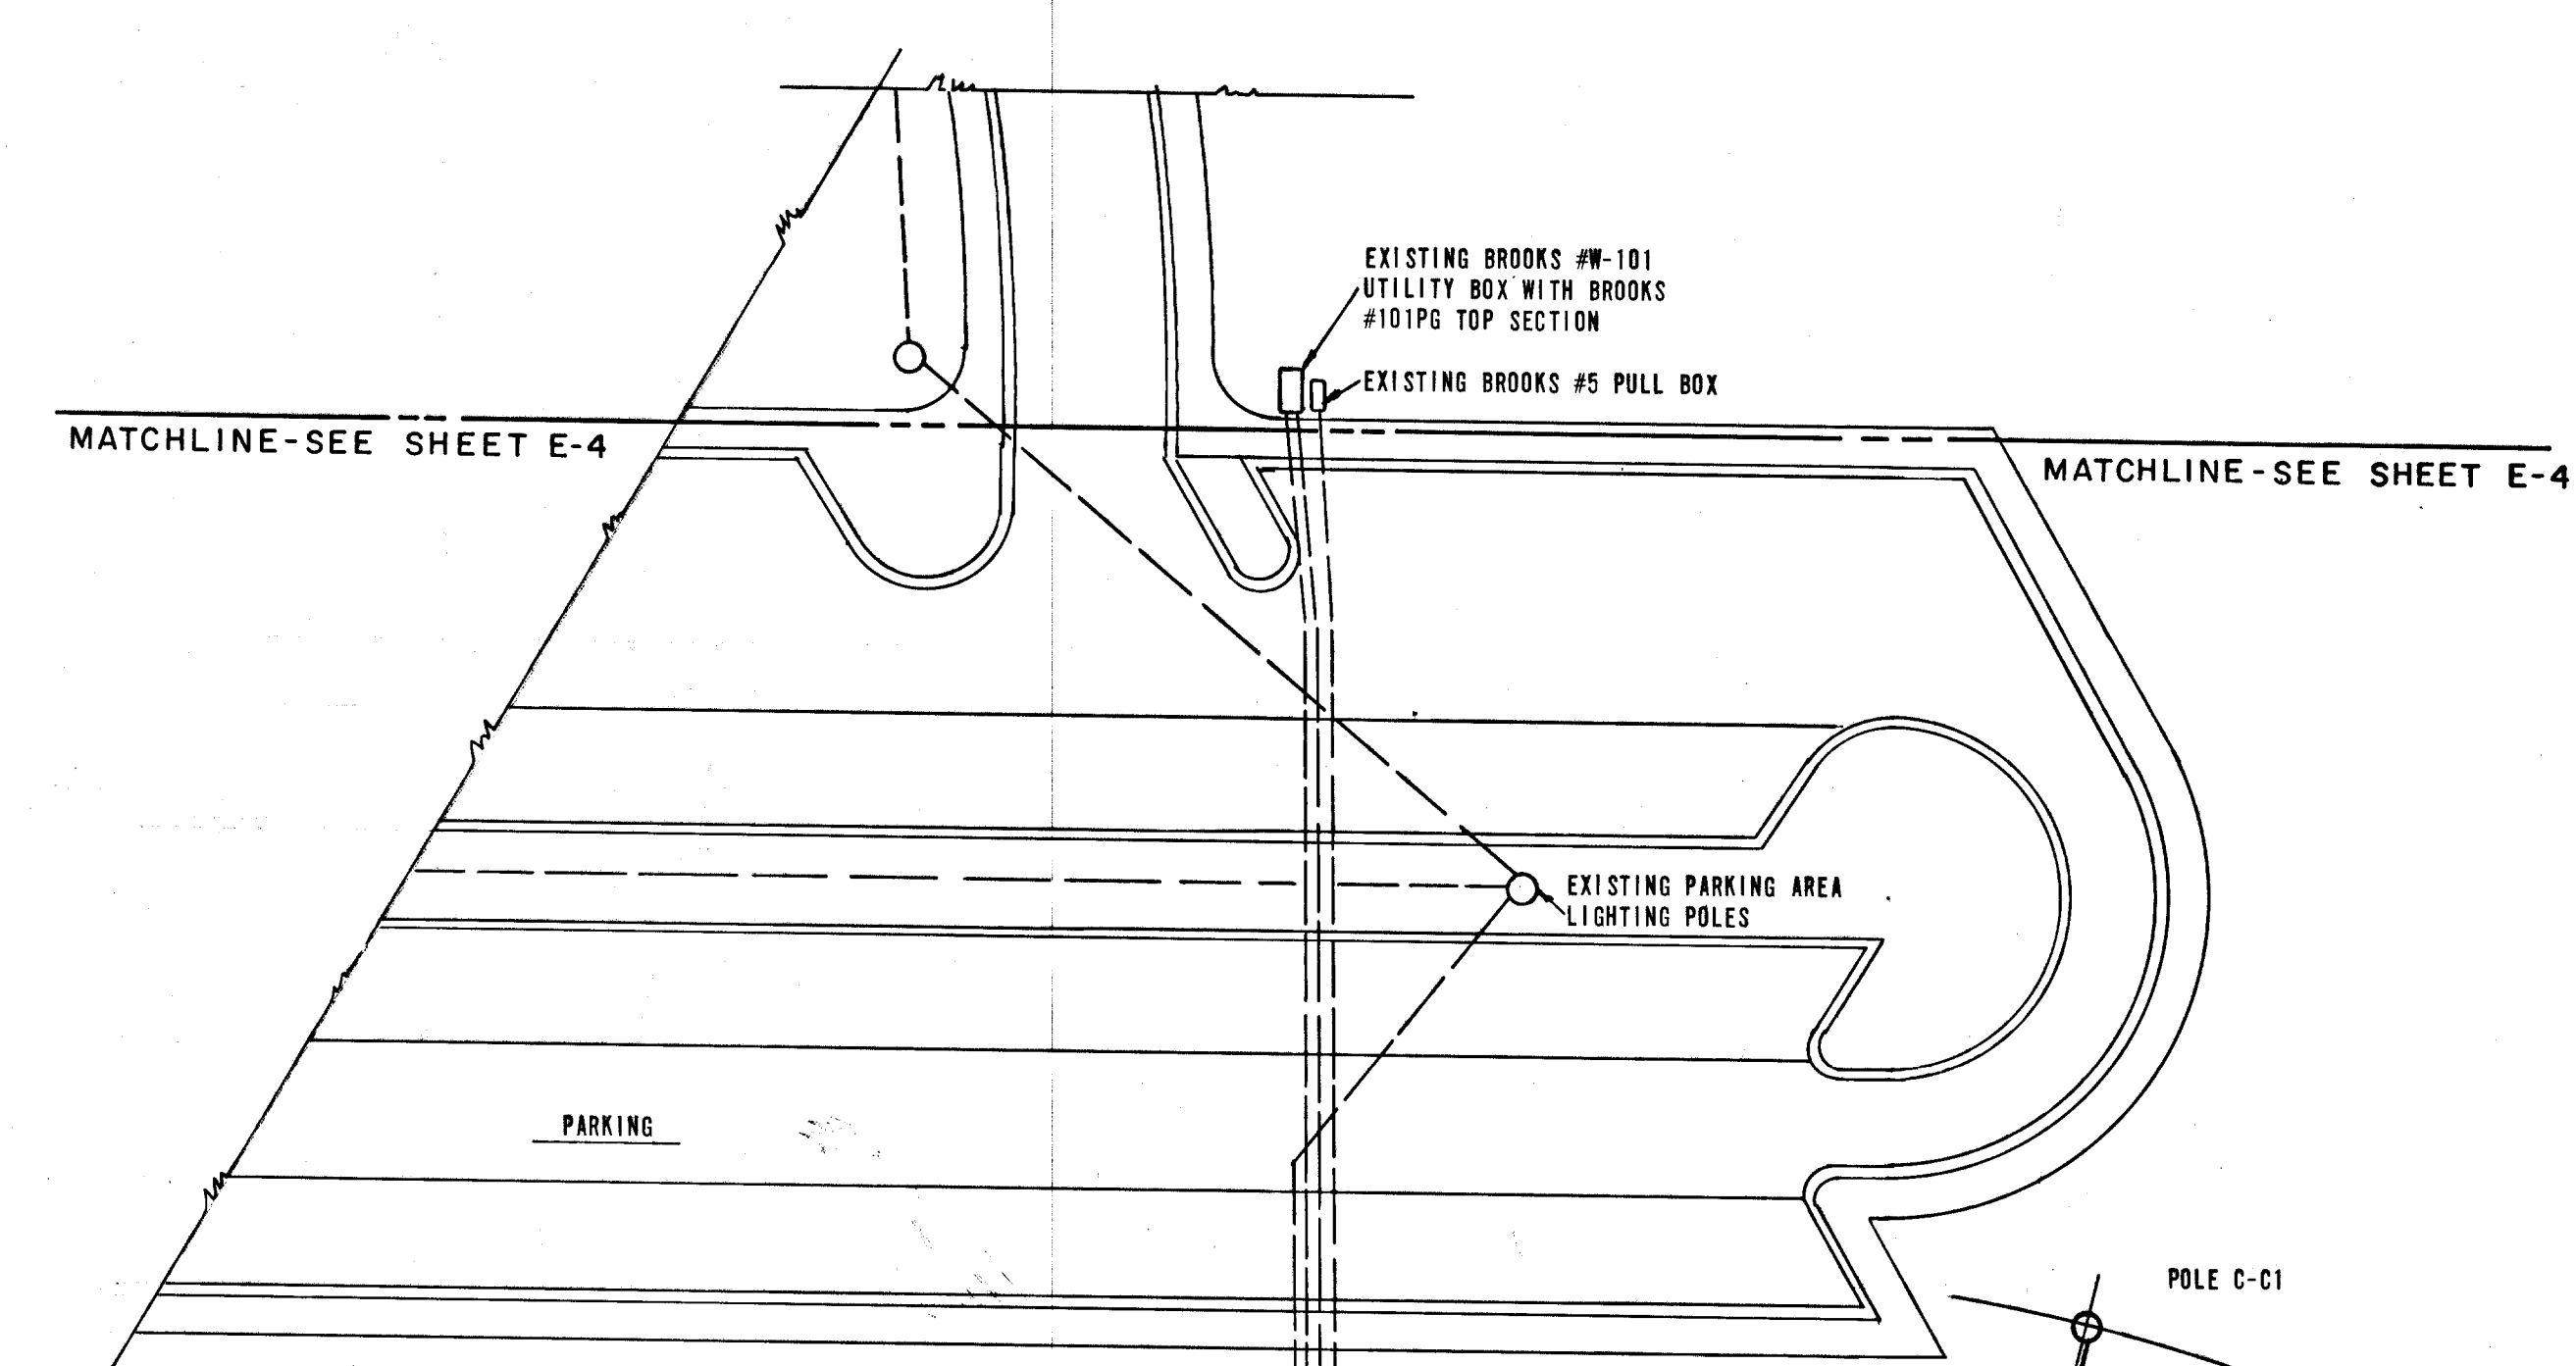

DETAIL 3-AA
NOT TO SCALE

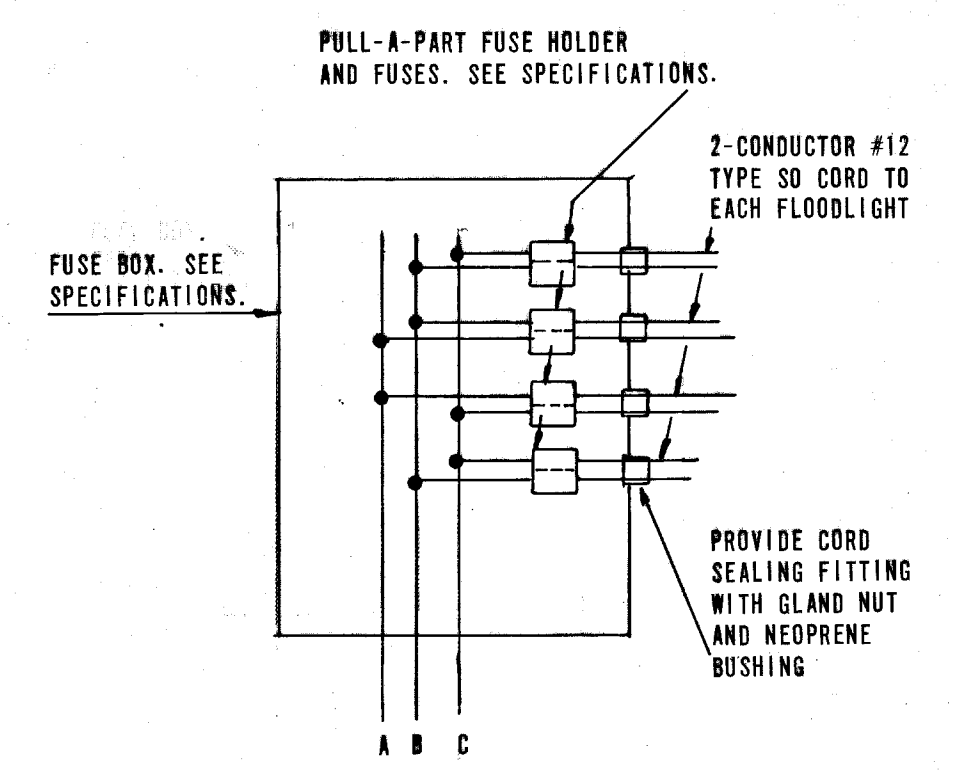

DETAIL 3-BA
NOT TO SCALE

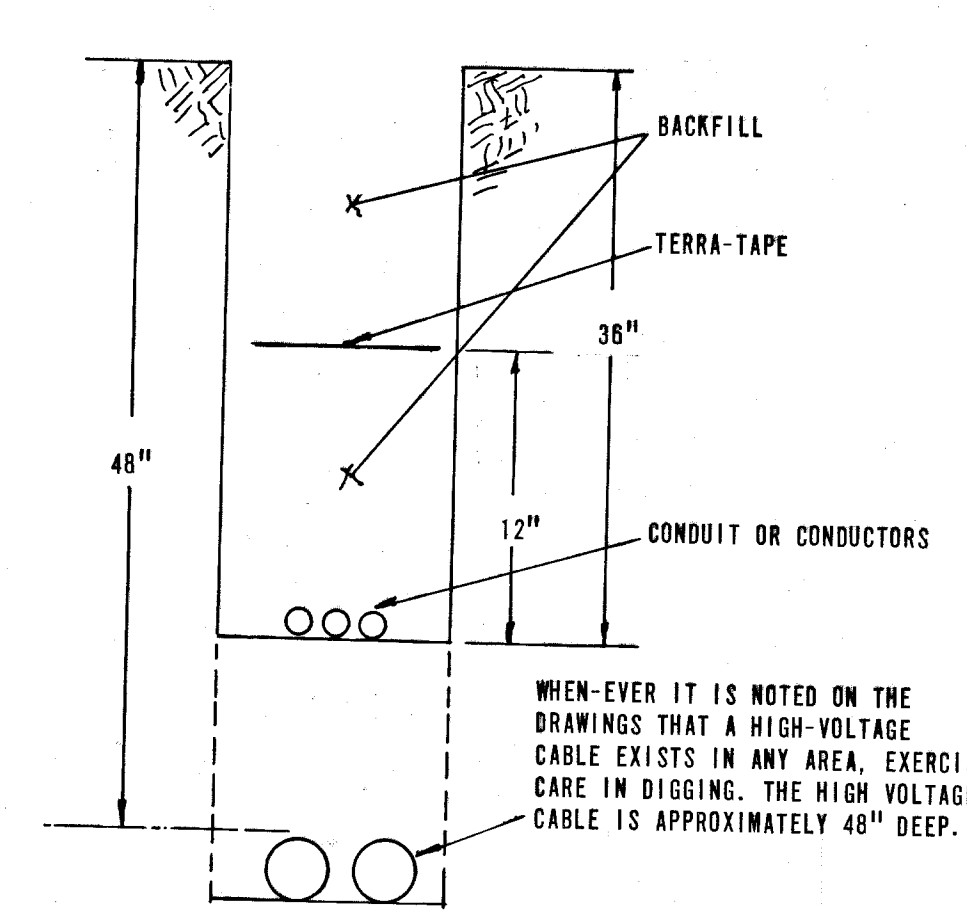

DETAIL 3-CA
NOT TO SCALE
TYPICAL TRENCHING DETAIL
SEE SPECIFICATIONS

CONTRACT
DRAWING
MAR 5 1973

AS BUILT

REV.	DATE	DESCRIPTION	APP.

JOSEPH P. GEOWILL
CONSULTING ENGINEERS
3135 INDUSTRIAL ROAD
LAS VEGAS NEVADA 89102

CITY OF LAS VEGAS NEVADA
DEPARTMENT OF PUBLIC WORKS
SERVICES DIVISION

LORENZI PARK POWER & LIGHTING.
BASEBALL FIELDS ELECTRICAL
PLOT PLAN "B"

DESIGNED BY:	DATE:
DRAWN BY:	1-9-72
CHECKED BY:	DATE
APPROVED: SUPERINTENDENT OF RECREATION	DATE
APPROVED: DIRECTOR OF PUBLIC WORKS	DATE
DWG. NO. 650.19-22	E-3

