
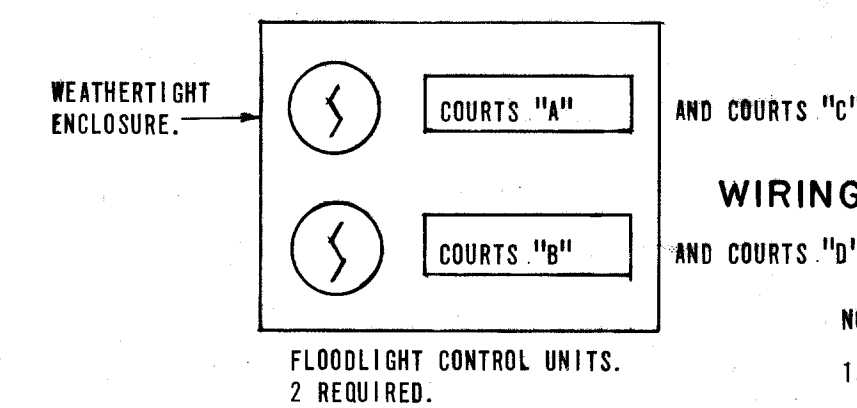
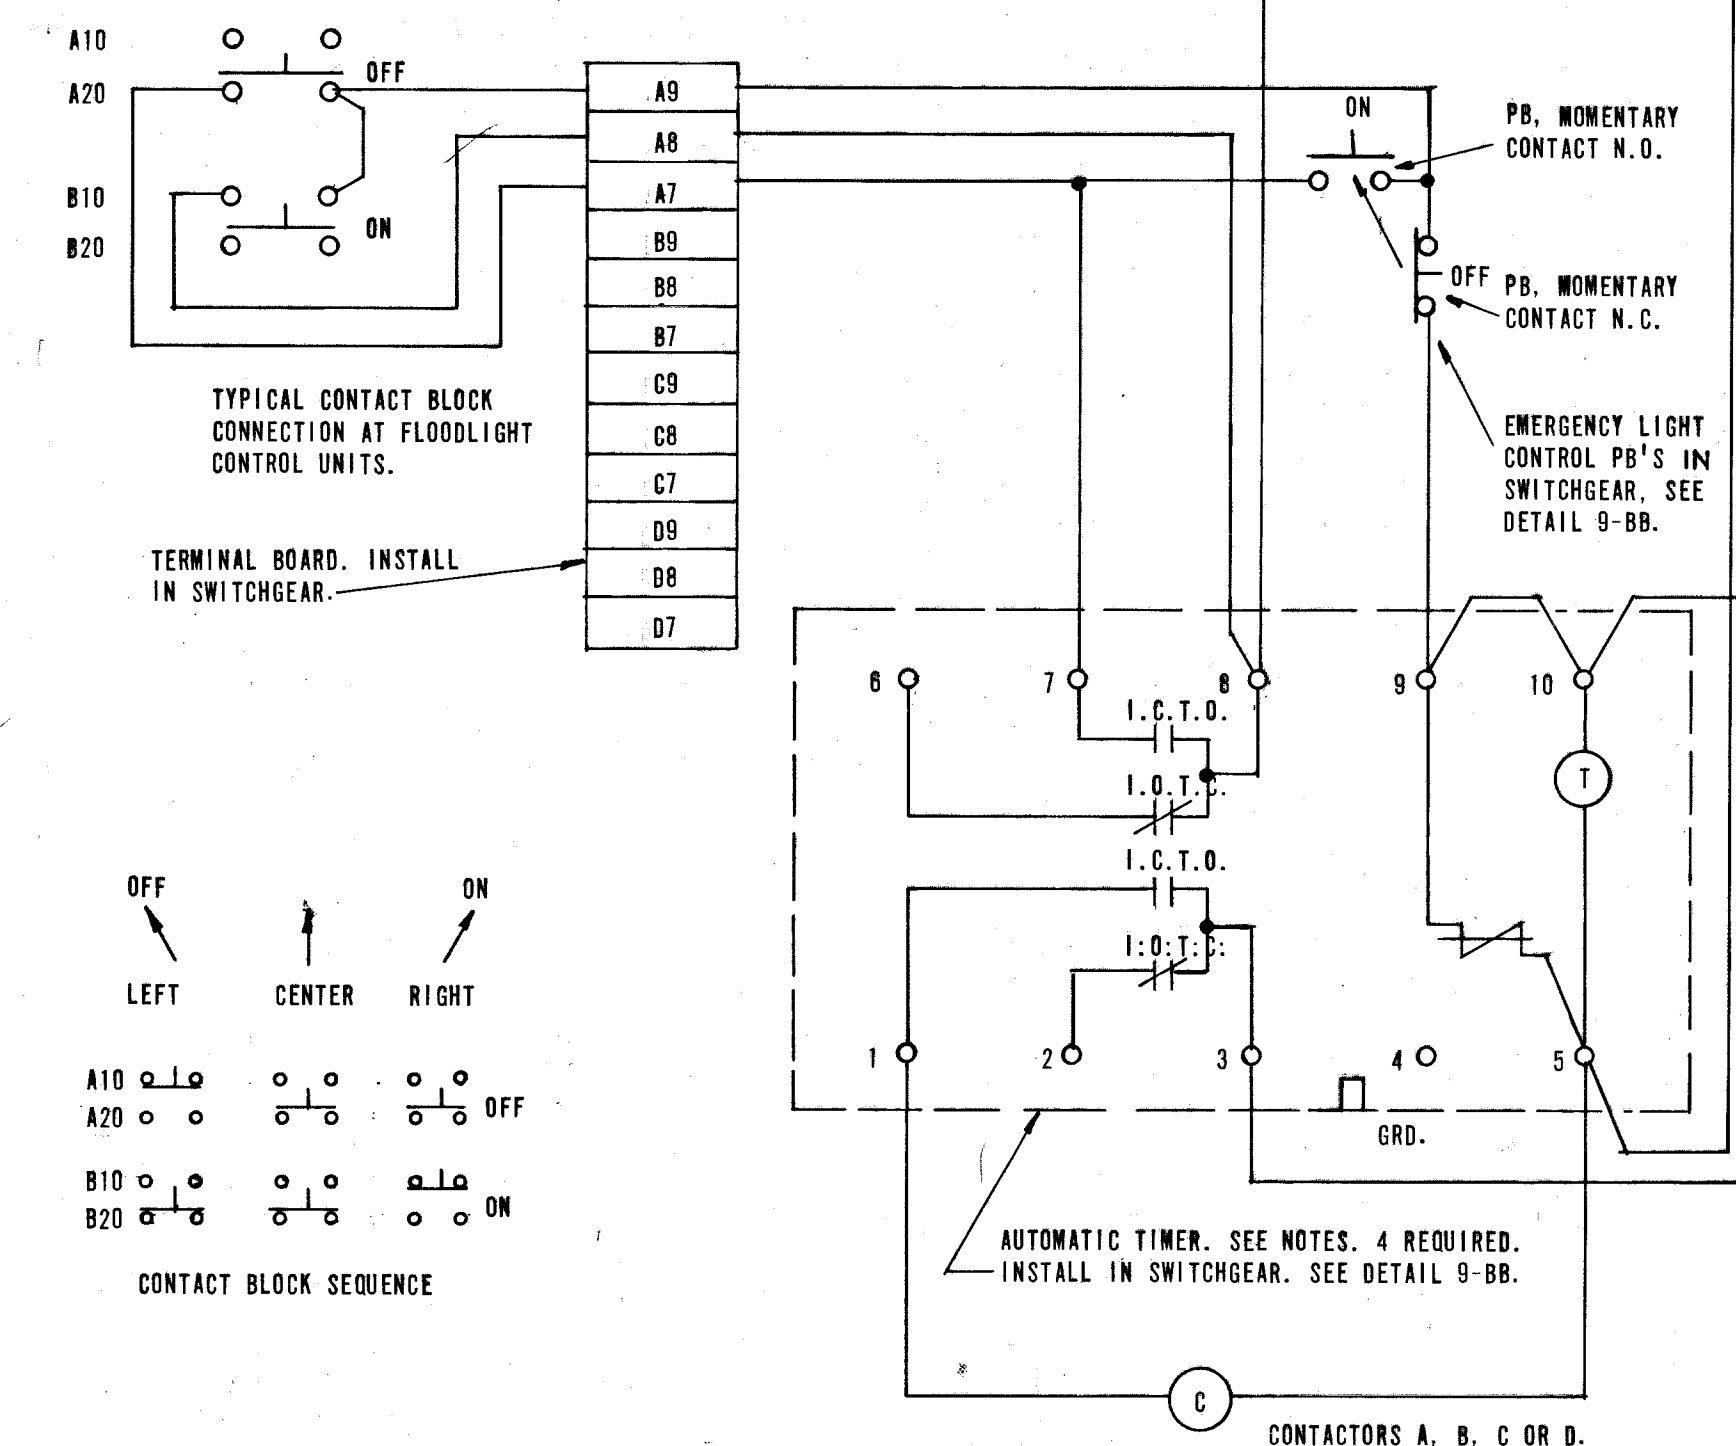
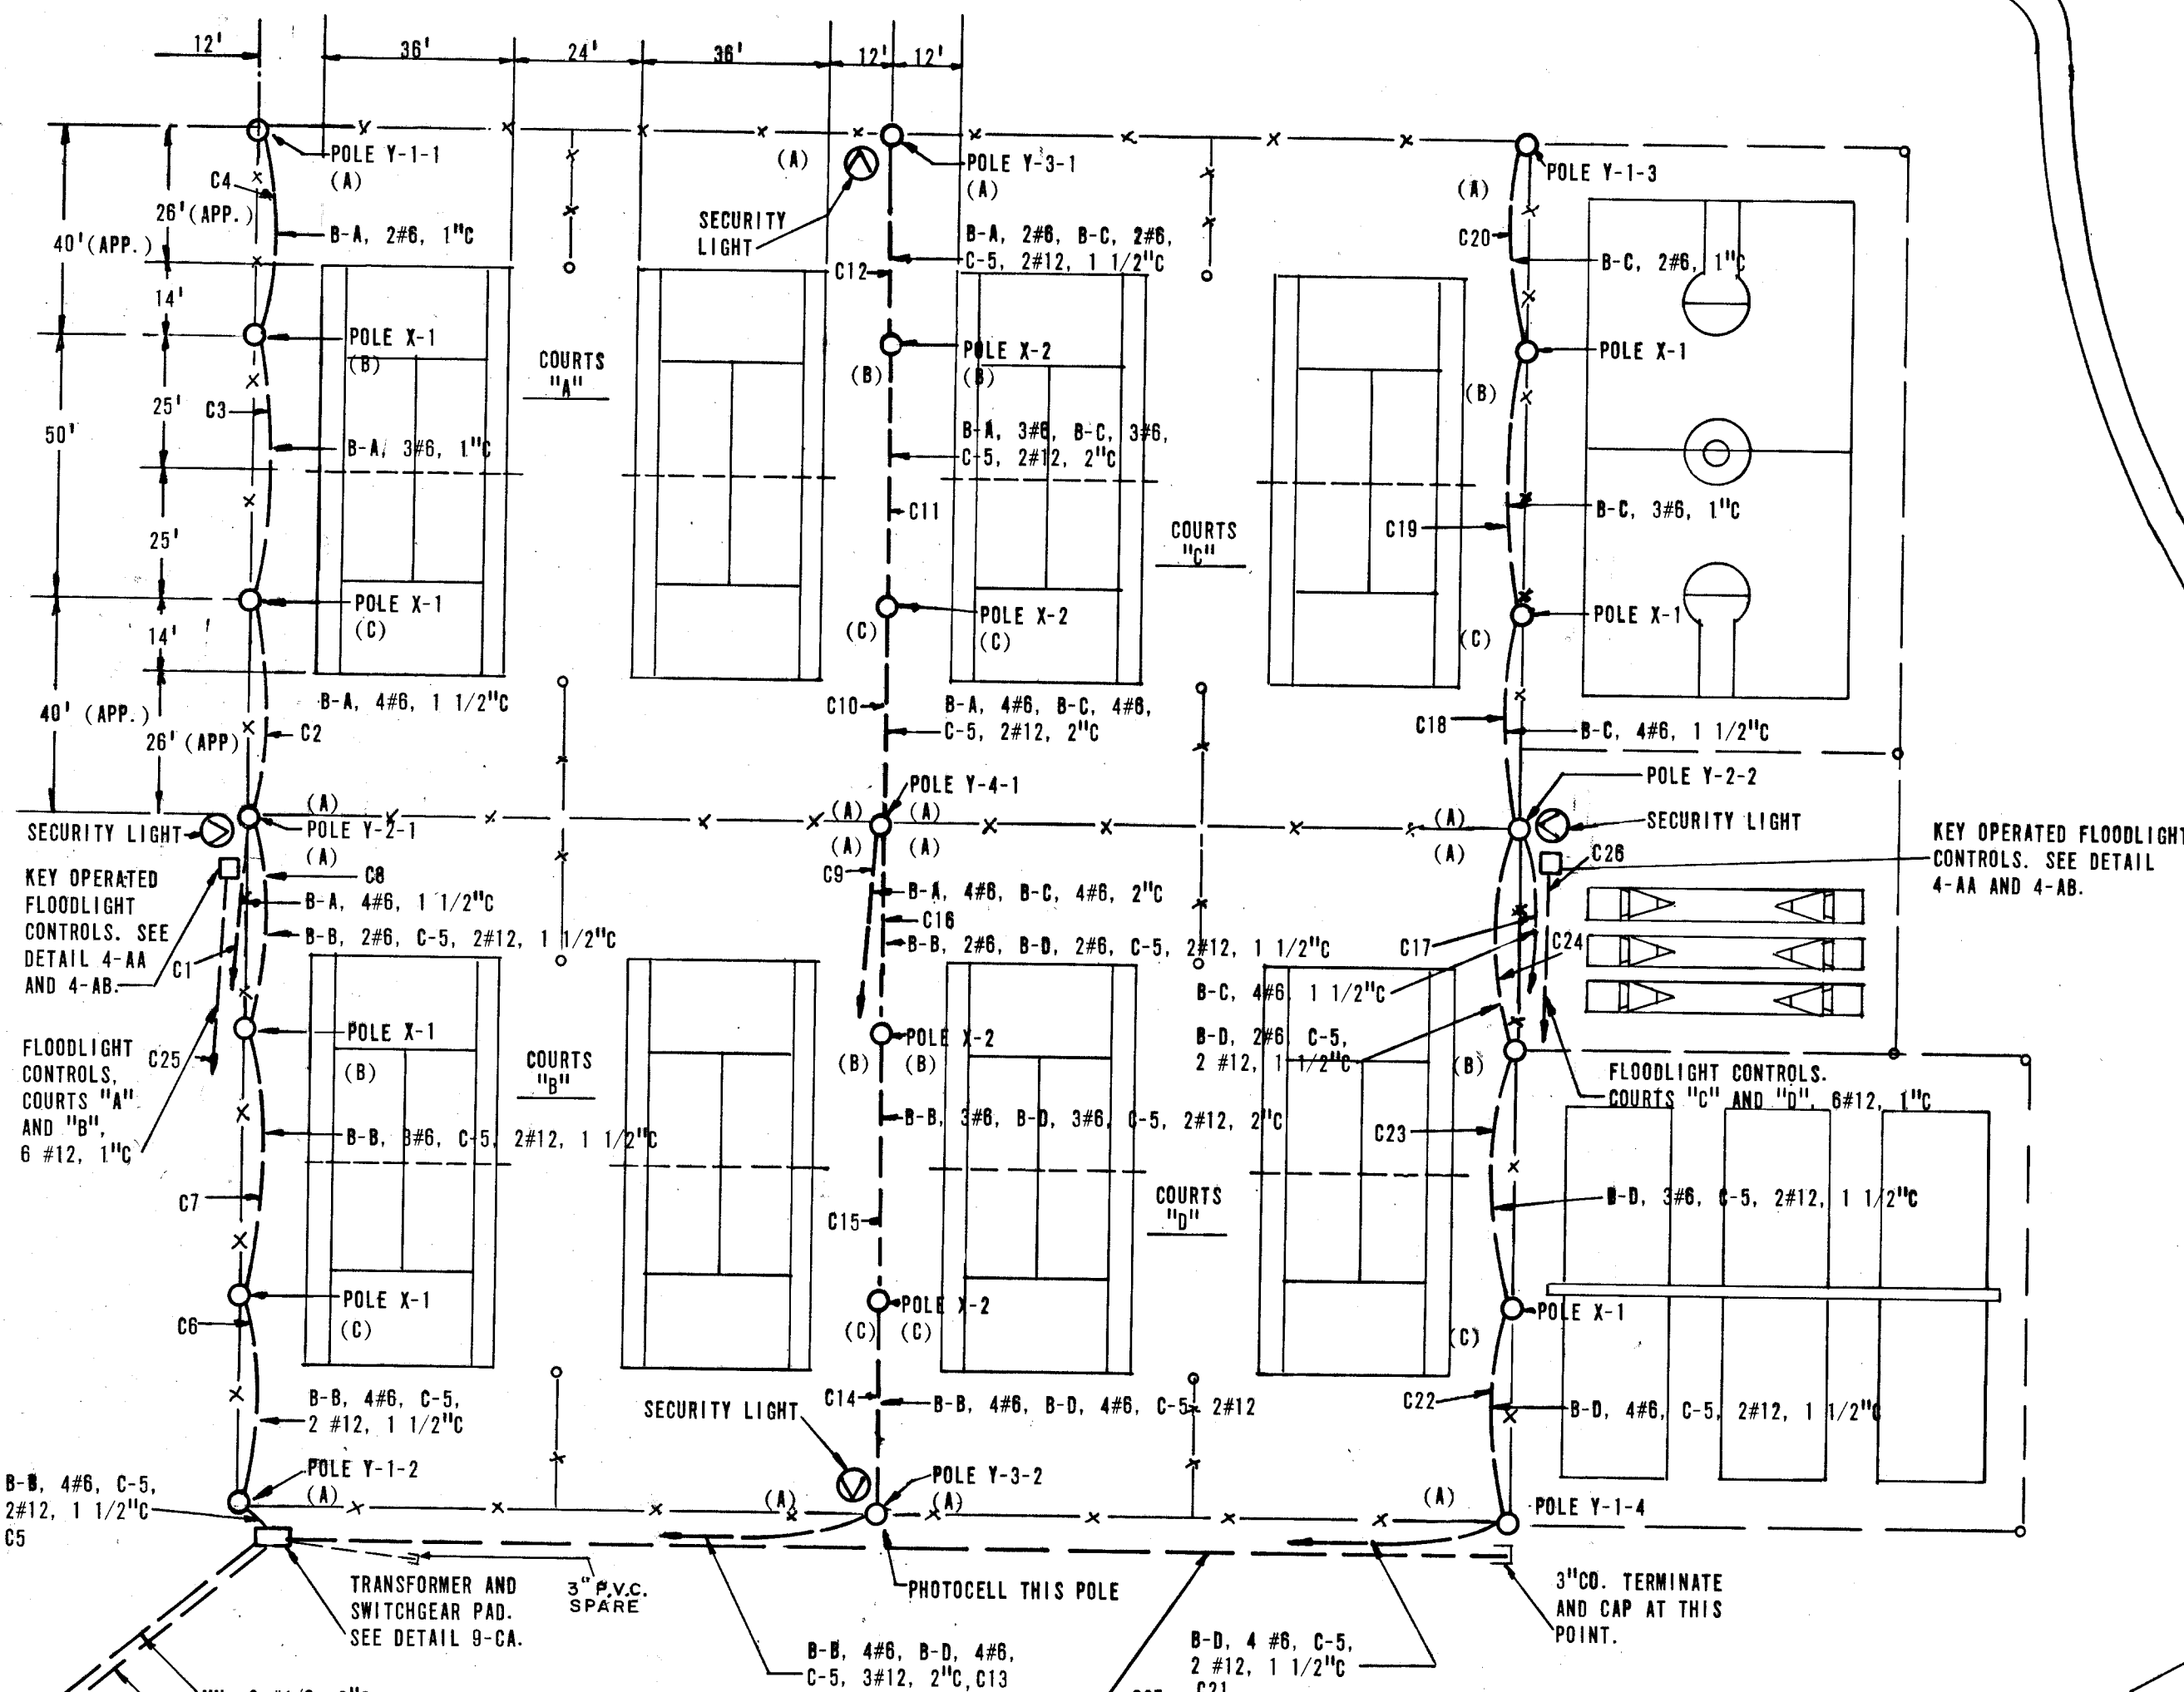


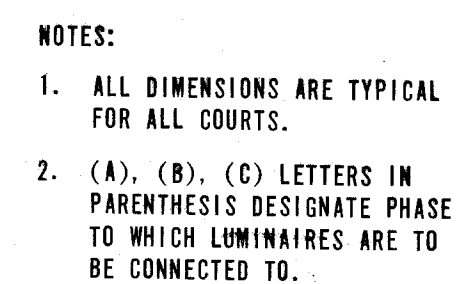


CONTRACT
DRAWING
MAR 5 1973

AS BUILT

		COURTS "C" & "D"		CONDUCTOR		CONDUIT			
CKT. NO.	PHASE	FROM	TO POLE	L. F. E.A.	SIZE	L. F.	SIZE	SYM	
	B.C	PANEL-B	Y-2-2	760					
A (N)	Y-4-1		842	#6	372	1½"	C17		
B.C			530						
A (N)			800	#6			C 9		
B-C	A.B	POLE Y-2-2	X-1 (C)	104					
	A.B			186	#6	46	1½"		
	A.B			104					
	C (N)	POLE Y-4-1	X-2 (C)	186	#6			C18	
	A			62					
	B.N	POLE X-1 (C)	X-1 (B)	206	#6	56	1"	C19	
	A			62					
	B.N	X-2 (C)	X-2 (B)	206	#6			C20	
	A.N	POLE X-1 (B)	Y-1-3	186	#6	48	1"	C11	
	A.N	X-2 (B)	Y-3-1	186	#6			C12	
	B-D	B.C	PANEL-B	Y-1-4	478				
		B.C		Y-3-2	560	#6	230	1½"	C21
A.N				248					
A.N				330	#6				
A.B				84					
C.N		POLE Y-1-4	X-2 (C)	186	#6	42	1½"	C22	
A.B				84					
C.N		POLE Y-3-2	X-2 (C)	186	#6			C14	
A				62					
B.N		POLE X-1 (C)	X-1 (B)	206	#6	56	1½"	C23	
A				62					
B-D		B.N	POLE X-2 (C)	X-2 (B)	206	#6			C15
	A.N	POLE X-1 (C)	Y-2-2	186	#6	48	1½"	C24	
	A.N	POLE X-2 (B)	Y-4-1	186	#6			C16	

COURTS "A" & "B"								
CKT. NO.	PHASE	FROM	TO POLE	CONDUCTOR		CONDUIT		
				L. F.	SIZE	L. F.	SIZE	SYM.
B-A	B, C	PANEL-B	Y-2-1	300				
	A (N)			380	#6	147	1½"	C 1
	B, C		Y-4-1	530				
	A (N)		600	#6	257	2"	C 2	
	A, B	POLE Y-2-1	X-1 (C)	104				
	A (N)			185	#6	46	1½"	C 9
	B, C			104				
	A (N)			186	#6		2"	C 10
	A	POLE Y-4-1	X-2 (C)					
	B (N)			62				
	A (N)			206	#6	56	1"	C 3
	B, C			62				
	A	POLE X-2 (C)	X-2 (B)	205	#6			
	B (N)			185	#6		2"	C 11
	A (N)			185	#6	46	1"	C 4
	B, C			186	#6		1½"	C 12
A (N)	POLE X-2 (B)	Y-3-1						
B, C			45					
A (N)			128	#6	21	1½"	C 5	
B, C			248					
A (N)		330	#6	116	2"	C 13		
A, B	POLE Y-1-2	X-1 (C)	84					
A (N)			166	#6	42	1½"	C 6	
B, C			84					
A (N)			166	#6		2"	C 14	
A, B	POLE Y-3-2	X-2 (C)						
A (N)			62					
B (N)			205	#6	56	1½"	C 7	
A			62					
A	POLE X-2 (C)	X-2 (B)	205	#6				
B (N)			208	#6				
A (N)			180	#6	46	1½"	C 8	
B, C			185	#6		1½"	C 16	

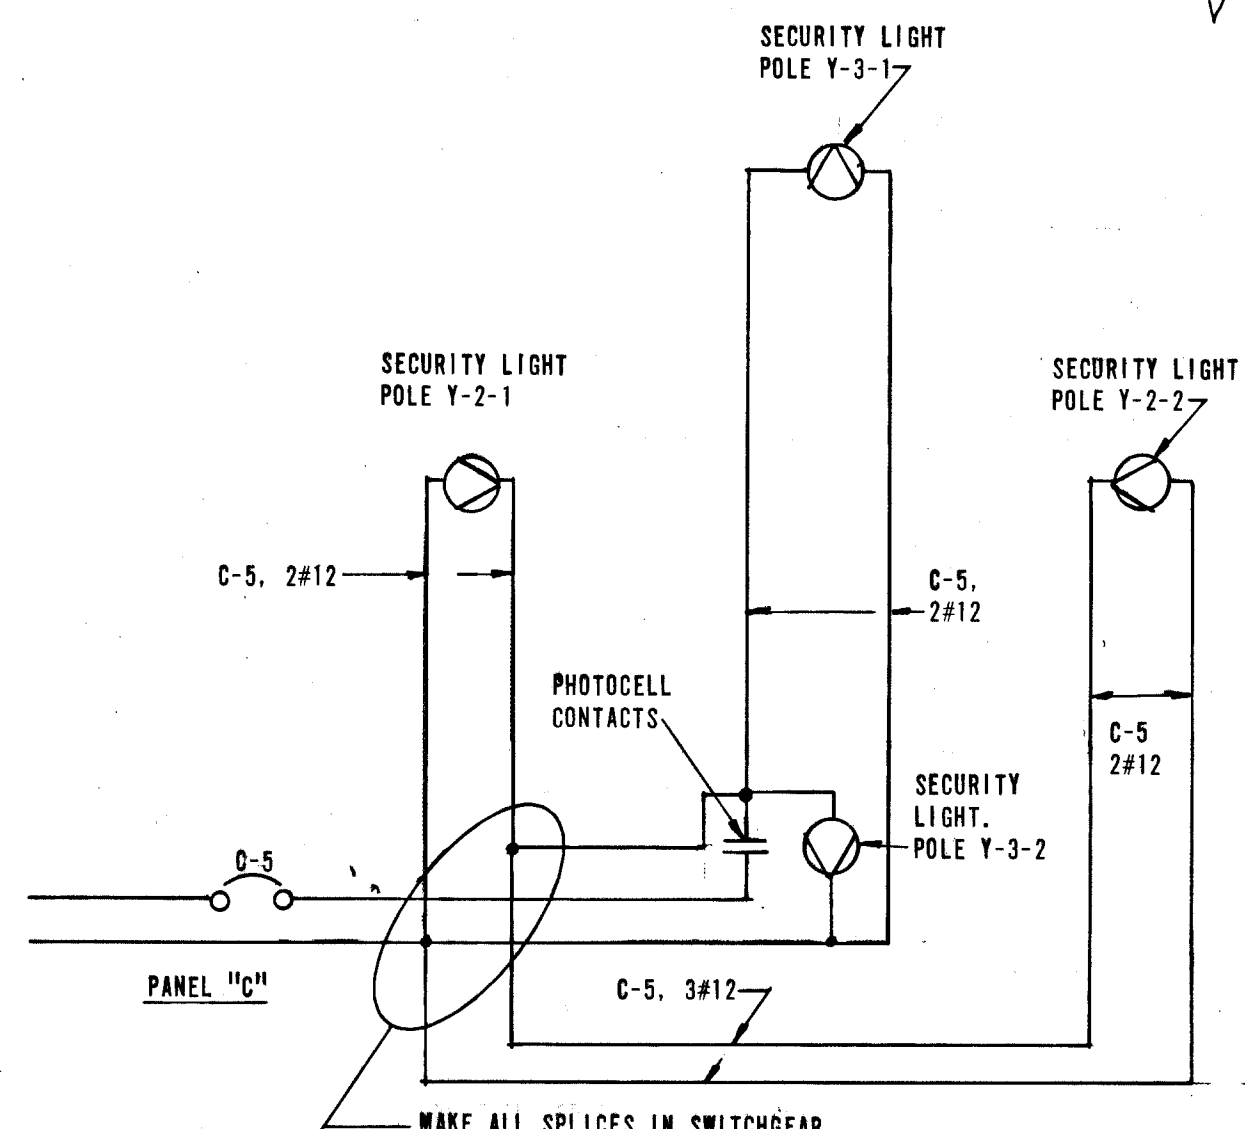

CKT.		FROM	TO POLE	CONDUCTOR		CONDUIT		SYM.
				L.F.	SIZE	L.F.	SIZE	
C-1	A-7 A-8 A-9	PAN. B. TERM. BLOCK FOR FLO. LIGHT CONTROL	VICINITY OF Y-2-1 OUTSIDE OF FENCE. SEE NOTE: 2	157 EACH	#12	150	1"	C25
C-2	B-7 B-8 B-9	"						
C-3	C-7 C-8 C-9	"	VICINITY OF Y-2-2 OUTSIDE OF FENCE. SEE NOTE: 2					
C-4	D-7 D-8 D-9	"		387 EACH	#12	375	1"	C28
		SWITCHGEAR	VICINITY OF Y-1-4			235	3"	C27
NH	A B C	SWITCHGEAR	EXIST. J.B.	117 EACH	#4/0	105	3"	A-6 EXT.
						105	3"	A-7 EXT.

