




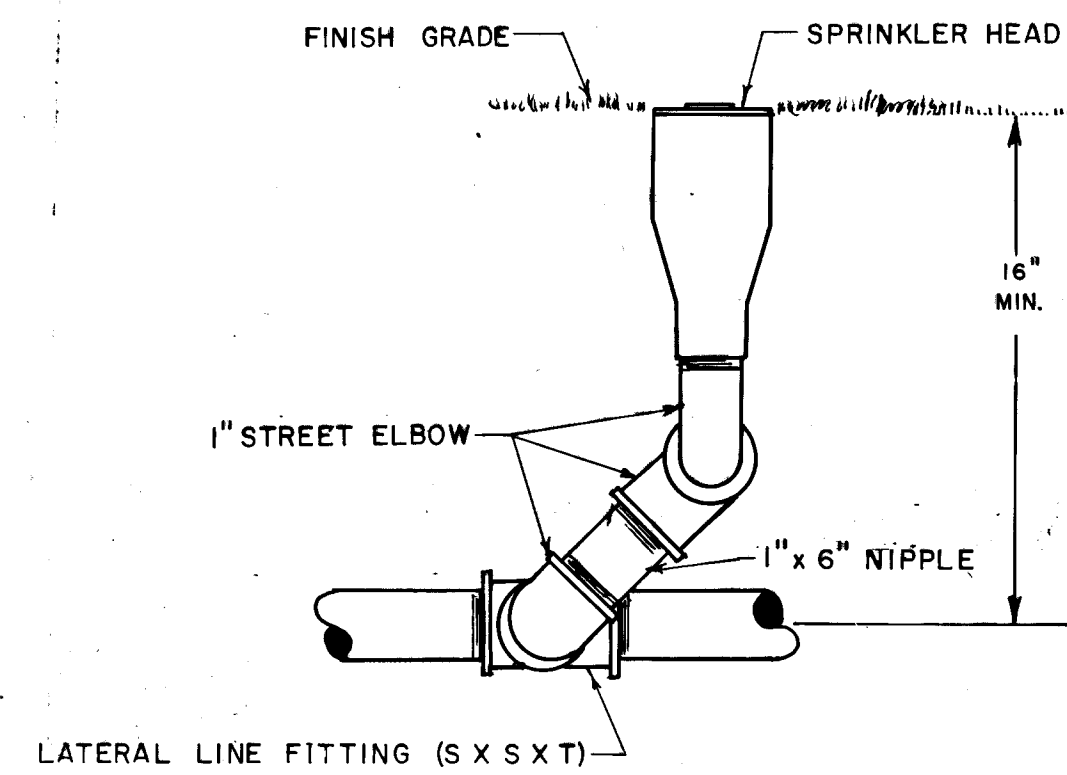


TYPICAL LAWN HEAD ASSEMBLY
NO SCALE

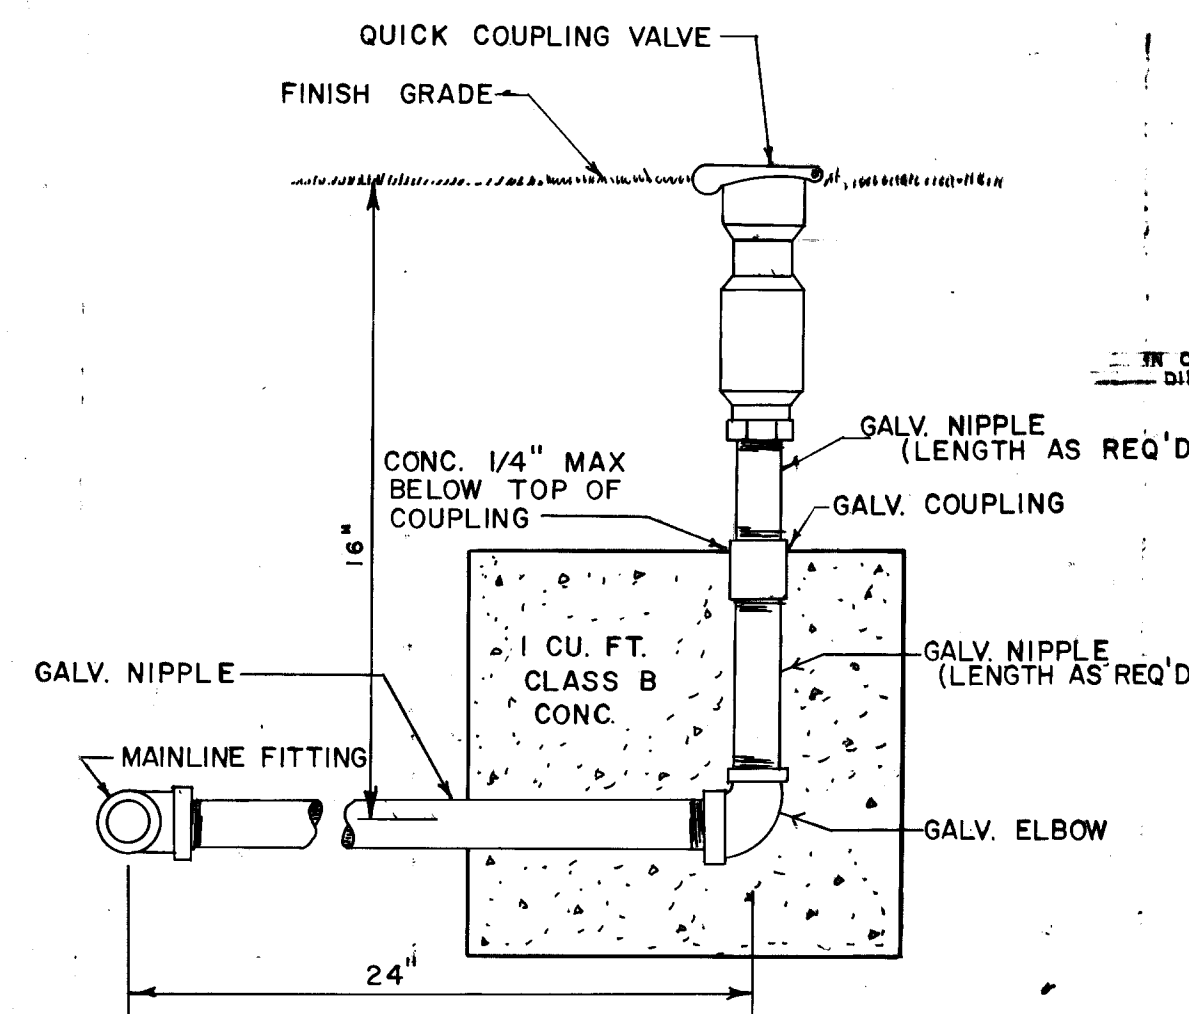


QUICK COUPLING VALVE ASSEMBLY
NO SCALE

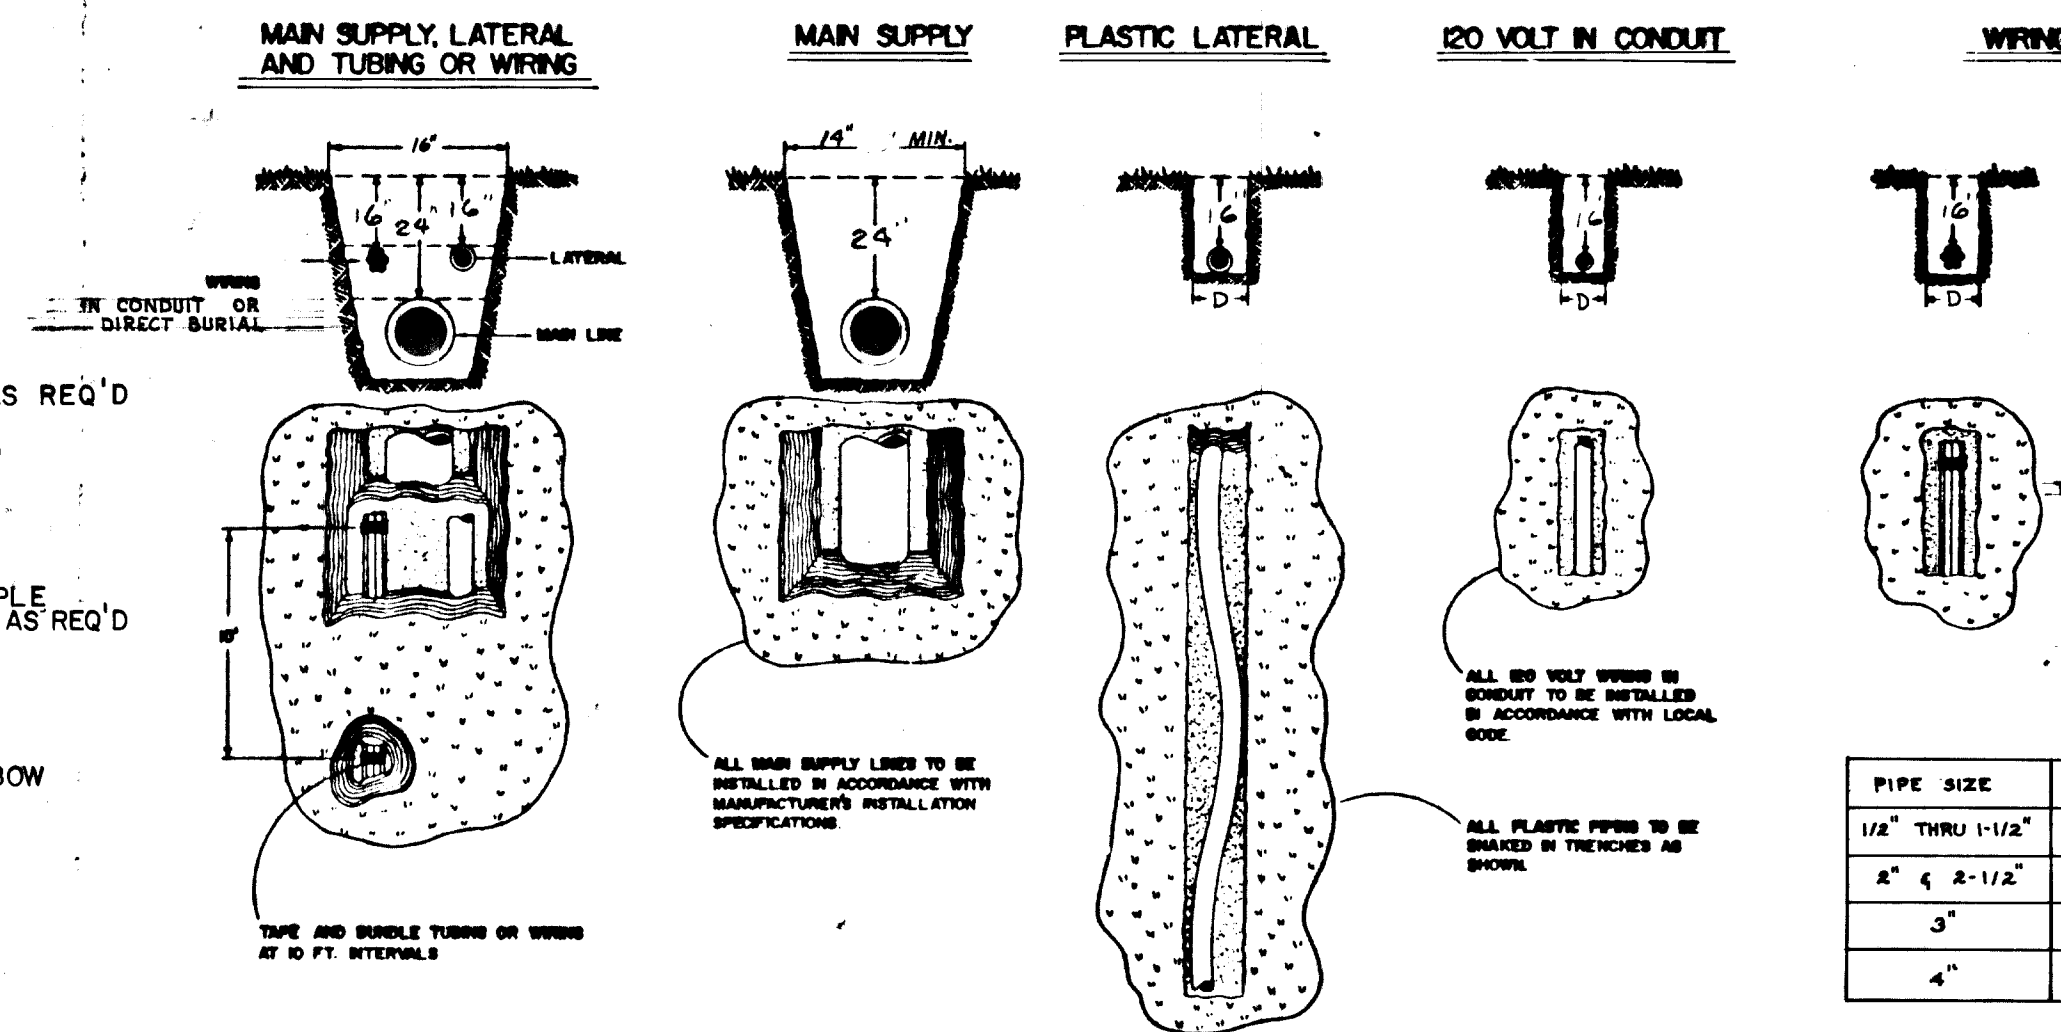


TYPICAL TRENCHING DETAIL

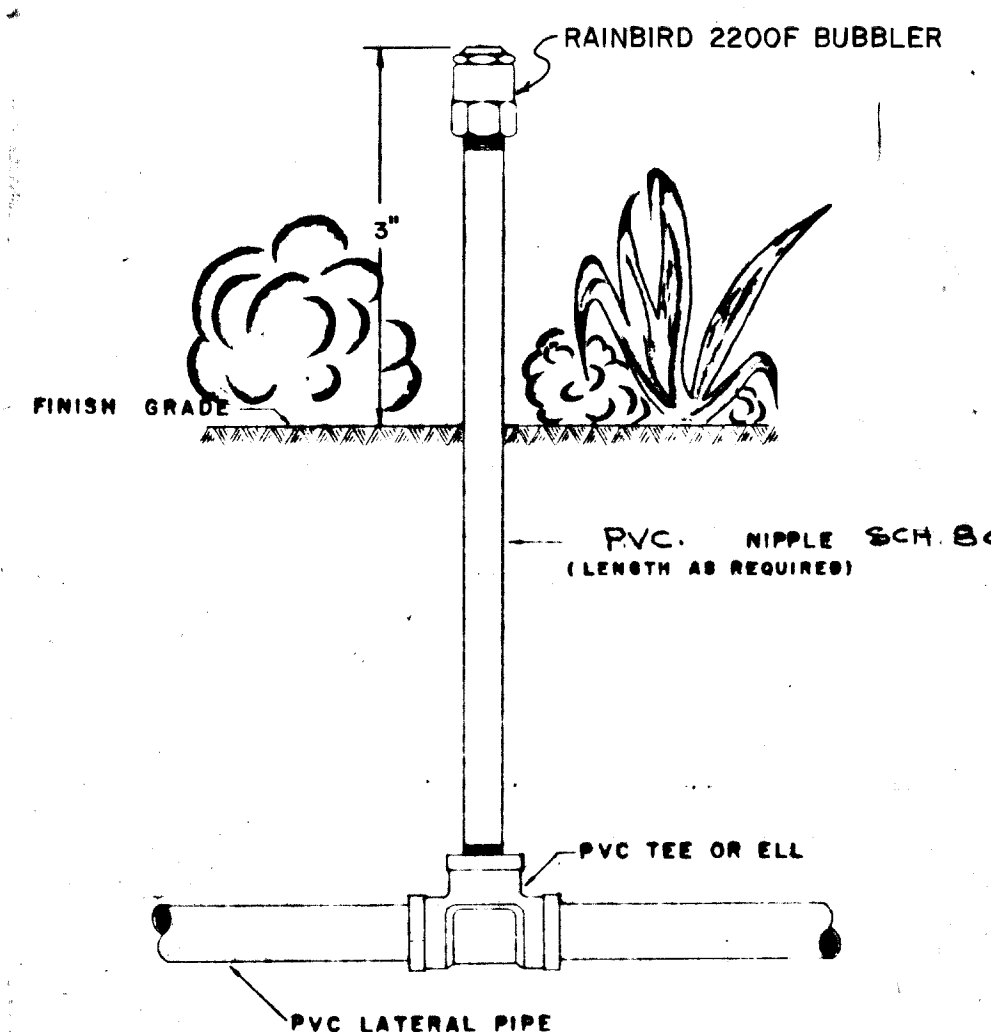


TYPICAL SHRUB HEAD DETAIL

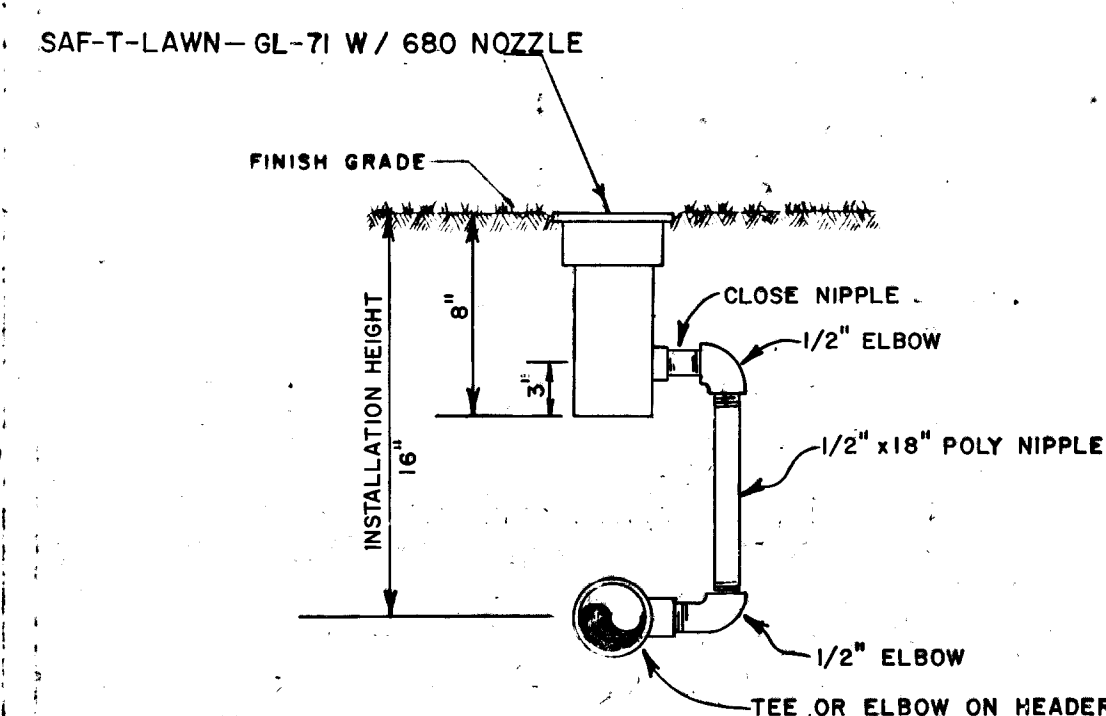

TYPICAL POP UP DETAIL

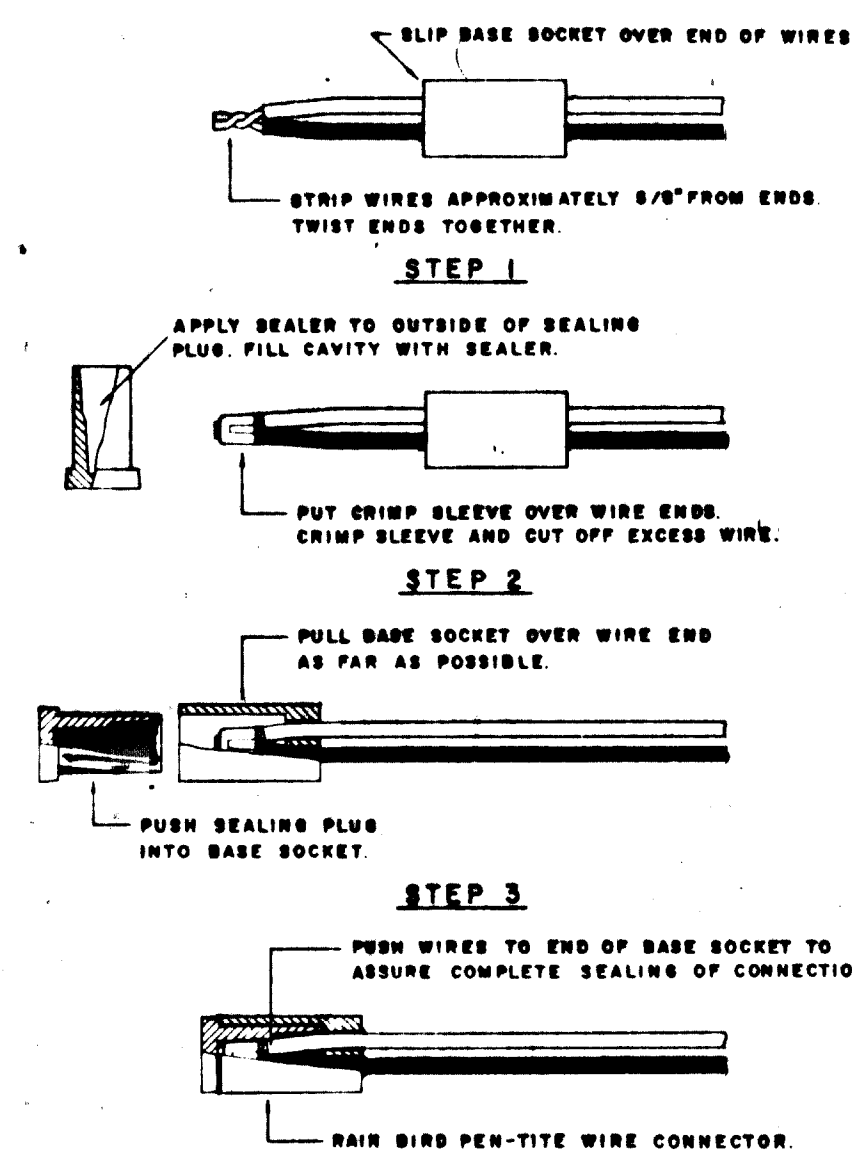


TYPICAL WIRE CONNECTION DETAIL
No. 58 (RAIN BIRD PEN-TITE WIRE CONNECTOR)

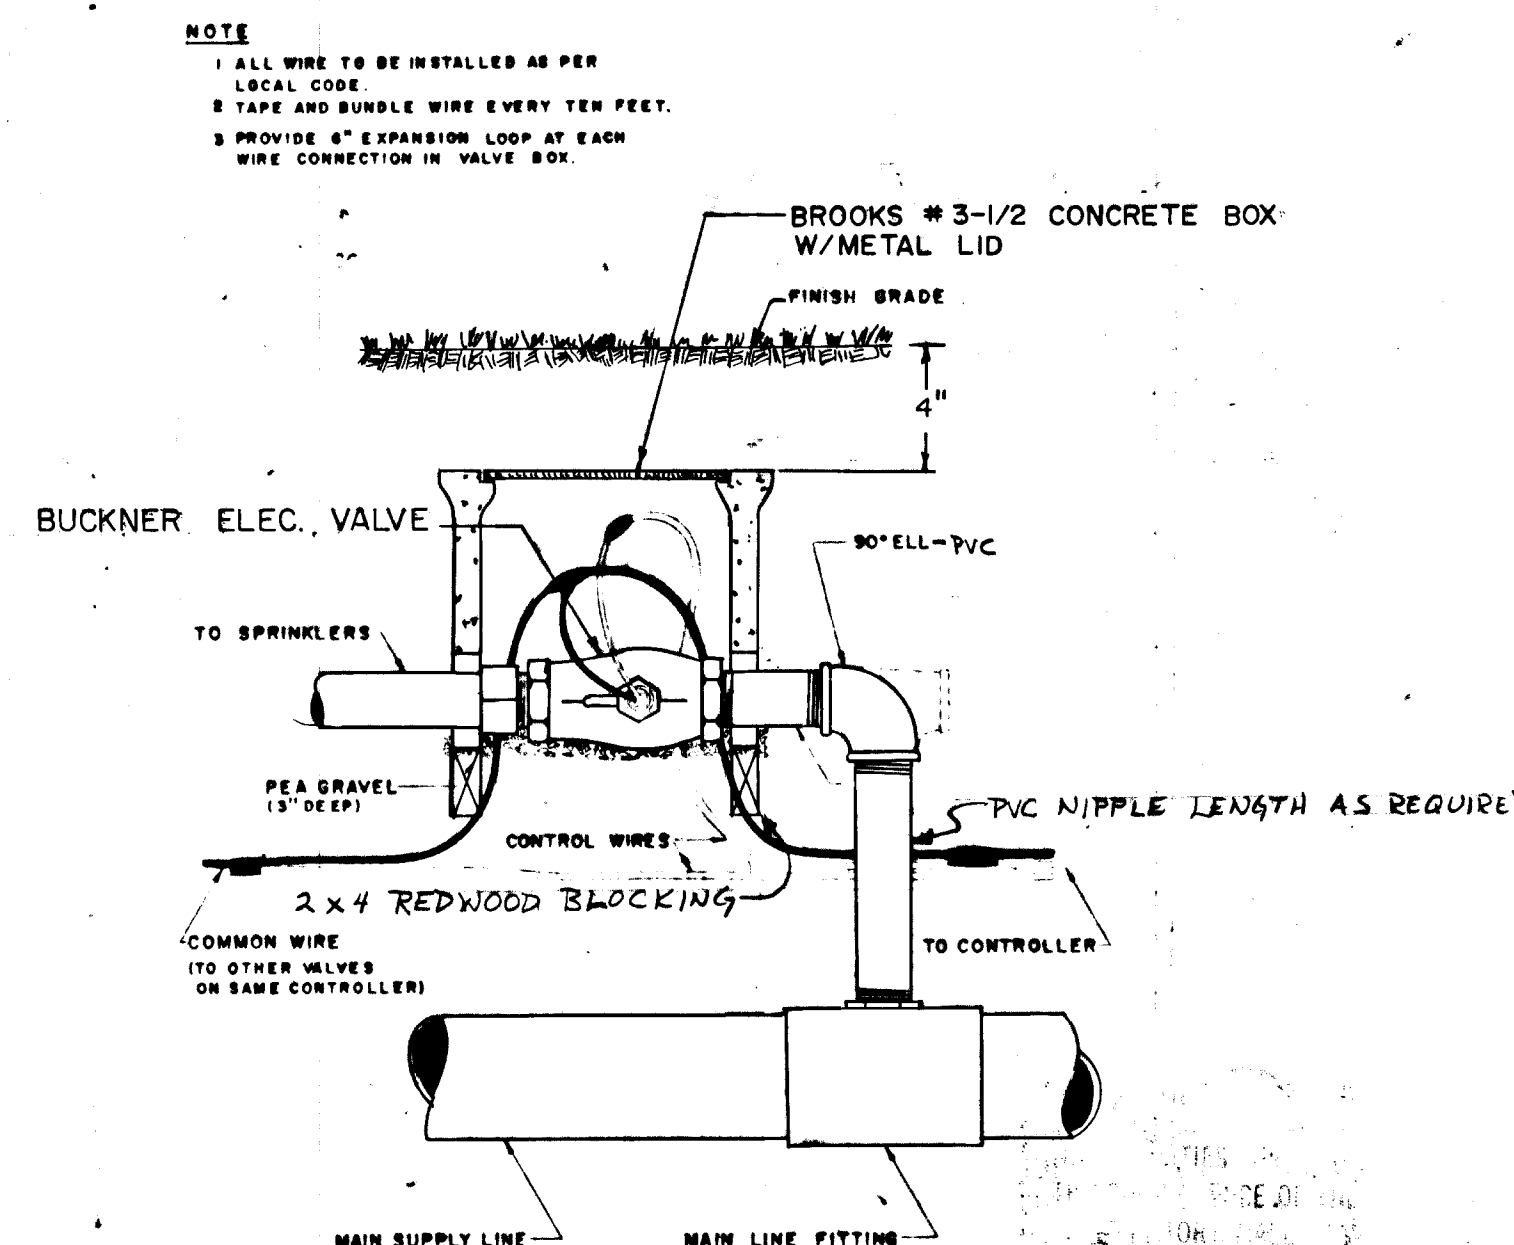

VALVE DETAIL
(WITH VALVE BOX & MARKER)

IRRIGATION SYSTEM CONSTRUCTION NOTES
(applicable to sheets 3, 4, 5 and 6 of these drawings)

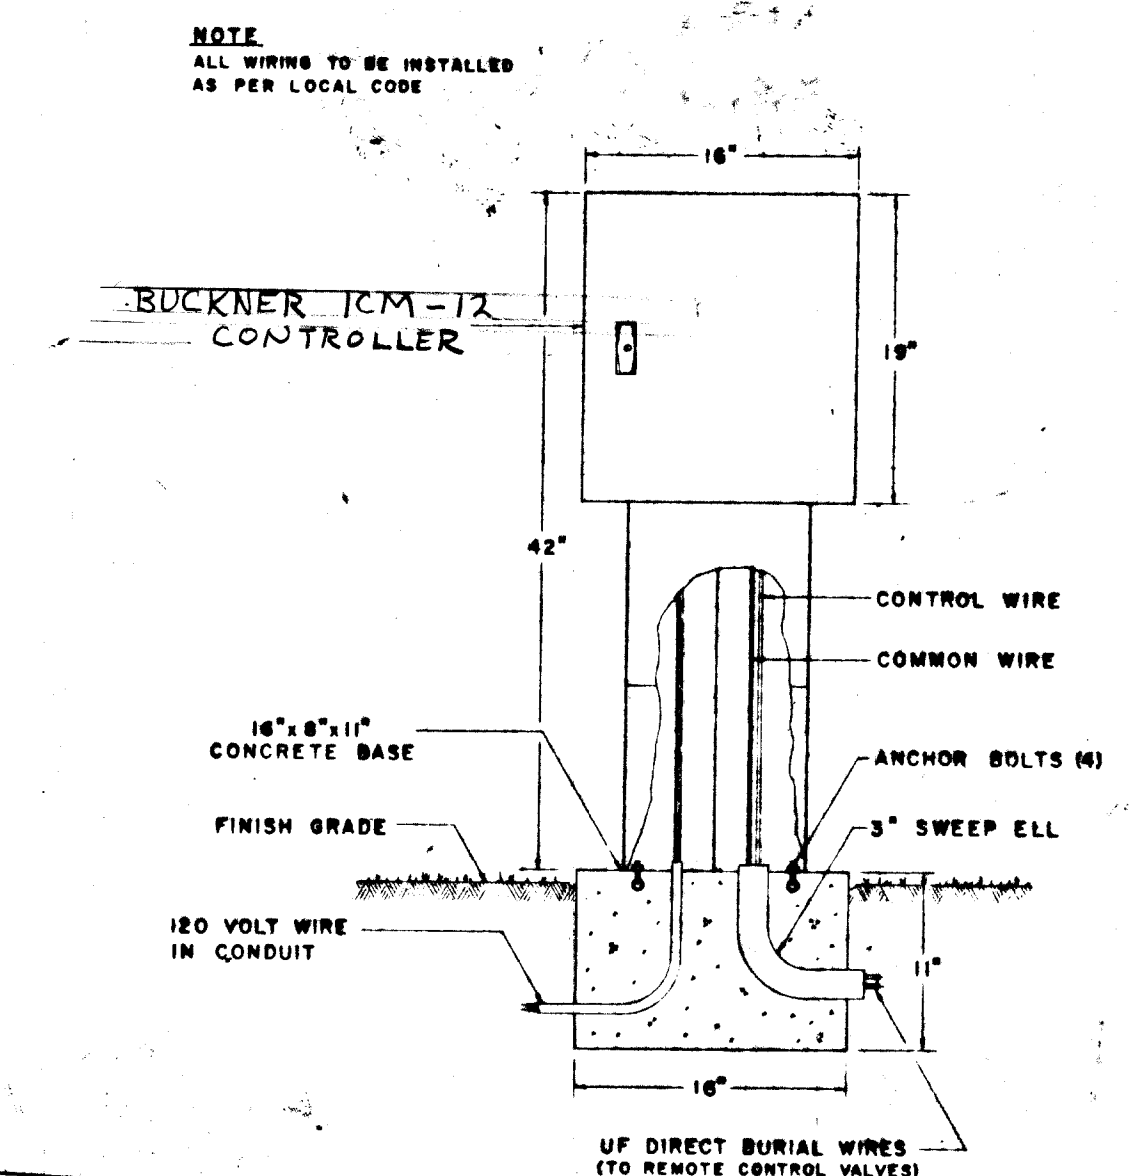

CONTROLLER DETAIL
(ELECTRIC PEDESTAL MOUNT)

APPROVED: *[Signature]* 1/7/75
Public Works Department
Date
3/3/75
2-25-75
2-28-75
Date

CONTRACT
DRAWING
MAR 7 1975

AS BUILT

PROFESSIONAL ENGINEER
WILLIAM J. PAVIS
CIVIL
No. 1218
State of Nevada
12/3/78

CITY OF LAS VEGAS NEVADA DEPARTMENT OF PUBLIC WORKS SERVICES DIVISION			
IRRIGATION SYSTEM — DETAILS			
W.Q. NO. 3115	F.B.K. NO. 73-2X	DATE	DRAWING NO.
SC(H) NOT TO SCALE SC(V)		5-29-74	650.19-25A
DES. C. KAJKOWSKI			FILE NO.
DR. C. KAJKOWSKI			
APPROVED BY DIRECTOR OF PUBLIC WORKS			SHEET 7 OF 16