
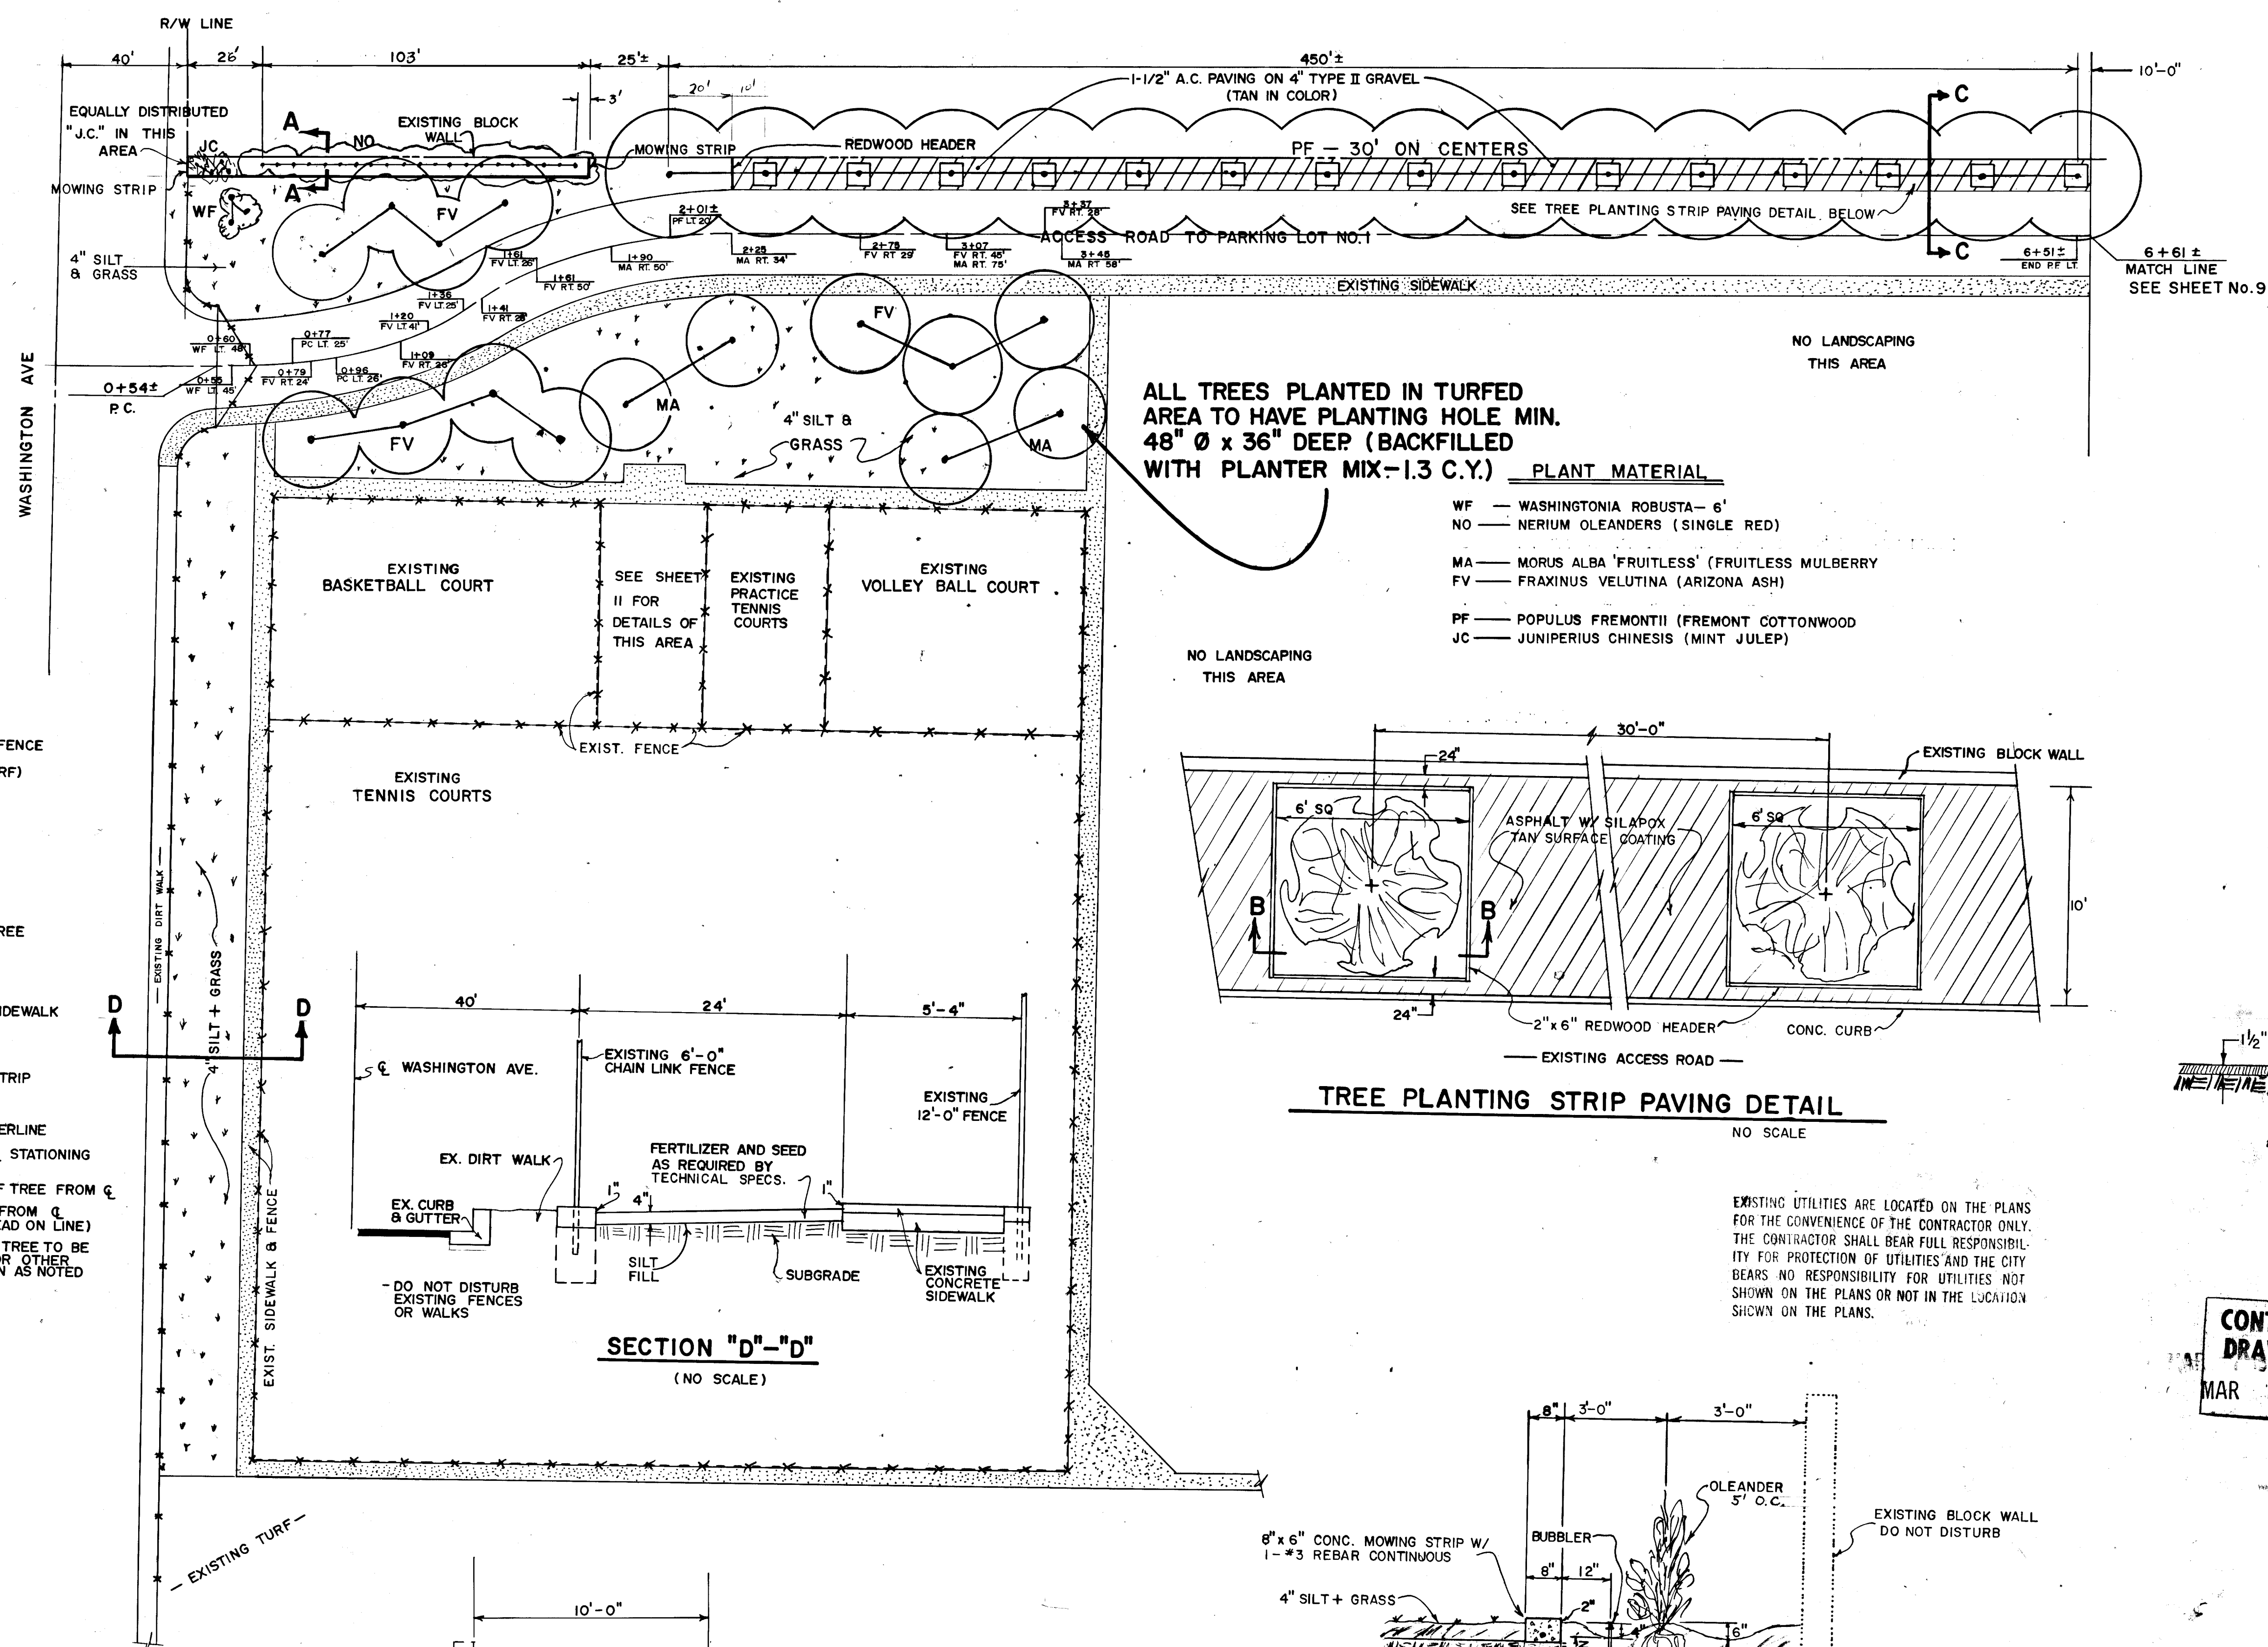


APPROXIMATE QUANTITIES—THIS SHEET			
ITEM	DESCRIPTION	UNIT	QUANTITY
301.100	2" x 6" REDWOOD HEADERS	LF	370
302.200	TYPE II GRAVEL	CY	47
334.003	1 1/2" A.C. PAVEMENT—SINGLE LIFT	TON	35
334.910	TAN ASPHALT COLORING	SY	425
340.900	8" x 6" CONC. MOWING STRIP	LF	140
450.000	PLANTER MIX	CY	124
450.012	2" CALIPER FRUITLESS MULBERRY	EA	4
450.013	2" CALIPER COTTONWOOD (PF)	EA	16
330.000	PAVING ASPHALT	TN	2
450.015	2" CALIPER ARIZONA ASH (FV)	EA	11
450.017	6 FT. WASHINGTONIA ROBUSTA (WF)	EA	3
450.050	OLEANDER 5 GAL. (NO)	EA	21
450.051	5 GAL JUNIPER (MINT) (JC)	EA	4
450.900	SILT	SY	2844
450.901	GRASS SEEDING	SY	2844

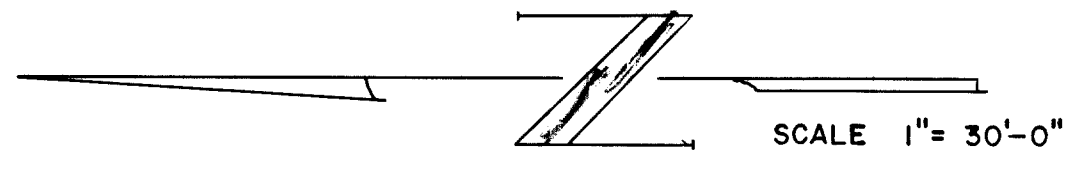


**LEGEND—THIS SHEET**


- — — — — EXISTING FENCE
- GRASS (TURF)
- NEW TREE
- FV TYPE OF TREE
- — — — — EXISTING SIDEWALK
- ▨ PLANTER STRIP
- ROAD CENTERLINE
- ROADWAY & STATIONING
- DISTANCE OF TREE FROM C (FACING AHEAD ON LINE)
- SPECIES OF TREE TO BE PLANTED—OR OTHER INFORMATION AS NOTED

**ALL TREES PLANTED IN TURFED AREA TO HAVE PLANTING HOLE MIN. 48" Ø x 36" DEEP (BACKFILLED WITH PLANTER MIX—1.3 C.Y.)**


- PLANT MATERIAL**
- WF — WASHINGTONIA ROBUSTA—6'
  - NO — NERIUUS OLEANDERS (SINGLE RED)
  - MA — MORUS ALBA 'FRUITLESS' (FRUITLESS MULBERRY)
  - FV — FRAXINUS VELUTINA (ARIZONA ASH)
  - PF — POPULUS FREMONTII (FREMONT COTTONWOOD)
  - JC — JUNIPERUS CHINESIS (MINT JULEP)

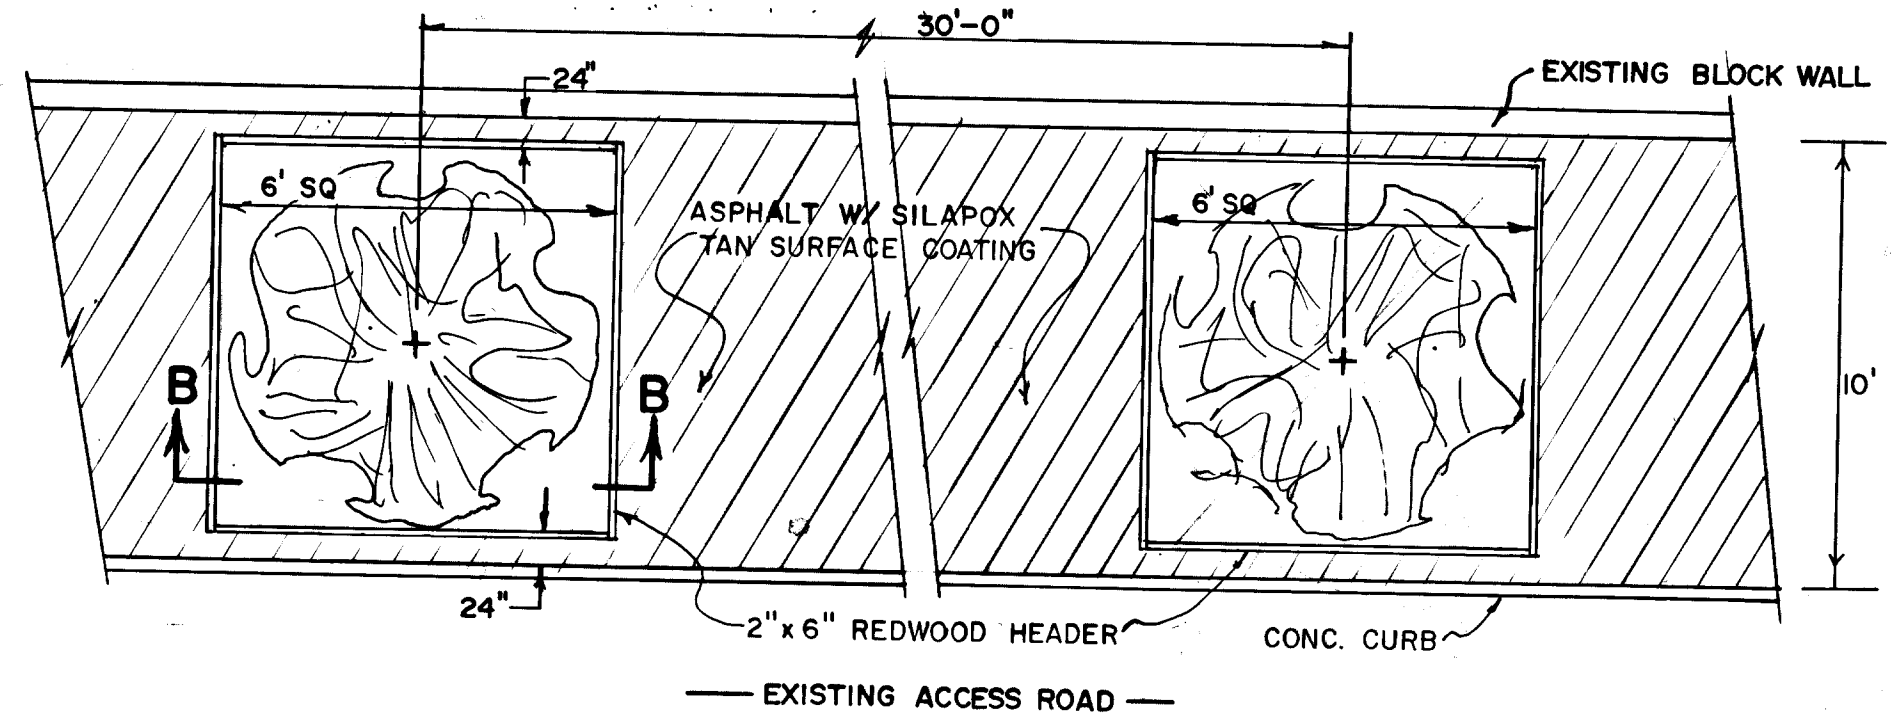


**TREE PLANTING STRIP PAVING DETAIL**  
NO SCALE

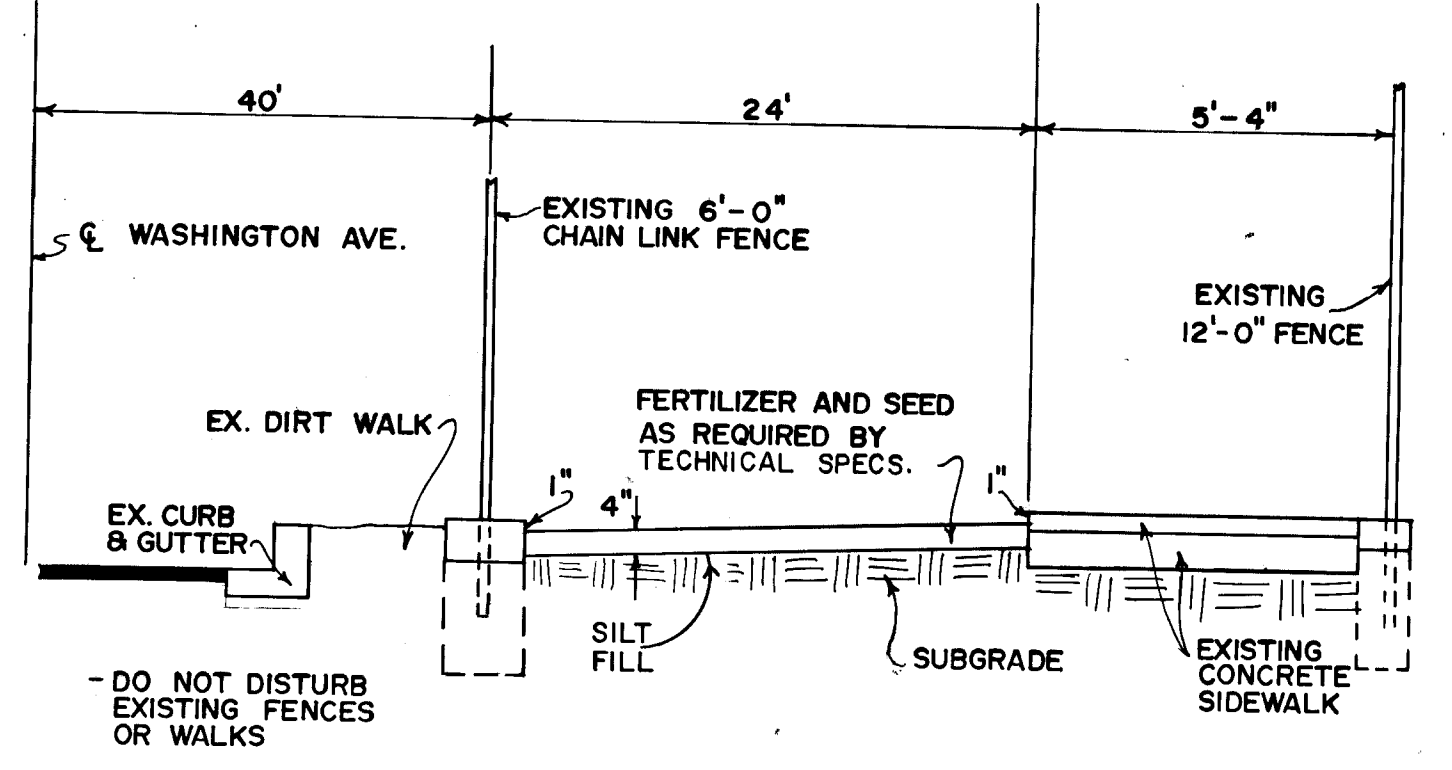


**SECTION "D"—"D"**  
(NO SCALE)

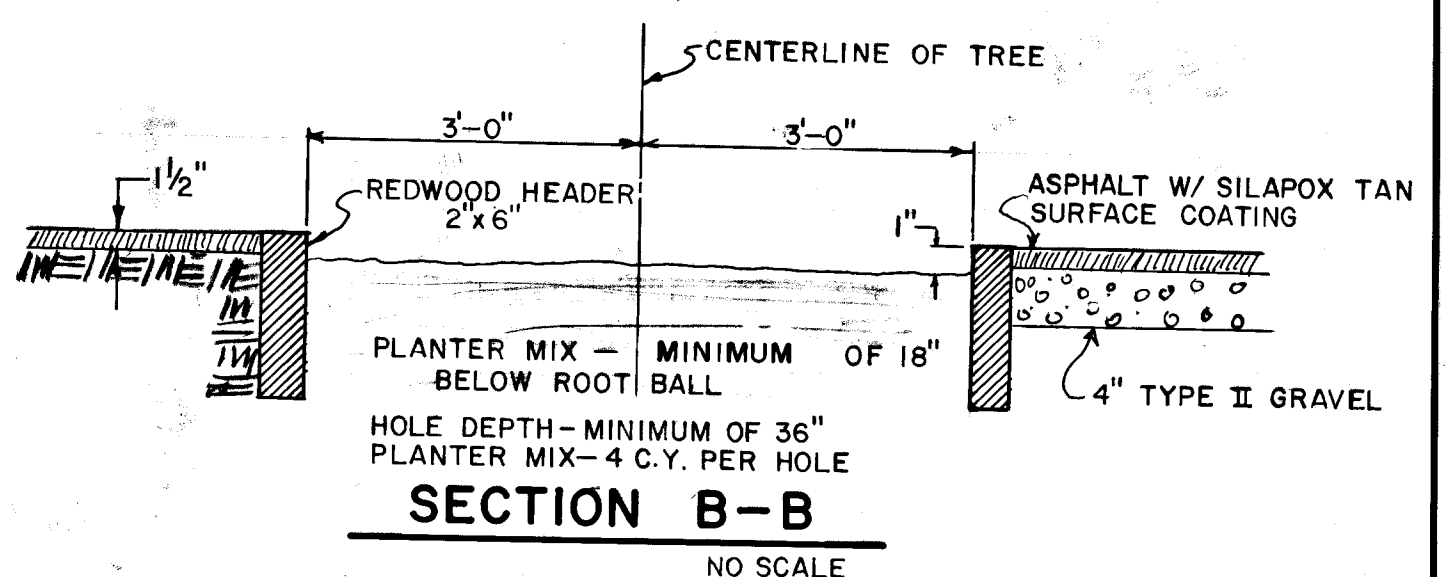

**SECTION B-B**  
NO SCALE

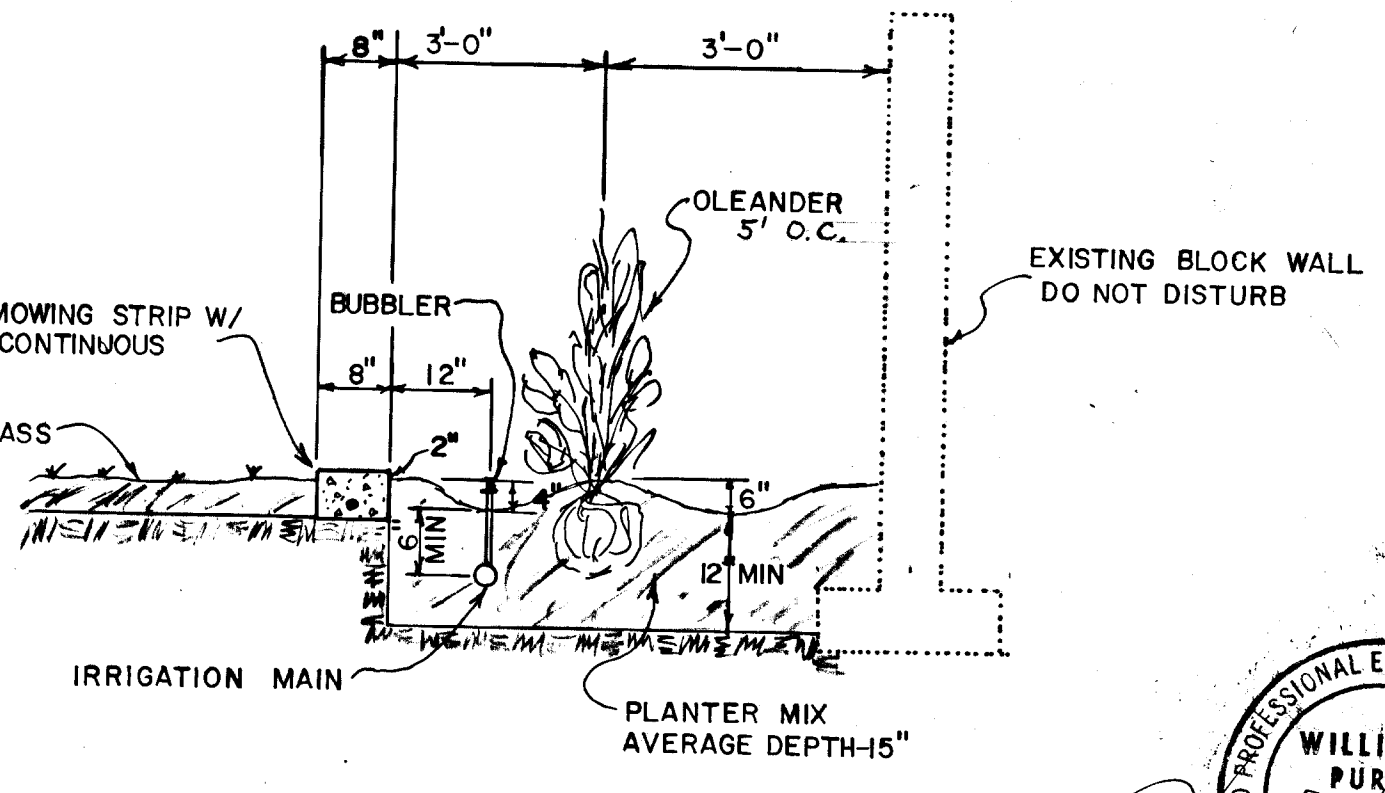

**SECTION A-A**  
NO SCALE

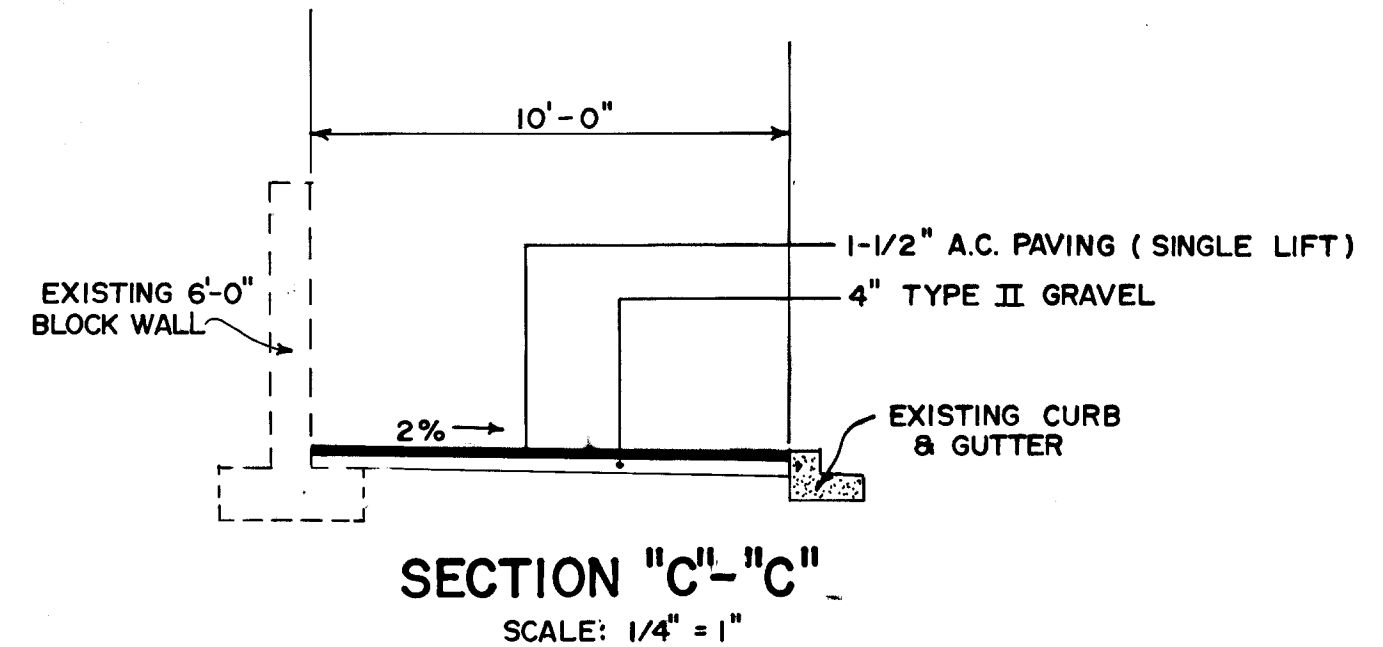

**SECTION "C"—"C"**  
SCALE: 1/4" = 1"

APPROVED: *[Signature]* 12/26/74  
 Public Works Department  
 Date

REVIEWED: *[Signature]* 3/13/75  
 Public Works Department  
 Date

DESIGNED: *[Signature]* 2-20-75  
 Construction Div. Eng.  
 Date

**CONTRACT DRAWING**  
MAR 7 1975

**AS BUILT**



Department of Public Works  
Engineering Division

Lorenzi Park Phase III B

PARKING LOT NO. I ACCESS ROAD  
LANDSCAPING PLAN

scale (h) as noted	scale (v) as noted	drawing no.
w.o.no. 3115	f.bk.no. 73-2X	650.19-25A
design by c. kajkowski	drawn by c. kajkowski	date 4/22/74
approved by Director of Public Works	plate	sht. 8 of 16

PROFESSIONAL ENGINEER  
 WILLIAM J. PURVIS  
 CIVIL  
 No. 3338 NOVEMBER 1973