

RECORD DRAWINGS  
NOT FOR CONSTRUCTION

1. TO ALTER THESE DOCUMENTS FOR ANOTHER PROJECT BY ANYONE OTHER THAN THE ORIGINAL ARCHITECT IS A VIOLATION OF NRS 623.
2. THIS RECORD DRAWING HAS BEEN PREPARED IN PART, BASED UPON INFORMATION FURNISHED BY THE GENERAL CONTRACTOR, WHILE THIS INFORMATION IS BELIEVED TO BE RELIABLE, THE DESIGN PROFESSIONAL CANNOT ASSURE ITS ACCURACY, AND THIS IS NOT RESPONSIBLE FOR THE ACCURACY OF THIS RECORD DRAWING OR FOR ANY ERRORS OR OMISSIONS WHICH MAY HAVE BEEN INCORPORATED INTO IT AS A RESULT. THE DESIGN PROFESSIONAL CANNOT AND DOES NOT WARRANT THEIR ACCURACY.
3. INFORMATION THAT MAY BE INCLUDED WOULD BE SIGNIFICANT CHANGES TO PLANTING OR IRRIGATION LAYOUT PLANS AND ASSOCIATED DRAWINGS, MINOR DIMENSION OR CONSTRUCTION DETAIL CHANGES MAY NOT BE INCLUDED.

WASHINGTON AVENUE

PHASE LINE - LIMITS OF CONSTRUCTION

SIGHT VISIBILITY RESTRICTED ZONE (TYP.).  
NO PLANTING OR OBSTRUCTION GREATER  
THAN 2' 6" TALL ALLOWED IN HATCHED AREA

PHASE LINE - LIMITS OF CONSTRUCTION

MATCHLINE L2.03

CONCRETE COLLAR AT  
LIGHTPOLE, SEE DETAIL "F"  
SHEET L5.02

BENCH (TYP.)

MOWCURB (TYP.) TO SEPARATE  
PLANTER AREA FROM TURF AREA.

SEE DETAIL "D", SHEET  
L4.05 FOR TYPICAL  
PICNIC AREA LAYOUT.

MATCHLINE L2.06

SITE LEGEND

| SYMBOL | DESCRIPTION                                                                                                                            |
|--------|----------------------------------------------------------------------------------------------------------------------------------------|
|        | PHASE LINE / LIMITS OF CONSTRUCTION                                                                                                    |
|        | ADD ALT #1 LIMIT LINE                                                                                                                  |
|        | EXISTING CMU WALL, PROTECT IN PLACE                                                                                                    |
|        | DECOMPOSED GRANITE                                                                                                                     |
|        | MOWCURB                                                                                                                                |
|        | SEE DETAIL "C", SHEET L5.01                                                                                                            |
|        | PERIMETER SPLIT RAIL FENCE<br>SEE DETAILS "D" AND "E", SHEET L5.01                                                                     |
|        | PARK CONCRETE PATHS AND PLAZAS<br>SEE NOTE 6, THIS SHEET                                                                               |
|        | RIP-RAP PER CIVIL DRAWINGS<br>SEE PLANTING PLANS FOR RIP-RAP COLOR                                                                     |
|        | PARK SIGNAGE. SEE PARK SIGN LEGEND, THIS SHEET<br>TRAFFIC SIGNAGE. SEE CIVIL DRAWINGS FOR ADDITIONAL INFORMATION                       |
|        | PERMANENT BOLLARDS AT MAIN PLAZA DROP-OFF<br>SEE DETAIL "D", SHEET L5.02 (SQUARE SYMBOL)                                               |
|        | REMOVABLE BOLLARDS AT SHOWMOBILE PLAZA<br>SEE DETAIL "E", SHEET L5.02 (ROUND SYMBOL)                                                   |
|        | TRASH RECEPTACLE<br>SEE "SITE FURNISHINGS LEGEND AND INFORMATION", SHEET L5.01                                                         |
|        | BENCH<br>SEE "SITE FURNISHINGS LEGEND AND INFORMATION", SHEET L5.01                                                                    |
|        | ADA ACCESSIBLE PICNIC TABLE<br>SEE "SITE FURNISHINGS LEGEND AND INFORMATION", SHEET L5.01                                              |
|        | BIKE RACK<br>SEE "SITE FURNISHINGS LEGEND AND INFORMATION", SHEET L5.01                                                                |
|        | DRINKING FOUNTAIN. SEE "SITE FURNISHINGS LEGEND AND<br>INFORMATION", SHEET L5.01 AND DETAIL "N", SHEET C6.02                           |
|        | DOG WASTE BAG DISPENSER WITH SIGN.<br>SEE DETAIL "F", SHEET L5.08                                                                      |
|        | FAMILY BARBECUE GRILL<br>SEE DETAIL "B", SHEET L5.02                                                                                   |
|        | LIGHTING. SEE ELECTRICAL DRAWINGS.                                                                                                     |
|        | TENNIS MAINTENANCE SHED ON<br>CONCRETE PAD. SEE "SITE FURNISHINGS<br>LEGEND AND INFORMATION", SHEET L5.01                              |
|        | BLEACHERS - 5 BENCHES.<br>SEE DETAIL "A", SHEET L5.05<br>AND DETAIL "H", SHEET L5.06                                                   |
|        | ADAPTIVE TOT LOT WITH<br>SHADE COVER (LARGE)<br>SEE DETAIL "A", SHEET L4.06 FOR<br>PLAY STRUCTURE. SEE F52.0 FOR<br>SHADE COVER.       |
|        | SOFTBALL FIELD TOT LOT WITH<br>SHADE COVER (SMALL)<br>SEE DETAIL "B", SHEET L4.06 FOR<br>PLAY STRUCTURE. SEE F53.0 FOR<br>SHADE COVER. |
|        | 50' X 50' SHADE SHELTER<br>SEE SHEETS 551.0 THRU 554.2.                                                                                |
|        | 36' X 36' SHADE SHELTER<br>SEE SHEETS 555.0 THRU 558.2.                                                                                |
|        | 16' X 16'<br>SHADE SHELTER<br>SEE SHEETS 559.0<br>THRU 562.2.                                                                          |


PARK SIGN LEGEND

| ID | DESCRIPTION                                                                              |
|----|------------------------------------------------------------------------------------------|
| 1  | SITE SHELTER RESERVATION SIGN. POLE MOUNTED SIGN.<br>SEE DETAIL "C", SHEET L5.08         |
| 2  | PARK RULES SIGN. POLE MOUNTED SIGN. SEE DETAIL "D",<br>SHEET L5.08.                      |
| 3  | REPORT VANDALISM SIGN. POLE MOUNTED SIGN. SEE<br>DETAIL "E", SHEET L5.08.                |
| 4  | DOG SIGN. POLE MOUNTED SIGN. SEE DETAILS "F" AND "G"<br>SHEET L5.08.                     |
| 5  | WALK LOOP TRAIL SIGN. POLE MOUNTED SIGN. SEE DETAIL<br>"H" SHEET L5.08.                  |
| 6  | HANDICAP SIGN. POLE MOUNTED SIGN. SEE DETAILS "A"<br>AND "D" SHEET L5.09.                |
| 7  | EXCLUSIVE HANDICAP SIGN. POLE MOUNTED SIGN. SEE<br>DETAILS "B" AND "E" SHEET L5.09.      |
| 8  | VAN ACCESSIBLE HANDICAP SIGN. POLE MOUNTED SIGN.<br>SEE DETAILS "C" AND "F" SHEET L5.09. |
| 9  | SOFTBALL SIGN. POLE MOUNTED SIGN. SEE DETAIL "G"<br>SHEET L5.05.                         |
| 10 | FIELD I.D. SIGN, SOFTBALL. FENCE MOUNTED SIGN.<br>SEE DETAIL "H" SHEET L5.05.            |
| 11 | SOFTBALL FIELD RULES SIGN. FENCE MOUNTED SIGN.<br>SEE DETAIL "I" SHEET L5.05.            |
| 12 | TENNIS COURT SIGN. FENCE MOUNTED SIGN. SEE DETAIL "G"<br>SHEET L5.07.                    |
| 13 | TENNIS CLASS SIGN. FENCE MOUNTED SIGN. SEE DETAIL "H"<br>SHEET L5.07.                    |
| 14 | TENNIS RULES SIGN. FENCE MOUNTED SIGN. SEE DETAIL "I"<br>SHEET L5.07.                    |
| 15 | PIONEER TRAIL SIGN. POLE MOUNTED SIGN. SEE DETAIL "J"<br>SHEET L5.09.                    |

SIGN NOTES:  
1) NOT ALL SIGNAGE IS SHOWN - SEE CIVIL ENGINEERS  
DRAWINGS FOR ADDITIONAL SIGNAGE.  
2) FOR SIGN POST INSTALLATION AND TYPICAL SIGN MOUNTING  
SEE SHEET L5.08, DETAILS "A" AND "B".  
3) FOR FENCE SIGN PLACEMENT AND ATTACHMENT  
SEE SHEET L5.06, DETAIL "I".

NOTES:

- 1) SEE SHEET L5.01 FOR SITE FURNISHINGS LEGEND AND INFORMATION.
- 2) CONTRACTOR SHALL OBTAIN AND COORDINATE ALL NECESSARY  
PERMITS, INSPECTIONS AND APPROVALS REQUIRED FOR THIS WORK. ALL  
CONSTRUCTION SHALL BE PERFORMED ACCORDING TO LOCAL CODES  
AND ORDINANCES.
- 3) INSTALL ALL PARK EQUIPMENT AND COMPONENTS IN ACCORDANCE  
WITH MANUFACTURER'S SPECIFICATIONS AND INSTRUCTIONS. INSTALL  
ALL PARK EQUIPMENT AND COMPONENTS AT LOCATIONS SHOWN ON  
DRAWINGS, PROPERLY ALIGNED AND SPACED; PLUMBED VERTICALLY,  
COMPLETE AND READY FOR USE. ALL BENCHES ARE TO BE LOCATED AT  
LEAST 10' BEYOND PATH EDGE WHERE ADJACENT TO THE 10' WALKS.  
SEE PLAN ENLARGEMENT SHEETS FOR ADDITIONAL SITE FURNITURE  
LOCATIONS. SECURE OWNER'S APPROVAL OF LOCATIONS PRIOR TO  
MOUNTING.
- 4) THE CONTRACTOR SHALL BE RESPONSIBLE FOR THE ACCURATE  
LAYOUT OF THE PROJECT; FOR ESTABLISHING ALL REFERENCE POINTS  
AND LINES SET FOR CONSTRUCTION. SEE CIVIL DRAWINGS FOR  
HORIZONTAL CONTROL, GRADING AND UTILITY DRAWINGS. VERIFY ALL  
EXISTING CONDITIONS PRIOR TO CONSTRUCTION. BRING ALL  
DISCREPANCIES TO THE ATTENTION OF THE OWNER'S REPRESENTATIVE  
PRIOR TO CONSTRUCTION.
- 5) VERIFY THE LOCATIONS OF ALL UNDERGROUND UTILITIES AND  
SERVICES PRIOR TO ANY EXCAVATION OR CONSTRUCTION.  
CONTRACTOR TO COORDINATE WITH OFF-SITE IMPROVEMENTS AND  
UTILITIES, INCLUDING STREET LIGHTING. CONTRACTOR ASSUMES FULL  
RESPONSIBILITY FOR ALL DAMAGE CAUSED BY THE FAILURE TO DO SO.
- 6) ALL CONCRETE TO BE NATURAL GREY COLOR, MEDIUM BROOM FINISH.  
SCORE PER PLAN. SCORING ALONG 10' WALKS TO BE APPROX. 10'-0" ON  
CENTER. SCORING ALONG 5' WALKS TO BE APPROX 5'-0" ON CENTER.  
MAXIMUM DISTANCE BETWEEN CONTROL JOINTS TO BE 10'.  
MAXIMUM DISTANCE BETWEEN EXPANSION JOINTS TO BE 30'.  
SEE DETAIL 3, SHEET C6.01.

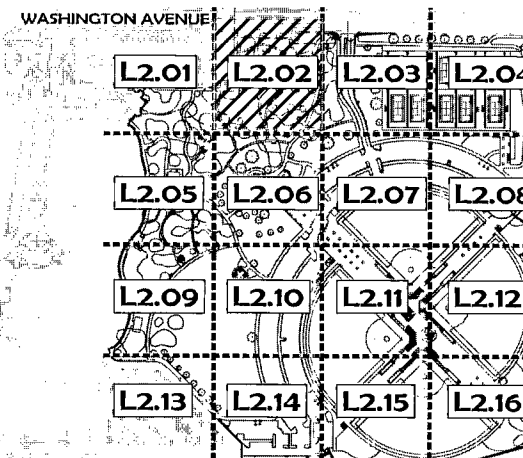

TWIN LAKES DRIVE

KEYMAP NOT TO SCALE

REVISIONS  
OWNER COMMENTS  
10-17-07  
SITE REVISIONS 07/21/08  
RECORD DRAWING 7-10-08  
CONSULTANT  
southwick LA  
702.597.3108  
12 Commerce Center Drive  
Henderson, NV, 89014  
www.southwickla.com

Lorenzi Park Renovations  
Phase 1  
Site Plan

OWNER: CITY OF LAS VEGAS  
DEPARTMENT OF PUBLIC WORKS  
ARCHITECTURAL SERVICES  
400 EAST STEWART AVENUE  
LAS VEGAS, NEVADA 89101  
PHONE: (702) 229-6535  
FAX: (702) 384-4846  
TDD: (702) 386-9158  
DRAWN: SAR  
FILE: 06-083  
DATE: JUNE 2007  
SCALE: AS SHOWN  
REV NO: 01B34.01  
CLV DWG NO: 83018-41  
SHEET NO: L2.02