


**RECORD DRAWINGS
NOT FOR CONSTRUCTION**

1. TO ALTER THESE DOCUMENTS FOR ANOTHER PROJECT BY ANYONE OTHER THAN THE ORIGINAL ARCHITECT IS A VIOLATION OF NRS 623.

2. THIS RECORD DRAWING HAS BEEN PREPARED IN PART, BASED UPON INFORMATION FURNISHED BY THE GENERAL CONTRACTOR, WHILE THIS INFORMATION IS BELIEVED TO BE RELIABLE, THE DESIGN PROFESSIONAL CANNOT ASSURE ITS ACCURACY, AND THUS IS NOT RESPONSIBLE FOR THE ACCURACY OF THIS RECORD DRAWING OR FOR ANY ERRORS OR OMISSIONS WHICH MAY HAVE BEEN INCORPORATED INTO IT AS A RESULT. THE DESIGN PROFESSIONAL CANNOT AND DOES NOT WARRANT THEIR ACCURACY.

3. INFORMATION THAT MAY BE INCLUDED WOULD BE SIGNIFICANT CHANGES TO PLANTING OR IRRIGATION LAYOUT PLANS AND ASSOCIATED DRAWINGS, MINOR DIMENSION OR CONSTRUCTION DETAIL CHANGES MAY NOT BE INCLUDED.

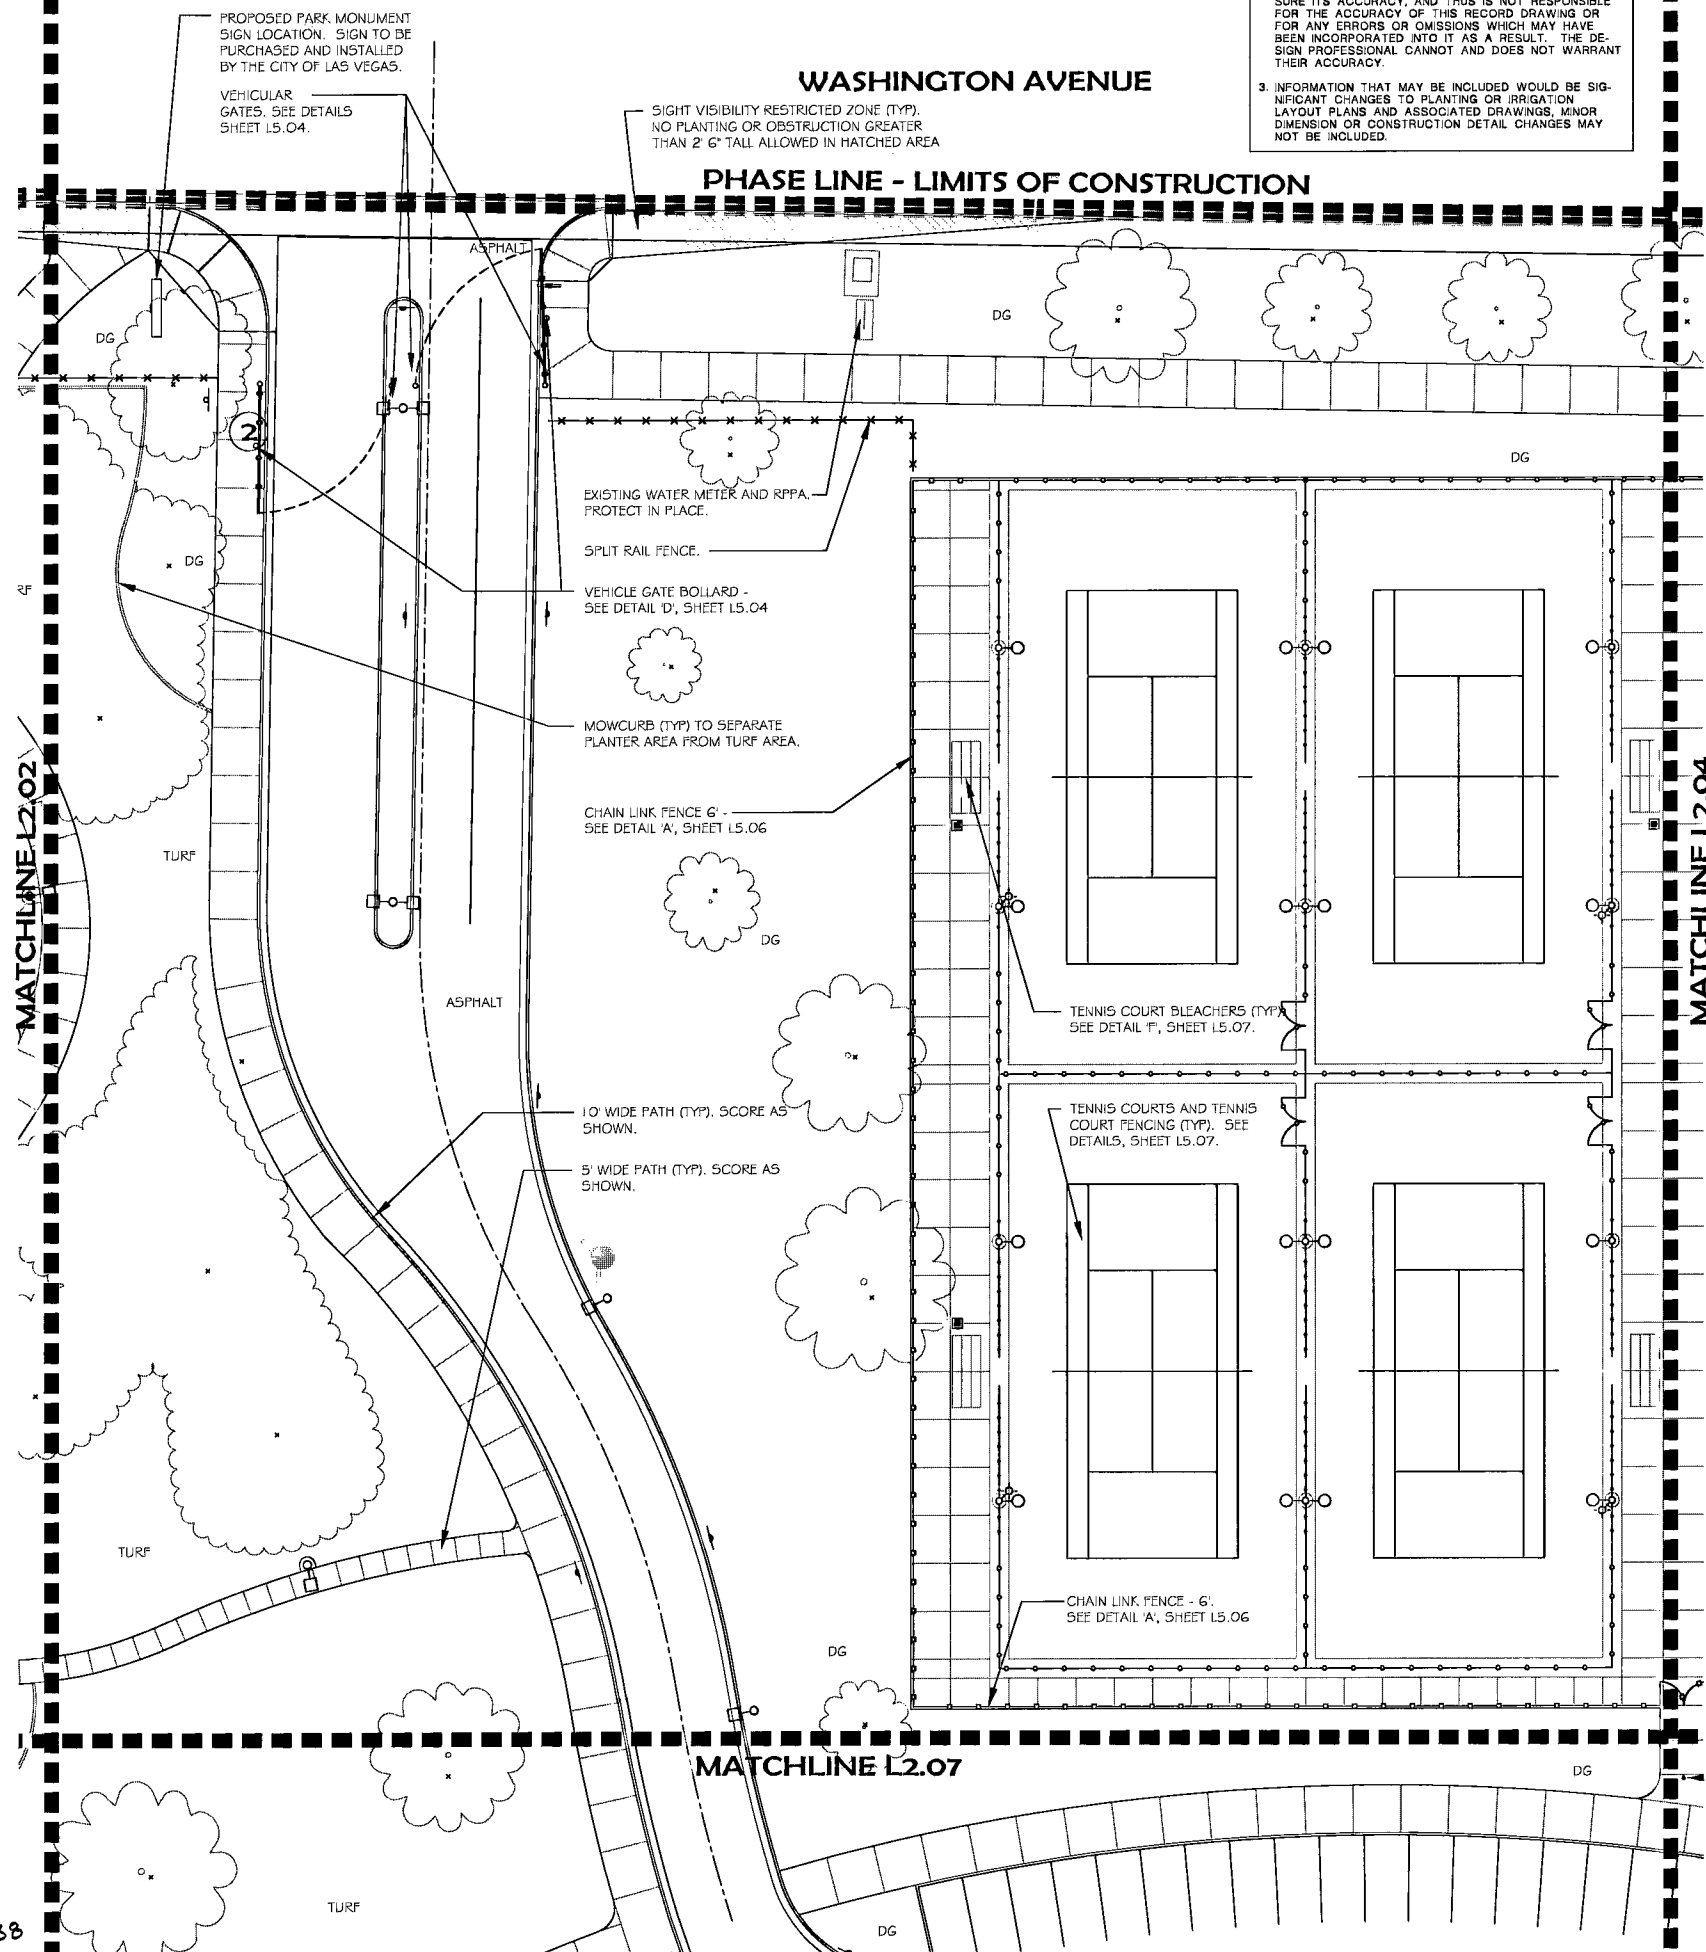

SITE LEGEND	
SYMBOL	DESCRIPTION
[Solid black line]	PHASE LINE / LIMITS OF CONSTRUCTION
[Dashed line]	ADD ALT #1 LIMIT LINE
[Dotted line]	EXISTING CMU WALL, PROTECT IN PLACE
[Stippled pattern]	DECOMPOSED GRANITE
[Wavy line]	MOWCURB SEE DETAIL C, SHEET L5.01
[Cross-hatched pattern]	PERIMETER SPLIT RAIL FENCE SEE DETAILS D' AND E', SHEET L5.01
[Grid pattern]	PARK CONCRETE PATHS AND PLAZAS SEE NOTE 6, THIS SHEET
[Stippled pattern]	RIP-RAP PER CIVIL DRAWINGS SEE PLANTING PLANS FOR RIP-RAP COLOR
[Stippled pattern]	PARK SIGNAGE, SEE PARK SIGN LEGEND, THIS SHEET
[Stippled pattern]	TRAFFIC SIGNAGE, SEE CIVIL DRAWINGS FOR ADDITIONAL INFORMATION
[Stippled pattern]	PERMANENT BOLLARDS AT MAIN PLAZA DROP-OFF SEE DETAIL D', SHEET L5.02 (SQUARE SYMBOL)
[Stippled pattern]	REMOVABLE BOLLARDS AT SHOWMOBILE PLAZA SEE DETAIL E', SHEET L5.02 (ROUND SYMBOL)
[Stippled pattern]	TRASH RECEPTACLE SEE SITE FURNISHINGS LEGEND AND INFORMATION, SHEET L5.01
[Stippled pattern]	BENCH SEE SITE FURNISHINGS LEGEND AND INFORMATION, SHEET L5.01
[Stippled pattern]	ADA ACCESSIBLE PICNIC TABLE SEE SITE FURNISHINGS LEGEND AND INFORMATION, SHEET L5.01
[Stippled pattern]	BIKE RACK SEE SITE FURNISHINGS LEGEND AND INFORMATION, SHEET L5.01
[Stippled pattern]	DRINKING FOUNTAIN, SEE SITE FURNISHINGS LEGEND AND INFORMATION, SHEET L5.01 AND DETAIL N', SHEET C6.02
[Stippled pattern]	DOG WASTE BAG DISPENSER WITH SIGN SEE DETAIL F', SHEET L5.08
[Stippled pattern]	FAMILY BARBECUE GRILL SEE DETAIL B', SHEET L5.02
[Stippled pattern]	LIGHTING, SEE ELECTRICAL DRAWINGS.
[Stippled pattern]	TENNIS MAINTENANCE SHED ON CONCRETE PAD, SEE SITE FURNISHINGS LEGEND AND INFORMATION, SHEET L5.01
[Stippled pattern]	BLEACHERS - 5 BENCHES SEE DETAIL A', SHEET L5.05 AND DETAIL H', SHEET L5.06
[Stippled pattern]	ADAPTIVE TOT LOT WITH SHADE COVER (LARGE) SEE DETAIL A', SHEET L4.06 FOR PLAY STRUCTURE, SEE F52.0 FOR SHADE COVER.
[Stippled pattern]	SOFTBALL FIELD TOT LOT WITH SHADE COVER (SMALL) SEE DETAIL B', SHEET L4.06 FOR PLAY STRUCTURE, SEE F53.0 FOR SHADE COVER.
[Stippled pattern]	50' X 30' SHADE SHELTER SEE SHEETS S51.0 THRU S54.2.
[Stippled pattern]	36' X 36' SHADE SHELTER SEE SHEETS S55.0 THRU S58.2.
[Stippled pattern]	16' X 16' SHADE SHELTER SEE SHEETS S59.0 THRU S61.2.

PARK SIGN LEGEND	
ID	DESCRIPTION
1	SITE SHELTER RESERVATION SIGN, POLE MOUNTED SIGN. SEE DETAIL C, SHEET L5.08
2	PARK RULES SIGN, POLE MOUNTED SIGN. SEE DETAIL D', SHEET L5.08
3	REPORT VANDALISM SIGN, POLE MOUNTED SIGN. SEE DETAIL E', SHEET L5.08
4	DOG SIGN, POLE MOUNTED SIGN. SEE DETAILS F' AND G' SHEET L5.08
5	WALK LOOP TRAIL SIGN, POLE MOUNTED SIGN. SEE DETAIL H' SHEET L5.08
6	HANDICAP SIGN, POLE MOUNTED SIGN. SEE DETAILS A' AND D' SHEET L5.09
7	EXCLUSIVE HANDICAP SIGN, POLE MOUNTED SIGN. SEE DETAILS B' AND E' SHEET L5.09
8	VAN ACCESSIBLE HANDICAP SIGN, POLE MOUNTED SIGN. SEE DETAILS C' AND F' SHEET L5.09
9	SOFTBALL SIGN, POLE MOUNTED SIGN. SEE DETAIL G' SHEET L5.05
10	FIELD I.D. SIGN, SOFTBALL, FENCE MOUNTED SIGN. SEE DETAIL H' SHEET L5.05
11	SOFTBALL FIELD RULES SIGN, FENCE MOUNTED SIGN. SEE DETAIL I' SHEET L5.05
12	TENNIS COURT SIGN, FENCE MOUNTED SIGN. SEE DETAIL G' SHEET L5.07
13	TENNIS CLASS SIGN, FENCE MOUNTED SIGN. SEE DETAIL H' SHEET L5.07
14	TENNIS RULES SIGN, FENCE MOUNTED SIGN. SEE DETAIL I' SHEET L5.07
15	PIONEER TRAIL SIGN, POLE MOUNTED SIGN. SEE DETAIL H' SHEET L5.09

SIGN NOTES:
1) NOT ALL SIGNAGE IS SHOWN - SEE CIVIL ENGINEERS DRAWINGS FOR ADDITIONAL SIGNAGE.
2) FOR SIGN POST INSTALLATION AND TYPICAL SIGN MOUNTING SEE SHEET L5.08, DETAILS A' AND B'.
3) FOR FENCE SIGN PLACEMENT AND ATTACHMENT SEE SHEET L5.06, DETAIL Y'.

NOTES:

1) SEE SHEET L5.01 FOR SITE FURNISHINGS LEGEND AND INFORMATION.


2) CONTRACTOR SHALL OBTAIN AND COORDINATE ALL NECESSARY PERMITS, INSPECTIONS AND APPROVALS REQUIRED FOR THIS WORK. ALL CONSTRUCTION SHALL BE PERFORMED ACCORDING TO LOCAL CODES AND ORDINANCES.

3) INSTALL ALL PARK EQUIPMENT AND COMPONENTS IN ACCORDANCE WITH MANUFACTURER'S SPECIFICATIONS AND INSTRUCTIONS. INSTALL ALL PARK EQUIPMENT AND COMPONENTS AT LOCATIONS SHOWN ON DRAWINGS, PROPERLY ALIGNED AND SPACED; PLUMBED VERTICALLY, COMPLETE AND READY FOR USE. ALL BENCHES ARE TO BE LOCATED AT LEAST 10' BEYOND PATH EDGE WHERE ADJACENT TO THE 10' WALKS. SEE PLAN ENLARGEMENT SHEETS FOR ADDITIONAL SITE FURNITURE LOCATIONS. SECURE OWNERS APPROVAL OF LOCATIONS PRIOR TO MOUNTING.

4) THE CONTRACTOR SHALL BE RESPONSIBLE FOR THE ACCURATE LAYOUT OF THE PROJECT, FOR ESTABLISHING ALL REFERENCE POINTS AND LINES SET FOR CONSTRUCTION. SEE CIVIL DRAWINGS FOR HORIZONTAL CONTROL, GRADING AND UTILITY DRAWINGS. VERIFY ALL EXISTING CONDITIONS PRIOR TO CONSTRUCTION. BRING ALL DISCREPANCIES TO THE ATTENTION OF THE OWNER'S REPRESENTATIVE PRIOR TO CONSTRUCTION.

5) VERIFY THE LOCATIONS OF ALL UNDERGROUND UTILITIES AND SERVICES PRIOR TO ANY EXCAVATION OR CONSTRUCTION. CONTRACTOR TO COORDINATE WITH OFF-SITE IMPROVEMENTS AND UTILITIES, INCLUDING STREET LIGHTING. CONTRACTOR ASSUMES FULL RESPONSIBILITY FOR ALL DAMAGE CAUSED BY THE FAILURE TO DO SO.

6) ALL CONCRETE TO BE NATURAL GREY COLOR, MEDIUM BROOM FINISH. SCORE PER PLAN. SCORING ALONG 10' WALKS TO BE APPROX. 10'-0" ON CENTER. SCORING ALONG 5' WALKS TO BE APPROX 5'-0" ON CENTER. MAXIMUM DISTANCE BETWEEN CONTROL JOINTS TO BE 10'. MAXIMUM DISTANCE BETWEEN EXPANSION JOINTS TO BE 30'. SEE DETAIL 3, SHEET C6.01.

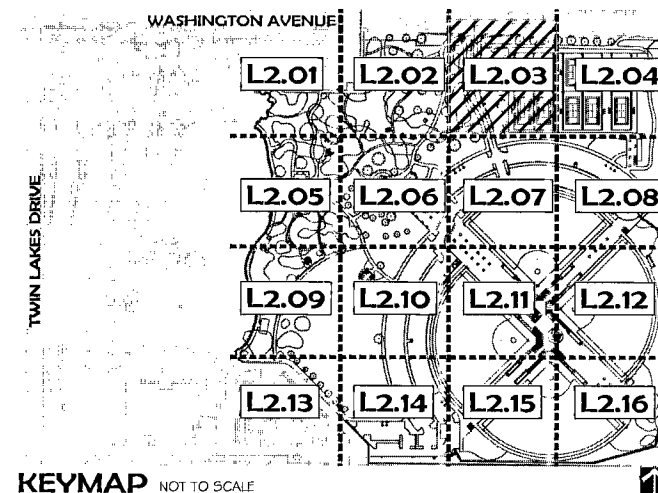

OWNER COMMENTS
10-17-07

3 SITE REVISIONS 07/20/08

RECORD DRAWING 7-0-08

CONSULTANT

southwick LA

702.597.3108
12 Commerce Center Drive
Henderson, NV 89014
www.southwickla.com

Lorenzi Park Renovations
Phase 1
Site Plan

OWNER: CITY OF LAS VEGAS
DEPARTMENT OF PUBLIC WORKS
ARCHITECTURAL SERVICES

100 EAST STEWART AVENUE
LAS VEGAS, NEVADA 89103
PHONE: (702) 229-6535
FAX: (702) 384-6848
TDD: (702) 386-9108

DRAWN: SAR
FILE: 06-083
DATE: JUNE 2007
SCALE: AS SHOWN
BID NO: 075314.01
CITY OF NO: 65018-41
SHEET NO: L2.03