


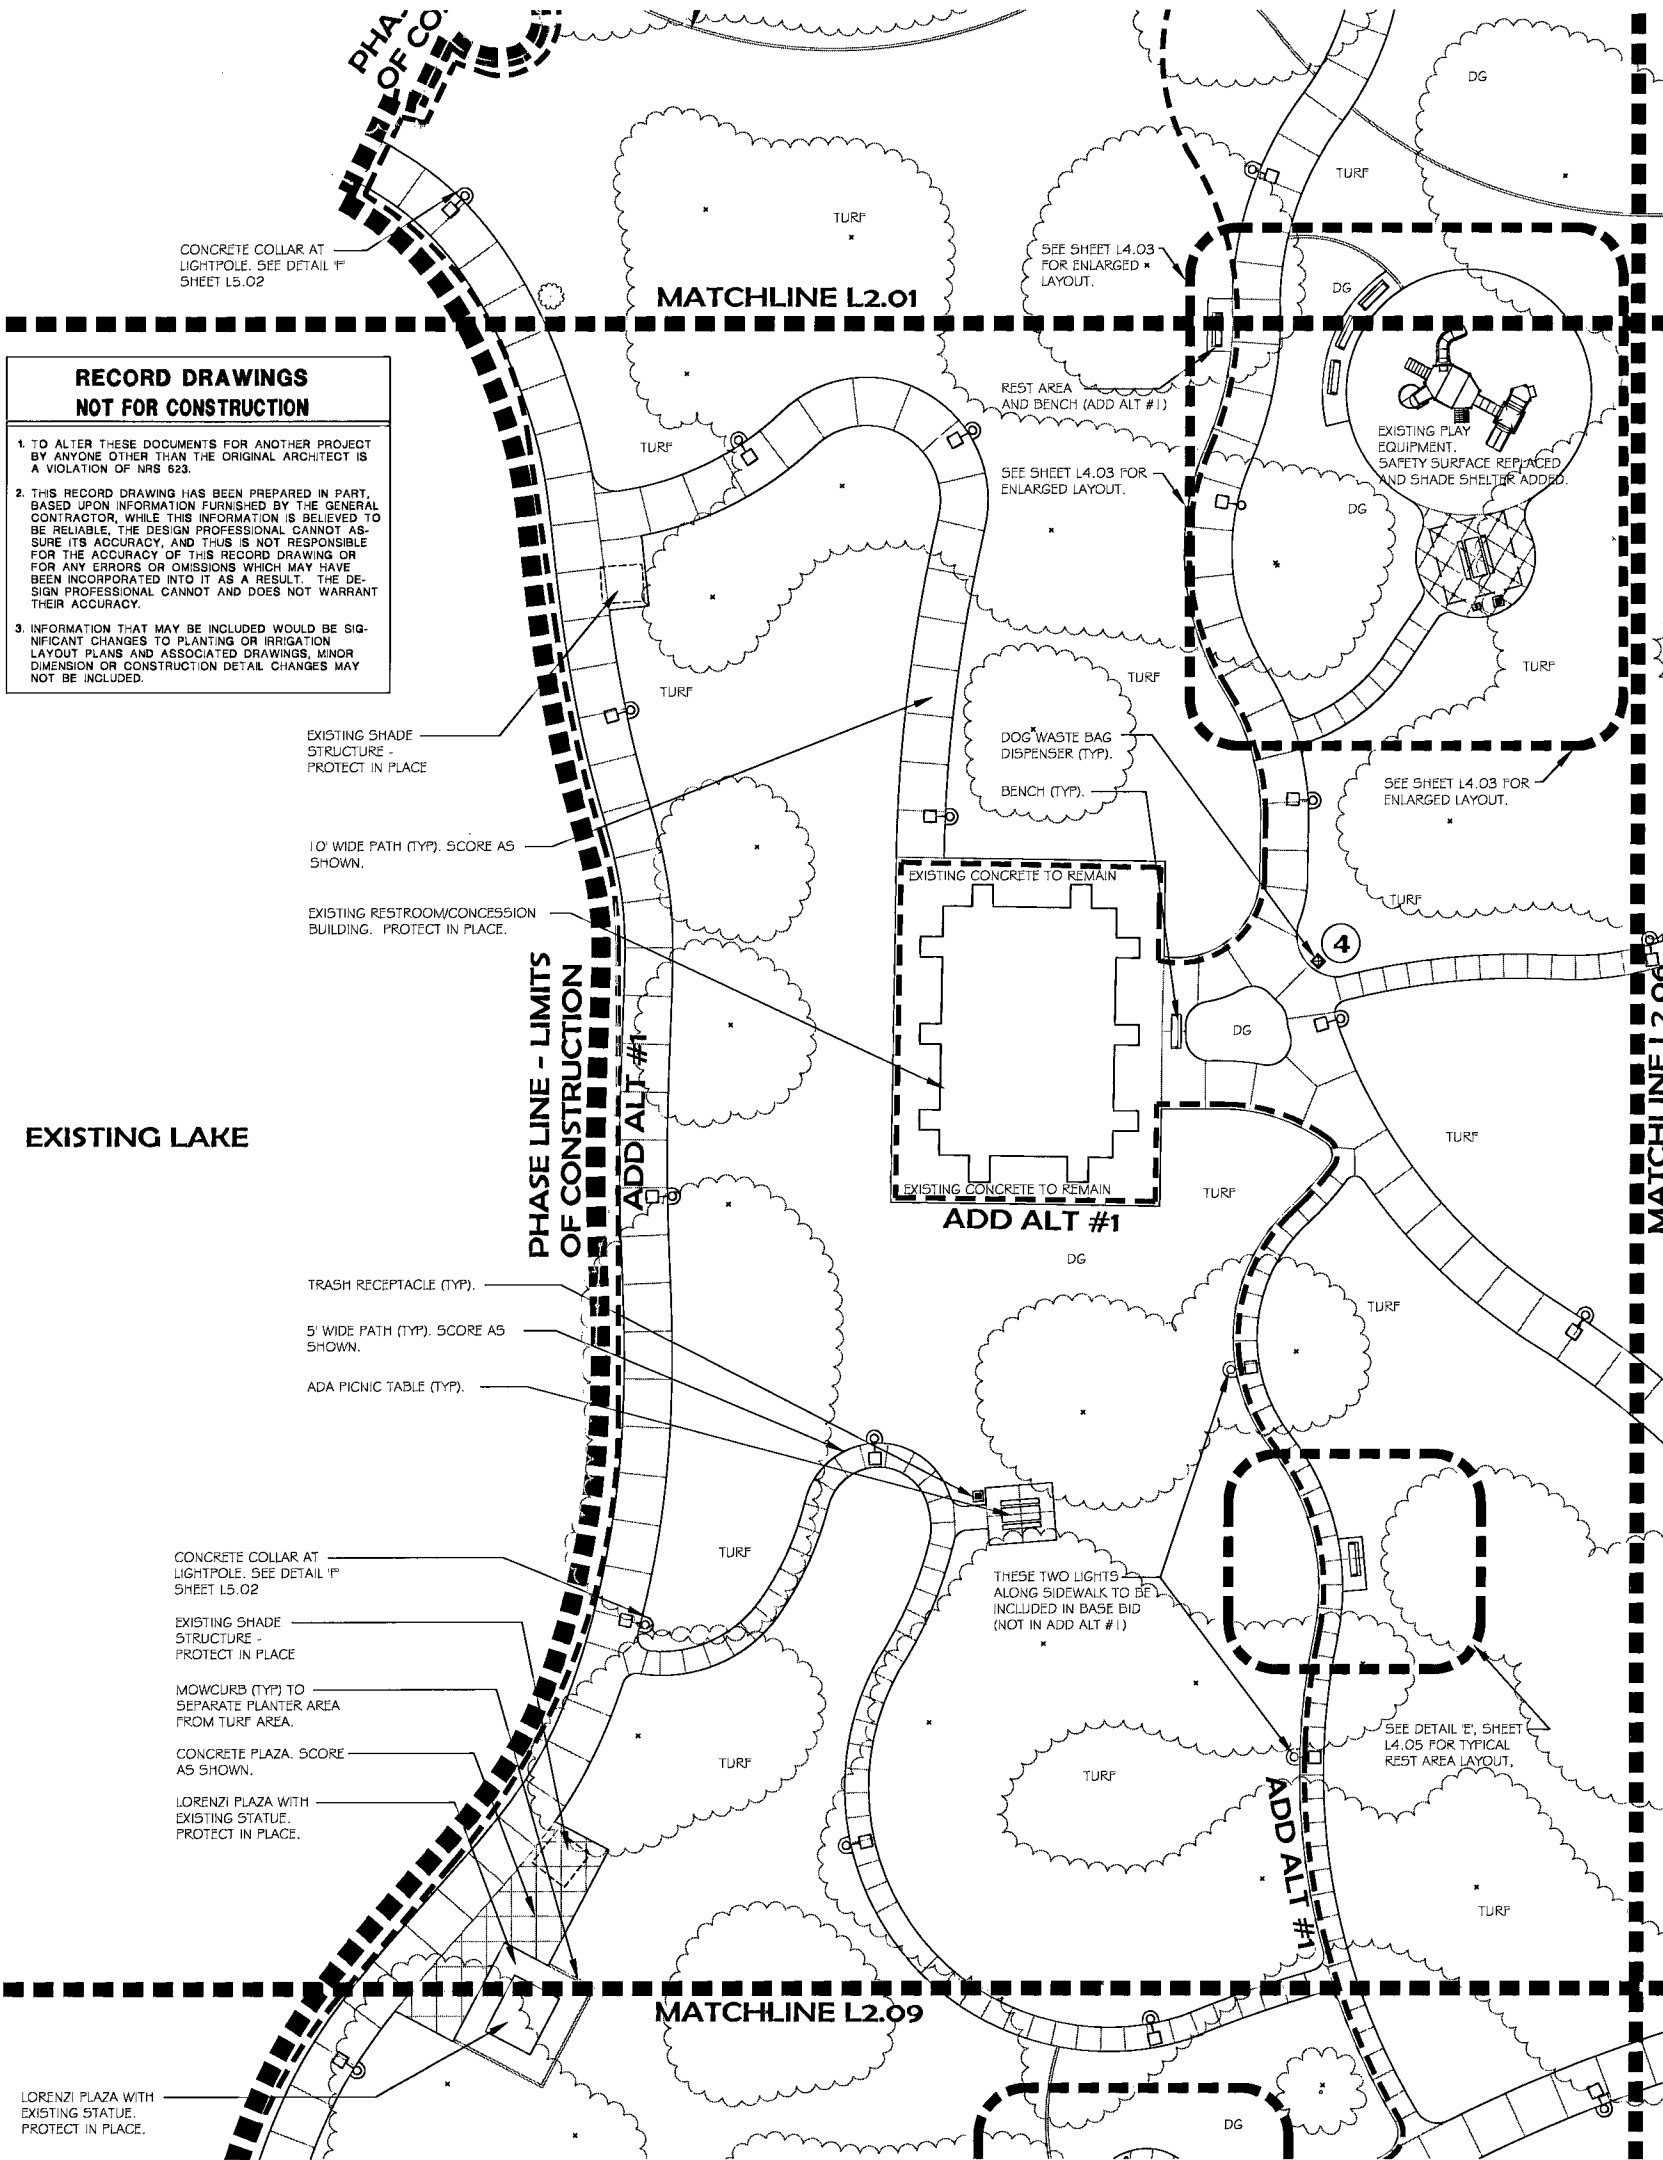

**RECORD DRAWINGS
NOT FOR CONSTRUCTION**

1. TO ALTER THESE DOCUMENTS FOR ANOTHER PROJECT BY ANYONE OTHER THAN THE ORIGINAL ARCHITECT IS A VIOLATION OF NRS 623.

2. THIS RECORD DRAWING HAS BEEN PREPARED IN PART, BASED UPON INFORMATION FURNISHED BY THE GENERAL CONTRACTOR, WHILE THIS INFORMATION IS BELIEVED TO BE RELIABLE, THE DESIGN PROFESSIONAL CANNOT ASSURE ITS ACCURACY, AND THIS IS NOT RESPONSIBLE FOR THE ACCURACY OF THIS RECORD DRAWING OR FOR ANY ERRORS OR OMISSIONS WHICH MAY HAVE BEEN INCORPORATED INTO IT AS A RESULT. THE DESIGN PROFESSIONAL CANNOT AND DOES NOT WARRANT THEIR ACCURACY.

3. INFORMATION THAT MAY BE INCLUDED WOULD BE SIGNIFICANT CHANGES TO PLANTING OR IRRIGATION LAYOUT PLANS AND ASSOCIATED DRAWINGS, MINOR DIMENSION OR CONSTRUCTION DETAIL CHANGES MAY NOT BE INCLUDED.

SITE LEGEND

SYMBOL	DESCRIPTION
	PHASE LINE / LIMITS OF CONSTRUCTION
	ADD ALT #1 LIMIT LINE
	EXISTING CMU WALL, PROTECT IN PLACE
	DECOMPOSED GRANITE
	MOWCURB
	SEE DETAIL 'C', SHEET L5.01
	PERIMETER SPLIT RAIL FENCE
	SEE DETAILS 'D' AND 'E', SHEET L5.01
	PARK, CONCRETE PATHS AND PLAZAS
	SEE NOTE 6, THIS SHEET
	RIP-RAP PER CIVIL DRAWINGS
	SEE PLANTING PLANS FOR RIP-RAP COLOR
	PARK SIGNAGE. SEE PARK SIGN LEGEND, THIS SHEET
	TRAFFIC SIGNAGE. SEE CIVIL DRAWINGS FOR ADDITIONAL INFORMATION
	PERMANENT BOLLARDS AT MAIN PLAZA DROP-OFF
	SEE DETAIL 'D', SHEET L5.02 (SQUARE SYMBOL)
	REMOVABLE BOLLARDS AT SHOWMOBILE PLAZA
	SEE DETAIL 'E', SHEET L5.02 (ROUND SYMBOL)
	TRASH RECEPTACLE
	SEE SITE FURNISHINGS LEGEND AND INFORMATION, SHEET L5.01
	BENCH
	SEE 'SITE FURNISHINGS LEGEND AND INFORMATION', SHEET L5.01
	ADA ACCESSIBLE PICNIC TABLE
	SEE 'SITE FURNISHINGS LEGEND AND INFORMATION', SHEET L5.01
	BIKE RACK
	SEE 'SITE FURNISHINGS LEGEND AND INFORMATION', SHEET L5.01
	DRINKING FOUNTAIN. SEE 'SITE FURNISHINGS LEGEND AND INFORMATION', SHEET L5.01 AND DETAIL 'N', SHEET C6.02
	DOG WASTE BAG DISPENSER WITH SIGN.
	SEE DETAIL 'P', SHEET L5.06
	FAMILY BARBECUE GRILL
	SEE DETAIL 'B', SHEET L5.02
	LIGHTING. SEE ELECTRICAL DRAWINGS.

TENNIS MAINTENANCE SHED ON CONCRETE PAD. SEE 'SITE FURNISHINGS LEGEND AND INFORMATION', SHEET L5.01

BLEACHERS - 5 BENCHES. SEE DETAIL 'A', SHEET L5.05 AND DETAIL 'H', SHEET L5.06

ADAPTIVE TOT LOT WITH SHADE COVER (LARGE) SEE DETAIL 'A', SHEET L4.06 FOR PLAY STRUCTURE. SEE 'F52.0 FOR SHADE COVER.

SOFTBALL FIELD TOT LOT WITH SHADE COVER (SMALL) SEE DETAIL 'B', SHEET L4.06 FOR PLAY STRUCTURE. SEE 'F53.0 FOR SHADE COVER.

50' X 50' SHADE SHELTER. SEE SHEETS 551.0 THRU 554.2.

36' X 36' SHADE SHELTER. SEE SHEETS 555.0 THRU 558.2.

16' X 16' SHADE SHELTER. SEE SHEETS 559.0 THRU 561.2.

SCALE: 1" = 20'-0"

PARK SIGN LEGEND

ID	DESCRIPTION
1	SITE SHELTER RESERVATION SIGN. POLE MOUNTED SIGN. SEE DETAIL 'C', SHEET L5.08
2	PARK RULES SIGN, POLE MOUNTED SIGN. SEE DETAIL 'D', SHEET L5.08.
3	REPORT VANDALISM SIGN. POLE MOUNTED SIGN. SEE DETAIL 'E', SHEET L5.08
4	DOG SIGN, POLE MOUNTED SIGN. SEE DETAILS 'F' AND 'G' SHEET L5.08.
5	WALK LOOP TRAIL SIGN. POLE MOUNTED SIGN. SEE DETAIL 'H' SHEET L5.08.
6	HANDICAP SIGN, POLE MOUNTED SIGN. SEE DETAILS 'A' AND 'D' SHEET L5.09.
7	EXCLUSIVE HANDICAP SIGN, POLE MOUNTED SIGN. SEE DETAILS 'B' AND 'E' SHEET L5.09.
8	VAN ACCESSIBLE HANDICAP SIGN, POLE MOUNTED SIGN. SEE DETAILS 'C' AND 'F' SHEET L5.09.
9	SOFTBALL SIGN. POLE MOUNTED SIGN. SEE DETAIL 'G' SHEET L5.05.
10	FIELD I.D. SIGN, SOFTBALL. FENCE MOUNTED SIGN. SEE DETAIL 'H' SHEET L5.05.
11	SOFTBALL FIELD RULES SIGN. FENCE MOUNTED SIGN. SEE DETAIL 'I' SHEET L5.05.
12	TENNIS COURT SIGN. FENCE MOUNTED SIGN. SEE DETAIL 'G' SHEET L5.07.
13	TENNIS CLASS SIGN. FENCE MOUNTED SIGN. SEE DETAIL 'H' SHEET L5.07.
14	TENNIS RULES SIGN. FENCE MOUNTED SIGN. SEE DETAIL 'I' SHEET L5.07.
15	PIONEER TRAIL SIGN. POLE MOUNTED SIGN. SEE DETAIL 'H' SHEET L5.09.

SIGN NOTES:


1) NOT ALL SIGNAGE IS SHOWN - SEE CIVIL ENGINEERS DRAWINGS FOR ADDITIONAL SIGNAGE.

2) FOR SIGN POST INSTALLATION AND TYPICAL SIGN MOUNTING SEE SHEET L5.08, DETAILS 'A' AND 'B'.

3) FOR FENCE SIGN PLACEMENT AND ATTACHMENT SEE SHEET L5.06, DETAIL 'I'.

NOTES:

- 1) SEE SHEET L5.01 FOR SITE FURNISHINGS LEGEND AND INFORMATION.
- 2) CONTRACTOR SHALL OBTAIN AND COORDINATE ALL NECESSARY PERMITS, INSPECTIONS AND APPROVALS REQUIRED FOR THIS WORK. ALL CONSTRUCTION SHALL BE PERFORMED ACCORDING TO LOCAL CODES AND ORDINANCES.
- 3) INSTALL ALL PARK EQUIPMENT AND COMPONENTS IN ACCORDANCE WITH MANUFACTURER'S SPECIFICATIONS AND INSTRUCTIONS. INSTALL ALL PARK EQUIPMENT AND COMPONENTS AT LOCATIONS SHOWN ON DRAWINGS; PROPERLY ALIGNED AND SPACED; PLUMBED VERTICALLY, COMPLETE AND READY FOR USE. ALL BENCHES ARE TO BE LOCATED AT LEAST 18' BEYOND PATH EDGE WHERE ADJACENT TO THE 10' WALKS. SEE PLAN ENLARGEMENT SHEETS FOR ADDITIONAL SITE FURNITURE LOCATIONS. SECURE OWNERS APPROVAL OF LOCATIONS PRIOR TO MOUNTING.
- 4) THE CONTRACTOR SHALL BE RESPONSIBLE FOR THE ACCURATE LAYOUT OF THE PROJECT; FOR ESTABLISHING ALL REFERENCE POINTS AND LINES SET FOR CONSTRUCTION. SEE CIVIL DRAWINGS FOR HORIZONTAL CONTROL, GRADING AND UTILITY DRAWINGS. VERIFY ALL EXISTING CONDITIONS PRIOR TO CONSTRUCTION. BRING ALL DISCREPANCIES TO THE ATTENTION OF THE OWNERS REPRESENTATIVE PRIOR TO CONSTRUCTION.
- 5) VERIFY THE LOCATIONS OF ALL UNDERGROUND UTILITIES AND SERVICES PRIOR TO ANY EXCAVATION OR CONSTRUCTION. CONTRACTOR TO COORDINATE WITH OFF-SITE IMPROVEMENTS AND UTILITIES, INCLUDING STREET LIGHTING. CONTRACTOR ASSUMES FULL RESPONSIBILITY FOR ALL DAMAGE CAUSED BY THE FAILURE TO DO SO.
- 6) ALL CONCRETE TO BE NATURAL GREY COLOR, MEDIUM BROOM FINISH. SCORE PER PLAN. SCORING ALONG 10' WALKS TO BE APPROX. 10'-0" ON CENTER. SCORING ALONG 5' WALKS TO BE APPROX 5'-0" ON CENTER. MAXIMUM DISTANCE BETWEEN CONTROL JOINTS TO BE 10'. MAXIMUM DISTANCE BETWEEN EXPANSION JOINTS TO BE 30'. SEE DETAIL 3, SHEET C6.01.

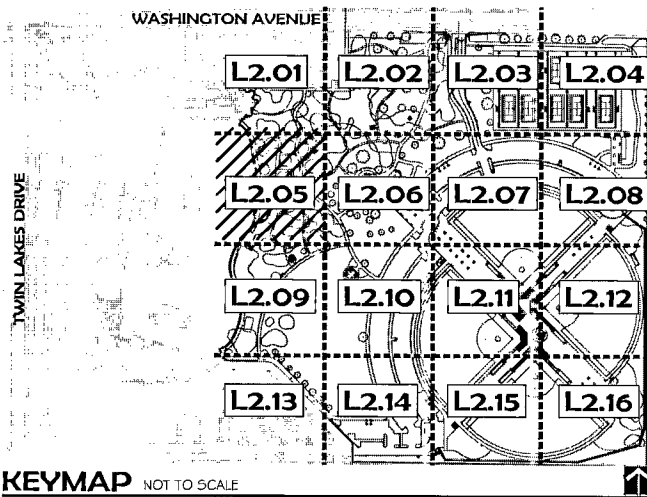

REVISIONS

OWNER COMMENTS

0-17-07

3 SITE REVISIONS 07/21/08

RECORD DRAWING 7-0-08

CONSULTANT

southwick LA

702.597.3108
12 Commerce Center Drive
Henderson, NV 89014
www.southwickla.com

Lorenzi Park Renovations
Phase 1
Site Plan

OWNER: CITY OF LAS VEGAS
DEPARTMENT OF PUBLIC WORKS
ARCHITECTURAL SERVICES

400 EAST STEWART AVENUE
LAS VEGAS, NEVADA 89101
PHONE: (702) 229-6535
FAX: (702) 384-4848
TDD: (702) 386-9108

DRAWN: SAR

FILE: 06-083

DATE: JUNE 2007

SCALE: AS SHOWN

SHEET NO: 07/02/07

CIVIL DWG NO: 650/0-47

SHEET NO: **L2.05**