

F E D C B A

**RECORD DRAWINGS
NOT FOR CONSTRUCTION**

1. TO ALTER THESE DOCUMENTS FOR ANOTHER PROJECT BY ANYONE OTHER THAN THE ORIGINAL ARCHITECT IS A VIOLATION OF NRS 623.

2. THIS RECORD DRAWING HAS BEEN PREPARED IN PART, BASED UPON INFORMATION FURNISHED BY THE GENERAL CONTRACTOR, WHILE THIS INFORMATION IS BELIEVED TO BE RELIABLE, THE DESIGN PROFESSIONAL CANNOT ASSURE ITS ACCURACY, AND THIS IS NOT RESPONSIBLE FOR THE ACCURACY OF THIS RECORD DRAWING OR FOR ANY ERRORS OR OMISSIONS WHICH MAY HAVE BEEN INCORPORATED INTO IT AS A RESULT. THE DESIGN PROFESSIONAL CANNOT AND DOES NOT WARRANT THEIR ACCURACY.

3. INFORMATION THAT MAY BE INCLUDED WOULD BE SIGNIFICANT CHANGES TO PLANTING OR IRRIGATION LAYOUT PLANS AND ASSOCIATED DRAWINGS, MINOR DIMENSION OR CONSTRUCTION DETAIL CHANGES MAY NOT BE INCLUDED.

RECORD DRAWING 7-10-08

USASHADE
A Fabric Structures, Inc.

8505 Chancellor Row
Dallas, Tx 75247
1 800 966 5005

Sun Ports

Offices in: Dallas, TX Austin, TX
Las Vegas, NV and Mesa, AZ

Certifications:
IAS Certification No. FA-428
Clark County Manufacturer Cert No. 355

Customer
Southwick Landscape Architects

Project
Lorenzi Park for the City of Las Vegas

Location
Las Vegas NV

Structure
T-Cantilever Unit 3

Size
20'-0" wide x 13'-6"

BID No 07-15314.01
CLV Dwg. No 650.19-47
100% CD Document
Not for construction

Drawing Description
Details

Drawing No.
700-12093

FILE / DPIC:
700-12093.dwg


Date
May 7, 2007

Drawing by:
J. Hernandez


Checked by:
J. Margarito

Job No
29997


Page
FS 5.4

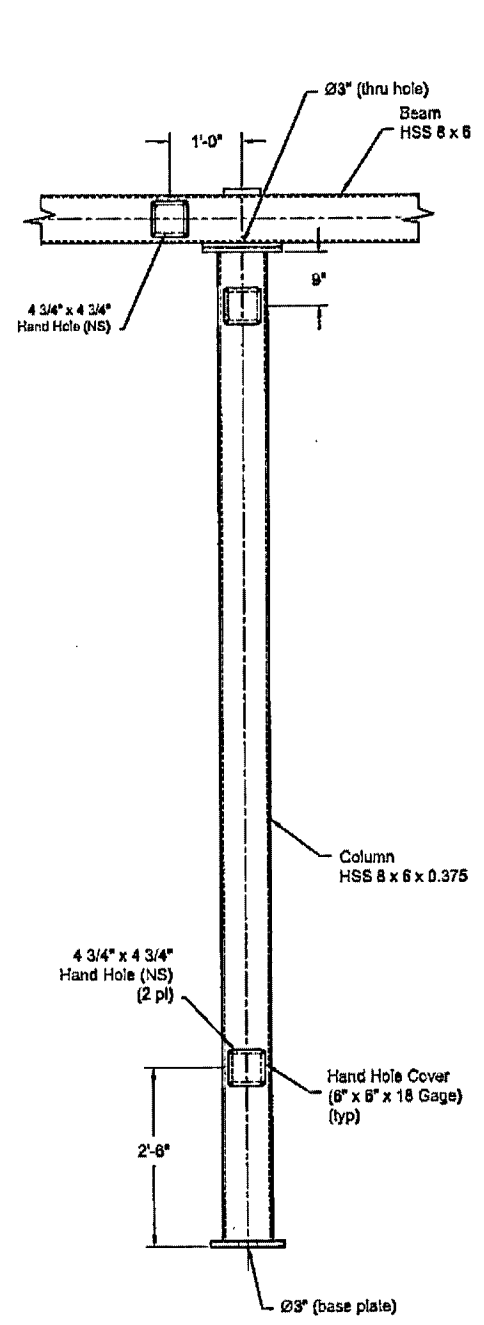


DETAIL K

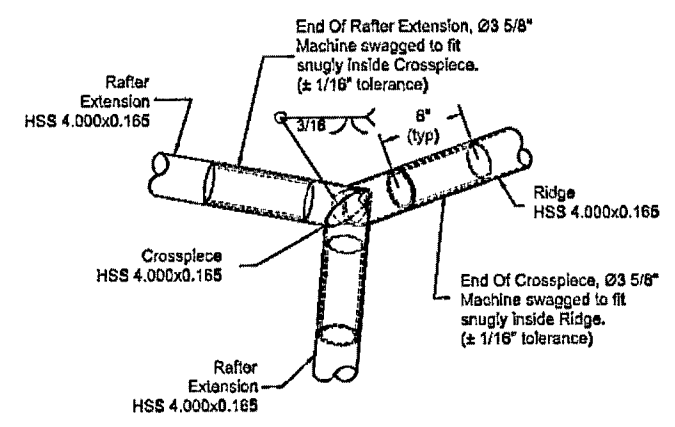

DETAIL L

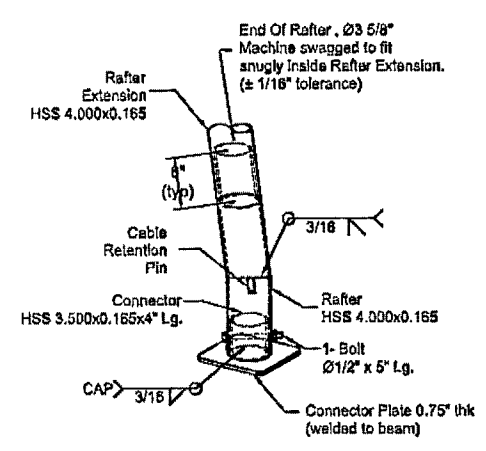


DETAIL M

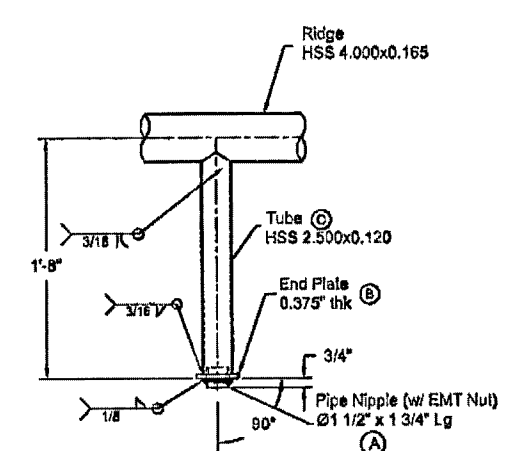


**DETAIL J
(Before Light Installation)**

Note:
Pipe nipple (item A) must be welded to plate (item B) before welding plate (item B) to tube (item C).

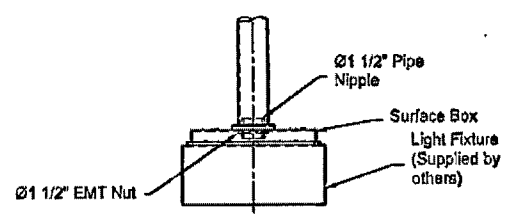


**DETAIL J
(After Light Installation)**

Note:
All structure information shall be examined to determine where access holes for concealed electrical wiring should be located.

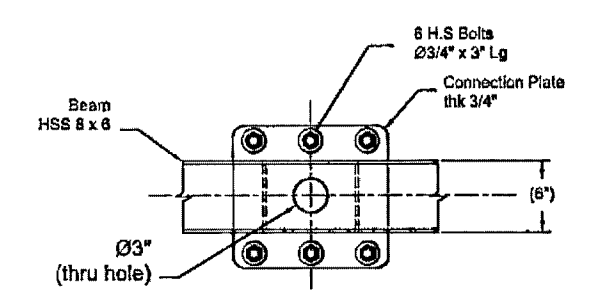

SECTION P-P

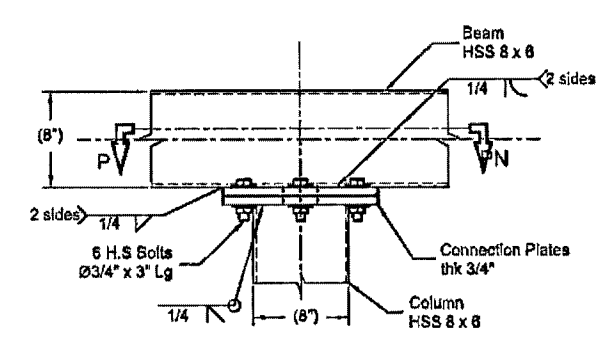

**COLUMN - BEAM CONNECTION
FRONT VIEW**

DETAIL N

F E D C B A