


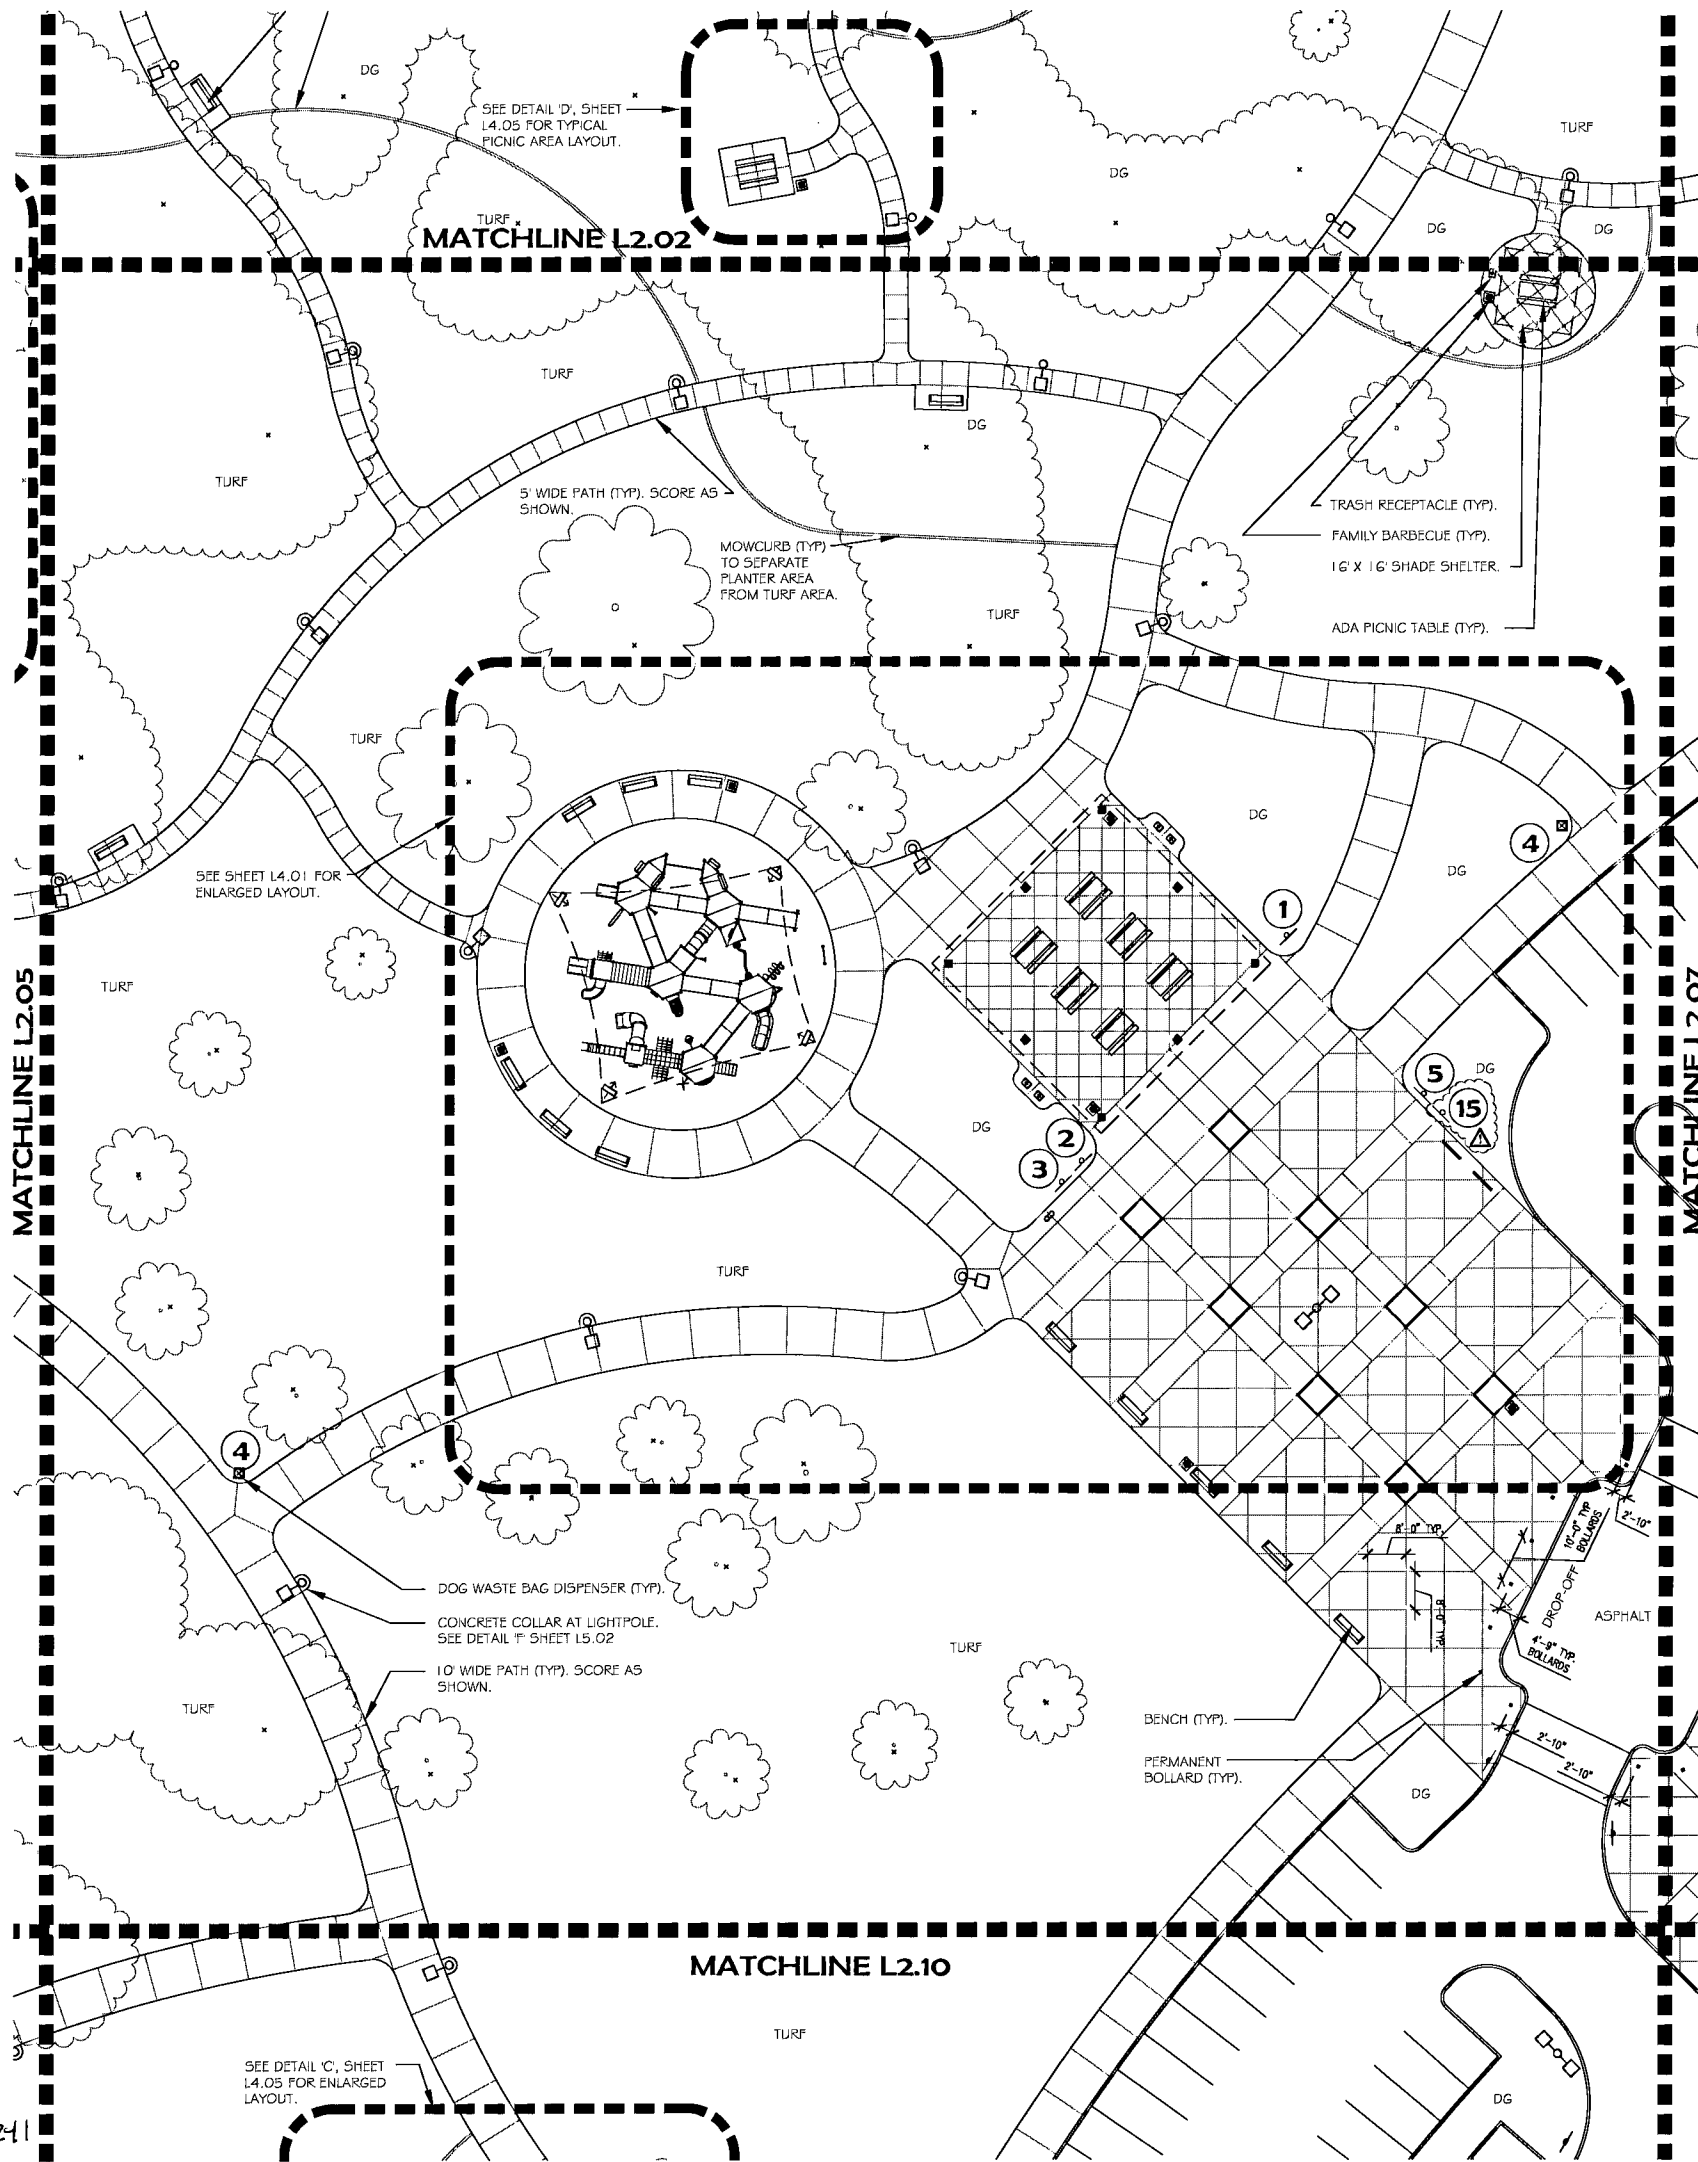

SITE LEGEND

SYMBOL	DESCRIPTION
	PHASE LINE / LIMITS OF CONSTRUCTION
	ADD ALT #1 LIMIT LINE
	EXISTING CMU WALL, PROTECT IN PLACE
	DECOMPOSED GRANITE
	MOWCURB
	PERIMETER SPLIT RAIL FENCE
	PARK CONCRETE PATHS AND PLAZAS
	RIP-RAP PER CIVIL DRAWINGS
	PARK SIGNAGE. SEE PARK SIGN LEGEND, THIS SHEET
	TRAFFIC SIGNAGE. SEE CIVIL DRAWINGS FOR ADDITIONAL INFORMATION
	PERMANENT BOLLARDS AT MAIN PLAZA DROP-OFF
	REMOVABLE BOLLARDS AT SHOWMOBILE PLAZA
	TRASH RECEPTACLE
	BENCH
	ADA ACCESSIBLE PICNIC TABLE
	BIKE RACK
	DRINKING FOUNTAIN. SEE 'SITE FURNISHINGS LEGEND AND INFORMATION', SHEET L5.01 AND DETAIL 'N', SHEET C6.02
	DOG WASTE BAG DISPENSER WITH SIGN.
	FAMILY BARBECUE GRILL
	LIGHTING. SEE ELECTRICAL DRAWINGS.
	TENNIS MAINTENANCE SHED ON CONCRETE PAD. SEE 'SITE FURNISHINGS LEGEND AND INFORMATION', SHEET L5.01
	BLEACHERS - 5 BENCHES.
	ADAPTIVE TOT LOT WITH SHADE COVER (LARGE)
	SOFTBALL FIELD TOT LOT WITH SHADE COVER (SMALL)
	50' X 50' SHADE SHELTER
	36' X 36' SHADE SHELTER
	16' X 16' SHADE SHELTER


PARK SIGN LEGEND

ID	DESCRIPTION
1	SITE SHELTER RESERVATION SIGN. POLE MOUNTED SIGN. SEE DETAIL 'C', SHEET L5.08.
2	PARK RULES SIGN. POLE MOUNTED SIGN. SEE DETAIL 'D', SHEET L5.08.
3	REPORT VANDALISM SIGN. POLE MOUNTED SIGN. SEE DETAIL 'E', SHEET L5.08.
4	DOG SIGN. POLE MOUNTED SIGN. SEE DETAILS 'F' AND 'G' SHEET L5.08.
5	WALK LOOP TRAIL SIGN. POLE MOUNTED SIGN. SEE DETAIL 'H' SHEET L5.08.
6	HANDICAP SIGN. POLE MOUNTED SIGN. SEE DETAILS 'A' AND 'D' SHEET L5.09.
7	EXCLUSIVE HANDICAP SIGN. POLE MOUNTED SIGN. SEE DETAILS 'B' AND 'E' SHEET L5.09.
8	VAN ACCESSIBLE HANDICAP SIGN. POLE MOUNTED SIGN. SEE DETAILS 'C' AND 'F' SHEET L5.09.
9	SOFTBALL SIGN. POLE MOUNTED SIGN. SEE DETAIL 'G' SHEET L5.09.
10	FIELD I.D. SIGN, SOFTBALL. FENCE MOUNTED SIGN. SEE DETAIL 'H' SHEET L5.09.
11	SOFTBALL FIELD RULES SIGN. FENCE MOUNTED SIGN. SEE DETAIL 'I' SHEET L5.09.
12	TENNIS COURT SIGN. FENCE MOUNTED SIGN. SEE DETAIL 'G' SHEET L5.07.
13	TENNIS CLASS SIGN. FENCE MOUNTED SIGN. SEE DETAIL 'H' SHEET L5.07.
14	TENNIS RULES SIGN. FENCE MOUNTED SIGN. SEE DETAIL 'I' SHEET L5.07.
15	PIONEER TRAIL SIGN. POLE MOUNTED SIGN. SEE DETAIL 'H' SHEET L5.09.

SIGN NOTES:
1) NOT ALL SIGNAGE IS SHOWN - SEE CIVIL ENGINEERS DRAWINGS FOR ADDITIONAL SIGNAGE.
2) FOR SIGN POST INSTALLATION AND TYPICAL SIGN MOUNTING SEE SHEET L5.08, DETAILS 'A' AND 'B'.
3) FOR FENCE SIGN PLACEMENT AND ATTACHMENT SEE SHEET L5.06, DETAIL 'I'.

RECORD DRAWINGS NOT FOR CONSTRUCTION

1. TO ALTER THESE DOCUMENTS FOR ANOTHER PROJECT BY ANYONE OTHER THAN THE ORIGINAL ARCHITECT IS A VIOLATION OF NRS 623.
2. THIS RECORD DRAWING HAS BEEN PREPARED IN PART, BASED UPON INFORMATION FURNISHED BY THE GENERAL CONTRACTOR, WHILE THIS INFORMATION IS BELIEVED TO BE RELIABLE, THE DESIGN PROFESSIONAL CANNOT ASSURE ITS ACCURACY, AND THIS IS NOT RESPONSIBLE FOR THE ACCURACY OF THIS RECORD DRAWING OR FOR ANY ERRORS OR OMISSIONS WHICH MAY HAVE BEEN INCORPORATED INTO IT AS A RESULT. THE DESIGN PROFESSIONAL CANNOT AND DOES NOT WARRANT THEIR ACCURACY.
3. INFORMATION THAT MAY BE INCLUDED WOULD BE SIGNIFICANT CHANGES TO PLANTING OR IRRIGATION LAYOUT PLANS AND ASSOCIATED DRAWINGS, MINOR DIMENSION OR CONSTRUCTION DETAIL CHANGES MAY NOT BE INCLUDED.

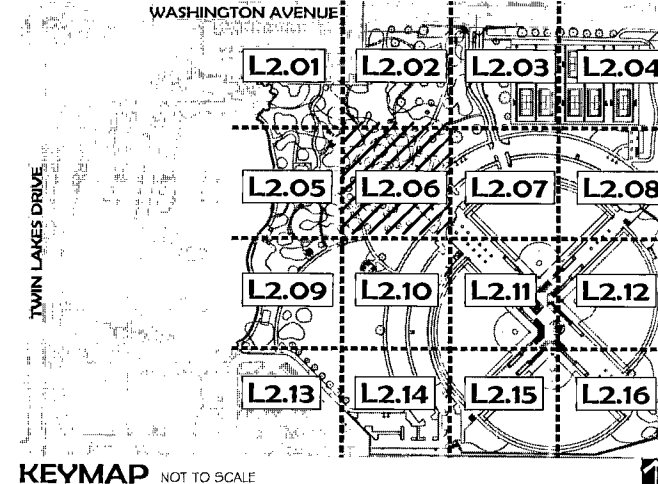

OWNER COMMENTS
10-17-07
SITE REVISIONS
RECORD DRAWING 7-10-08
CONSULTANT
southwick LA
702.597.3108
12 Commerce Center Drive
Henderson, NV 89014
www.southwickla.com

Lorenzi Park Renovations
Phase 1
Site Plan

OWNER: CITY OF LAS VEGAS
DEPARTMENT OF PUBLIC WORKS
ARCHITECTURAL SERVICES
400 EAST STEWART AVENUE
LAS VEGAS, NEVADA 89101
PHONE: (702) 229-6535
FAX: (702) 384-6846
TDD: (702) 386-9108
DRAWN: SAR
FILE: 06-083
DATE: JUNE 2007
SCALE: AS SHOWN
BID NO: 071834.01
CLV DWG NO: 65075-41
SHEET NO: L2.06