


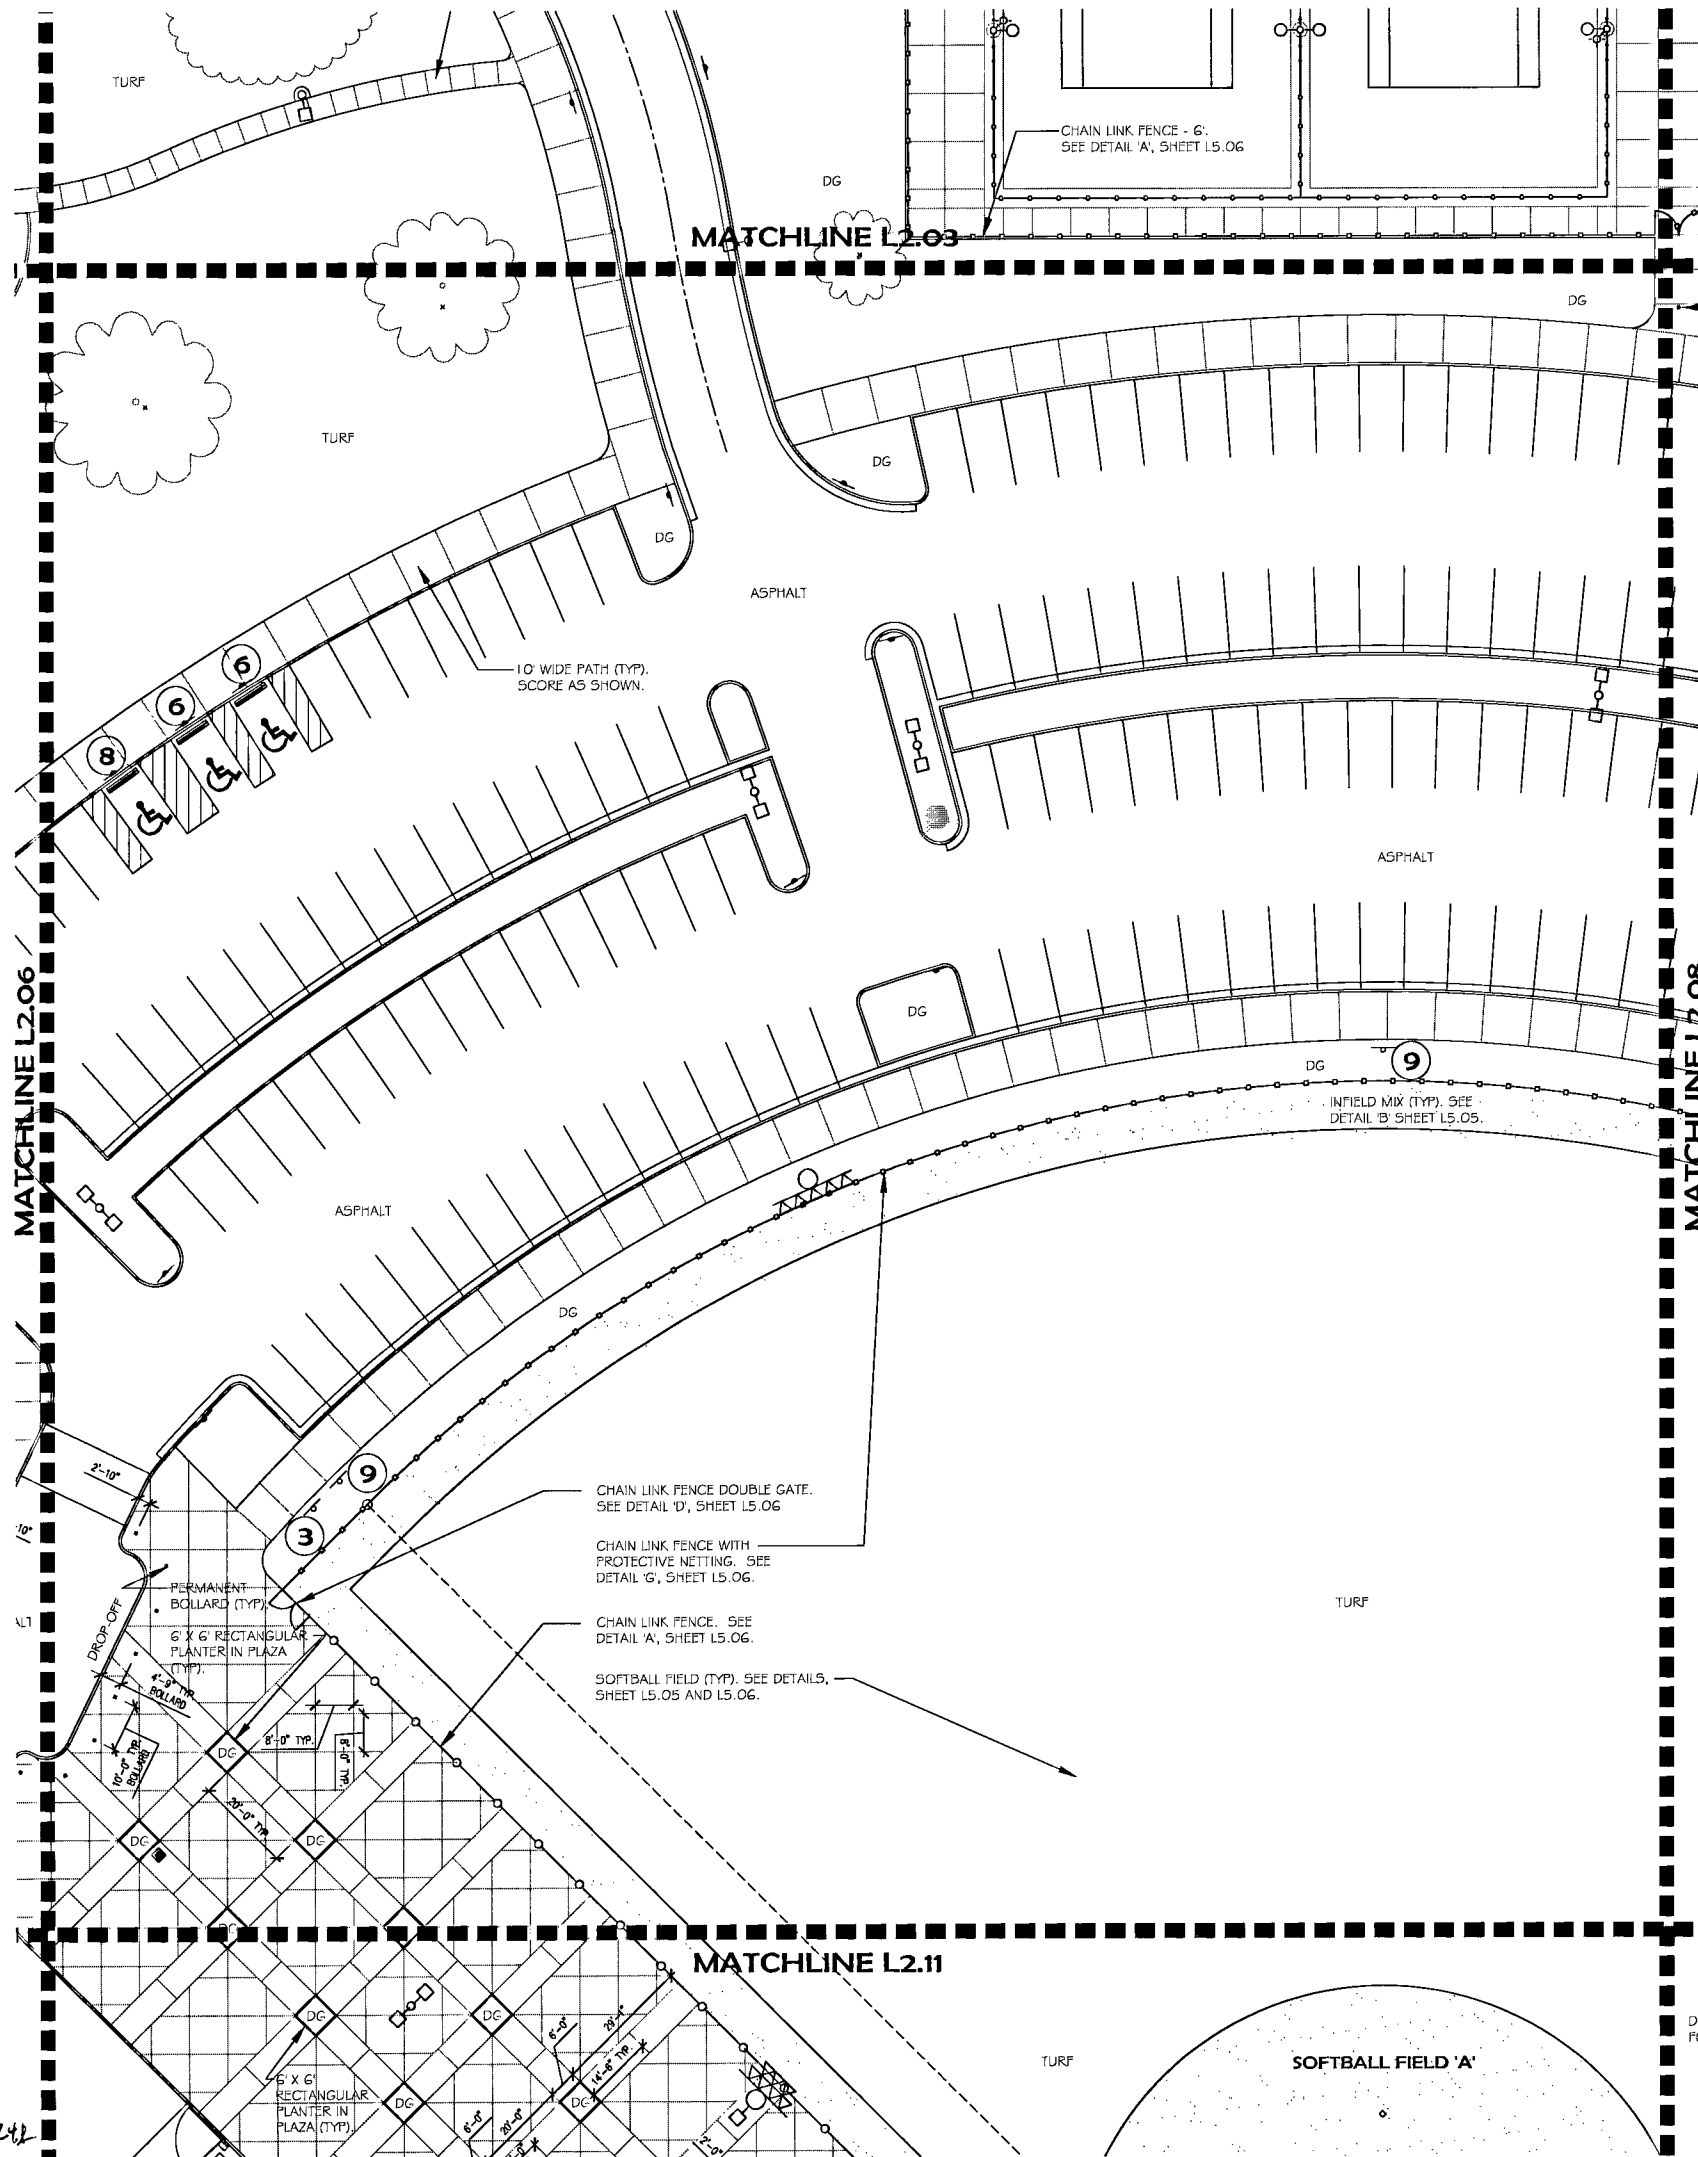

SITE LEGEND

SYMBOL	DESCRIPTION
	PHASE LINE / LIMITS OF CONSTRUCTION
	ADD ALT #1 LIMIT LINE
	EXISTING CMU WALL, PROTECT IN PLACE
	DECOMPOSED GRANITE
	MOWCURB SEE DETAIL 'C', SHEET L5.01
	PERIMETER SPLIT RAIL FENCE SEE DETAILS 'D' AND 'E', SHEET L5.01
	PARK CONCRETE PATHS AND PLAZAS SEE NOTE 6, THIS SHEET
	RIP-RAP PER CIVIL DRAWINGS SEE PLANTING PLANS FOR RIP-RAP COLOR
	PARK SIGNAGE. SEE PARK SIGN LEGEND, THIS SHEET
	TRAFFIC SIGNAGE. SEE CIVIL DRAWINGS FOR ADDITIONAL INFORMATION
	PERMANENT BOLLARDS AT MAIN PLAZA DROP-OFF SEE DETAIL 'D', SHEET L5.02 (SQUARE SYMBOL)
	REMOVABLE BOLLARDS AT SHOWMOBILE PLAZA SEE DETAIL 'E', SHEET L5.02 (ROUND SYMBOL)
	TRASH RECEPTACLE SEE 'SITE FURNISHINGS LEGEND AND INFORMATION', SHEET L5.01
	BENCH SEE 'SITE FURNISHINGS LEGEND AND INFORMATION', SHEET L5.01
	ADA ACCESSIBLE PICNIC TABLE SEE 'SITE FURNISHINGS LEGEND AND INFORMATION', SHEET L5.01
	BIKE RACK SEE 'SITE FURNISHINGS LEGEND AND INFORMATION', SHEET L5.01
	DRINKING FOUNTAIN. SEE 'SITE FURNISHINGS LEGEND AND INFORMATION', SHEET L5.01 AND DETAIL 'N', SHEET C6.02
	DOG WASTE BAG DISPENSER WITH SIGN. SEE DETAIL 'F', SHEET L5.08
	FAMILY BARBECUE GRILL SEE DETAIL 'B', SHEET L5.02
	LIGHTING. SEE ELECTRICAL DRAWINGS.
	TENNIS MAINTENANCE SHED ON CONCRETE PAD. SEE 'SITE FURNISHINGS LEGEND AND INFORMATION', SHEET L5.01
	BLEACHERS - 5 BENCHES. SEE DETAIL 'A', SHEET L5.05 AND DETAIL 'H', SHEET L5.06
	ADAPTIVE TOT LOT WITH SHADE COVER (LARGE) SEE DETAIL 'A', SHEET L4.06 FOR PLAY STRUCTURE. SEE P52.0 FOR SHADE COVER.
	SOFTBALL FIELD TOT LOT WITH SHADE COVER (SMALL) SEE DETAIL 'B', SHEET L4.06 FOR PLAY STRUCTURE. SEE P53.0 FOR SHADE COVER.
	50' X 50' SHADE SHELTER SEE SHEETS S51.0 THRU S54.2.
	36' X 36' SHADE SHELTER SEE SHEETS S55.0 THRU S58.2.
	16' X 16' SHADE SHELTER SEE SHEETS S59.0 THRU S61.2.


PARK SIGN LEGEND

ID	DESCRIPTION
1	SITE SHELTER RESERVATION SIGN. POLE MOUNTED SIGN. SEE DETAIL 'C', SHEET L5.08
2	PARK RULES SIGN. POLE MOUNTED SIGN. SEE DETAIL 'D', SHEET L5.08.
3	REPORT VANDALISM SIGN. POLE MOUNTED SIGN. SEE DETAIL 'E', SHEET L5.08.
4	DOG SIGN. POLE MOUNTED SIGN. SEE DETAILS 'F' AND 'G' SHEET L5.08.
5	WALK LOOP TRAIL SIGN. POLE MOUNTED SIGN. SEE DETAIL 'H' SHEET L5.08.
6	HANDICAP SIGN. POLE MOUNTED SIGN. SEE DETAILS 'A' AND 'D' SHEET L5.09.
7	EXCLUSIVE HANDICAP SIGN. POLE MOUNTED SIGN. SEE DETAILS 'B' AND 'E' SHEET L5.09.
8	VAN ACCESSIBLE HANDICAP SIGN. POLE MOUNTED SIGN. SEE DETAILS 'C' AND 'F' SHEET L5.09.
9	SOFTBALL SIGN. POLE MOUNTED SIGN. SEE DETAIL 'G' SHEET L5.09.
10	FIELD I.D. SIGN. SOFTBALL. FENCE MOUNTED SIGN. SEE DETAIL 'H' SHEET L5.05.
11	SOFTBALL FIELD RULES SIGN. FENCE MOUNTED SIGN. SEE DETAIL 'I' SHEET L5.05.
12	TENNIS COURT SIGN. FENCE MOUNTED SIGN. SEE DETAIL 'G' SHEET L5.07.
13	TENNIS CLASS SIGN. FENCE MOUNTED SIGN. SEE DETAIL 'H' SHEET L5.07.
14	TENNIS RULES SIGN. FENCE MOUNTED SIGN. SEE DETAIL 'I' SHEET L5.07.
15	PIONEER TRAIL SIGN. POLE MOUNTED SIGN. SEE DETAIL 'H' SHEET L5.09.

SIGN NOTES:
1) NOT ALL SIGNAGE IS SHOWN - SEE CIVIL ENGINEERS DRAWINGS FOR ADDITIONAL SIGNAGE.
2) FOR SIGN POST INSTALLATION AND TYPICAL SIGN MOUNTING SEE SHEET L5.08, DETAILS 'A' AND 'B'.
3) FOR FENCE SIGN PLACEMENT AND ATTACHMENT SEE SHEET L5.06, DETAIL 'I'.


RECORD DRAWINGS NOT FOR CONSTRUCTION

1. TO ALTER THESE DOCUMENTS FOR ANOTHER PROJECT BY ANYONE OTHER THAN THE ORIGINAL ARCHITECT IS A VIOLATION OF NRS 623.
2. THIS RECORD DRAWING HAS BEEN PREPARED IN PART, BASED UPON INFORMATION FURNISHED BY THE GENERAL CONTRACTOR. WHILE THIS INFORMATION IS BELIEVED TO BE RELIABLE, THE DESIGN PROFESSIONAL CANNOT ASSURE ITS ACCURACY, AND THIS IS NOT RESPONSIBLE FOR THE ACCURACY OF THIS RECORD DRAWING OR FOR ANY ERRORS OR OMISSIONS WHICH MAY HAVE BEEN INCORPORATED INTO IT AS A RESULT. THE DESIGN PROFESSIONAL CANNOT AND DOES NOT WARRANT THEIR ACCURACY.
3. INFORMATION THAT MAY BE INCLUDED WOULD BE SIGNIFICANT CHANGES TO PLANTING OR IRRIGATION LAYOUT PLANS AND ASSOCIATED DRAWINGS. MINOR DIMENSION OR CONSTRUCTION DETAIL CHANGES MAY NOT BE INCLUDED.

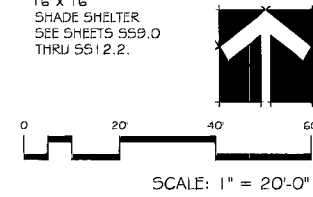

TWIN LAKES DRIVE

KEYMAP NOT TO SCALE

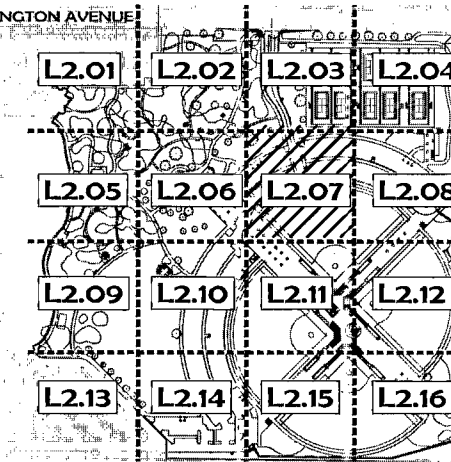

REVISIONS
OWNER COMMENTS
0-17-07
RECORD DRAWING 7-2-07
CONSULTANT
southwick LA
702.597.3108
12 Commerce Center Drive
Henderson, NV 89014
www.southwickla.com

Lorenzi Park Renovations
Phase 1
Site Plan

OWNER: CITY OF LAS VEGAS
DEPARTMENT OF PUBLIC WORKS
ARCHITECTURAL SERVICES
400 EAST STEWART AVENUE
LAS VEGAS, NEVADA 89101
PHONE: (702) 259-6535
FAX: (702) 384-4846
TDD: (702) 386-9108
DRAWN: SAR
FILE: 06-083
DATE: JUNE 2007
SCALE: AS SHOWN
SHEET NO: 01/33/4/01
CLY DWG NO: 65015-41
SHEET NO: L2.07