 
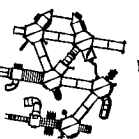
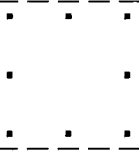
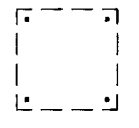


| SITE FURNISHINGS LEGEND & INFORMATION                                               |                                           |      |                                                                                                                                                                                                                                                                                                                                                                                                                                                                                                                   |            |                  |
|-------------------------------------------------------------------------------------|-------------------------------------------|------|-------------------------------------------------------------------------------------------------------------------------------------------------------------------------------------------------------------------------------------------------------------------------------------------------------------------------------------------------------------------------------------------------------------------------------------------------------------------------------------------------------------------|------------|------------------|
| SYMBOL                                                                              | ITEM                                      | QTY. | DESCRIPTION                                                                                                                                                                                                                                                                                                                                                                                                                                                                                                       | DETAIL     |                  |
|                                                                                     |                                           |      |                                                                                                                                                                                                                                                                                                                                                                                                                                                                                                                   | DETAIL     | SHEET            |
|    | CONCRETE MOWCURB                          | -    | CONCRETE MOWCURB, BETWEEN ALL TURF AND PLANTING AREAS.                                                                                                                                                                                                                                                                                                                                                                                                                                                            | C          | L5.01            |
|    | SPLIT RAIL FENCE                          | -    | PERIMETER SITE FENCE ALONG WASHINGTON AVENUE. SEE SITE LAYOUT PLANS FOR EXACT LOCATION.                                                                                                                                                                                                                                                                                                                                                                                                                           | D, E       | L5.01            |
|    | PARK CONCRETE PATHS AND PLAZAS            | -    | CONCRETE PATHS AND PLAZAS. NATURAL GRAY CONCRETE, MEDIUM BROOM FINISH, SCORE PER PLAN.                                                                                                                                                                                                                                                                                                                                                                                                                            | A, B       | L5.01            |
|    | BOLLARD                                   | 16   | BOLLARD ALONG DROP-OFF AREA                                                                                                                                                                                                                                                                                                                                                                                                                                                                                       | D          | L5.02            |
|    | REMOVABLE BOLLARD                         | 16   | REMOVABLE BOLLARD                                                                                                                                                                                                                                                                                                                                                                                                                                                                                                 | E          | L5.02            |
|    | TRASH RECEPTACLE                          | 37   | TRASH RECEPTACLE. MODEL #Q5-P52532W-A21, T1-SMOOTH STAINED CONCRETE, COLOR: SAND, WITH STANDARD GLOSS SEALER, CAST AND PAINTED CITY SEAL AND CITY OF LAS VEGAS TEXT (SCRIPT LETTERS, 2 1/2" HIGH, ONE SIDE ONLY), STEEL LIDS INCLUDING CABLE AND BOLTS, Q-GL27 GALVANIZED 30 GAL LINER, WITH 2" DIA. DRAIN HOLE. BY QUICK CRETE PRODUCTS CORP. PHONE: (951) 737-6240. EPOXY TRASH RECEPTACLE TO SURFACE. CONTRACTOR TO PROVIDE PHOTO OR DRAWING OF SCRIPT ON TRASH RECEPTACLE PRIOR TO ORDERING SITE FURNISHINGS. | -          | -                |
|    | BENCH                                     | 27   | BENCH. MODEL #Q1-VIC-84B WITH CONCRETE CENTER ARM REST, TEXTURE: SMOOTH, COLOR: SAND, BY QUICK CRETE PRODUCTS CORP. PHONE: (951) 737-6240.                                                                                                                                                                                                                                                                                                                                                                        | -          | -                |
|    | PICNIC TABLE                              | 19   | ADA ACCESSIBLE PICNIC TABLE. MODEL #PT9636-AG, SMOOTH STAINED CONCRETE, GRAFFITI-RESISTANT SEALER FINISH. COLOR: SAND (TO MATCH BENCH). BY UNIVERSAL PRECAST, INC. PHONE: (877) 915-2500.                                                                                                                                                                                                                                                                                                                         | F          | L5.02            |
|    | BIKE RACK                                 | 2    | BIKE RACK. MODEL #625C-IG, POWDER COATED TAN. BY KAY PARK RECREATION CORP. PHONE: (800) 553-2476. IN-GROUND MOUNT AND INSTALL PER MANUFACTURER'S SPECIFICATIONS. SEE DETAIL FOR LAYOUT.                                                                                                                                                                                                                                                                                                                           | -          | -                |
|    | DRINKING FOUNTAIN                         | 7    | DRINKING FOUNTAIN. MODEL #440DB-ADAH10, STANDARD POWDER-COAT FINISH, BY MOST DEPENDABLE FOUNTAINS. PHONE: (800) 552-6331. COLOR: BROWN.                                                                                                                                                                                                                                                                                                                                                                           | N          | C6.02            |
|    | DOG WASTE BAG DISPENSER WITH SIGN         | 6    | DOG WASTE BAG DISPENSER WITH SIGN. DOGIPOT JUNIOR BAG DISPENSER, ARTICLE # 1002-2 WITH LOCKING ACCESS PANEL. PHONE (800) 364-7681. INSTALL PER MANUFACTURER'S SPECIFICATIONS. COLOR: FOREST GREEN.                                                                                                                                                                                                                                                                                                                | F, G       | L5.08            |
|  | FAMILY BARBECUE                           | 10   | FAMILY BARBECUE GRILL. MODEL #5B1635, STANDARD FINISH. BY KAY PARK RECREATION CORP. PHONE: (800) 553-2476. IN-GROUND MOUNT AND INSTALL PER STRUCTURAL DRAWINGS.                                                                                                                                                                                                                                                                                                                                                   | B          | L5.02            |
|  | ADAPTIVE TOT LOT WITH SHADE COVER (LARGE) | 1    | ADAPTIVE TOT LOT WITH SHADE COVER (LARGE)<br>FOR TOT LOT: A<br>FOR SHADE COVER: VARIOUS                                                                                                                                                                                                                                                                                                                                                                                                                           | A<br>F52.0 | L4.06            |
|  | SOFTBALL TOT LOT WITH SHADE COVER (SMALL) | 1    | SOFTBALL TOT LOT WITH SHADE COVER (SMALL)<br>FOR TOT LOT: B<br>FOR SHADE COVER: VARIOUS                                                                                                                                                                                                                                                                                                                                                                                                                           | B<br>F53.0 | L4.06            |
|  | 50' X 50' SHADE SHELTER                   | 1    | 50' X 50' SHADE SHELTER. SQR 50 MR, FRAME COLOR: SUREY BEIGE; MULTI-RIB ROOF COLOR: DELFT BLUE. INSTALL PER MANUFACTURER'S SPECIFICATIONS. MANUFACTURER: POLIGON. SUPPLIER: MIRACLE PLAYGROUND, PHONE: (800) 905-1411 OR APPROVED EQUAL. CONTRACTOR TO PROVIDE SHOP DRAWINGS FOR APPROVAL & FOR PERMIT IF APPROVED EQUAL IS USED.                                                                                                                                                                                 | ALL        | 551.0 THRU 554.2 |
|  | 36' X 36' SHADE SHELTER                   | 1    | 36' X 36' SHADE SHELTER. SQR 36 MR, FRAME COLOR: SUREY BEIGE; MULTI-RIB ROOF COLOR: DELFT BLUE. INSTALL PER MANUFACTURER'S SPECIFICATIONS. MANUFACTURER: POLIGON. SUPPLIER: MIRACLE PLAYGROUND, PHONE: (800) 905-1411 OR APPROVED EQUAL. CONTRACTOR TO PROVIDE SHOP DRAWINGS FOR APPROVAL & FOR PERMIT IF APPROVED EQUAL IS USED.                                                                                                                                                                                 | ALL        | 555.0 THRU 558.2 |
|  | 16' X 16' SHADE SHELTER                   | 6    | 16' X 16' SHADE SHELTER. SQR 16 MR, FRAME COLOR: SUREY BEIGE; MULTI-RIB ROOF COLOR: DELFT BLUE. INSTALL PER MANUFACTURER'S SPECIFICATIONS. MANUFACTURER: POLIGON. SUPPLIER: MIRACLE PLAYGROUND, PHONE: (800) 905-1411 OR APPROVED EQUAL. CONTRACTOR TO PROVIDE SHOP DRAWINGS FOR APPROVAL & FOR PERMIT IF APPROVED EQUAL IS USED.                                                                                                                                                                                 | ALL        | 559.0 THRU 562.2 |
|  | 15' X 15' MAINTENANCE BUILDING            | 1    | 15' X 15' STEEL MAINTENANCE SHED. MANUFACTURER: UNITED STEEL BUILDING (OR APPROVED EQUAL). COLOR: SAHARA TAN WITH ASH GRAY TRIM AND GALVALUME ROOF. 15' CEILING HEIGHT. PHONE: 888-446-6963. INSTALL PER MANUFACTURER'S SPECIFICATIONS AND RECOMMENDATIONS.                                                                                                                                                                                                                                                       | -          | -                |

NOTES:  
1) THE MANUFACTURER AND MODEL IDENTIFIED FOR THE SHADE SHELTERS HAVE BEEN CHOSEN AS THE DESIGN STANDARD FOR THE SHADE SHELTERS. OTHER MANUFACTURERS MUST MEET THE MINIMUM STANDARDS TO BE CONSIDERED AS AN APPROVED EQUAL PRODUCT.  
2) CONTRACTOR TO PROVIDE COLOR SAMPLES FOR ALL SITE FURNITURE AND EQUIPMENT FOR APPROVAL PRIOR TO CONSTRUCTION.  
3) ALL FURNITURE LOCATIONS AND ORIENTATIONS TO BE APPROVED BY OWNER PRIOR TO INSTALLATION.

RECORD DRAWINGS  
NOT FOR CONSTRUCTION

1. TO ALTER THESE DOCUMENTS FOR ANOTHER PROJECT BY ANYONE OTHER THAN THE ORIGINAL ARCHITECT IS A VIOLATION OF NRS 623.

2. THIS RECORD DRAWING HAS BEEN PREPARED IN PART, BASED UPON INFORMATION FURNISHED BY THE GENERAL CONTRACTOR. WHILE THIS INFORMATION IS BELIEVED TO BE RELIABLE, THE DESIGN PROFESSIONAL CANNOT ASSURE ITS ACCURACY, AND THIS IS NOT RESPONSIBLE FOR THE ACCURACY OF THIS RECORD DRAWING OR FOR ANY ERRORS OR OMISSIONS WHICH MAY HAVE BEEN INCORPORATED INTO IT AS A RESULT. THE DESIGN PROFESSIONAL CANNOT AND DOES NOT WARRANT THEIR ACCURACY.

3. INFORMATION THAT MAY BE INCLUDED WOULD BE SIGNIFICANT CHANGES TO PLANTING OR IRRIGATION LAYOUT PLANS AND ASSOCIATED DRAWINGS, MINOR DIMENSION OR CONSTRUCTION DETAIL CHANGES MAY NOT BE INCLUDED.

REVISIONS

RECORD DRAWING 7-10-08

CONSULTANT




702.597.3108  
12 Commerce Center Drive  
Henderson, NV 89014  
www.southwickla.com

A NOT USED


NOT TO SCALE

NOTES:  
1) PROVIDE CONTROL JOINTS @ 10' O.C. & EXPANSION JOINTS @ 30' O.C.  
2) KEEP TOP OF SOD FLUSH WITH CURB.  
3) CONTRACTOR TO MEANDER MOWCURB PER PLAN. ALL CURVES AND TRANSITIONS ARE TO BE SMOOTH AND NATURAL.

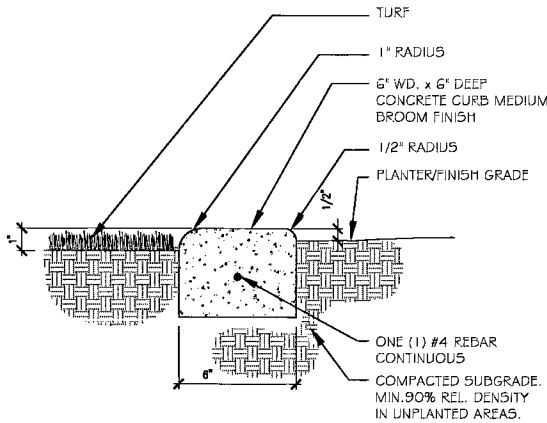

C CONCRETE MOW CURB

NOT TO SCALE

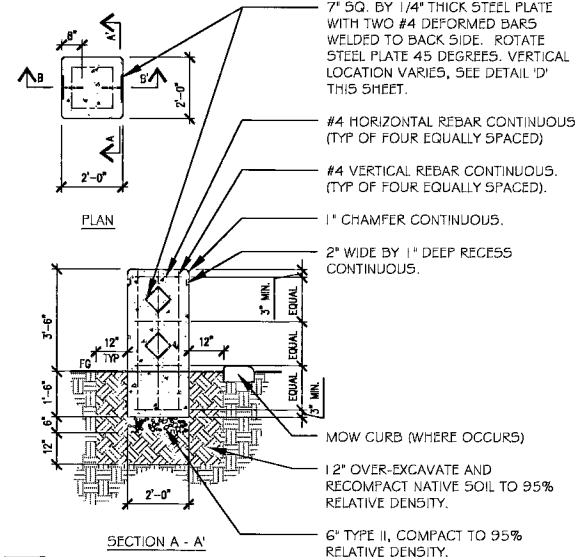


E SPLIT RAIL FENCE-"COLUMN"

NOT TO SCALE

B NOT USED


NOT TO SCALE

NOTE:  
TUBULAR STEEL: 4" SQUARE TUBULAR STEEL, CONTINUOUS BETWEEN COLUMNS, CLEAN FREE OF RUST, GREASE, AND DIRT, APPLY ONE COAT PRIMER AND TWO COATS PAINT. SEE SPECIFICATIONS. COLOR: HUNTER GREEN. WELD ALL POINTS OF CONNECTION CONTINUOUS.

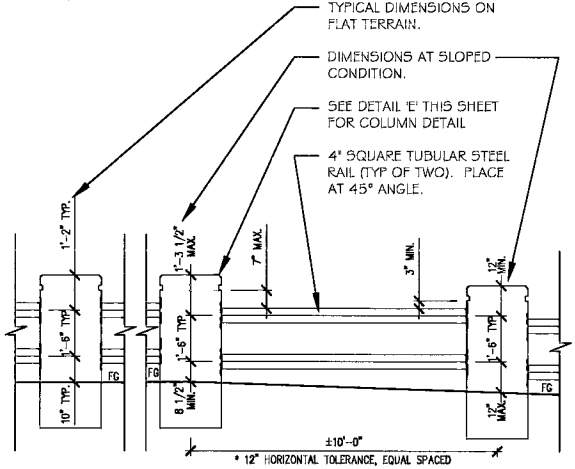

D SPLIT RAIL FENCE-"RAIL"

NOT TO SCALE

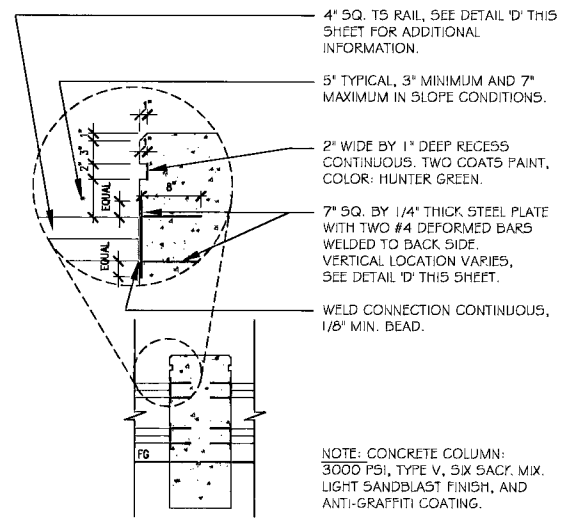

Lorenzi Park Renovations  
Phase 1  
SITE DETAILS

OWNER: CITY OF LAS VEGAS  
DEPARTMENT OF PUBLIC WORKS  
ARCHITECTURAL SERVICES

400 EAST STEWART AVENUE  
LAS VEGAS, NEVADA 89103  
PHONE: (702) 229-6535  
FAX: (702) 384-4848  
TDD: (702) 386-9108

DRAWN: SAR  
FILE: 06-083  
DATE: JUNE 2007  
SCALE: AS SHOWN  
REV NO: 0715314.01  
CLV DWG NO: 65018-41

L5.01