

**RECORD DRAWINGS
NOT FOR CONSTRUCTION**


1. TO ALTER THESE DOCUMENTS FOR ANOTHER PROJECT BY ANYONE OTHER THAN THE ORIGINAL ARCHITECT IS A VIOLATION OF NRS 623.
2. THIS RECORD DRAWING HAS BEEN PREPARED IN PART, BASED UPON INFORMATION FURNISHED BY THE GENERAL CONTRACTOR, WHILE THIS INFORMATION IS BELIEVED TO BE RELIABLE, THE DESIGN PROFESSIONAL CANNOT ASSURE ITS ACCURACY, AND THIS IS NOT RESPONSIBLE FOR THE ACCURACY OF THIS RECORD DRAWING OR FOR ANY ERRORS OR OMISSIONS WHICH MAY HAVE BEEN INCORPORATED INTO IT AS A RESULT. THE DESIGN PROFESSIONAL CANNOT AND DOES NOT WARRANT THEIR ACCURACY.
3. INFORMATION THAT MAY BE INCLUDED WOULD BE SIGNIFICANT CHANGES TO PLANTING OR IRRIGATION LAYOUT PLANS AND ASSOCIATED DRAWINGS. MINOR DIMENSION OR CONSTRUCTION DETAIL CHANGES MAY NOT BE INCLUDED.

southwick
LA

702.597.3108
12 Commerce Center Drive
Henderson, NV 89014
www.southwickla.com


A NOT USED

NOT TO SCALE

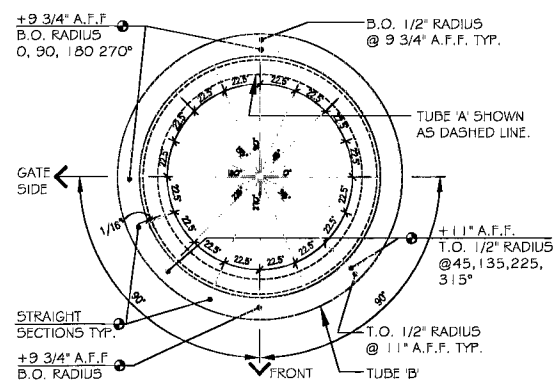


D TUBE 'B' PLAN (CLOSED POSITION)

NOT TO SCALE

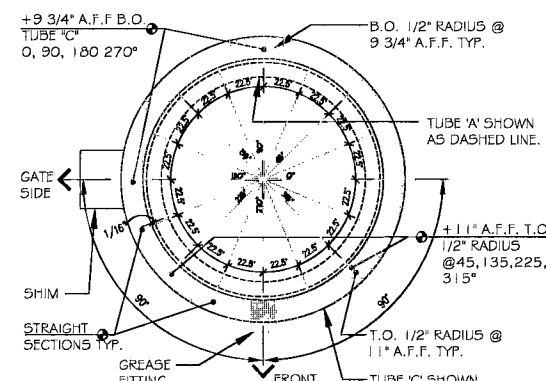

E TUBE 'C' PLAN VIEW


NOT TO SCALE

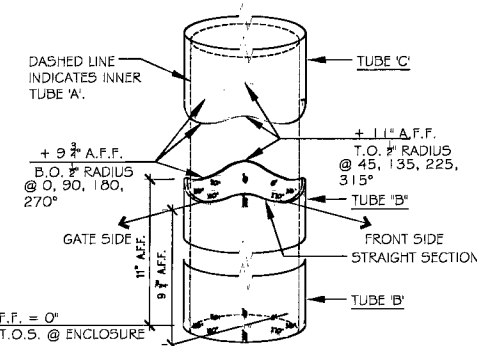

NOTE: CONTRACTOR TO GREASE JAMB ASSEMBLY PRIOR TO COMPLETION OF GATE.

F TUBE 'B' (AXONOMETRIC)

NOT TO SCALE

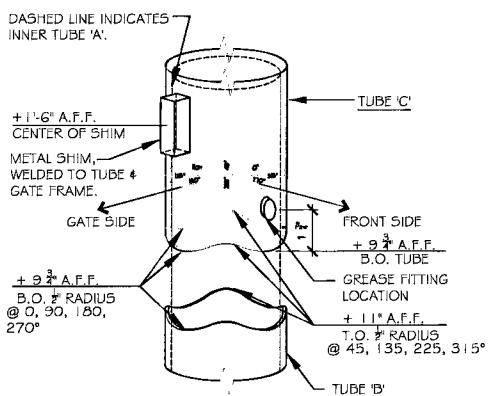


NOTE: CONTRACTOR TO GREASE JAMB ASSEMBLY PRIOR TO COMPLETION OF GATE.

G TUBE 'C' (AXONOMETRIC)

NOT TO SCALE

B NOT USED

NOT TO SCALE

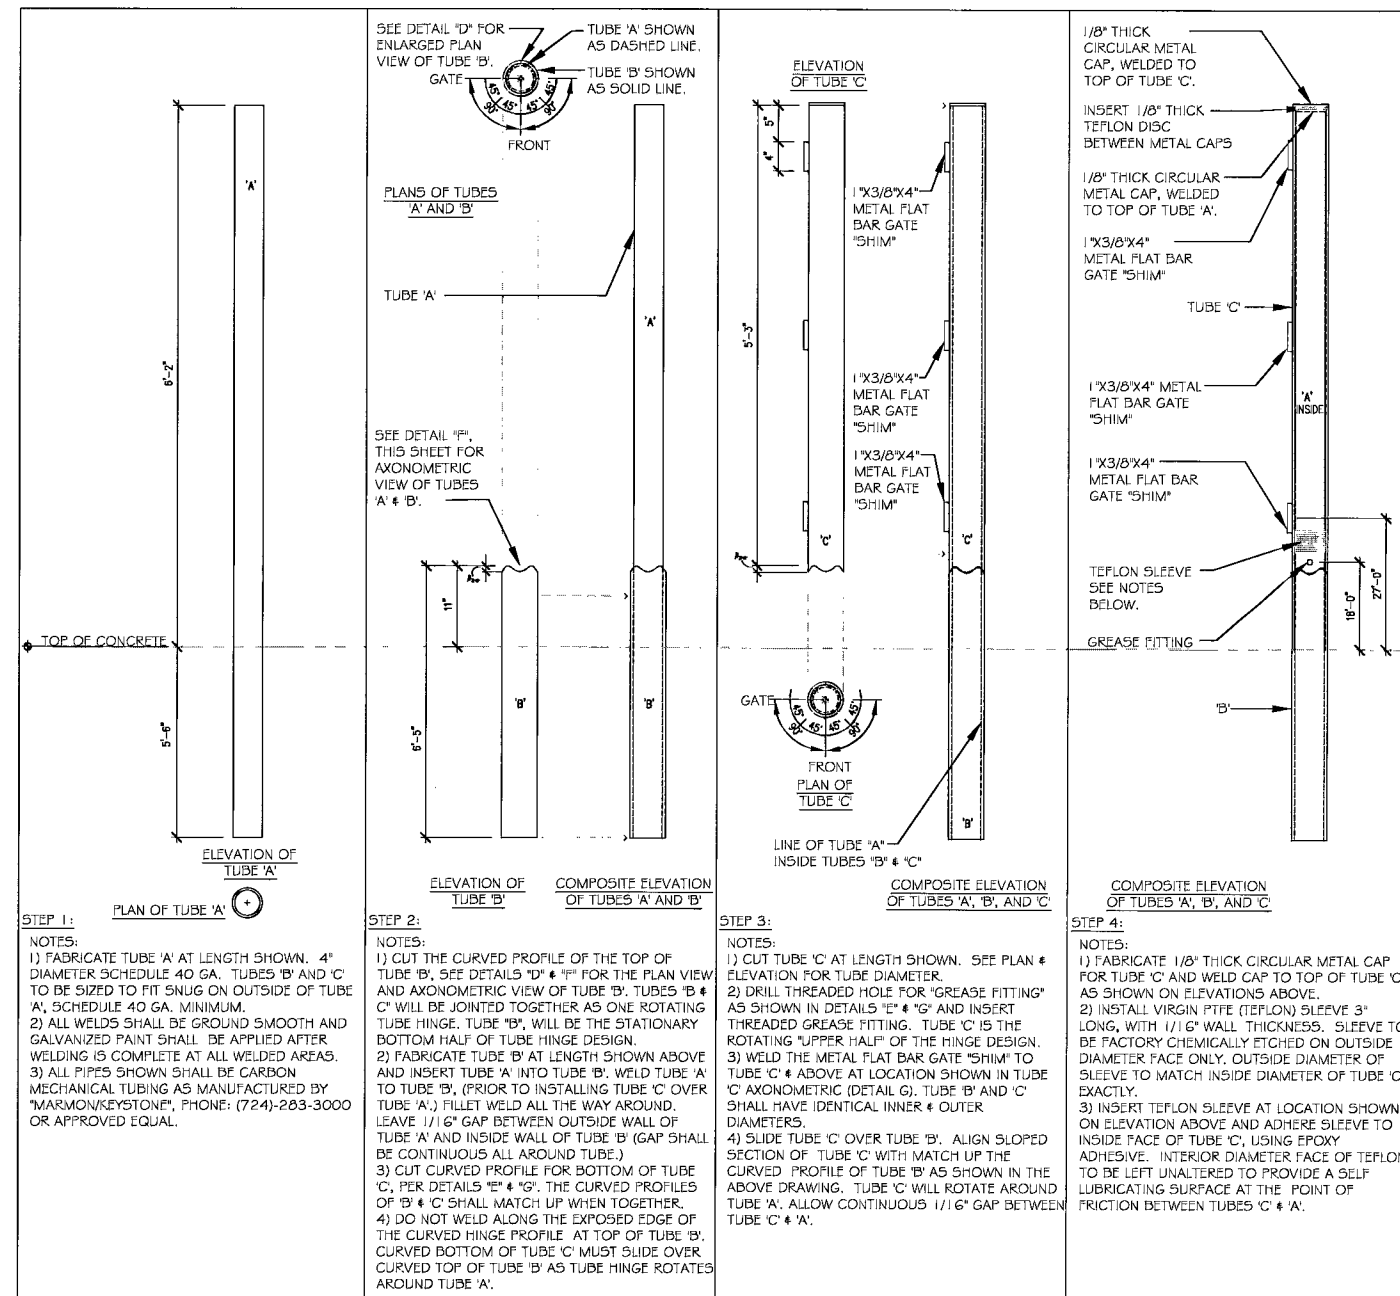

H "GATE HINGE" COMPLETE ASSEMBLY

NOT TO SCALE

Lorenzi Park Renovations
Phase I
SITE DETAILS

OWNER: CITY OF LAS VEGAS
DEPARTMENT OF PUBLIC WORKS
ARCHITECTURAL SERVICES

400 EAST STEWART AVENUE
LAS VEGAS, NEVADA 89101
PHONE: (702) 229-5535
FAX: (702) 384-4646
TDD: (702) 386-9108

DRAWN: SAR

TITLE: 06-083

DATE: JUNE 2007

SCALE: AS SHOWN

REV NO: 07.03.01

REV DESCRIPTION: 35018-41

REV NO: 35018-41

REV NO: 35018-41

L5.03