


RECORD DRAWINGS NOT FOR CONSTRUCTION

1. TO ALTER THESE DOCUMENTS FOR ANOTHER PROJECT BY ANYONE OTHER THAN THE ORIGINAL ARCHITECT IS A VIOLATION OF NRS 623.
2. THIS RECORD DRAWING HAS BEEN PREPARED IN PART, BASED UPON INFORMATION FURNISHED BY THE GENERAL CONTRACTOR, WHILE THIS INFORMATION IS BELIEVED TO BE RELIABLE, THE DESIGN PROFESSIONAL CANNOT ASSURE ITS ACCURACY, AND THIS IS NOT RESPONSIBLE FOR THE ACCURACY OF THIS RECORD DRAWING OR FOR ANY ERRORS OR OMISSIONS WHICH MAY HAVE BEEN INCORPORATED INTO IT AS A RESULT. THE DESIGN PROFESSIONAL CANNOT AND DOES NOT WARRANT THEIR ACCURACY.
3. INFORMATION THAT MAY BE INCLUDED WOULD BE SIGNIFICANT CHANGES TO PLANTING OR IRRIGATION LAYOUT PLANS AND ASSOCIATED DRAWINGS, MINOR DIMENSION OR CONSTRUCTION DETAIL CHANGES MAY NOT BE INCLUDED.

NOTES:
1. REFER TO MANUFACTURER'S SPECIFICATIONS PRIOR TO INSTALLATION.
2. SEE SHEET C6.04 DETAIL #5 FOR POST TENSION SLAB INFORMATION.


NET POST:
MANUFACTURER: DOUGLAS
MODEL #: DTP-37-BLACK

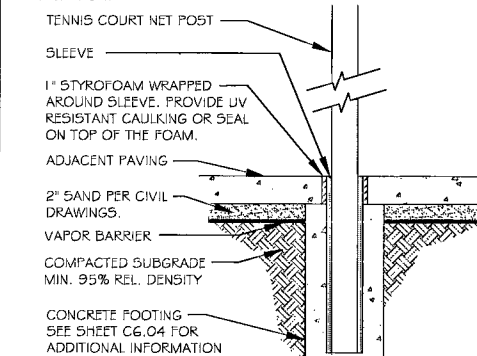

SECTION

B TENNIS COURT NET POST


NOT TO SCALE

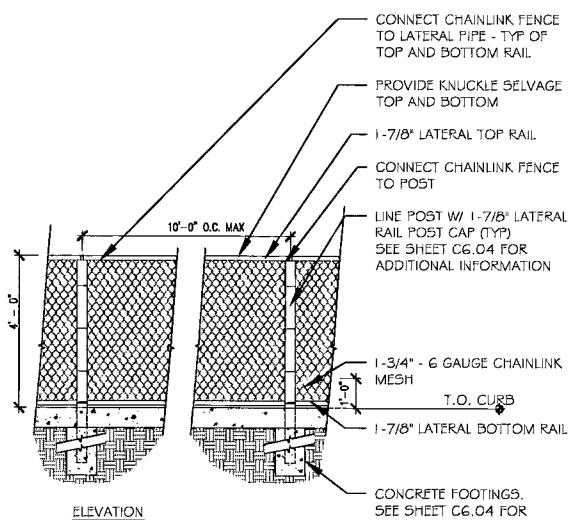

ELEVATION

D TENNIS COURT FENCE - 4'


NOT TO SCALE

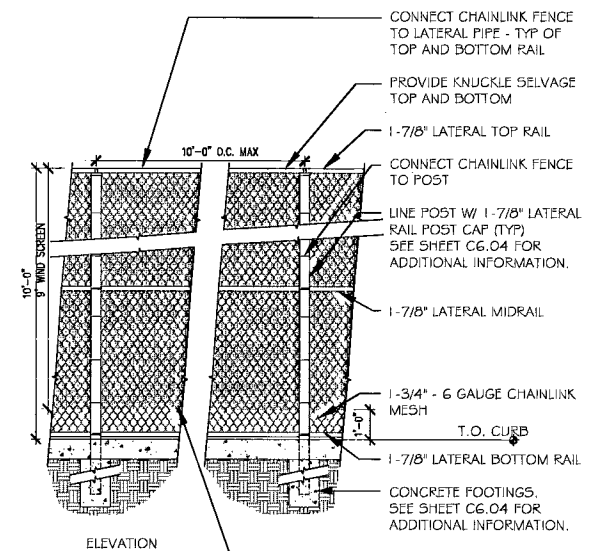

ELEVATION

C TENNIS COURT FENCE - 10'

NOT TO SCALE

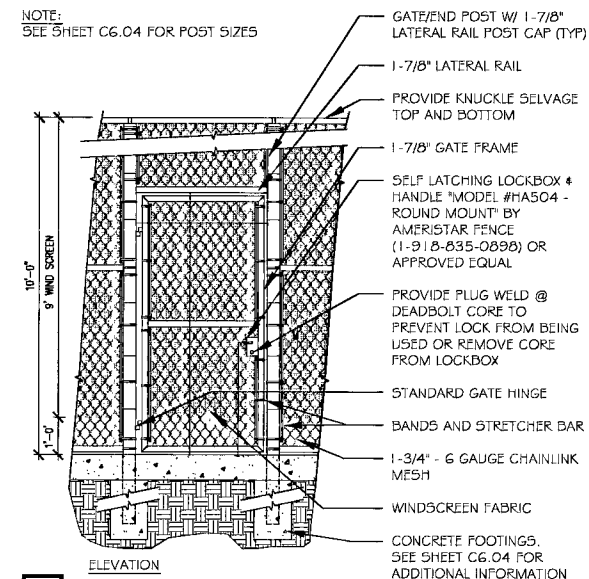


ELEVATION

E TENNIS COURT FENCE GATE


NOT TO SCALE

NOTE:
SEE DETAILS 'A' AND 'E' SHEET L5.06 FOR 6' FENCE IN TENNIS COURT AREA

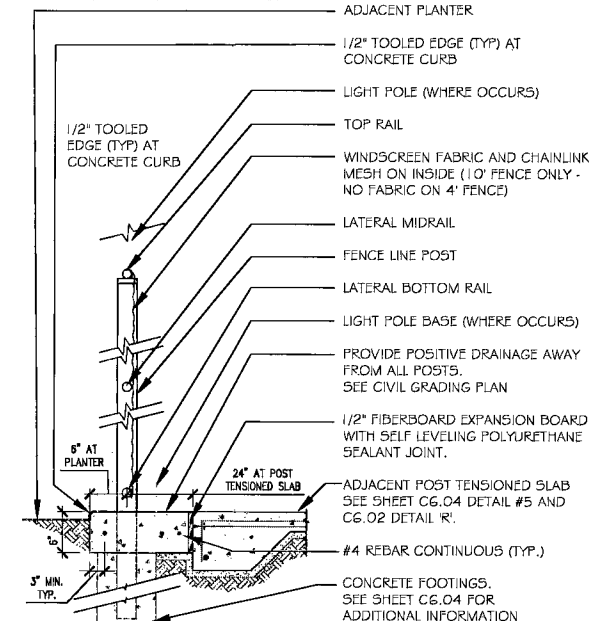

J TENNIS COURT FENCE SECTION



NOT TO SCALE

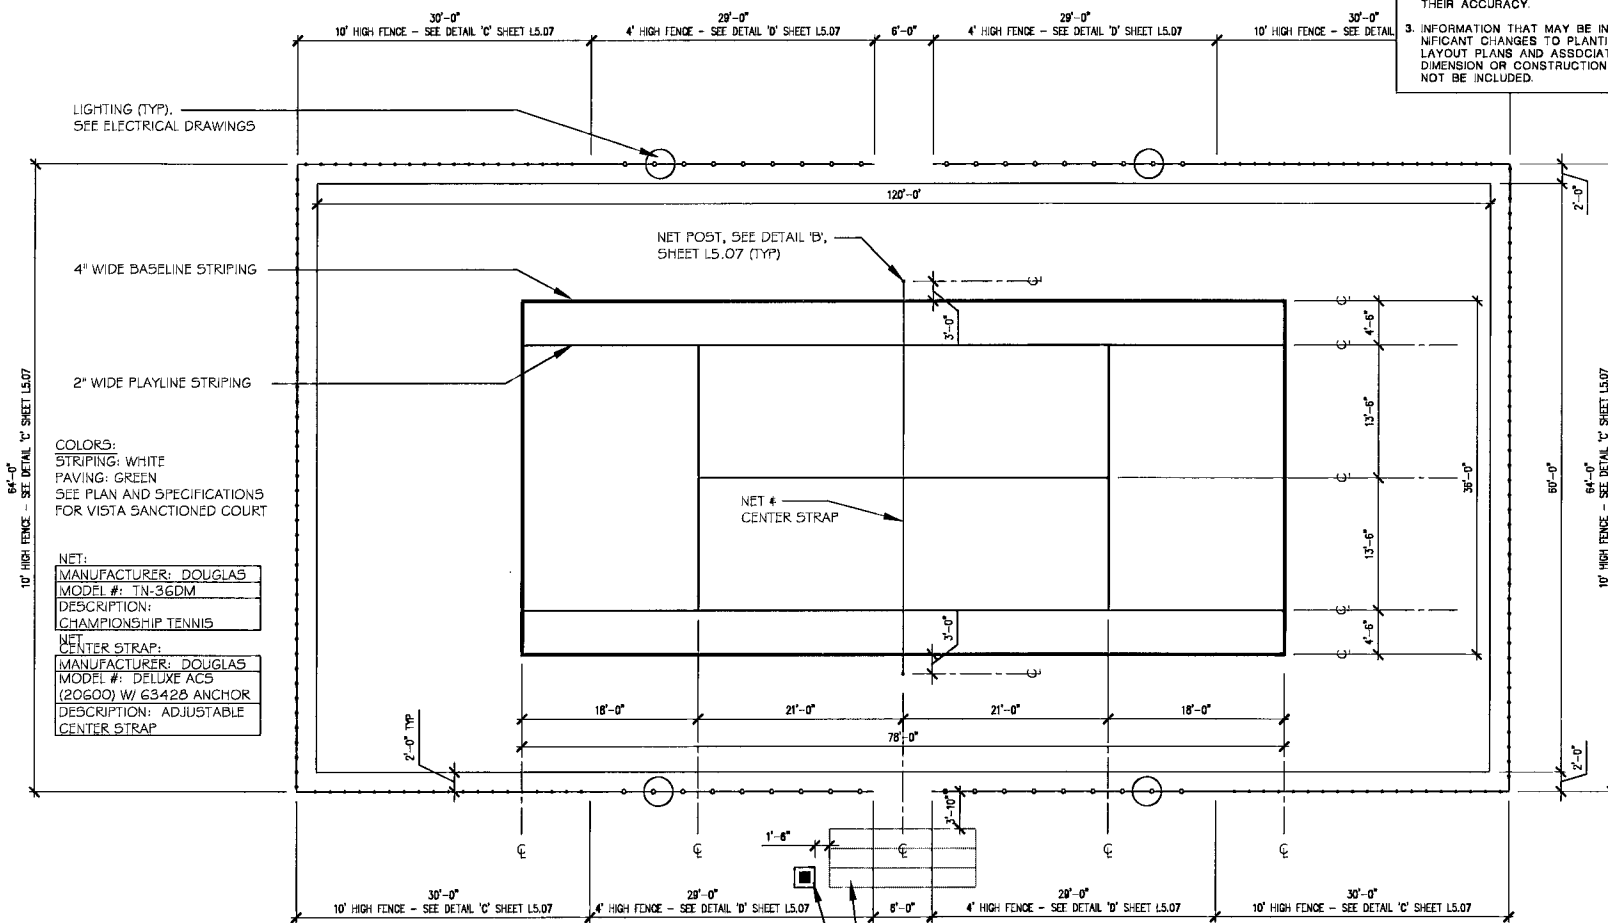

A TENNIS COURT LAYOUT


NOT TO SCALE

NOTE:
15' 3 ROW BLEACHER FRAME, MODEL #9900-1, AS MANUFACTURED BY MIRACLE RECREATION EQUIPMENT COMPANY, 2657 WINDMILL PARKWAY, #195 HENDERSON, NV 89074. PHONE: (800) 905-1411

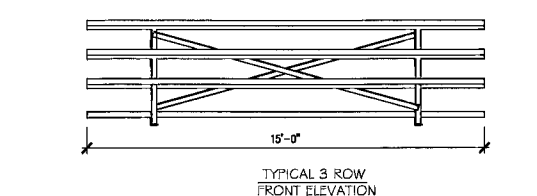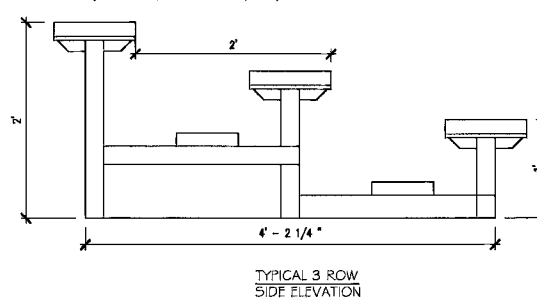


F BLEACHERS - 3 BENCHES

NOT TO SCALE

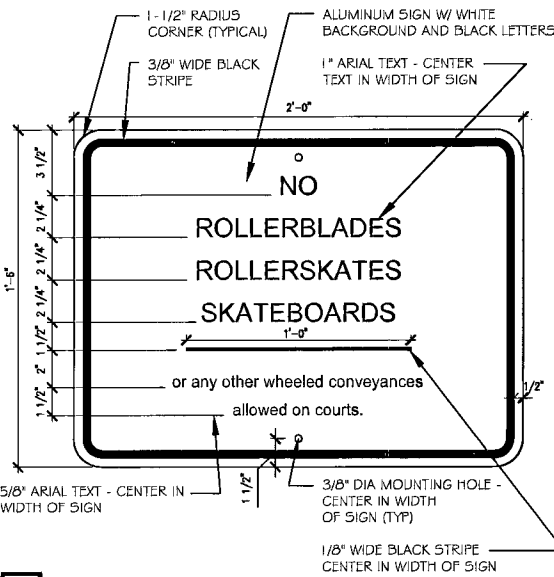


G TENNIS COURT SIGN

NOT TO SCALE

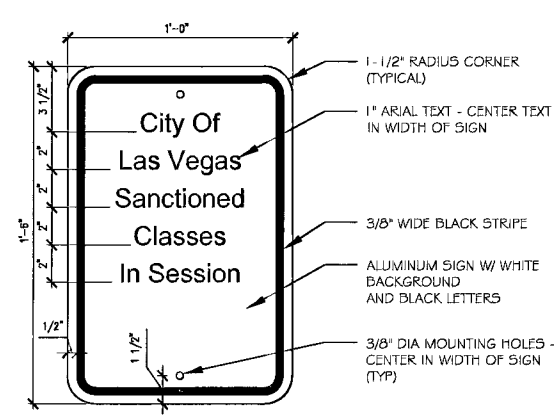

H TENNIS CLASS SIGN

NOT TO SCALE

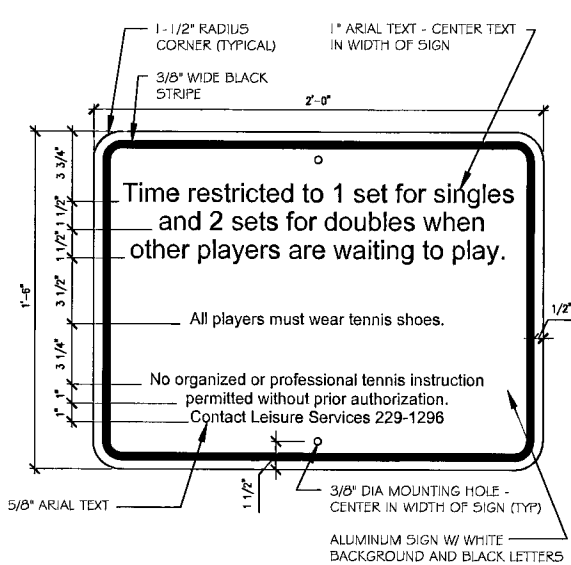

I TENNIS RULES SIGN

NOT TO SCALE