


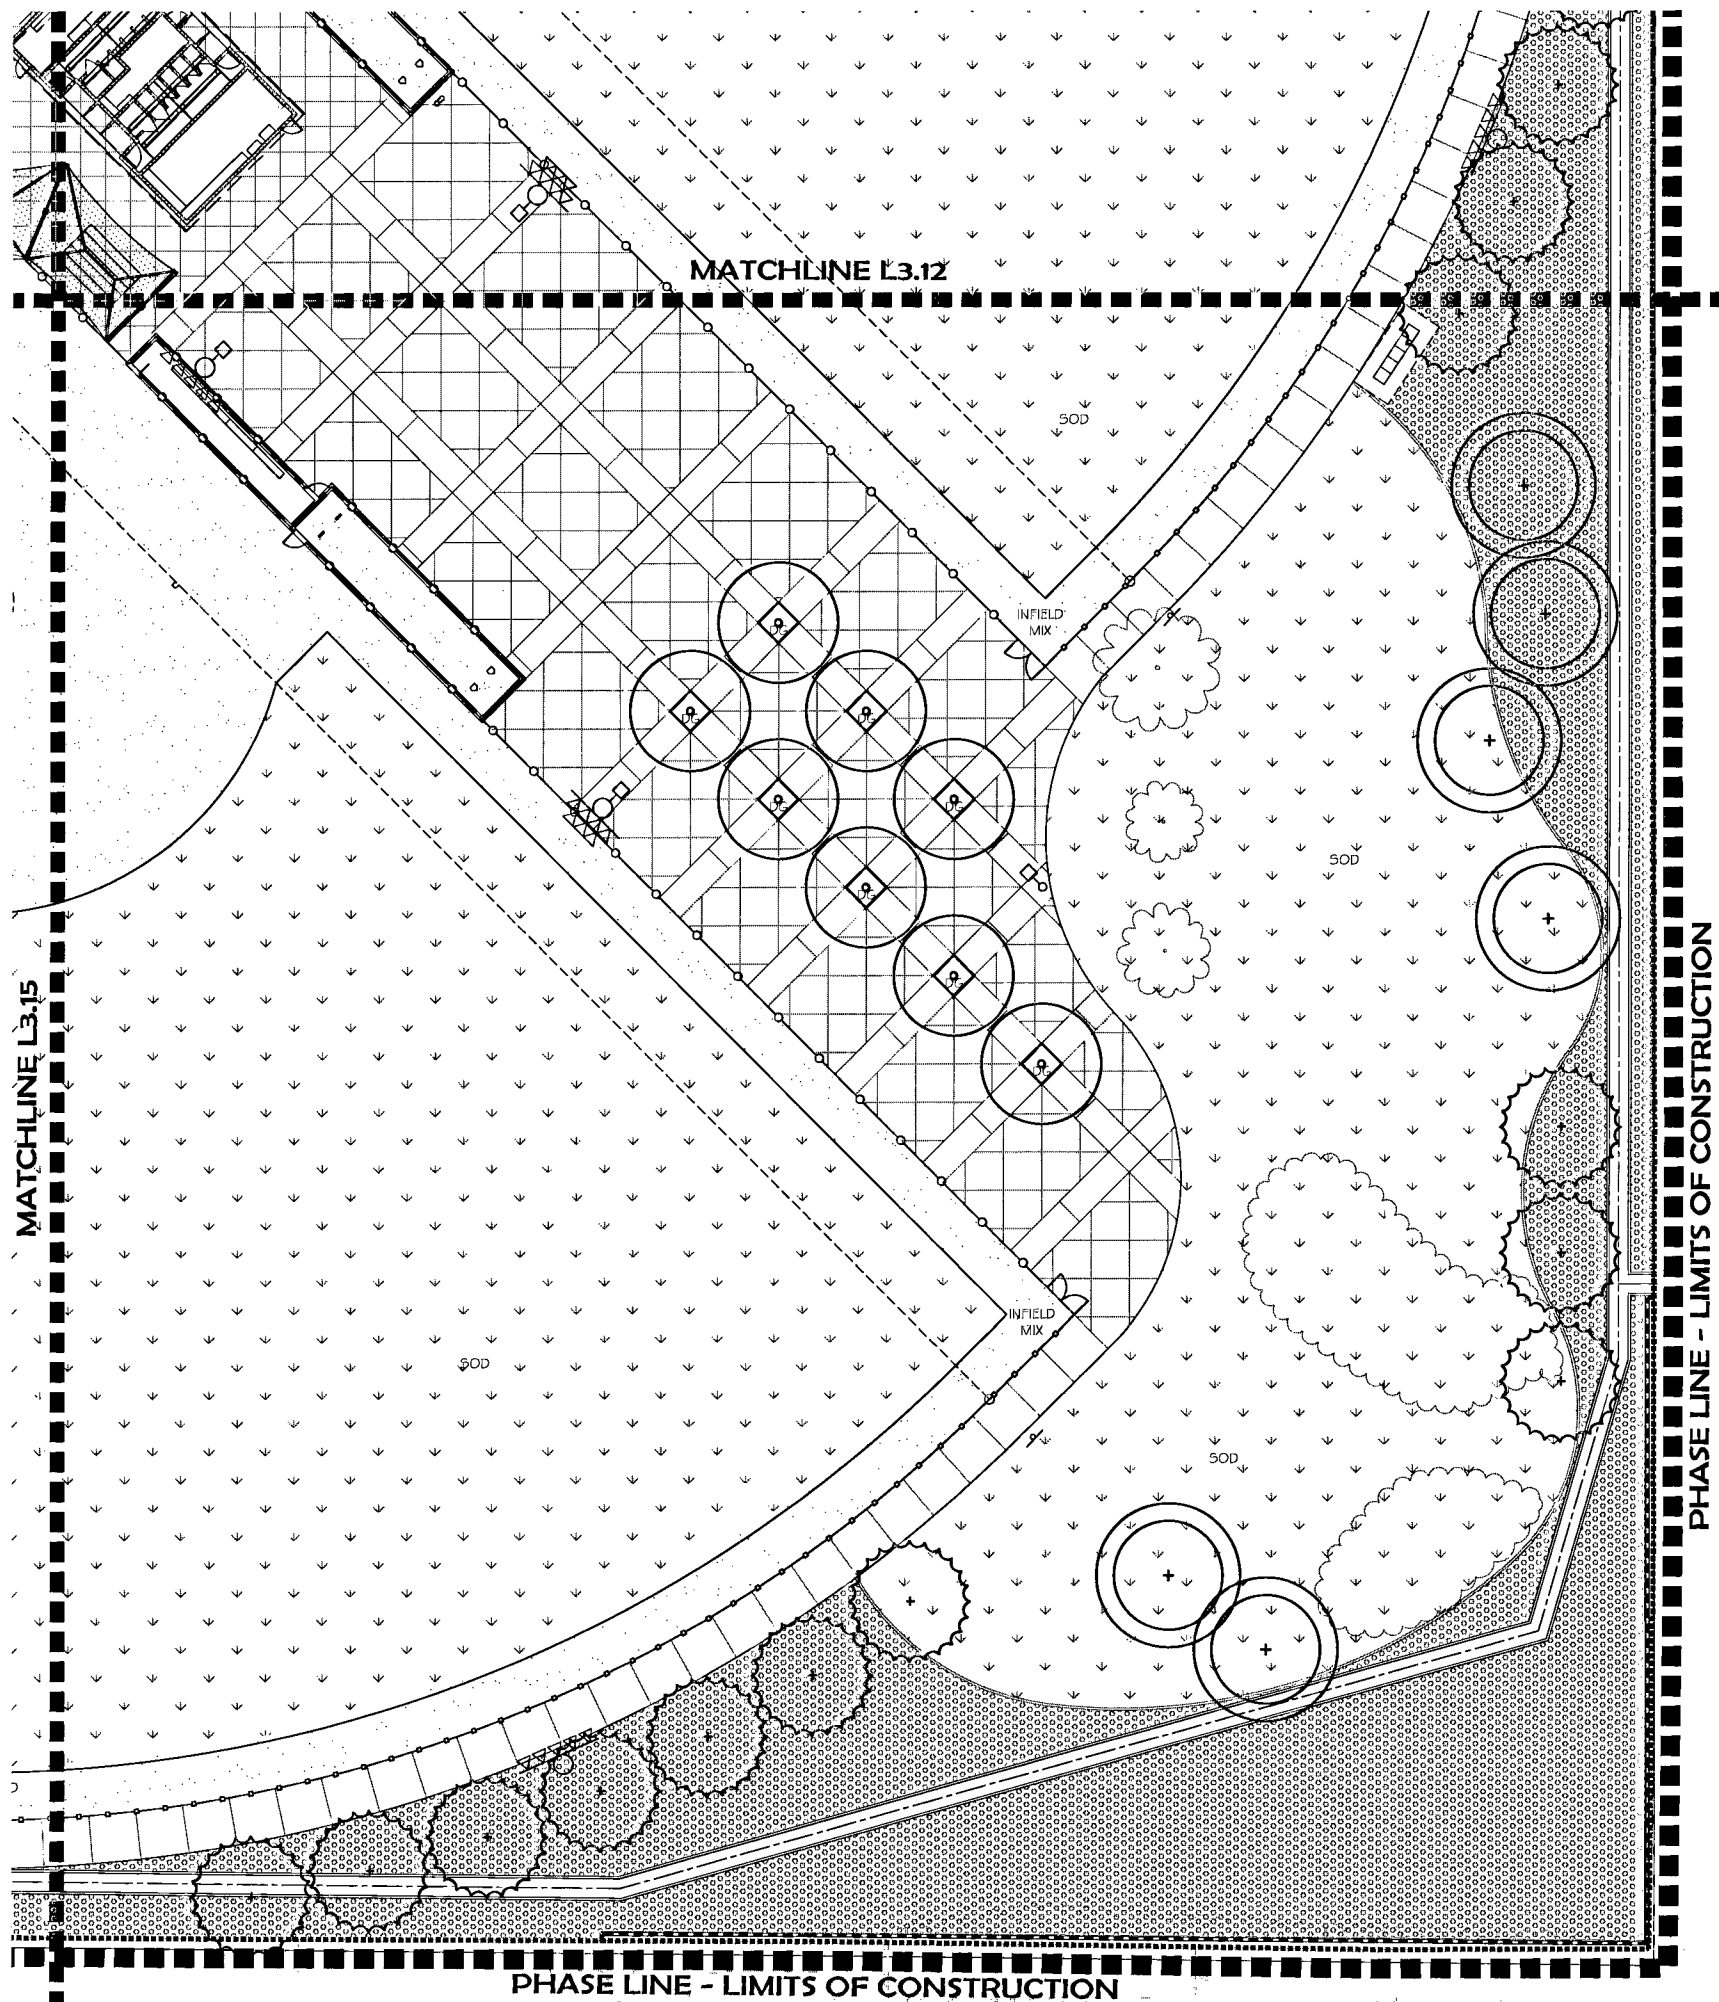

TREE LEGEND

SYMBOL	BOTANICAL/COMMON NAME
	CHITALPA TASHKENTENSIS 'PINK DAWN' - STD PINK DAWN CHITALPA
	FRAXINUS OXYCARPA 'RAYWOOD' RAYWOOD ASH
	FRAXINUS VELUTINA 'RIO GRANDE' TANTEX ASH
	OLIA EUROPAEA 'SWAN HILL' - MULTI SWAN HILL OLIVE (NO SUBSTITUTION ALLOWED)
	PINUS ELDARICA MONDELL PINE
	PISTACIA CHINENSIS CHINESE PISTACHE
	ROBINIA AMBIGUA 'PURPLE ROBE' PURPLE ROBE LOCUST
	VITEX AGNUS-CASTUS - MULTI CHASTE TREE
	EXISTING TREES PROTECT IN PLACE

SHRUB LEGEND

SYMBOL	BOTANICAL/COMMON NAME
	CAESALPINIA GILLIESII YELLOW BIRD OF PARADISE
	COTONEASTER LACTEUS RED CLUSTERBERRY
	DODONAEA VISCOSA 'PURPUREA' PURPLE HOPSEED BUSH
	LEUCOPHYLLUM LANGMANIAE 'RIO BRAVO' RIO BRAVO SAGE
	LEUCOPHYLLUM ZYGOPHYLLUM 'CIMARRON' CIMARRON SAGE
	LIGUSTRUM JAPONICA JAPANESE PRIVET
	MYRTUS COMMUNIS 'COMPACTA' DWARF GREEK MYRTLE
	SALVIA CLEVELANDII CHAPARRAL SAGE

GROUND COVERS/ACCENT LEGEND



SYMBOL	BOTANICAL/COMMON NAME
	ACACIA REDOLENS 'DESERT CARPET' CREEPING ACACIA
	CHRYSACTINIA MEXICANA DAMIANITA DAISY
	CONVOLVULUS GNEORUM BUSH MORNING GLORY
	DASYLIRION QUADRANGULATUM TOOTHLESS STOOL
	TEUCRIUM CHAMAEDRY'S 'PROSTRATUM' PROSTRATE GERMANDER
	HESPERALOE PARVIFLORA RED HESPERALOE
	MUHLENBERGIA CAPILLARIS 'REGAL MIST' REGAL MIST DEAR GRASS
	VERBENA RIGIDA COARSE VERBENA
	CYNODON SPECIES 'TIFFWAY II' TIFFWAY II HYBRID BERMUDA
	RIP-RAP PER CIVIL DRAWINGS. COLOR TO MATCH DECOMPOSED GRANITE. CONTRACTOR TO PROVIDE SAMPLE FOR APPROVAL.
	1 MM MINUS DECOMPOSED GRANITE. COLOR: DIAMOND INFIELD MIX AVAILABLE THROUGH MINERAL PARK DECORATIVE ROCK. (702) 275-1371. SEE DETAIL 'B', SHEET L5.05.

PLANTING NOTES

- 1) DECOMPOSED GRANITE (DG) - INSTALL A 2" LAYER OF 1/2" MINUS DECOMPOSED GRANITE CONTINUOUS IN ALL PLANTERS UNDER ALL TREES AND SHRUBS. COLOR: 'SEDONA CORAL' AVAILABLE THROUGH MINERAL PARK DECORATIVE ROCK. (702) 275-1371. BEFORE PLACING GRANITE, COMPACT SUB-GRADE TO 85% AND APPLY A PRE-EMERGENT HERBICIDE TO SOIL. AFTER PLACING GRANITE: RAKE SMOOTH, WET TO ENTIRE DEPTH, ALLOW TO DRY, THEN LIGHTLY SCARIFY SURFACE WITH A LEAF RAKE. APPLY A SECONDARY APPLICATION OF PRE-EMERGENT HERBICIDE TO TOP OF GRANITE. KEEP TOP OF GRANITE 1" BELOW ADJACENT WALKS AND CURBS. DO NOT ALLOW GRANITE TO TOUCH THE TRUNK OF ANY PLANT. INSTALL AFTER INSTALLATION OF PLANT MATERIAL. SEE DETAIL 'H' ON SHEET L6.01.
- 2) SEE SHEET L6.01 FOR PLANT SIZES, QUANTITIES AND DETAILS.
- 3) ALL MULTI-TRUNK TREES ARE TO HAVE 3 TO 4 TRUNKS. THE LOWEST HORIZONTAL BRANCHING PATTERN FROM ANY TRUNK ON ONE TREE SHALL BE A MINIMUM OF 30" FROM FINISH GRADE.
- 4) CONTRACTOR TO PROTECT AND PRESERVE EXISTING LANDSCAPE UNLESS MARKED FOR REMOVAL. CONTRACTOR TO KEEP PLANT MATERIALS THRIVING AND HEALTHY. ANY PLANT MATERIAL DAMAGED DURING OR AS A RESULT OF CONSTRUCTION IS TO BE REPLACED AT THE CONTRACTOR'S EXPENSE. PLANTS ARE TO BE REPLACED WITH TREES AND/OR SHRUBS OF THE SAME SIZE, FORM, GENUS, SPECIES, AND VARIETY. CONTRACTOR TO PROVIDE ADDITIONAL DECOMPOSED GRANITE IN EXISTING LANDSCAPE AREAS THAT ARE DISTURBED AS NECESSARY.
- 5) SHRUB PLACEMENT FOR ALL NEW PLANTINGS TO AVOID ALL EXISTING TREE ROOTS OF 2" CALIBER OR GREATER.

RECORD DRAWINGS NOT FOR CONSTRUCTION

1. TO ALTER THESE DOCUMENTS FOR ANOTHER PROJECT BY ANYONE OTHER THAN THE ORIGINAL ARCHITECT IS A VIOLATION OF NRS 623.
2. THIS RECORD DRAWING HAS BEEN PREPARED IN PART, BASED UPON INFORMATION FURNISHED BY THE GENERAL CONTRACTOR, WHILE THIS INFORMATION IS BELIEVED TO BE RELIABLE, THE DESIGN PROFESSIONAL CANNOT ASSURE ITS ACCURACY, AND THIS IS NOT RESPONSIBLE FOR THE ACCURACY OF THIS RECORD DRAWING OR FOR ANY ERRORS OR OMISSIONS WHICH MAY HAVE BEEN INCORPORATED INTO IT AS A RESULT. THE DESIGN PROFESSIONAL CANNOT AND DOES NOT WARRANT THEIR ACCURACY.
3. INFORMATION THAT MAY BE INCLUDED WOULD BE SIGNIFICANT CHANGES TO PLANTING OR IRRIGATION LAYOUT PLANS AND ASSOCIATED DRAWINGS, MINOR DIMENSION OR CONSTRUCTION DETAIL CHANGES MAY NOT BE INCLUDED.

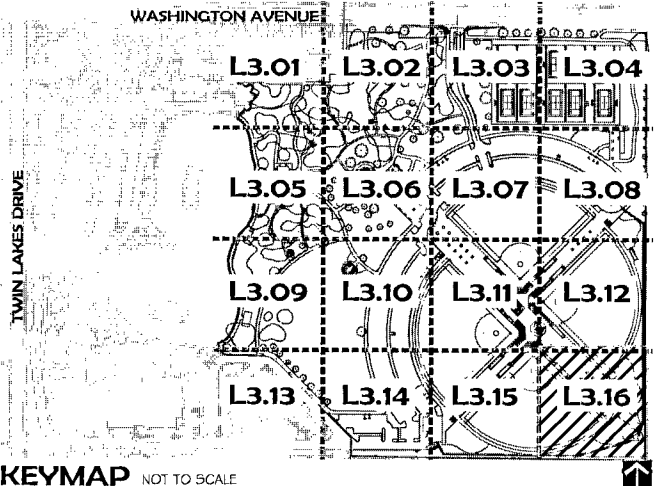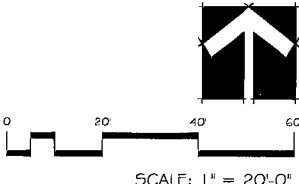

REVISIONS

RECORD DRAWING 7-10-01

CONSULTANT

southwick LA

702.597.3108
12 Commerce Center Drive
Henderson, NV 89014
www.southwickla.com

Lorenzi Park Renovations
Phase 1
Planting Plan

OWNER: CITY OF LAS VEGAS
DEPARTMENT OF PUBLIC WORKS
ARCHITECTURAL SERVICES

400 EAST STEWART AVENUE
LAS VEGAS, NEVADA 89101
PHONE: (702) 229-8501
FAX: (702) 384-4846
TDD: (702) 386-5106

DRAWN: SAR

FILE: 06-083

DATE: JUNE 2001

SCALE: AS SHOWN

BID NO: 071534.01

CLV DRG NO: 65018-41

SHEET NO: L3.16