



NOTE:
MEASURE PLANTS IN ACCORDANCE WITH THE LATEST EDITION
OF THE AMERICAN STANDARD FOR NURSERY STOCK.

MEASUREMENTS ARE TO REPRESENT AVERAGE SIZE OF A
PLANT AND SHALL NOT INCLUDE UNUSUALLY LONG BRANCHES.

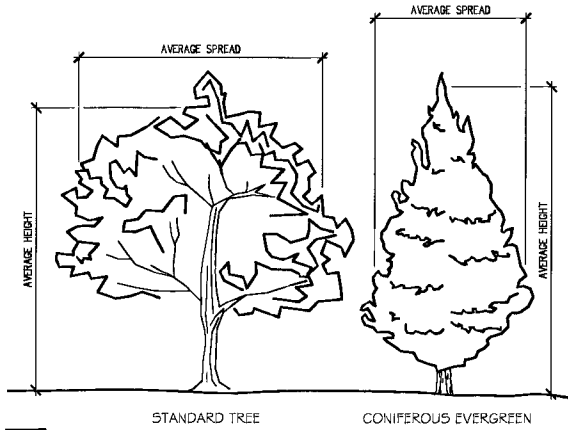

A PLANT MEASUREMENT DETAIL
NOT TO SCALE

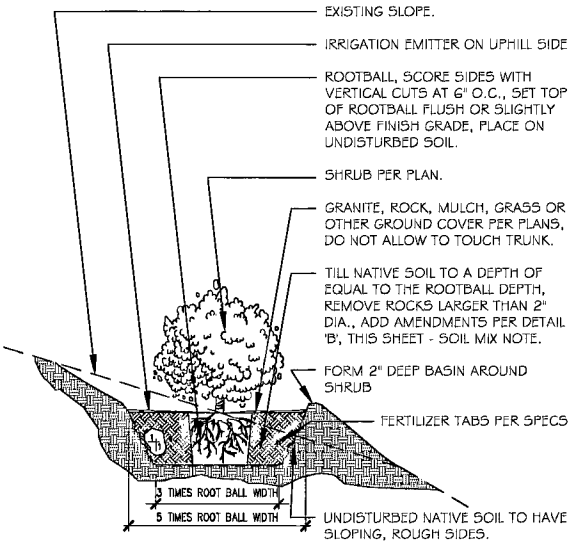

F SLOPE PLANTING DETAIL
NOT TO SCALE

TO ALL LAWN AREAS AND PRIOR TO IRRIGATION SYSTEM INSTALLATION, CROSS RIP
OR OTHERWISE TILL SUBGRADE TO A DEPTH OF 6\"/>

- 4 CU. YDS. NUTRI-MULCH ORGANIC SOIL CONDITIONER
15 LBS. 16-20-0 COMMERCIAL FERTILIZER WITH SOIL SULFUR
100 LBS. "GRO-POWER PLUS" CONDITIONING FERTILIZER
25 LBS. SOIL SULFUR


BACKFILL MIX FOR ALL TREES, SHRUBS, VINES AND OTHER CONTAINER PLANT
MATERIAL OTHER THAN BARE ROOT PALM TREES TO BE THOROUGHLY MIXED IN THE
TILLED NATIVE SOIL AREA OF THE PLANTING HOLE AND CONSIST OF THE FOLLOWING:

- 8 PARTS BY VOLUME ON SITE SOIL (NO PARTICLE OVER 1 1/2\"/>


AFTER PLANT INSTALLATION, EVENLY BROADCAST THE FOLLOWING AMENDMENTS
OVER THE TILLED NATIVE SOIL AREA AROUND THE ROOTBALL OF THE PLANT AND
WORK INTO THE TOP 2\"/>

- 1 LBS. 15-15-15 FERTILIZER PER 25 SQ. FT. OF TILLED SURFACE AREA
2 LBS. IRON SULFATE PER 25 SQ. FT. OF TILLED SURFACE AREA
15 LBS. "GROW POWER PLUS" FERTILIZER PER 25 SQ. FT. OF TILLED SURFACE AREA
10 LBS. SOIL SULFUR PER 25 SQ. FT. OF TILLED SURFACE AREA


B SOIL MIX NOTE
NOT TO SCALE

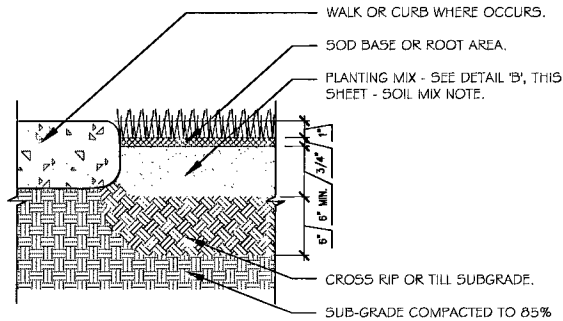


G SOD PLANTING DETAIL
NOT TO SCALE

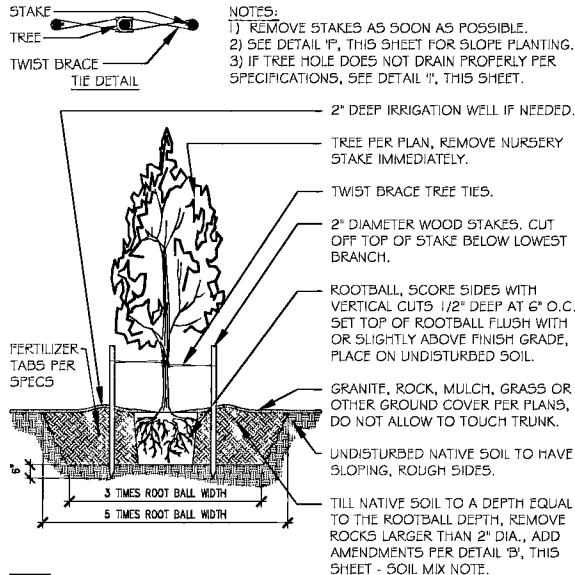


C TREE PLANTING DETAIL
NOT TO SCALE

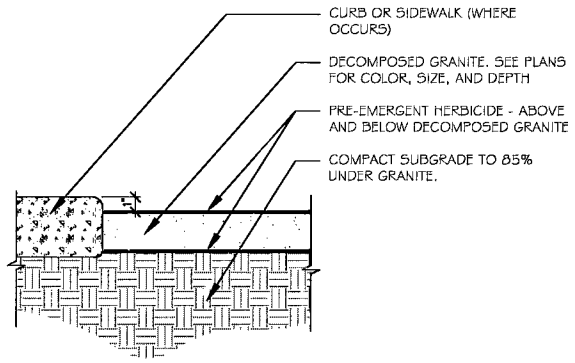


H DECOMPOSED GRANITE DETAIL
NOT TO SCALE

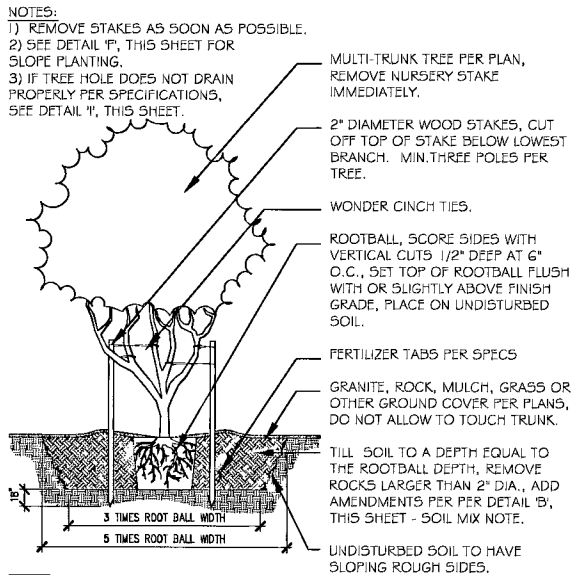

D MULTI-TRUNK PLANTING DETAIL
NOT TO SCALE

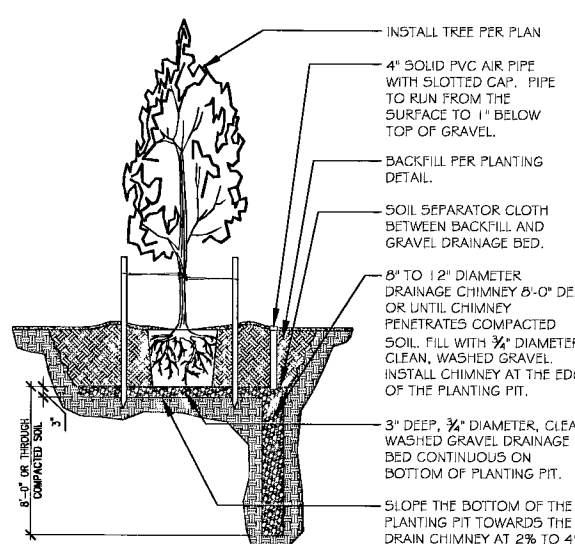

I TREE DRAIN CHIMNEY DETAIL

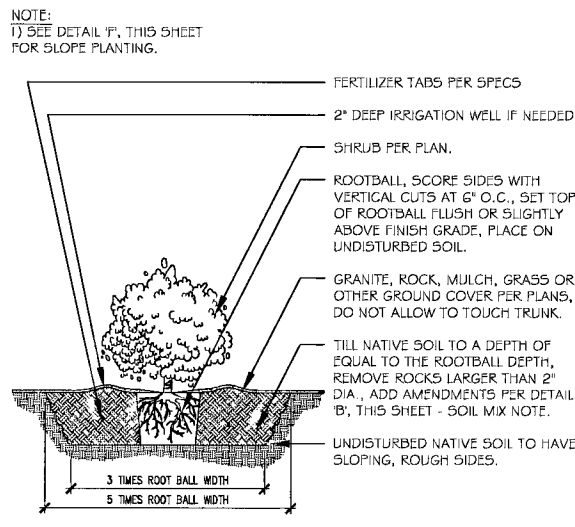

E SHRUB PLANTING DETAIL
NOT TO SCALE

RECORD DRAWINGS NOT FOR CONSTRUCTION

1. TO ALTER THESE DOCUMENTS FOR ANOTHER PROJECT
BY ANYONE OTHER THAN THE ORIGINAL ARCHITECT IS
A VIOLATION OF NRS 623.
2. THIS RECORD DRAWING HAS BEEN PREPARED IN PART,
BASED UPON INFORMATION FURNISHED BY THE GENERAL
CONTRACTOR, WHILE THIS INFORMATION IS BELIEVED TO
BE RELIABLE, THE DESIGN PROFESSIONAL CANNOT ASSURE
ITS ACCURACY, AND THIS IS NOT RESPONSIBLE FOR THE
ACCURACY OF THIS RECORD DRAWING OR FOR ANY ERRORS OR
OMISSIONS WHICH MAY HAVE BEEN INCORPORATED INTO IT AS
A RESULT. THE DESIGN PROFESSIONAL CANNOT AND DOES NOT
WARRANT ITS ACCURACY.
3. INFORMATION THAT MAY BE INCLUDED WOULD BE SIG-
NIFICANT CHANGES TO PLANTING OR IRRIGATION
LAYOUT PLANS AND ASSOCIATED DRAWINGS, MINOR
DIMENSION OR CONSTRUCTION DETAIL CHANGES MAY
NOT BE INCLUDED.

BOTANICAL NAME	COMMON NAME	QTY	SIZE (MINIMUM)	COND	DTL	REMARKS
TREES						
CHITALPA TASHKENTENSIS 'PINK DAWN'	PINK DAWN CHITALPA	37	1.25\"/>	BOX	A, B, C	
FRAXINUS OXYCARPA 'RAYWOOD'	RAYWOOD ASH	39	1.5\"/>	BOX	A, B, C	
FRAXINUS VELUTINA 'RIO GRANDE'	FAN-TEX ASH	91	1.25\"/>	BOX	A, B, C	
OLEA EUROPAEA 'SWAN HILL' - MULTI*	SWAN HILL OLIVE (NO SUBSTITUTIONS)	4	2.5\"/>	BOX	A, B, D	2.5\"/>
PINUS ELIDARICA	MONDEL PINE	43	2\"/>	BOX	A, B, C	
PISTACIA CHINENSIS	CHINESE PISTACHE	38	3\"/>	BOX	A, B, C	
ROBINIA AMBIGUA 'PURPLE ROBE'	PURPLE ROBE LOCUST	36	1.5\"/>	BOX	A, B, C	
VITEX AGNUS-CASTUS - MULTI	CHASTE TREE (PURPLE FLOWER)	7	2.0\"/>	BOX	A, B, D	2.0\"/>
SHRUBS AND GROUNDCOVERS						
ACACIA REDOLENS 'DESERT CARPET'	GREEFING ACACIA	58	5 GALLON	CONT.	B, E, F	FULL AND BUSHY
CAESALPINIA GILLIESII	YELLOW BIRD OF PARADISE	64	5 GALLON	CONT.	B, E, F	FULL AND BUSHY
CHRYSANTHEMUM MEXICANA	DAMIANITA DAISY	274	5 GALLON	CONT.	B, E, F	FULL AND BUSHY
CONVOLVULUS CINEORUM	BUSH MORNING GLORY	161	5 GALLON	CONT.	B, E, F	FULL AND BUSHY
COTONEASTER LACTIFLUS	RED CLUSTERBERRY	278	5 GALLON	CONT.	B, E, F	FULL AND BUSHY
DASYLIRION QUADRANGULATUM	TOOTHLESS STOOL	48	5 GALLON	CONT.	B, E, F	FULL
DODONAEA VISCOSA 'PURPUREA'	PURPLE HOPSPEED BUSH	112	5 GALLON	CONT.	B, E, F	FULL AND BUSHY
HEPERALOE PARVIFLORA	RED HESPERALOE	801	5 GALLON	CONT.	B, E, F	FULL AND BUSHY
LEUCOPHYLLUM LAMGMANIAE 'RIO BRAVO'	RIO BRAVO SAGE	549	5 GALLON	CONT.	B, E, F	FULL AND BUSHY
LEUCOPHYLLUM ZYGOPHYLLUM 'CIMARRON'	CIMARRON SAGE	248	5 GALLON	CONT.	B, E, F	FULL AND BUSHY
LIGUSTRUM JAPONICA	JAPANESE PRIVET	56	5 GALLON	CONT.	B, E, F	FULL AND BUSHY
MUHLBERGIA CAPILLARIS 'REGAL MIST'	REGAL MIST DEER GRASS	710	5 GALLON	CONT.	B, E, F	FULL AND BUSHY
MYRTUS COMMUNIS 'COMPACTA'	DWARF GREEK MYRTLE	116	5 GALLON	CONT.	B, E, F	FULL AND BUSHY
SALVIA CLEVELANDII	CHAPARRAL SAGE	25	5 GALLON	CONT.	B, E, F	FULL AND BUSHY
TEUCRUM CHAMAEDRYIS 'PROSTRATUM'	PROSTRATE GERMANDER	55	5 GALLON	CONT.	B, E, F	FULL AND BUSHY
VERBENA RIGIDA	COARSE VERBENA	19	5 GALLON	CONT.	B, E, F	FULL AND BUSHY
OTHER						
CYNODON SPECIES 'TIFWAY II'	'TIFWAY II' HYBRID BERMUDA		LONG ROLLS	SOD	B, G	

PLANTING LEGEND

NOTES: PLANT MATERIALS SHALL HAVE IDENTIFICATION TAGS ON 10% OF TOTAL QUANTITY OF EACH SPECIES.
* ALL PLANTS WITH ASTERISK MUST HAVE NURSERY TAG SHOWING TRADEMARK.
PLANT QUANTITIES ARE FOR REFERENCE ONLY, EXACT PLANT COUNTS ARE THE RESPONSIBILITY OF THE CONTRACTOR.