


- NOTES:
1. PROVIDE PLYWOOD COLLAR AROUND FOOTING HOLE TO PREVENT DIRT FROM FALLING IN THE HOLE.
2. VIBRATE CONCRETE FULL DEPTH OF FOOTING.

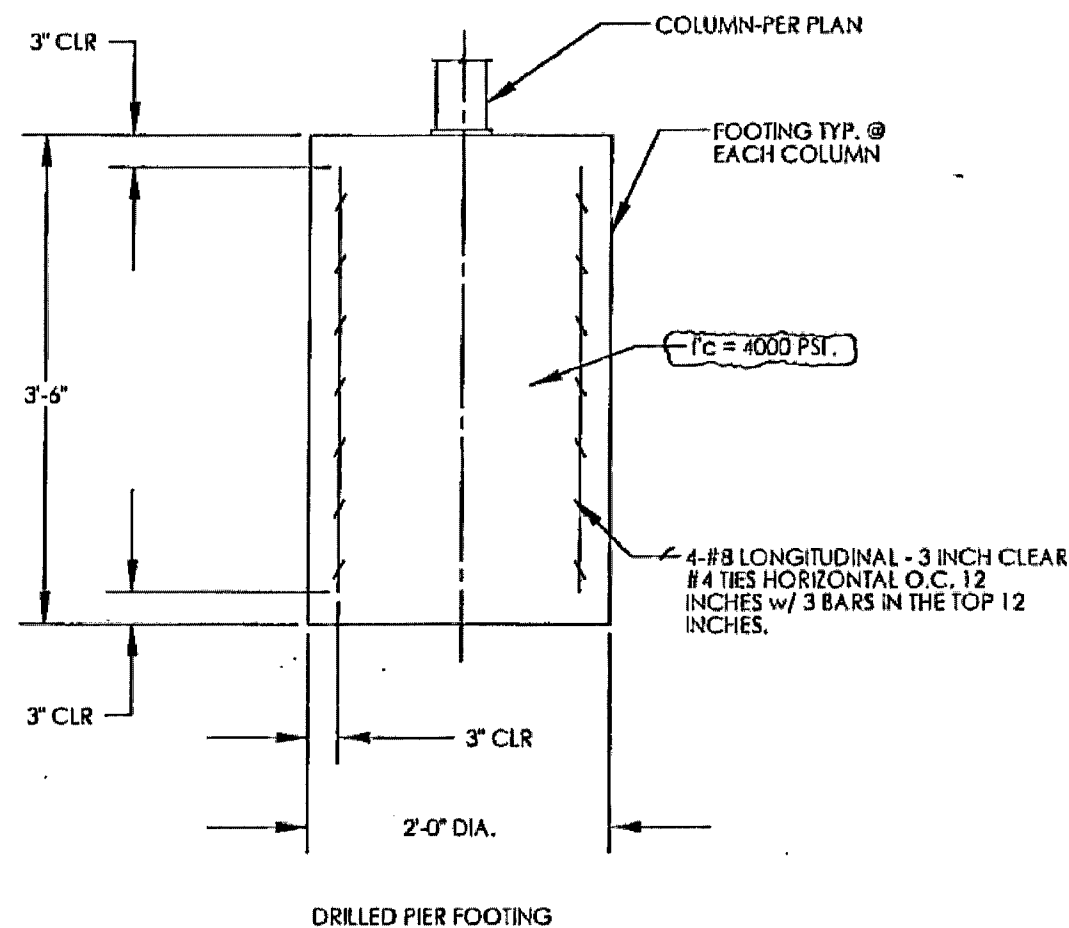

FOUNDATION NOTES:

1. ALL MATERIALS AND WORKMANSHIP SHALL CONFORM TO THE REQUIREMENTS OF THE 2006 INTERNATIONAL BUILDING CODE w/ NEVADA AMENDMENTS, AND ALL APPLICABLE STATE & LOCAL ORDINANCES AND REQUIREMENTS.
2. THE CONCRETE DESIGN IS BASED ON A 28-DAY STRENGTH OF 2500 PSI BUT THE CONTRACTOR IS URGED TO USE A 28-DAY STRENGTH OF 3000 PSI. TYPE V CEMENT IS RECOMMENDED.
3. ANCHOR BOLTS SHALL BE A307 QUALITY AND RECOMMENDED TO BE THE "HEADED" TYPE BOLT IF NOT USING THE ANCHORS SUPPLIED BY THE MANUFACTURER OF THE SHELTER.
4. THE PIER FOOTING SHALL BEAR ON COMPETENT UNDISTURBED SOIL OR 95% COMPACTED FILL. IF SIGNS OF ORGANIC MATERIAL, UNCONTROLLED FILL, CLAY OR SILT, HIGH WATER TABLE OR OTHER POSSIBLE DETRIMENTAL CONDITIONS ARE FOUND, INSTALLATION OF THE FOUNDATION MUST BE DISCONTINUED AND A SOILS ENGINEER CONTACTED. THE SOILS ENGINEER MUST THEN EVALUATE THE SOIL PROPERTIES BEFORE THE FOUNDATION CAN BE INSTALLED. A LOCAL FOUNDATION DESIGN ENGINEER MUST THEN REDESIGN THE FOUNDATION BASED ON THE NEW SOILS CONDITION.
5. ALL CONCRETE INSTALLATION SHALL CONFORM TO THE REQUIREMENTS OF THE AMERICAN CONCRETE INSTITUTE (ACI) BUILDING CODE, ACI 318, LATEST EDITION AND ALL STATE & LOCAL ORDINANCES AND REQUIREMENTS.
6. THE REINFORCING STEEL SHALL BE NEW AND UNUSED AND SHALL CONFORM TO THE REQUIREMENTS OF ASTM A615, GRADE 60.
7. IF FOOTING DEPTH SHOWN DOES NOT MEET LOCAL FROST REQUIREMENTS, FOOTINGS SHALL BE RE-DESIGNED UNDER DIRECTION OF A LOCAL ENGINEER. IT IS THE CONTRACTOR'S RESPONSIBILITY TO VERIFY THE LOCAL FROST LINE DEPTH BELOW FINISH GRADE PRIOR TO CONSTRUCTION.

THE FOUNDATION DESIGN CONTAINED HEREIN IS SITE SPECIFIC BASED ON "GEOTECHNICAL RECOMMENDATIONS REPORT LORENZI PARK RENOVATIONS - PHASE I, 3333 WEST WASHINGTON AVENUE, LAS VEGAS, NEVADA" PREPARED BY NINYO & MOORE, DATED MARCH 27, 2007

PAGE 25 OF REFERENCED SOILS REPORT RECOMMENDS W/C RATIO .50 OF TYPE V CEMENT AND A DESIGN STRENGTH OF f'_c -4,000 PSI.

RECORD DRAWINGS NOT FOR CONSTRUCTION

1. TO ALTER THESE DOCUMENTS FOR ANOTHER PROJECT BY ANYONE OTHER THAN THE ORIGINAL ARCHITECT IS A VIOLATION OF NRS 623.
2. THIS RECORD DRAWING HAS BEEN PREPARED IN PART, BASED UPON INFORMATION FURNISHED BY THE GENERAL CONTRACTOR, WHILE THIS INFORMATION IS BELIEVED TO BE RELIABLE, THE DESIGN PROFESSIONAL CANNOT ASSURE ITS ACCURACY, AND THUS IS NOT RESPONSIBLE FOR THE ACCURACY OF THIS RECORD DRAWING OR FOR ANY ERRORS OR OMISSIONS WHICH MAY HAVE BEEN INCORPORATED INTO IT AS A RESULT. THE DESIGN PROFESSIONAL CANNOT AND DOES NOT WARRANT THEIR ACCURACY.
3. INFORMATION THAT MAY BE INCLUDED WOULD BE SIGNIFICANT CHANGES TO PLANTING OR IRRIGATION LAYOUT PLANS AND ASSOCIATED DRAWINGS, MINOR DIMENSION OR CONSTRUCTION DETAIL CHANGES MAY NOT BE INCLUDED.

RECORD DRAWING 7-10-08

THIS SEAL PERTAINS ONLY TO THE MATERIALS SUPPLIED BY POLYGON.
THIS SEAL DOES NOT SERVE AS -OR REPRESENT- THE PROJECT
ENGINEER OF RECORD AND SHALL NOT BE CONSTRUED AS SUCH.

800-354-7721
www.polygon.com
by **PORTERCORP**
PORTERCORP 4240 N. 136th AVE HOLLAND, MI 49424

PRINT DATE: 10/17/2007
SCALE: 1:1
DRAWN BY: A07
REV LEVEL: A07
CREATION DATE: 4/11/2007
JOB NO: 43292

PROJECT: LORENZI PARK
PROJECT LOCATION: LAS VEGAS, NV
DRAWING: FOOTING DETAILS
CAD MODEL: SQR-16MR-B1-43292

SHEET

SS9.2