
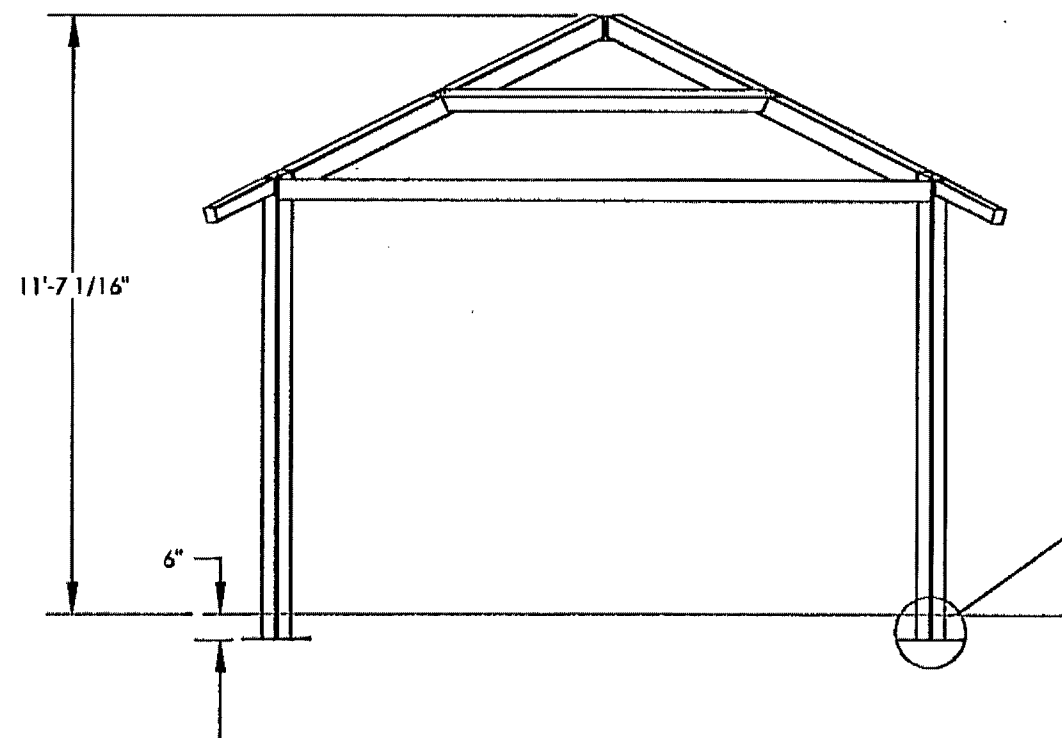
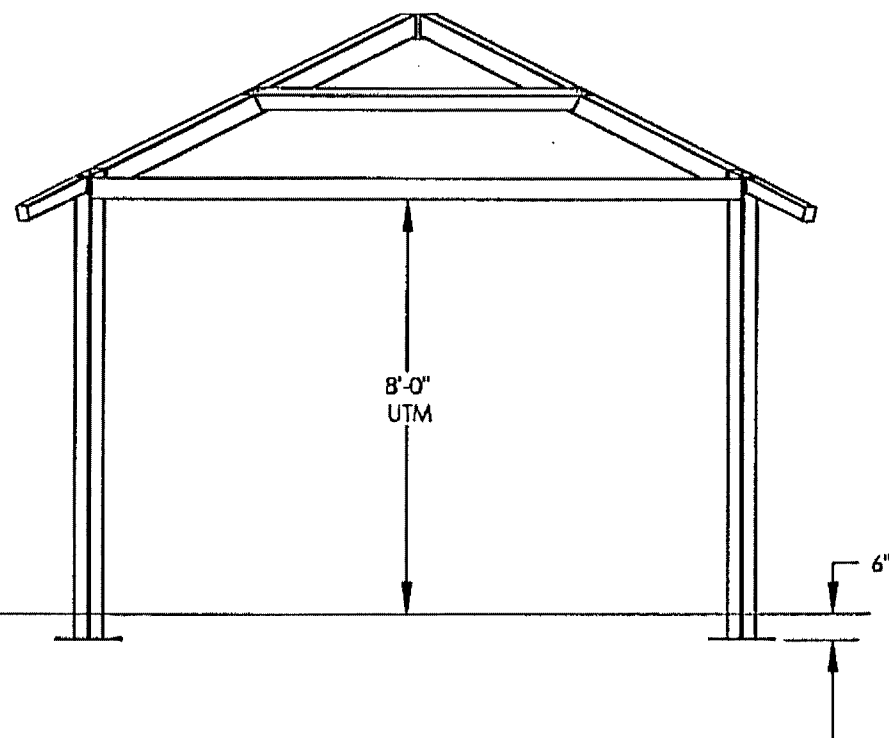
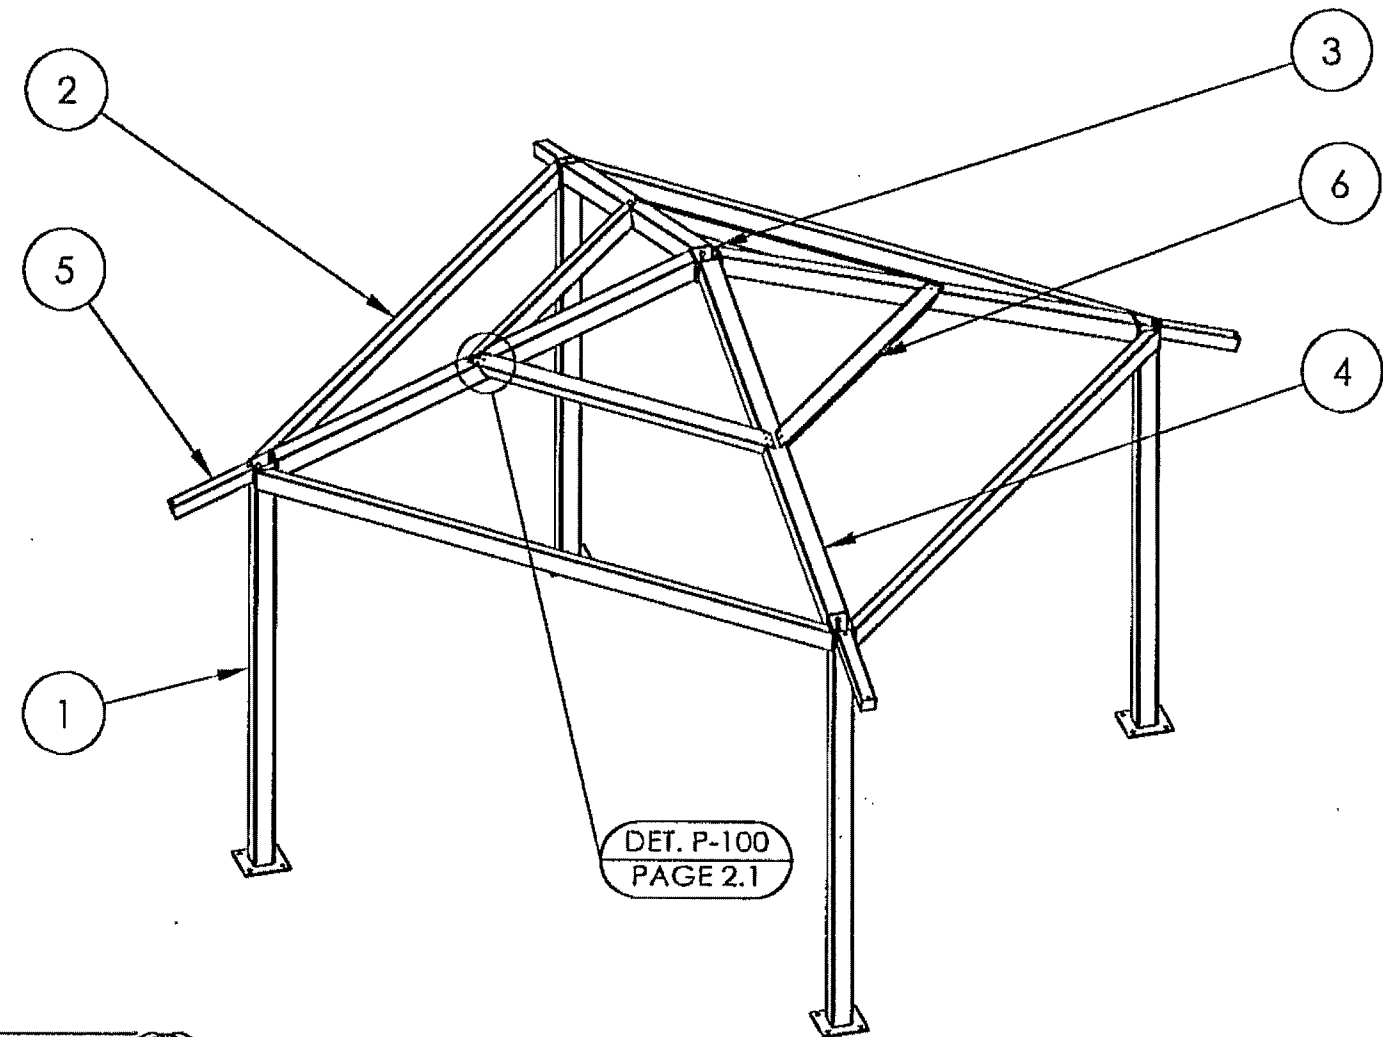


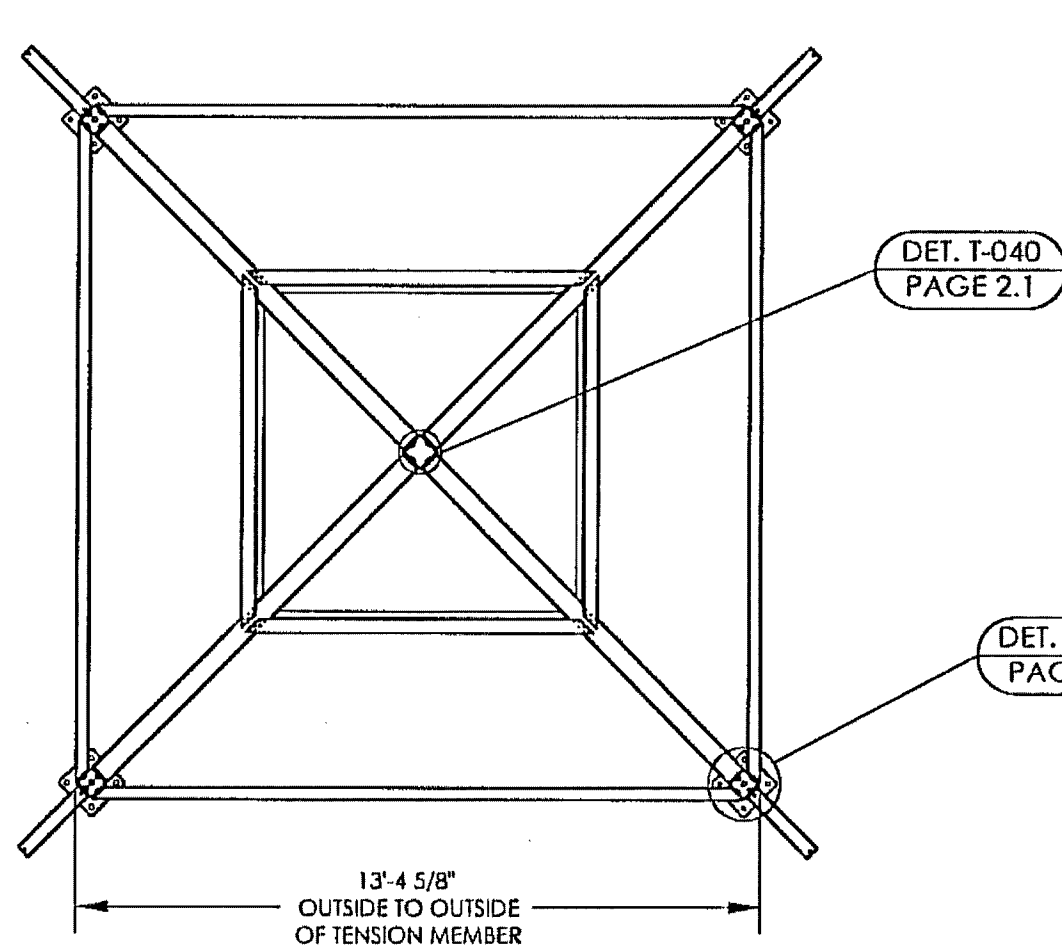

DET. A-200
PAGE 2.1

6	4	SQR-Flex Laser Purlin-43292	PURLIN, HSS4X4X1/8, 76.274'L	HSS4X4X1/8
5	4	SQR-Flex T-Tail-43292	T-TAIL ASM, HSS3.5X3.5X1/8, 21.00"L	HSS3.5X3.5X1/8
4	4	SQR-Flex Truss-43292	TRUSS ASM, HSS5X5X1/8, 108.120"L	HSS5X5X1/8
3	1	SQR-Flex C-Tube-43292	C-TUBE ASM, HSS6X6X3/8, 5 7/8"L	HSS6X6X3/8
2	4	SQR-Flex T-Mem-43292	T-MEM ASM, HSS5X3X1/8, 152.469"L	HSS5X3X1/8
1	4	SQR-Flex Column-43292	COL ASM, HSS5X5X3/16, 108.400"L	HSS5X5X3/16
ITEM	FRAME/QTY.	Part No.	Description	Material

**RECORD DRAWINGS
NOT FOR CONSTRUCTION**

1. TO ALTER THESE DOCUMENTS FOR ANOTHER PROJECT BY ANYONE OTHER THAN THE ORIGINAL ARCHITECT IS A VIOLATION OF NRS 623.

2. THIS RECORD DRAWING HAS BEEN PREPARED IN PART, BASED UPON INFORMATION FURNISHED BY THE GENERAL CONTRACTOR, WHILE THIS INFORMATION IS BELIEVED TO BE RELIABLE, THE DESIGN PROFESSIONAL CANNOT ASSURE ITS ACCURACY, AND THIS IS NOT RESPONSIBLE FOR THE ACCURACY OF THIS RECORD DRAWING OR FOR ANY ERRORS OR OMISSIONS WHICH MAY HAVE BEEN INCORPORATED INTO IT AS A RESULT. THE DESIGN PROFESSIONAL CANNOT AND DOES NOT WARRANT THEIR ACCURACY.

3. INFORMATION THAT MAY BE INCLUDED WOULD BE SIGNIFICANT CHANGES TO PLANTING OR IRRIGATION LAYOUT PLANS AND ASSOCIATED DRAWINGS, MINOR DIMENSION OR CONSTRUCTION DETAIL CHANGES MAY NOT BE INCLUDED.

RECORD DRAWING 7-10-08

THIS SEAL PERTAINS ONLY TO THE MATERIALS SUPPLIED BY POLYGON.
THIS SEAL DOES NOT SERVE AS - OR REPRESENT - THE PROJECT
ENGINEER OF RECORD AND SHALL NOT BE CONSTRUED AS SUCH.

PRINT DATE:	10/17/2007
DRAWN BY:	betbol
REVIEW:	A07
SCALE:	1:48
CREATION DATE:	4/11/2007
JOB NO:	43292

PROJECT: LORENZI PARK
 PROJECT LOCATION: LAS VEGAS, NV
 DRAWING: STRUCTURAL FRAMING PLAN
 CAD MODEL: SQR-16MR-B1-43292
 SHEET: **SS10.0**