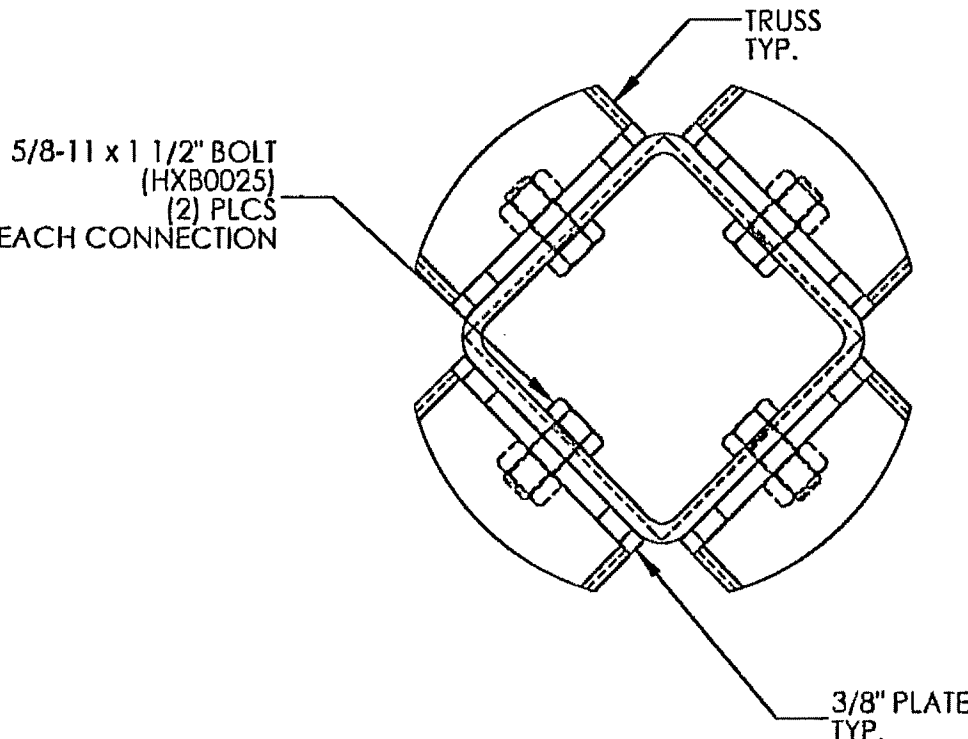
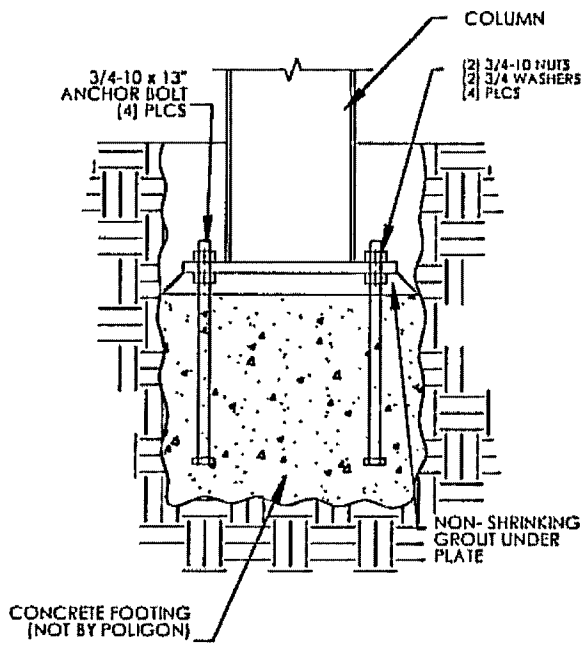
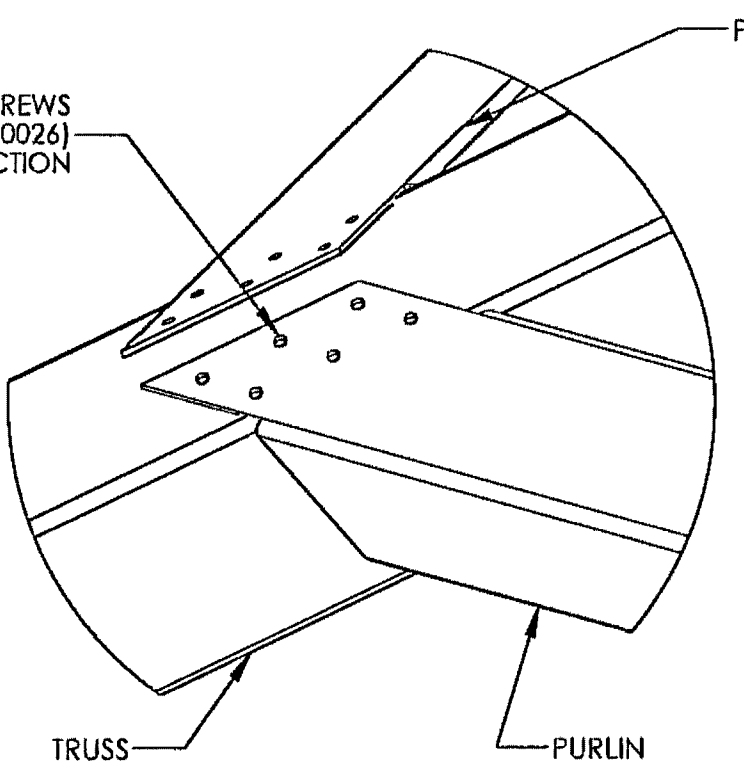
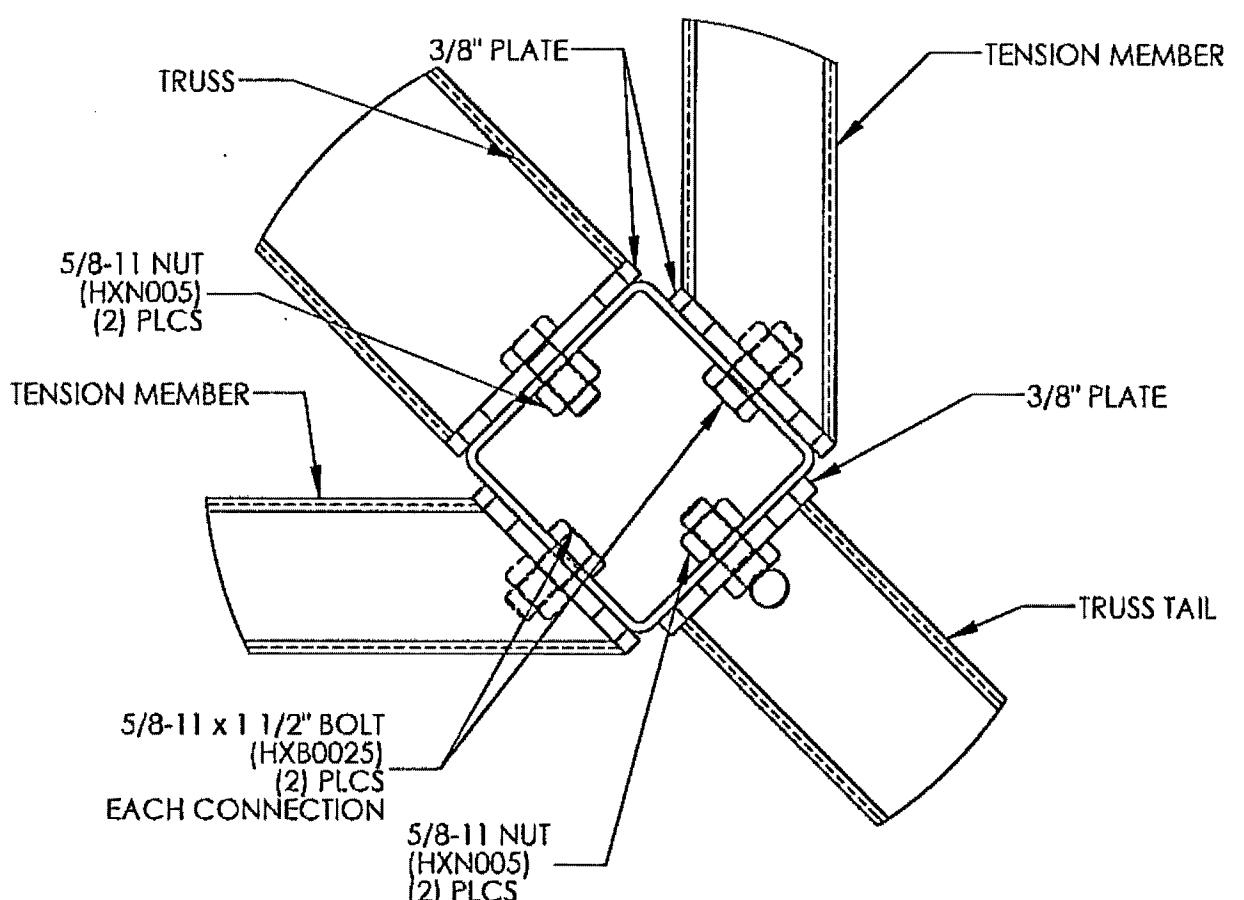


 5/8-11 x 1 1/2" BOLT (HXB0025) (2) PLCS EACH CONNECTION TRUSS TYP. 3/8" PLATE TYP.	T-040	 COLUMN 3/4-10 x 13" ANCHOR BOLT (4) PLCS (2) 3/4-10 NUTS (2) 3/4 WASHERS (4) PLCS NON-SHRINKING GROUT UNDER PLATE CONCRETE FOOTING (NOT BY POLYGON)	NOTES: ALL HIGH STRENGTH BOLTS ARE A-325 BOLTS AND TO BE INSTALLED BY THE "TURN OF THE NUT" METHOD AS SPECIFIED IN THE 9TH EDITION OF THE AISC "SPECIFICATION FOR STRUCTURAL JOINTS USING ASTM A325 OR A490 BOLTS", SECTION 8 D (1). A-325 BOLTS MAY BE INSTALLED WITHOUT WASHERS WHEN TIGHTENED BY THE "TURN OF THE NUT" METHOD. IT IS THE RESPONSIBILITY OF THE ERECTOR TO INSURE PROPER TIGHTNESS. INSPECTION OF THE HIGH STRENGTH BOLTING, IF REQUIRED SHALL BE IN ACCORDANCE WITH THE REQUIREMENTS OF THE GOVERNING CODE. ERECTION OF THE FRAMING MEMBERS WILL REQUIRE THE MAIN COLUMNS TO BE PLUMB SQUARE AND TIGHTENED BEFORE INSTALLING THE PURLINS. PURLINS, IF REQUIRED, MUST BE PARALLEL TO THE EAVE BEAMS AND TENSION MEMBERS. UNLESS THE BUILDING HAS A FACTORY APPLIED POWDERCOAT, E-COAT OR GALVANIZING, THE FRAME WILL BE PRIME PAINTED AND WILL BE REQUIRED TO BE FINISH PAINTED IN THE FIELD WITH ALL PAINT, MATERIALS AND LABOR NOT BY POLYGON (PORTERCORP, INC). REFER TO FINAL SALES ORDER. TOUCH-UP PAINT MUST BE APPLIED TO ALL EXPOSED BOLTS & NUTS. PERIODIC TOUCH-UP AT THESE BOLTED CONNECTIONS IS A MUST.	poligon 800-354-7721 www.poligon.com by PORTERCORP PORTERCORP 4240 N. 136th AVE HOLLAND, MI 49424
 (6) 1/4-14 x 1 1/4" SCREWS (030026) EACH CONNECTION PURLIN TRUSS PURLIN	P-100	 TRUSS 3/8" PLATE TENSION MEMBER 5/8-11 NUT (HXN005) (2) PLCS TENSION MEMBER 3/8" PLATE TRUSS TAIL 5/8-11 x 1 1/2" BOLT (HXB0025) (2) PLCS EACH CONNECTION 5/8-11 NUT (HXN005) (2) PLCS	C-240 RECORD DRAWINGS NOT FOR CONSTRUCTION 1. TO ALTER THESE DOCUMENTS FOR ANOTHER PROJECT BY ANYONE OTHER THAN THE ORIGINAL ARCHITECT IS A VIOLATION OF NRS 623. 2. THIS RECORD DRAWING HAS BEEN PREPARED IN PART, BASED UPON INFORMATION FURNISHED BY THE GENERAL CONTRACTOR, WHILE THIS INFORMATION IS BELIEVED TO BE RELIABLE, THE DESIGN PROFESSIONAL CANNOT ASSURE ITS ACCURACY, AND THIS IS NOT RESPONSIBLE FOR THE ACCURACY OF THIS RECORD DRAWING OR FOR ANY ERRORS OR OMISSIONS WHICH MAY HAVE BEEN INCORPORATED INTO IT AS A RESULT. THE DESIGN PROFESSIONAL CANNOT AND DOES NOT WARRANT THEIR ACCURACY. 3. INFORMATION THAT MAY BE INCLUDED WOULD BE SIGNIFICANT CHANGES TO PLANTING OR IRRIGATION LAYOUT PLANS AND ASSOCIATED DRAWINGS, MINOR DIMENSION OR CONSTRUCTION DETAIL CHANGES MAY NOT BE INCLUDED. RECORD DRAWING 7-10-08 THIS SEAL PERTAINS ONLY TO THE MATERIALS SUPPLIED BY POLYGON. THIS SEAL DOES NOT SERVE AS - OR REPRESENT - THE PROJECT ENGINEER OF RECORD AND SHALL NOT BE CONSTRUED AS SUCH.	PRINT DATE: 10/17/2007 SCALE: 1:1 DRAWN BY: bel/bal REV LEVEL: A07 CREATION DATE: 4/11/2007 JOB NO: 43292 PROJECT: LORENZI PARK PROJECT LOCATION: LAS VEGAS, NV DRAWING: FRAME CONNECTION DETAILS CAD MODEL: SQR-16MR-B1-43292 SHEET SS10.1