
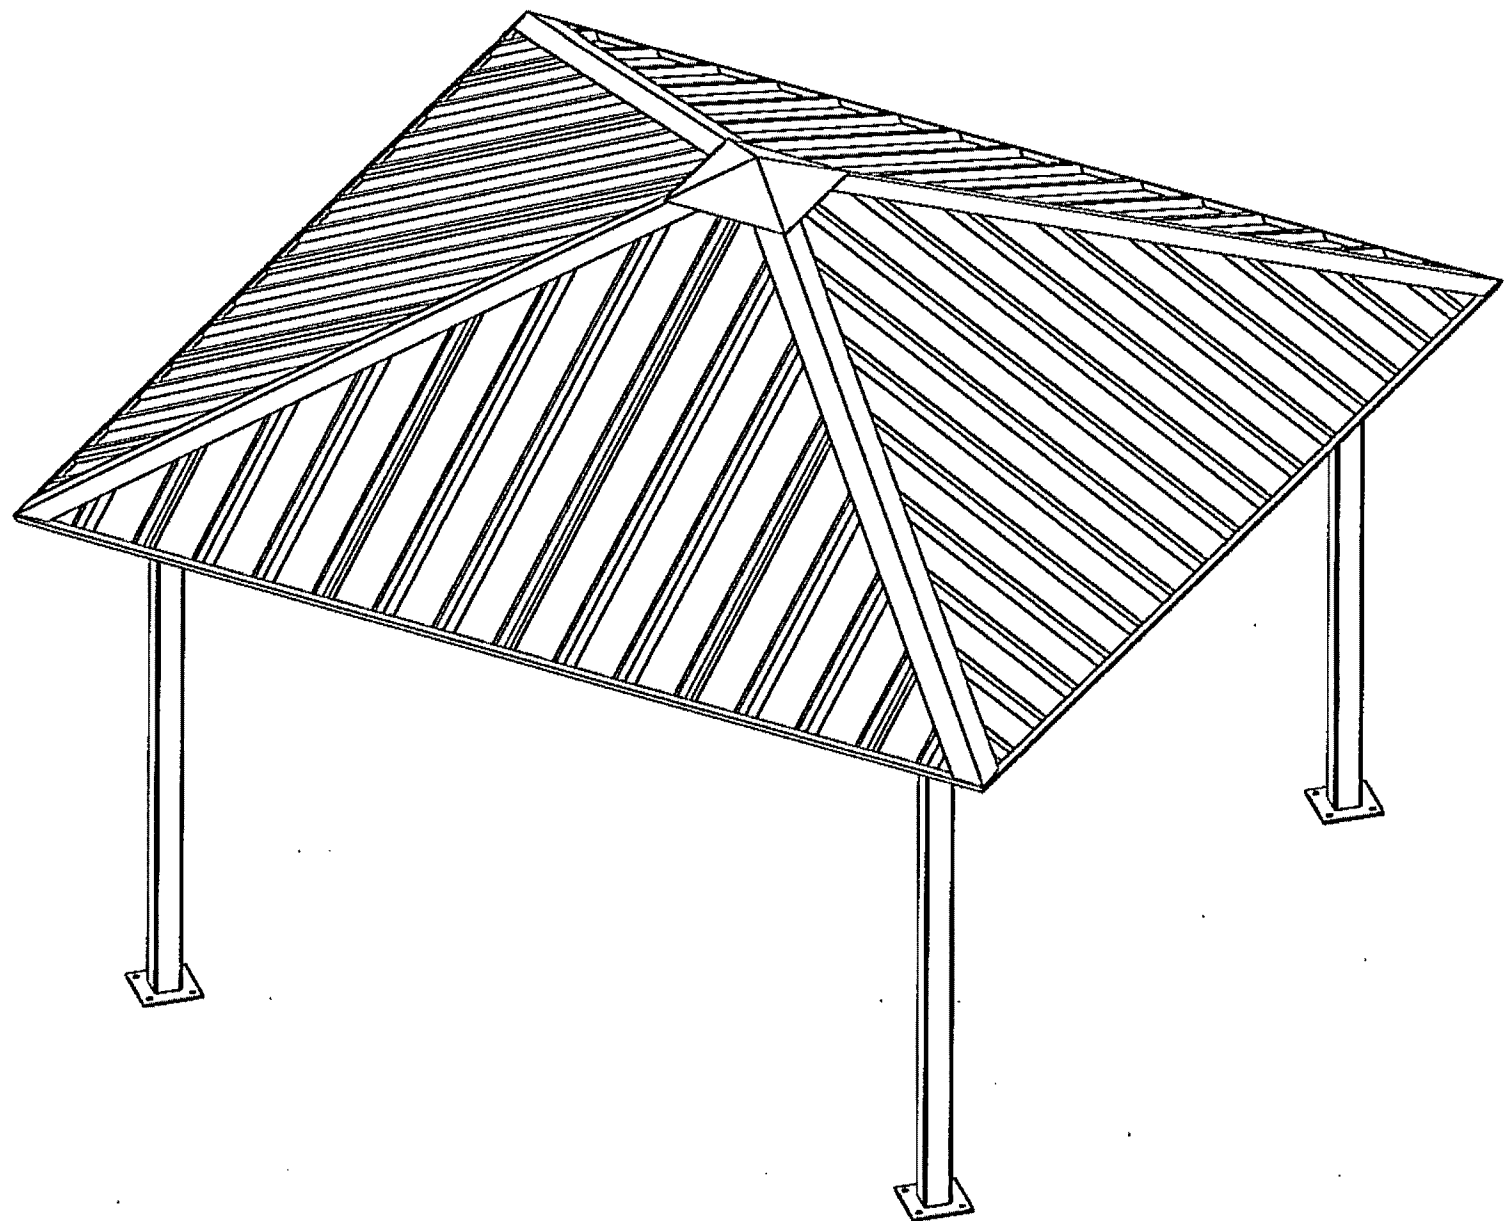
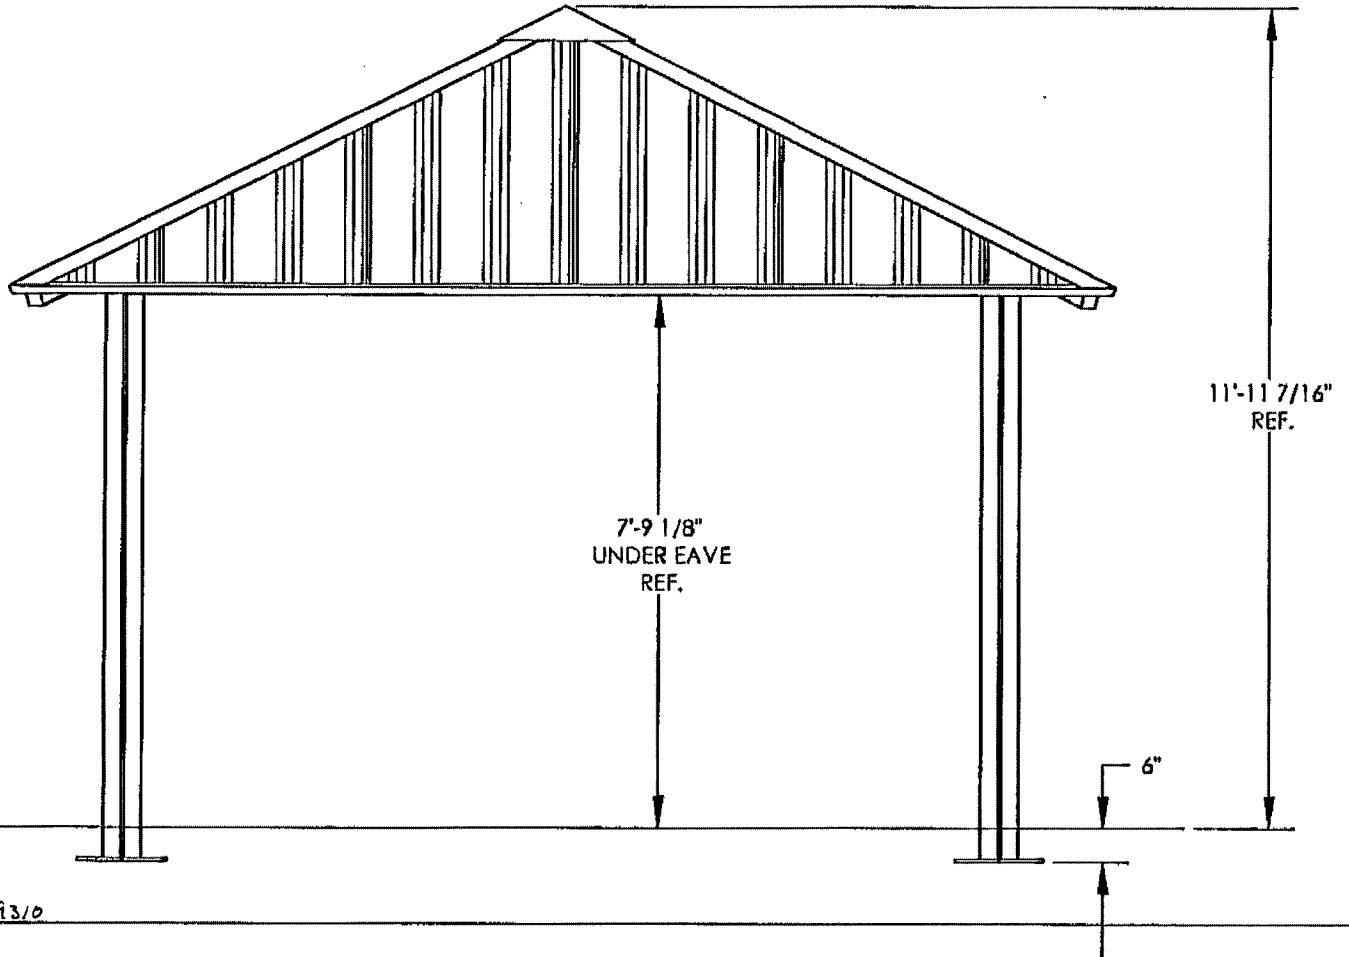


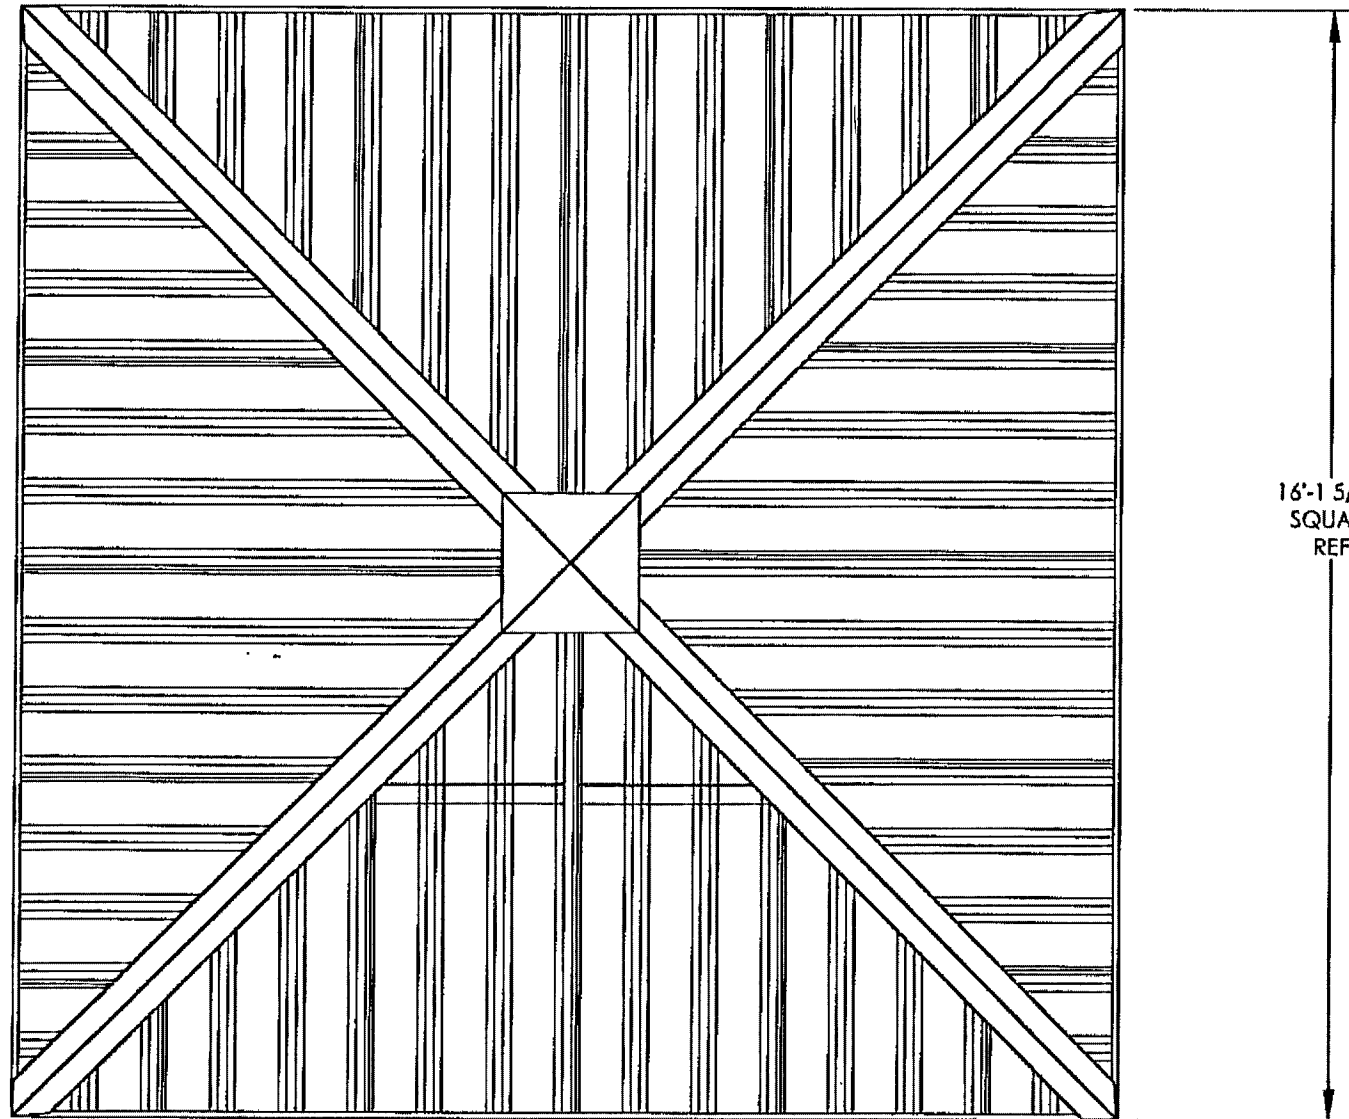

**RECORD DRAWINGS
NOT FOR CONSTRUCTION**

1. TO ALTER THESE DOCUMENTS FOR ANOTHER PROJECT BY ANYONE OTHER THAN THE ORIGINAL ARCHITECT IS A VIOLATION OF NRS 623.

2. THIS RECORD DRAWING HAS BEEN PREPARED IN PART, BASED UPON INFORMATION FURNISHED BY THE GENERAL CONTRACTOR, WHILE THIS INFORMATION IS BELIEVED TO BE RELIABLE, THE DESIGN PROFESSIONAL CANNOT ASSURE ITS ACCURACY, AND THIS IS NOT RESPONSIBLE FOR THE ACCURACY OF THIS RECORD DRAWING OR FOR ANY ERRORS OR OMISSIONS WHICH MAY HAVE BEEN INCORPORATED INTO IT AS A RESULT, THE DESIGN PROFESSIONAL CANNOT AND DOES NOT WARRANT THEIR ACCURACY.

3. INFORMATION THAT MAY BE INCLUDED WOULD BE SIGNIFICANT CHANGES TO PLANTING OR IRRIGATION LAYOUT PLANS AND ASSOCIATED DRAWINGS, MINOR DIMENSION OR CONSTRUCTION DETAIL CHANGES MAY NOT BE INCLUDED.

RECORD DRAWING 7-0-08

THIS SEAL PERTAINS ONLY TO THE MATERIALS SUPPLIED BY POLYGON.
THIS SEAL DOES NOT SERVE AS - OR REPRESENT - THE PROJECT
ENGINEER OF RECORD AND SHALL NOT BE CONSTRUED AS SUCH.

119310

PROJECT:

LORENZI PARK

CREATION DATE:

4/11/2007

DRAWN BY:

betbol

PRINT DATE:

10/17/2007

JOB NO:

43292

REV LEVEL:

A07

SCALE:

1:36

PATENTED AND/OR PATENTS PENDING. COPYRIGHT 2006 PORTERCORP HOLLAND, MI 49424

PROJECT LOCATION:

LAS VEGAS, NV

DRAWING:

ARCHITECTURAL ELEVATIONS

CAD MODEL:

SQR-16MR-81-43292

SHEET

SS11.0

poligon

ARCHITECTURE

800-354-7721

www.poligon.com

by

PORTERCORP

PORTERCORP 4240 N. 136th AVE HOLLAND, MI 49424