


J-CHANNEL CORNER TRIM CONNECTION DETAILS

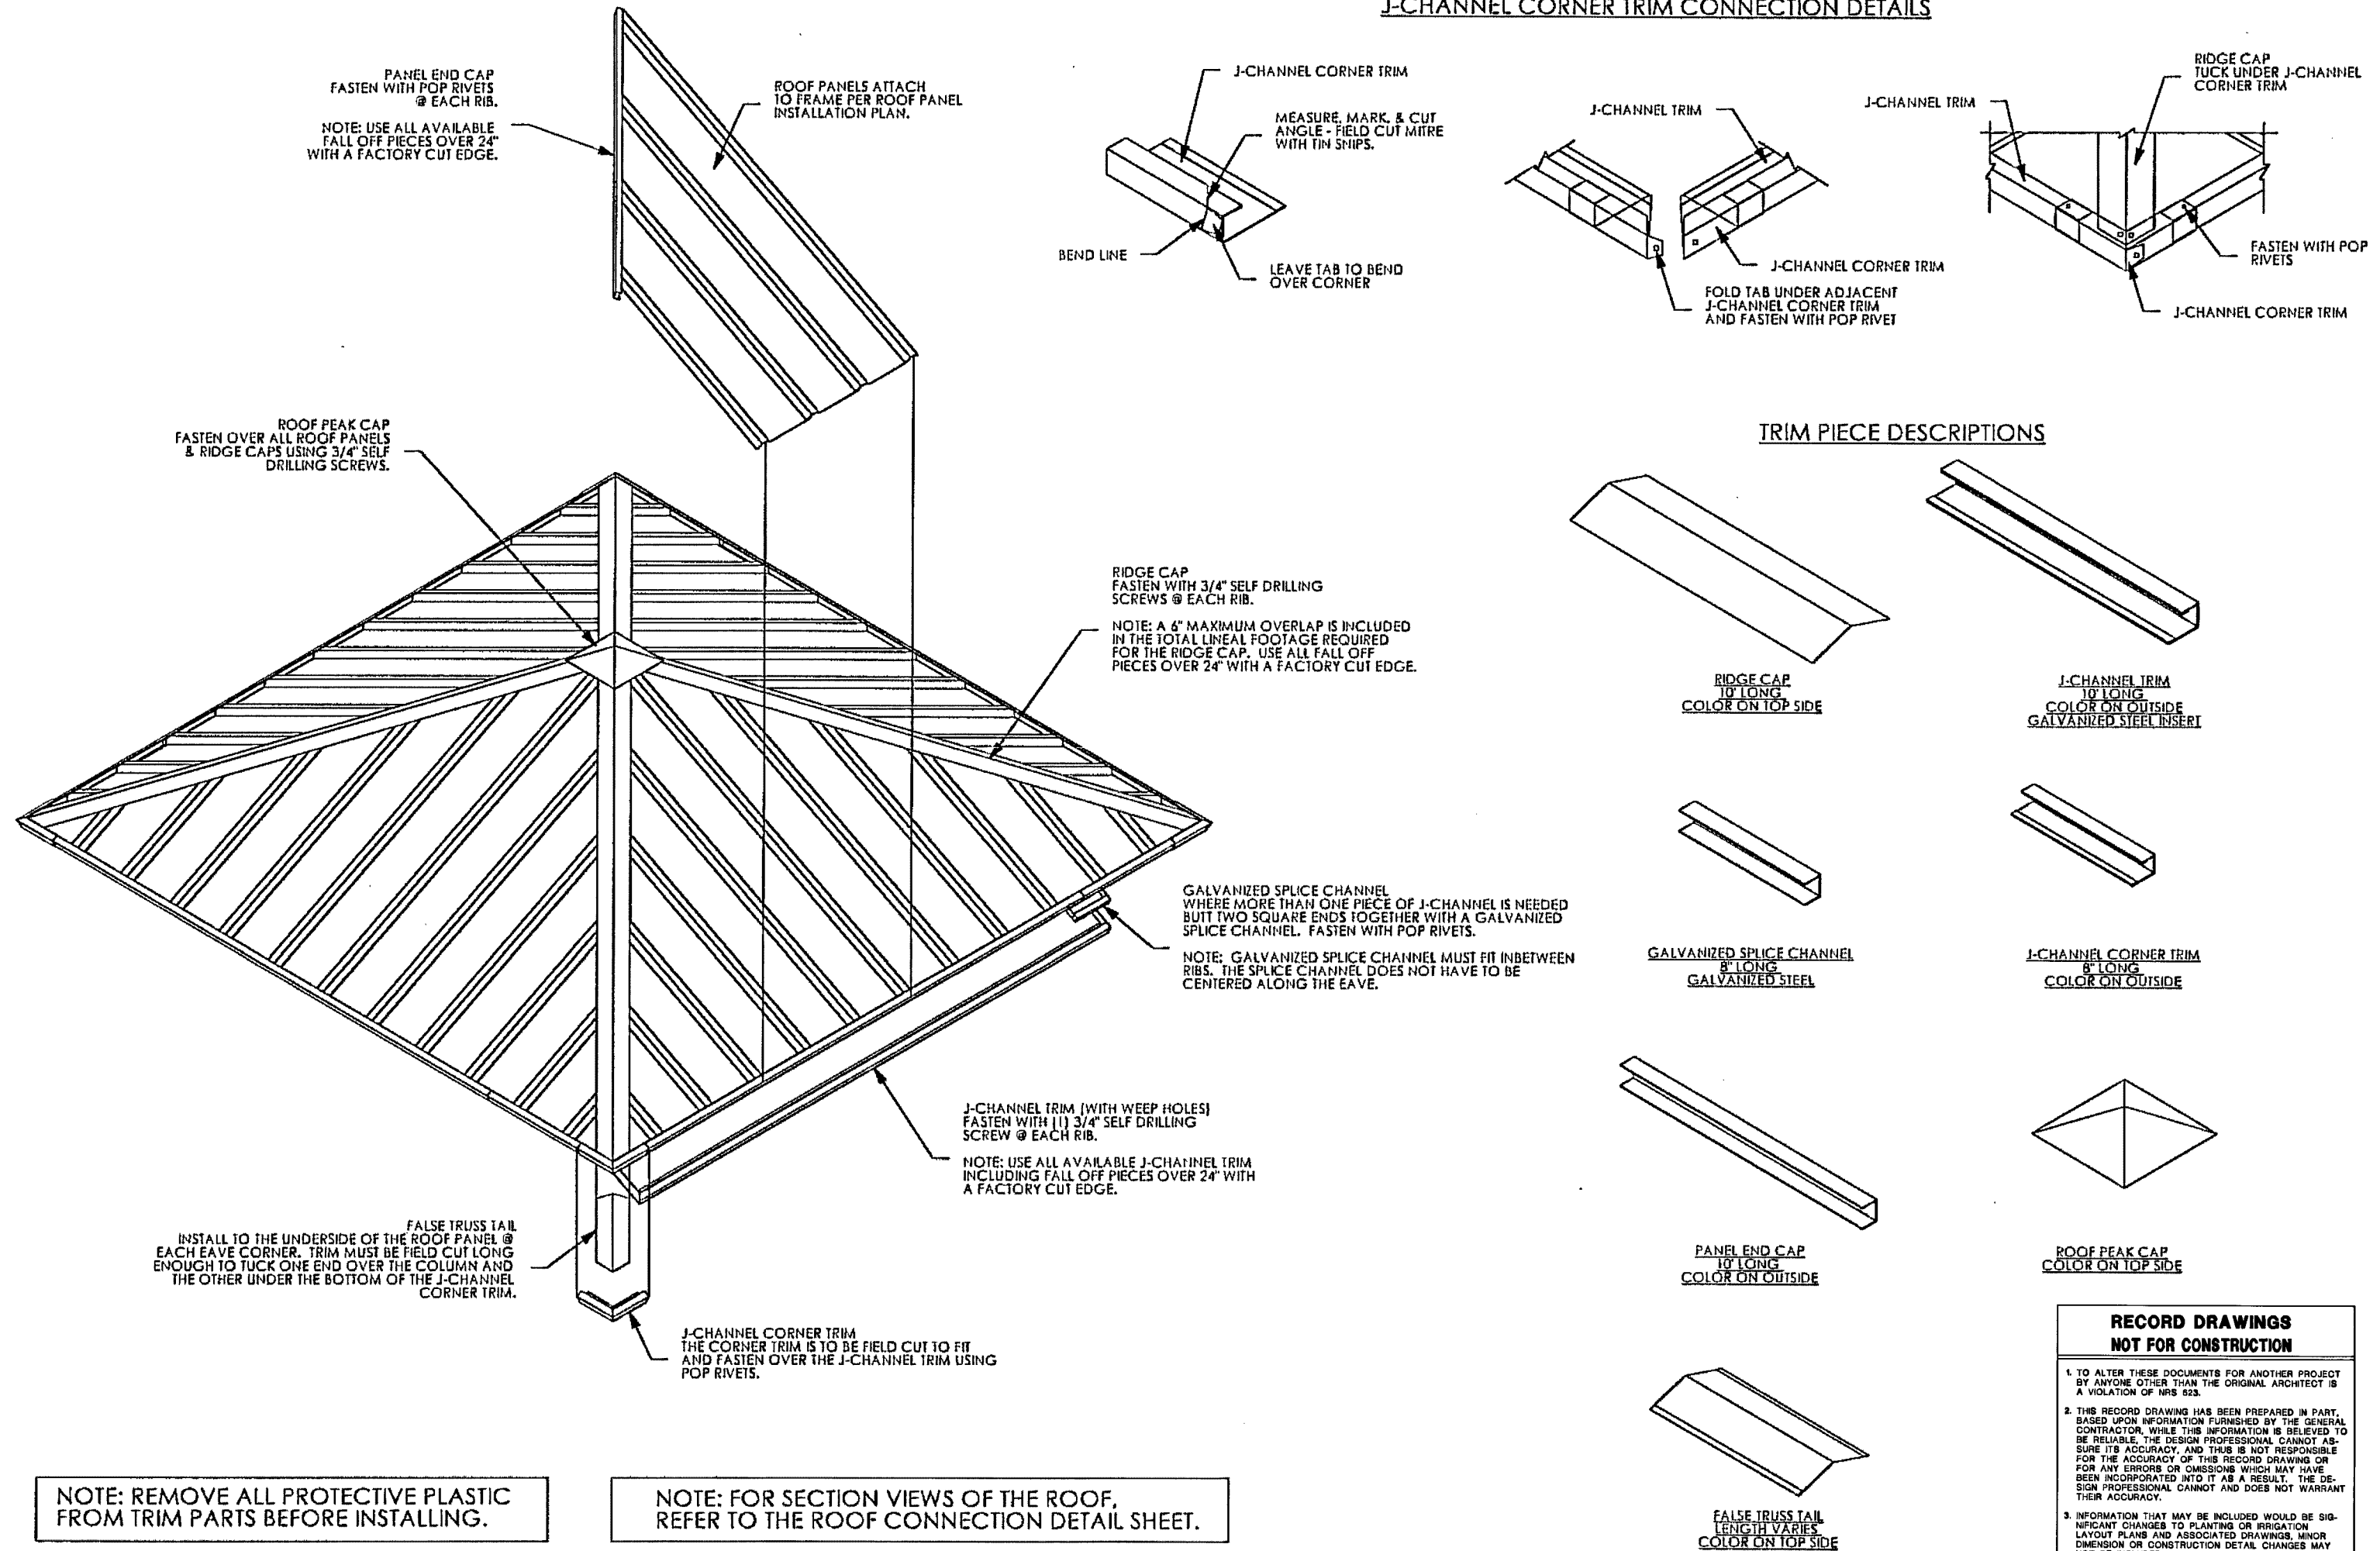

800-354-7721
www.poligon.com
by **PORTERCORP**
PORTERCORP 4240 N. 134th AVE. HOLLAND, MI 49424

PRINT DATE:	10/17/2007	DRAWN BY:	betbol
SCALE:	1:60	REV LEVEL:	A07
CREATION DATE:	4/11/2007	JOB NO:	43292

PROJECT: LORENZI PARK
PROJECT LOCATION: LAS VEGAS, NV
DRAWING: ROOF INSTALLATION
CAD MODEL: SQR-16MR-B1-43292

RECORD DRAWINGS
NOT FOR CONSTRUCTION

1. TO ALTER THESE DOCUMENTS FOR ANOTHER PROJECT BY ANYONE OTHER THAN THE ORIGINAL ARCHITECT IS A VIOLATION OF NRS 623.
2. THIS RECORD DRAWING HAS BEEN PREPARED IN PART, BASED UPON INFORMATION FURNISHED BY THE GENERAL CONTRACTOR, WHILE THIS INFORMATION IS BELIEVED TO BE RELIABLE, THE DESIGN PROFESSIONAL CANNOT ASSURE ITS ACCURACY, AND THIS IS NOT RESPONSIBLE FOR THE ACCURACY OF THIS RECORD DRAWING OR FOR ANY ERRORS OR OMISSIONS WHICH MAY HAVE BEEN INCORPORATED INTO IT AS A RESULT. THE DESIGN PROFESSIONAL CANNOT AND DOES NOT WARRANT THEIR ACCURACY.
3. INFORMATION THAT MAY BE INCLUDED WOULD BE SIGNIFICANT CHANGES TO PLANTING OR IRRIGATION LAYOUT PLANS AND ASSOCIATED DRAWINGS, MINOR DIMENSION OR CONSTRUCTION DETAIL CHANGES MAY NOT BE INCLUDED.

RECORD DRAWING 7-10-08

SHEET
SS12.2