


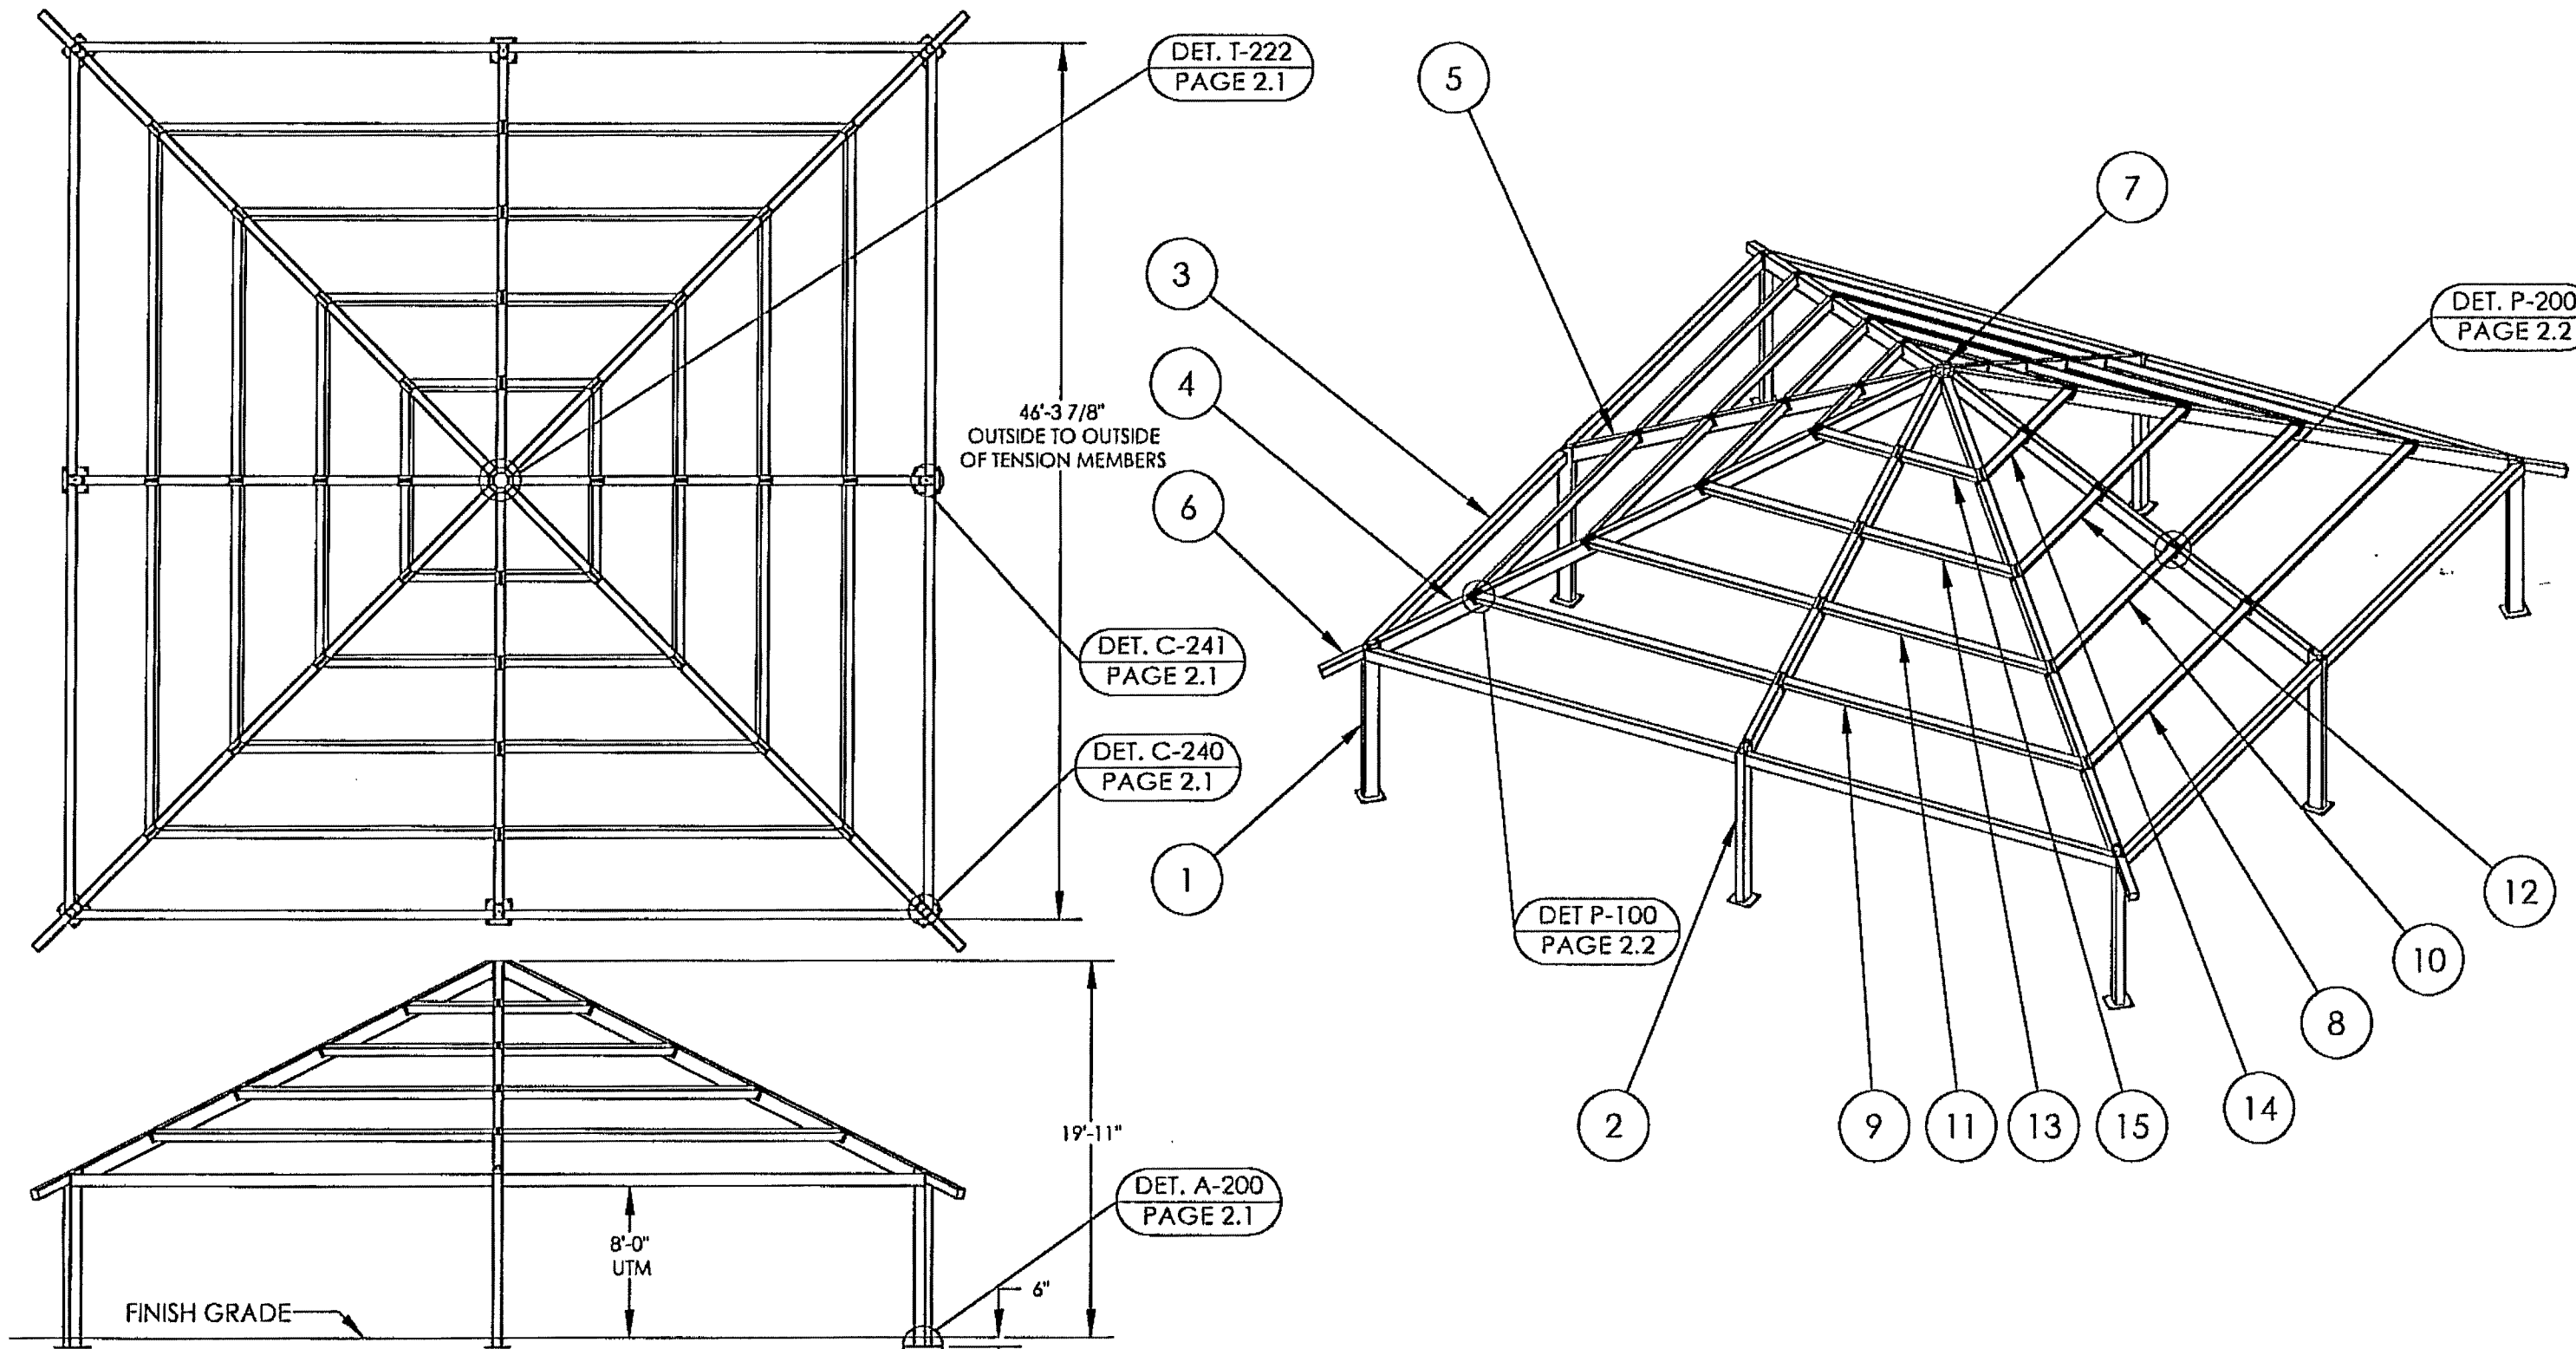

15	4	SQR-FLEX PURLIN_4_RH ASM-43293	R.H. PURLIN ASM 4,HSS6X6X3/16,56.491\"L	HSS6X6X3/16
14	4	SQR-FLEX PURLIN_4_LH ASM-43293	L.H. PURLIN ASM 4,HSS6X6X3/16,56.491\"L	HSS6X6X3/16
13	4	SQR-FLEX PURLIN_3_RH ASM-43293	R.H. PURLIN ASM 3,HSS6X6X3/16,110.604\"L	HSS6X6X3/16
12	4	SQR-FLEX PURLIN_3_LH ASM-43293	L.H. PURLIN ASM 3,HSS6X6X3/16,110.604\"L	HSS6X6X3/16
11	4	SQR-FLEX PURLIN_2_RH ASM-43293	R.H. PURLIN ASM 2,HSS6X6X3/16,164.717\"L	HSS6X6X3/16
10	4	SQR-FLEX PURLIN_2_LH ASM-43293	L.H. PURLIN ASM 2,HSS6X6X3/16,164.717\"L	HSS6X6X3/16
9	4	SQR-FLEX PURLIN_1_RH ASM-43293	R.H. PURLIN ASM 1,HSS6X6X3/16,218.830\"L	HSS6X6X3/16
8	4	SQR-FLEX PURLIN_1_LH ASM-43293	L.H. PURLIN ASM 1,HSS6X6X3/16,218.830\"L	HSS6X6X3/16
7	1	SQR-Flex C-Ring-43293	C-RING,CH12X30	CH12X30
6	4	SQR-Flex T-Tail-43293	T-TAIL,HSS6X6X1/8,30.950\"L	HSS6X6X1/8
5	4	SQR-Flex Mid Truss-43293	MID TRUSS ASM,HSS10X6X1/4,290.209\"L	HSS10X6X1/4
4	4	SQR-Flex Truss-43293	TRUSS ASM,HSS10X6X1/4,393.681\"L	HSS10X6X1/4
3	8	SQR-Flex T-Mem-43293	T-MEM ASM,HSS8X6X3/16,269.774\"L	HSS8X6X3/16
2	4	SQR-Flex Mid Column-43293	MID COL ASM,HSS10X6X3/16,114.500\"L	HSS10X6X3/16
1	4	SQR-Flex Column-43293	COL ASM,HSS10X6X3/16,113.168\"L	HSS10X6X3/16
ITEM	FRAME/QTY.	Part No.	Description	Material

**RECORD DRAWINGS
NOT FOR CONSTRUCTION**

1. TO ALTER THESE DOCUMENTS FOR ANOTHER PROJECT BY ANYONE OTHER THAN THE ORIGINAL ARCHITECT IS A VIOLATION OF NRS 623.

2. THIS RECORD DRAWING HAS BEEN PREPARED IN PART, BASED UPON INFORMATION FURNISHED BY THE GENERAL CONTRACTOR, WHILE THIS INFORMATION IS BELIEVED TO BE RELIABLE, THE DESIGN PROFESSIONAL CANNOT ASSURE ITS ACCURACY, AND THIS IS NOT RESPONSIBLE FOR THE ACCURACY OF THIS RECORD DRAWING OR FOR ANY ERRORS OR OMISSIONS WHICH MAY HAVE BEEN INCORPORATED INTO IT AS A RESULT. THE DESIGN PROFESSIONAL CANNOT AND DOES NOT WARRANT THEIR ACCURACY.

3. INFORMATION THAT MAY BE INCLUDED WOULD BE SIGNIFICANT CHANGES TO PLANTING OR IRRIGATION LAYOUT PLANS AND ASSOCIATED DRAWINGS, MINOR DIMENSION OR CONSTRUCTION DETAIL CHANGES MAY NOT BE INCLUDED.

RECORD DRAWING 1-10-08

THIS SEAL PERTAINS ONLY TO THE MATERIALS SUPPLIED BY POLYGON.
THIS SEAL DOES NOT SERVE AS - OR REPRESENT - THE PROJECT ENGINEER OF RECORD AND SHALL NOT BE CONSTRUED AS SUCH.