



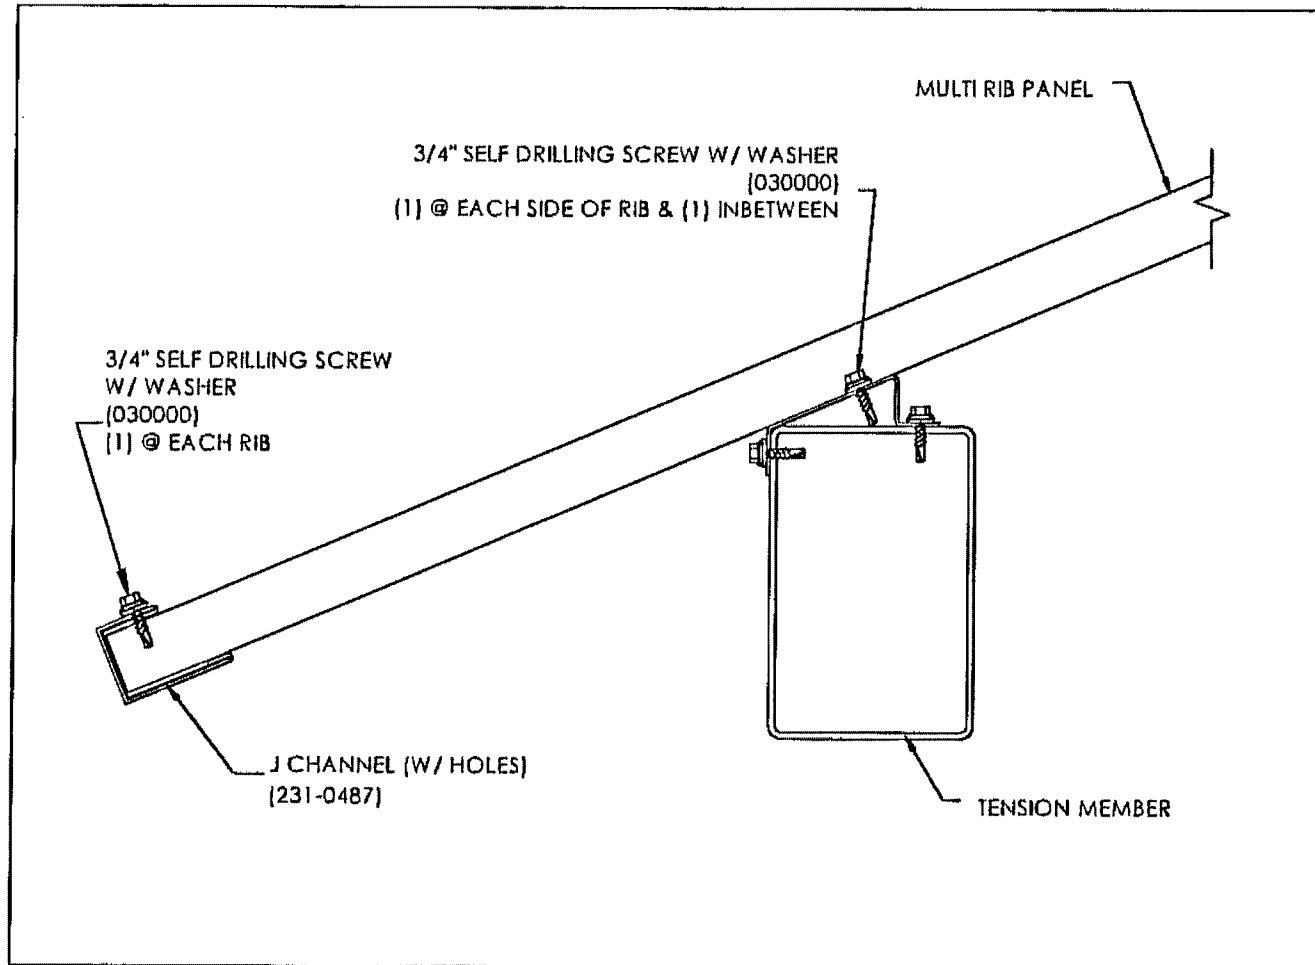


SECTION @ EAVE

MR-100

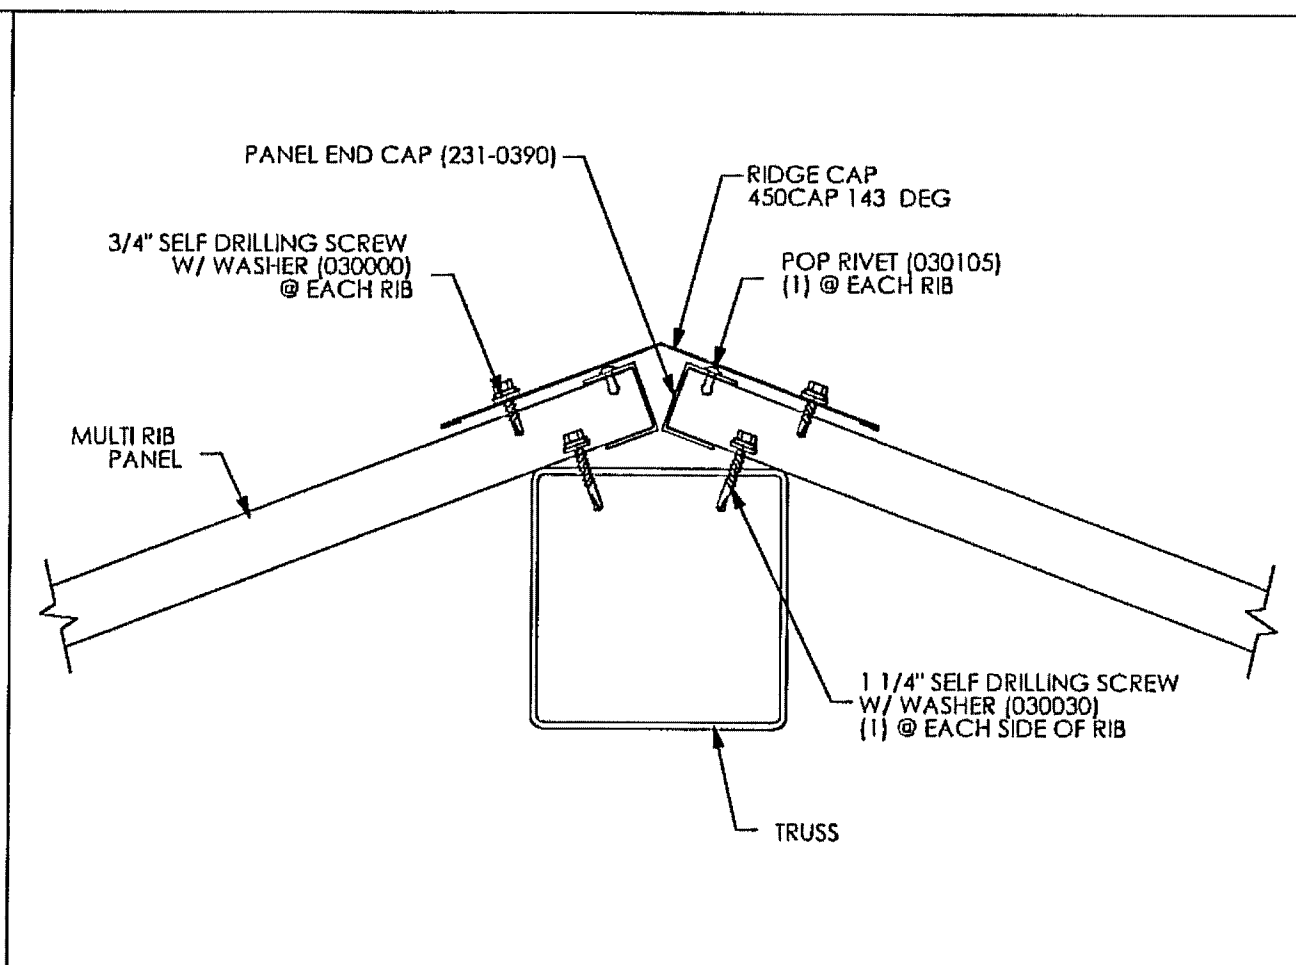


SECTION @ TRUSS

MR-300

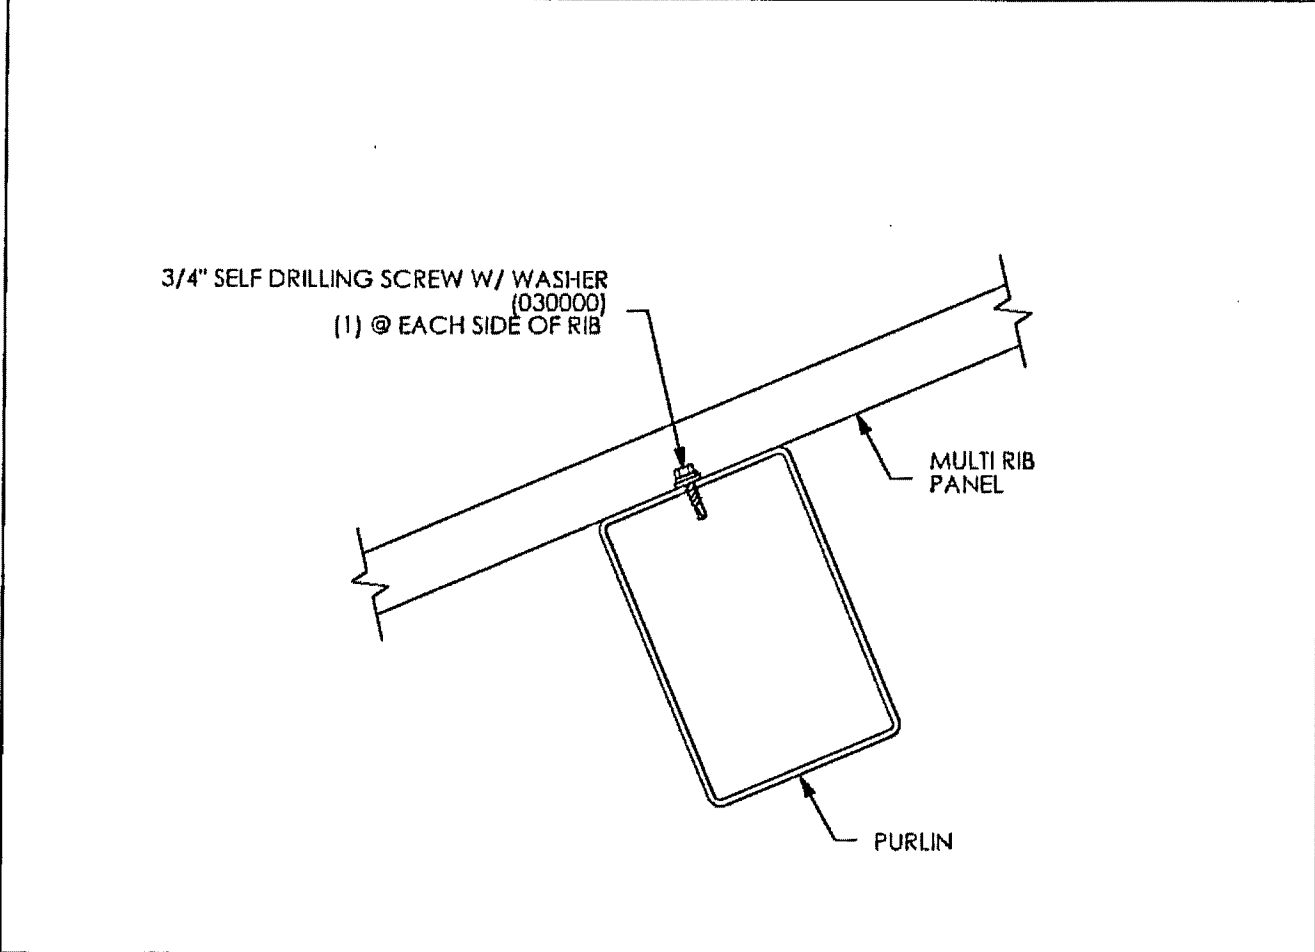

SECTION @ PURLIN

MR-600

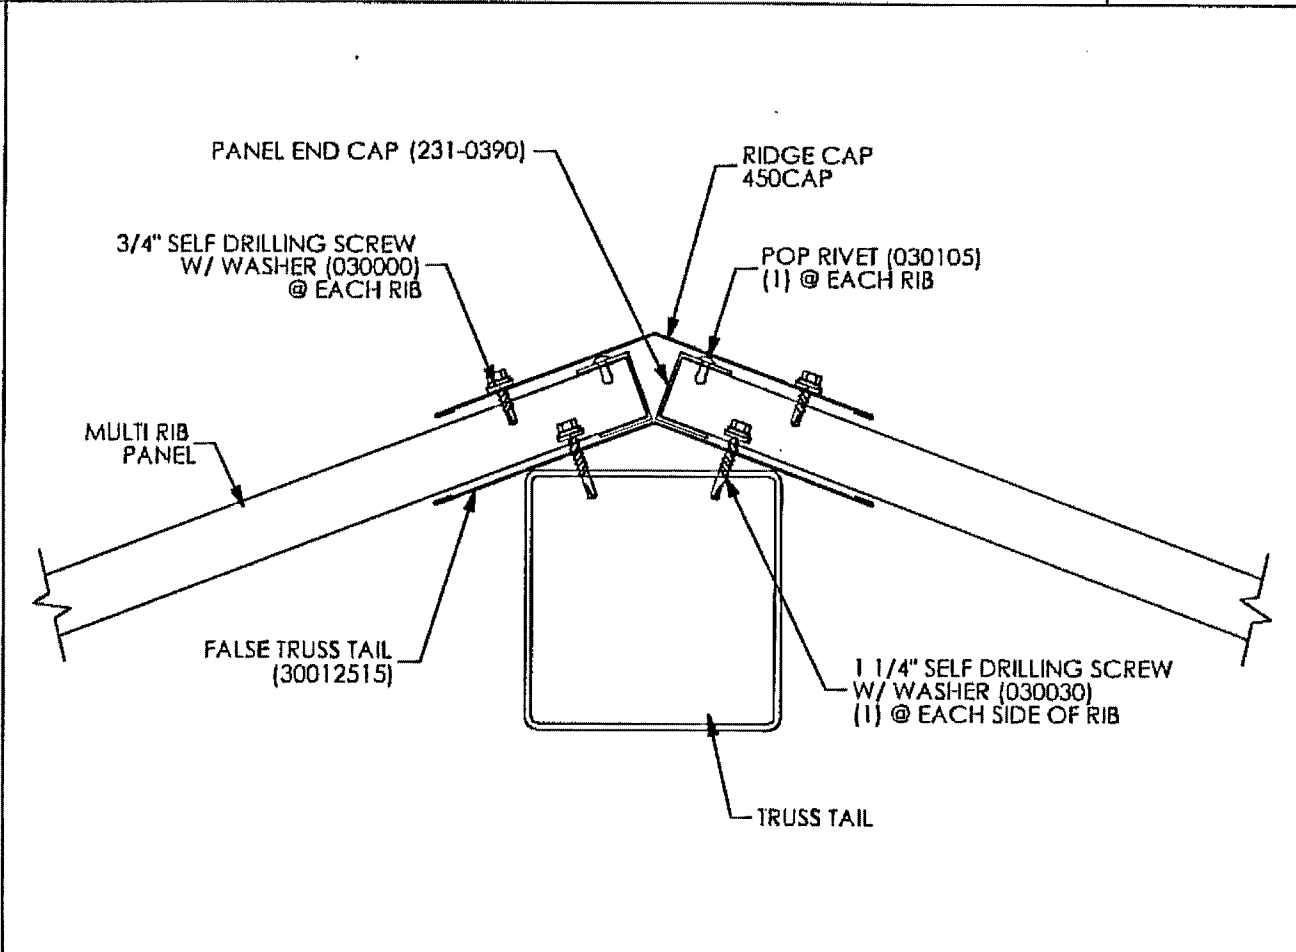

SECTION @ TRUSS TAIL

MR-800

NOTE:
ATTACH ROOF PEAK CAP TO RIBS &
RIDGE CAP WITH 3/4" SELF DRILLING
SCREW. (030030)

030000
#12-14x3/4" SELF DRILLING SCREW.

030030
#12-14x1 1/4" SELF DRILLING SCREW.
[NOTE: USE ONLY TO FASTEN ROOF AT THE RIDGE TO THE TRUSS OR RIDGE BEAM.]

030105
1/8"x" POP RIVET
USE TO ATTACH THE COVER PLATES.

NOTE:
ALL MATERIALS ARE CALLED
OUT ON SHEET 4.

**RECORD DRAWINGS
NOT FOR CONSTRUCTION**

1. TO ALTER THESE DOCUMENTS FOR ANOTHER PROJECT BY ANYONE OTHER THAN THE ORIGINAL ARCHITECT IS A VIOLATION OF NRS 623.

2. THIS RECORD DRAWING HAS BEEN PREPARED IN PART, BASED UPON INFORMATION FURNISHED BY THE GENERAL CONTRACTOR, WHILE THIS INFORMATION IS BELIEVED TO BE RELIABLE, THE DESIGN PROFESSIONAL CANNOT ASSURE ITS ACCURACY, AND THIS IS NOT RESPONSIBLE FOR THE ACCURACY OF THIS RECORD DRAWING OR FOR ANY ERRORS OR OMISSIONS WHICH MAY HAVE BEEN INCORPORATED INTO IT AS A RESULT. THE DESIGN PROFESSIONAL CANNOT AND DOES NOT WARRANT THEIR ACCURACY.

3. INFORMATION THAT MAY BE INCLUDED WOULD BE SIGNIFICANT CHANGES TO PLANTING OR IRRIGATION LAYOUT PLANS AND ASSOCIATED DRAWINGS, MINOR DIMENSION OR CONSTRUCTION DETAIL CHANGES MAY NOT BE INCLUDED.

RECORD DRAWING 7-0-08

PATENTED AND/OR PATENTS PENDING. COPYRIGHT 2006 PORTER CORP HOLLAND, MI 49424

PROJECT: LORENZI PARK
PROJECT LOCATION: LAS VEGAS, NV
DRAWING: ROOF CONNECTION DETAILS
SHEET: SS4.1

CREATION DATE: 4/14/2007
JOB NO: 43293
DRAWN BY: betbol
REV LEVEL: A14
PRINT DATE: 10/17/2007
SCALE: 1:64

poligon
800-354-7721
www.poligon.com
by PORTER CORP
PORTER CORP 4240 N. 136th AVE HOLLAND, MI 49424