


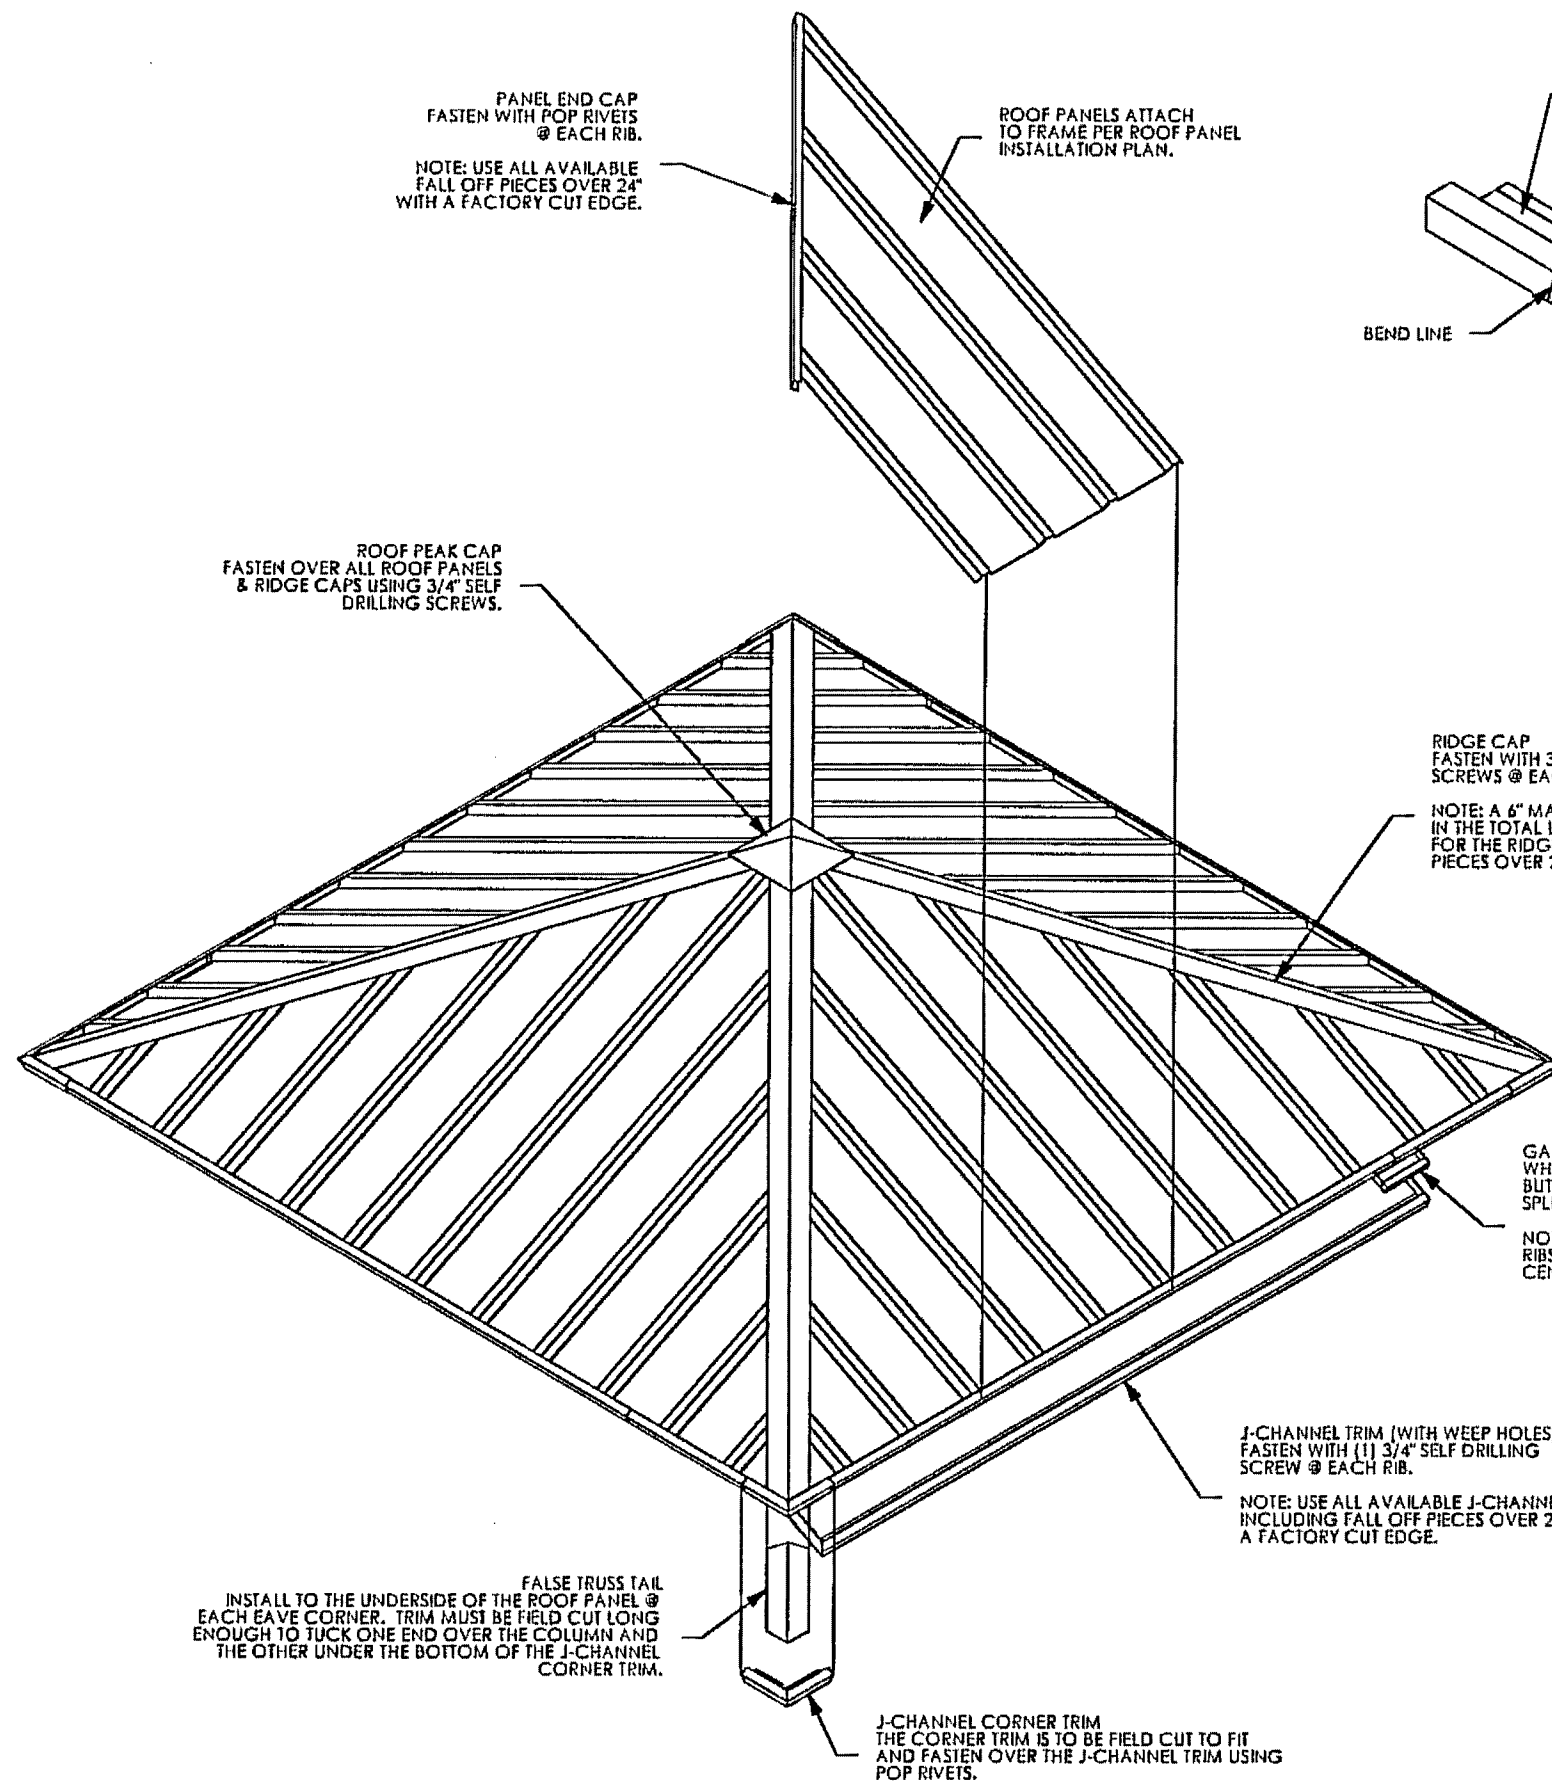
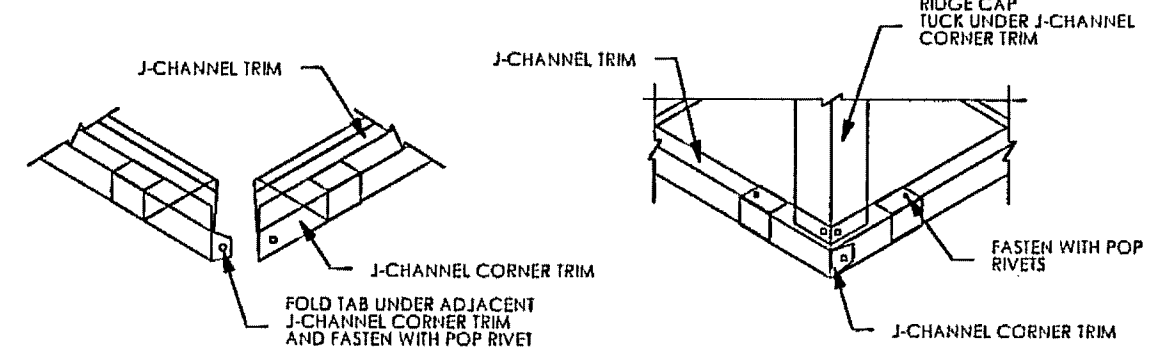
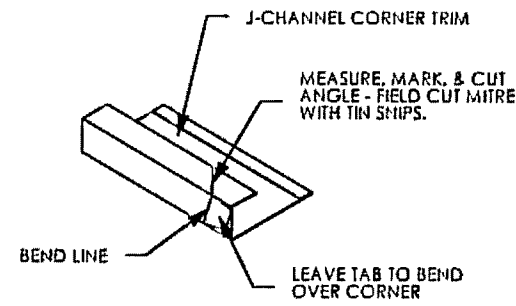
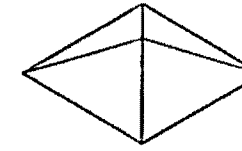
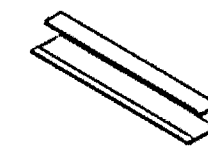
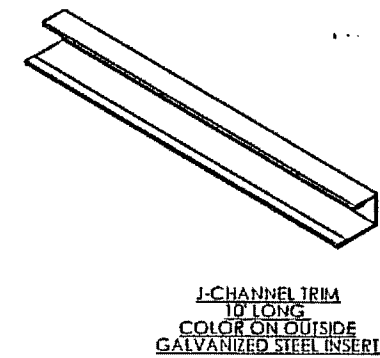
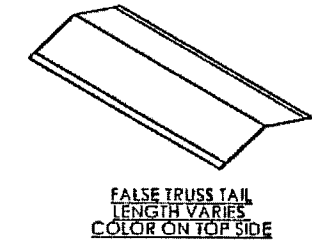


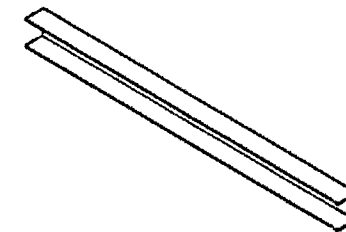

## J-CHANNEL CORNER TRIM CONNECTION DETAILS

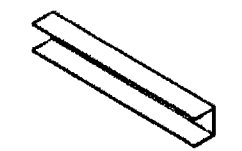

## TRIM PIECE DESCRIPTIONS

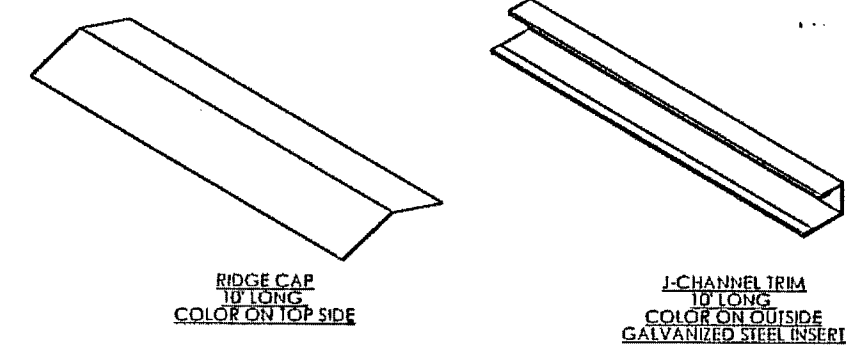

## RECORD DRAWINGS NOT FOR CONSTRUCTION

1. TO ALTER THESE DOCUMENTS FOR ANOTHER PROJECT BY ANYONE OTHER THAN THE ORIGINAL ARCHITECT IS A VIOLATION OF NRS 923.
2. THIS RECORD DRAWING HAS BEEN PREPARED IN PART, BASED UPON INFORMATION FURNISHED BY THE GENERAL CONTRACTOR, WHILE THIS INFORMATION IS BELIEVED TO BE RELIABLE, THE DESIGN PROFESSIONAL CANNOT ASSURE ITS ACCURACY, AND THIS IS NOT RESPONSIBLE FOR THE ACCURACY OF THIS RECORD DRAWING OR FOR ANY ERRORS OR OMISSIONS WHICH MAY HAVE BEEN INCORPORATED INTO IT AS A RESULT. THE DESIGN PROFESSIONAL CANNOT AND DOES NOT WARRANT THEIR ACCURACY.
3. INFORMATION THAT MAY BE INCLUDED WOULD BE SIGNIFICANT CHANGES TO PLANTING OR IRRIGATION LAYOUT PLANS AND ASSOCIATED DRAWINGS, MINOR DIMENSION OR CONSTRUCTION DETAIL CHANGES MAY NOT BE INCLUDED.

RECORD DRAWING 7-10-08

NOTE: REMOVE ALL PROTECTIVE PLASTIC FROM TRIM PARTS BEFORE INSTALLING.

NOTE: FOR SECTION VIEWS OF THE ROOF, REFER TO THE ROOF CONNECTION DETAIL SHEET.

**poligon**  
ARCHITECTURE  
800-354-7721  
www.poligon.com

by **PORTERCORP**  
PORTERCORP 4240 N. 136th AVE HOLLAND, MI 49424

|                |            |            |        |         |       |
|----------------|------------|------------|--------|---------|-------|
| PRINT DATE:    | 10/17/2007 | DRAWN BY:  | betbol | SCALE:  | 1:64  |
| CREATION DATE: | 4/14/2007  | REV LEVEL: | A14    | JOB NO: | 43293 |

PROJECT: LORENZI PARK

PROJECT LOCATION: LAS VEGAS, NV

CAD MODEL: SQR-50MR-B1-43293

DRAWING: ROOF INSTALLATION

SHEET

**SS4.2**