

GENERAL NOTES:

1. ALL CIRCUIT NUMBERS CORRESPOND TO PANEL-H4, U.N.O.
2. ALL CONDUIT IS 1-1/4" IW (2)#3 & (1)#3 CU GRD., U.N.O.



KEY NOTES:

- ① 1-1/4" CW (3)#6 & (1)#6 CU GRD.
- ② 1-1/4" CW (2)#4 & (1)#4 CU GRD.

**RECORD DRAWINGS
NOT FOR CONSTRUCTION**

1. TO ALTER THESE DOCUMENTS FOR ANOTHER PROJECT BY ANYONE OTHER THAN THE ORIGINAL ARCHITECT IS A VIOLATION OF NRS 623.
2. THIS RECORD DRAWING HAS BEEN PREPARED IN PART, BASED UPON INFORMATION FURNISHED BY THE GENERAL CONTRACTOR. WHILE THIS INFORMATION IS BELIEVED TO BE RELIABLE, THE DESIGN PROFESSIONAL CANNOT ASSURE ITS ACCURACY, AND THIS IS NOT RESPONSIBLE FOR THE ACCURACY OF THIS RECORD DRAWING OR FOR ANY ERRORS OR OMISSIONS WHICH MAY HAVE BEEN INCORPORATED INTO IT AS A RESULT. THE DESIGN PROFESSIONAL CANNOT AND DOES NOT WARRANT THEIR ACCURACY.
3. INFORMATION THAT MAY BE INCLUDED WOULD BE SIGNIFICANT CHANGES TO PLANTING OR IRRIGATION LAYOUT PLANS AND ASSOCIATED DRAWINGS, MINOR DIMENSION OR CONSTRUCTION DETAIL CHANGES MAY NOT BE INCLUDED.

ENGINEER OF RECORD HAS PERFORMED ALL REQUIRED VOLTAGE DROP CALCULATIONS WITHIN THE SCOPE OF THIS PROJECT.

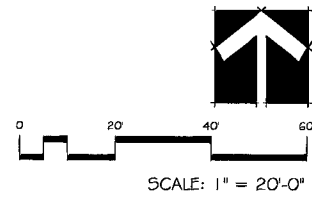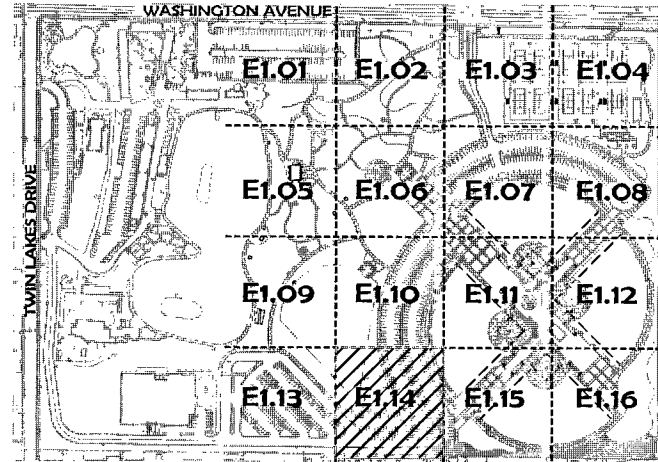

119356

REVISIONS	7-19-09 Record Drawing
CONSULTANT	Professional Design Associates, Inc. Electrical and Mechanical Engineers 20 West Street, Henderson, NV 89009 (702) 587-1022 Fax: (702) 587-1025 email: pdainc@pdainc.com website: www.pdainc.com
PROJECT	PDIA Project No. 20049
Lorenzi Park Renovations Phase 1 ELECTRICAL PLAN	
OWNER:	CITY OF LAS VEGAS DEPARTMENT OF PUBLIC WORKS ARCHITECTURAL SERVICES
ADDRESS:	400 EAST STEWART AVENUE LAS VEGAS, NEVADA 89101
PHONE:	(702) 229-8525
FAX:	(702) 384-8846
TITLE:	06-083
DATE:	JUNE 2007
SCALE:	AS SHOWN
SHEET NO:	E1.14