




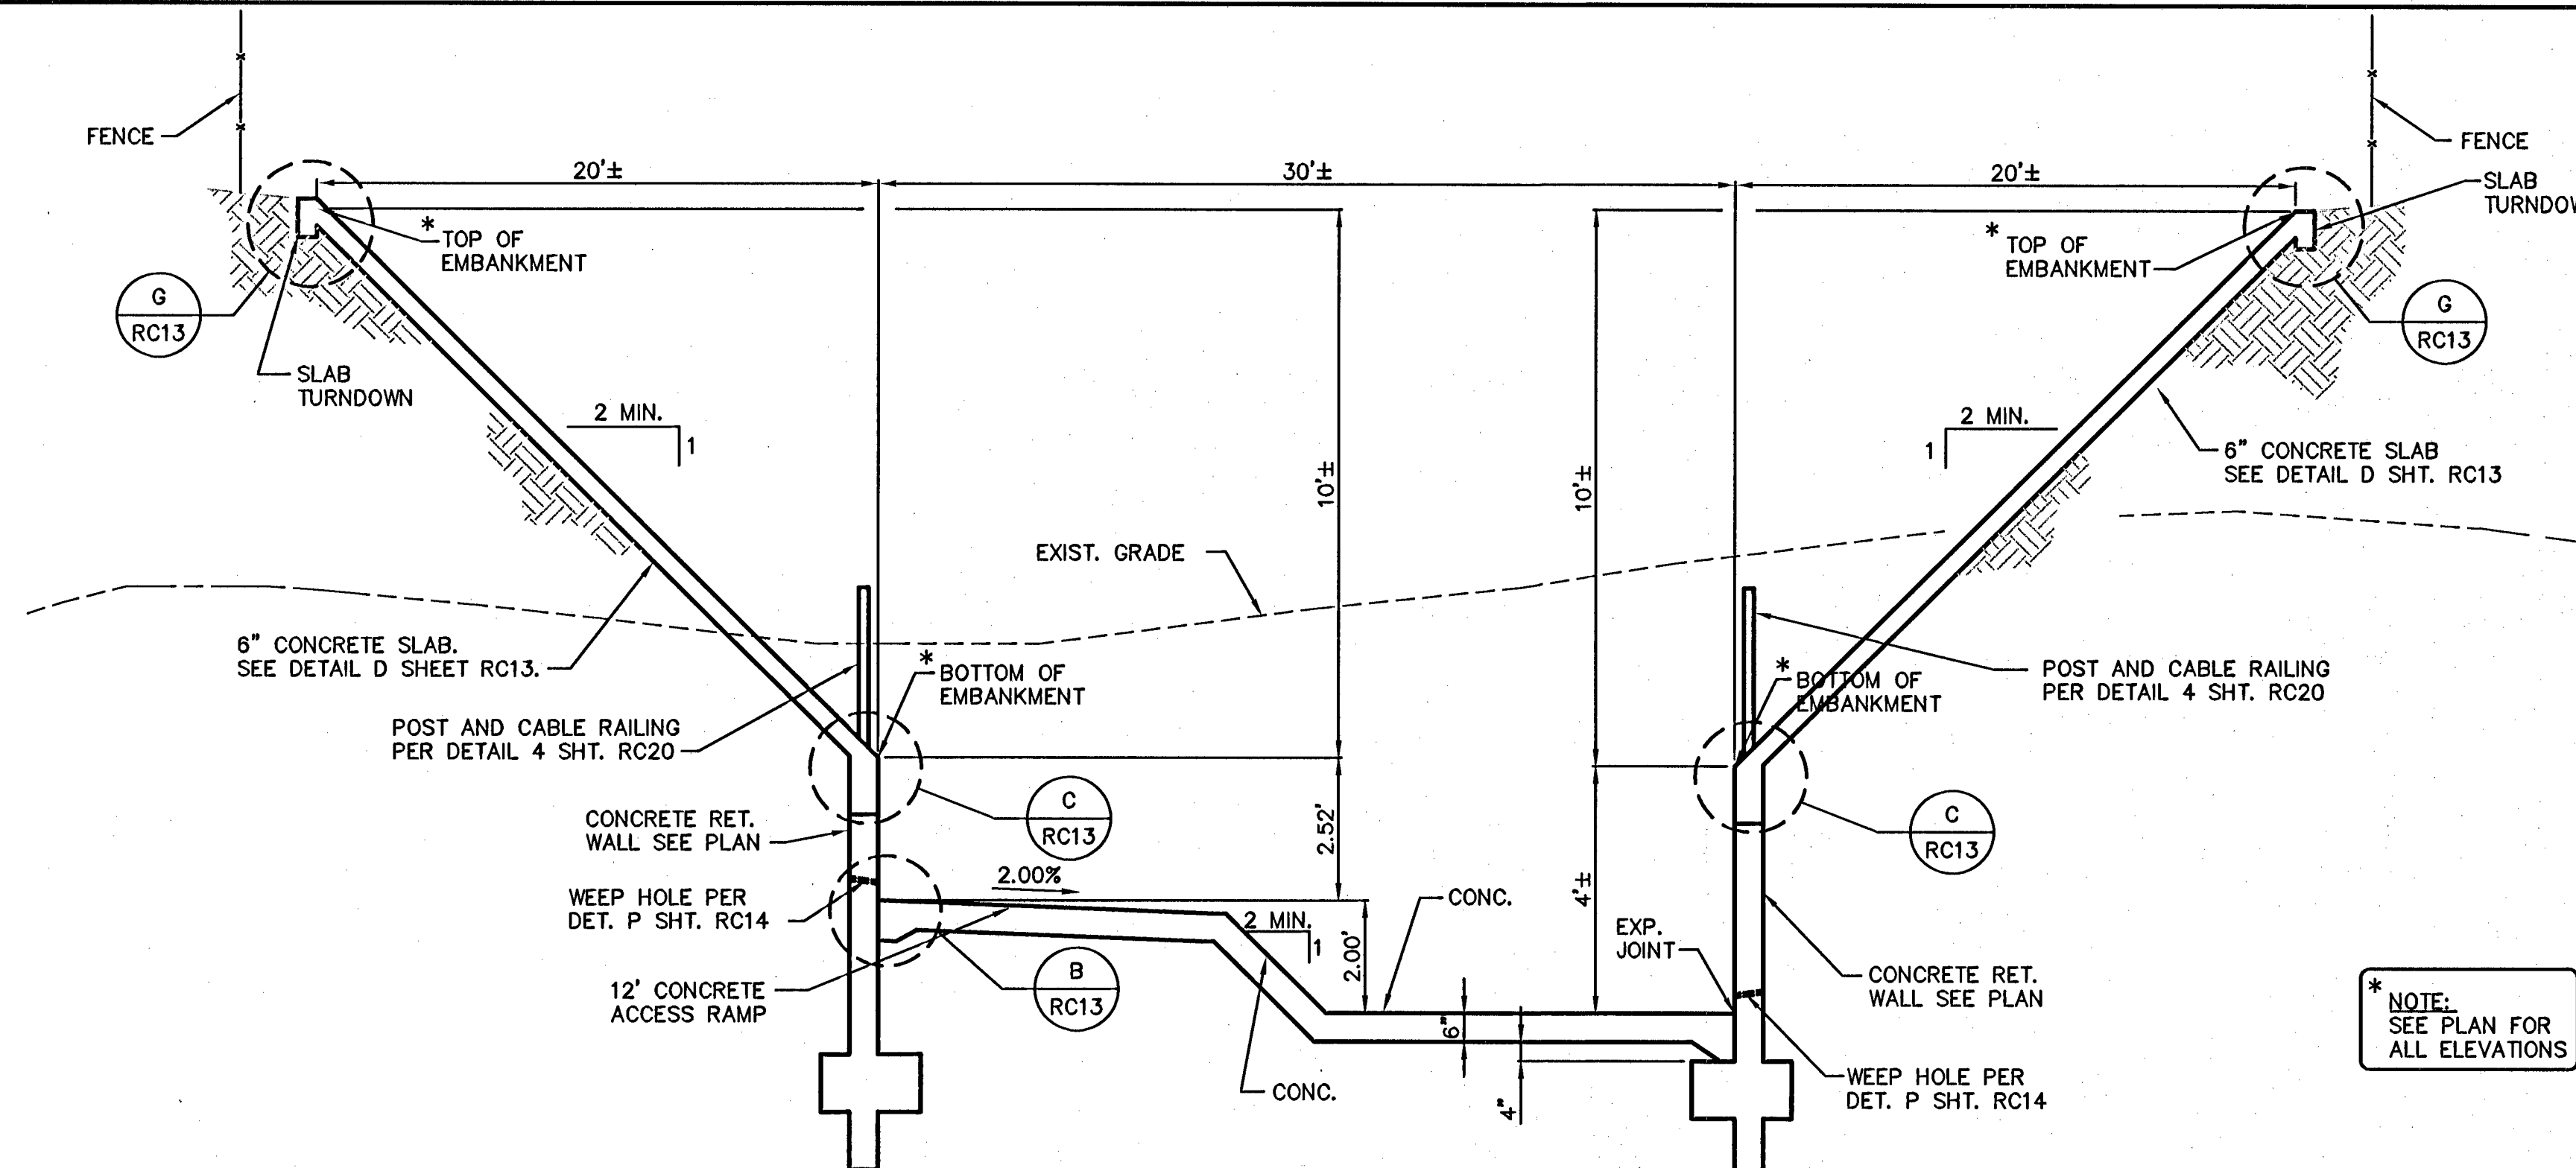


8 SECTION

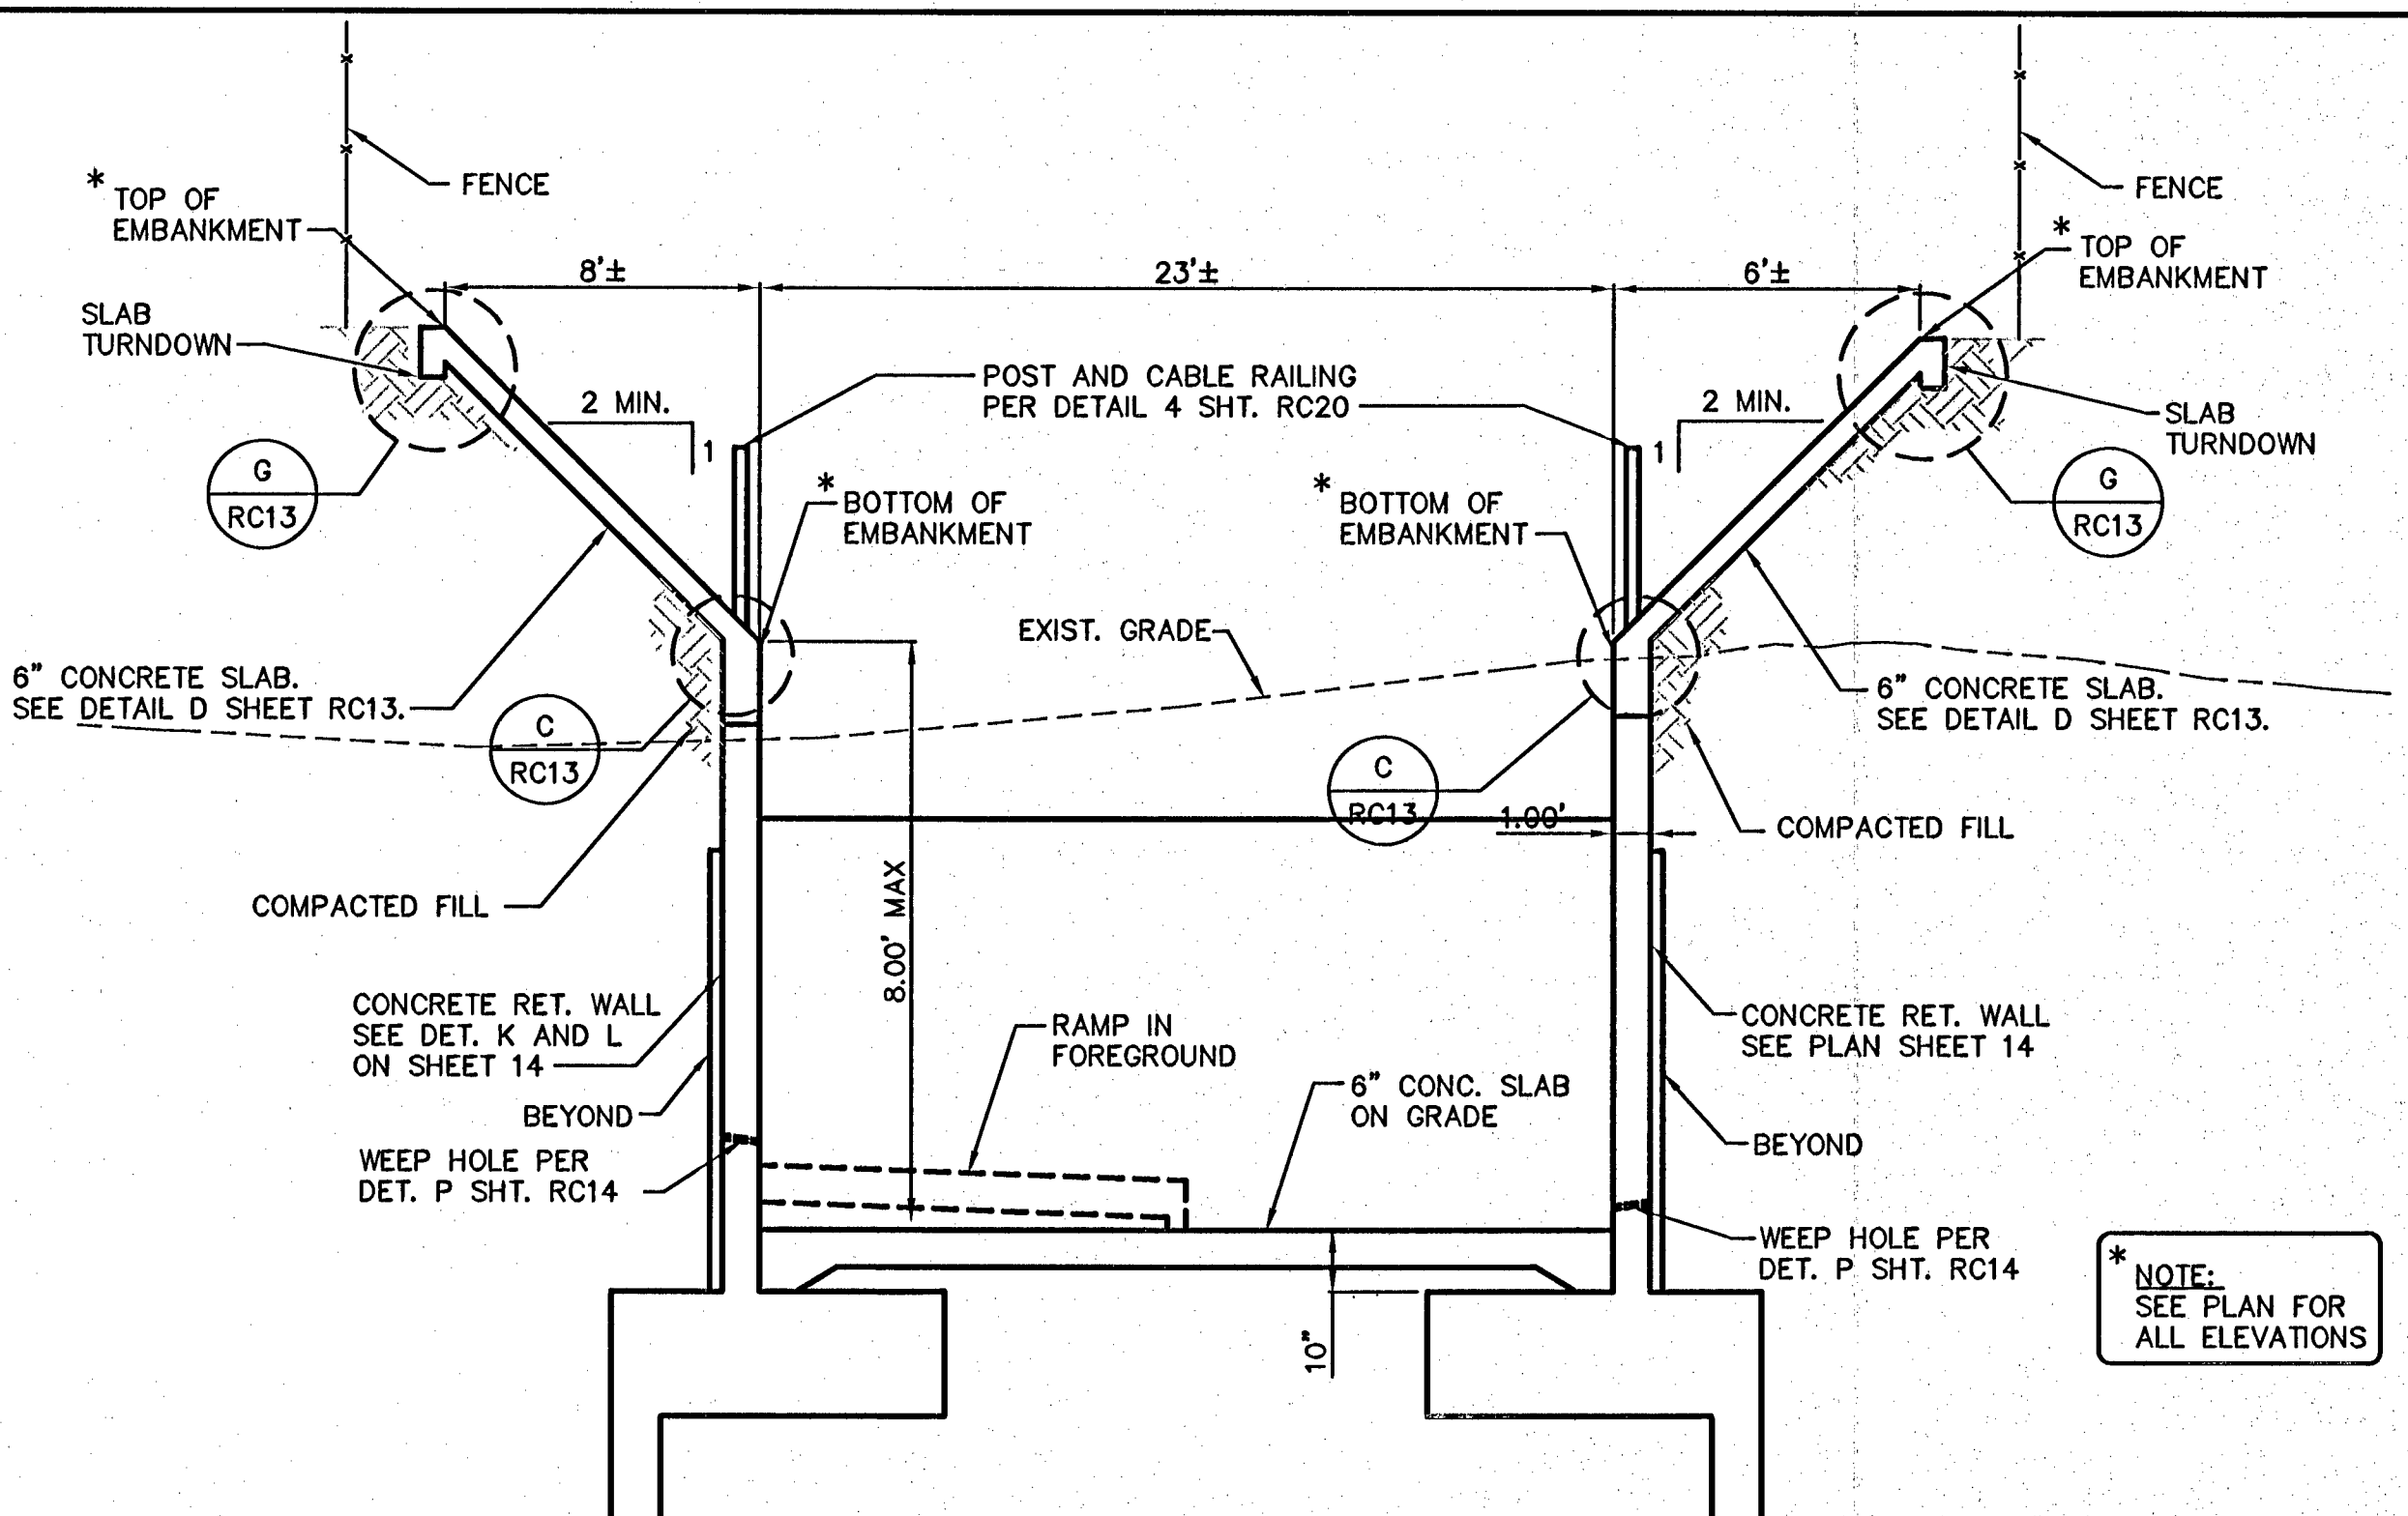


9 SECTION

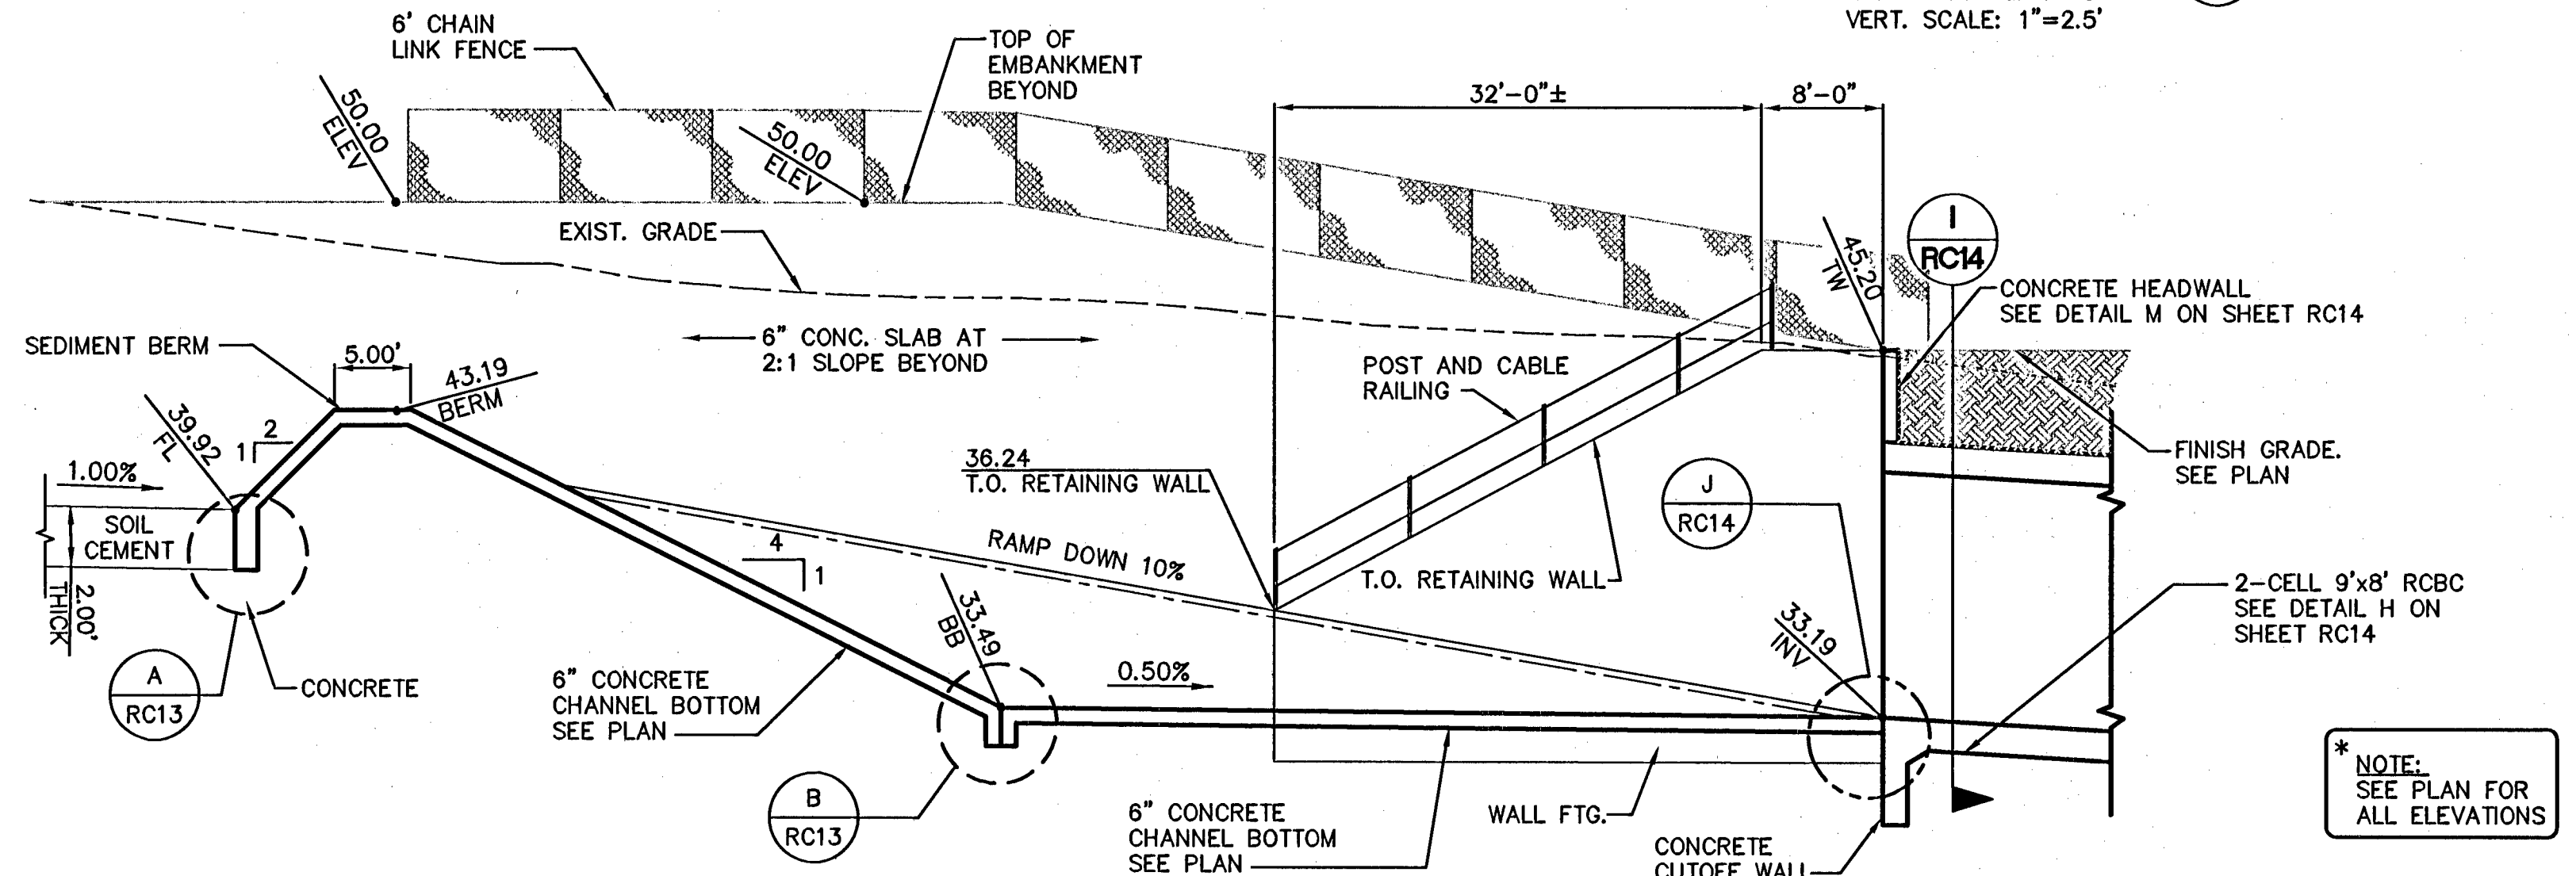

10 SECTION

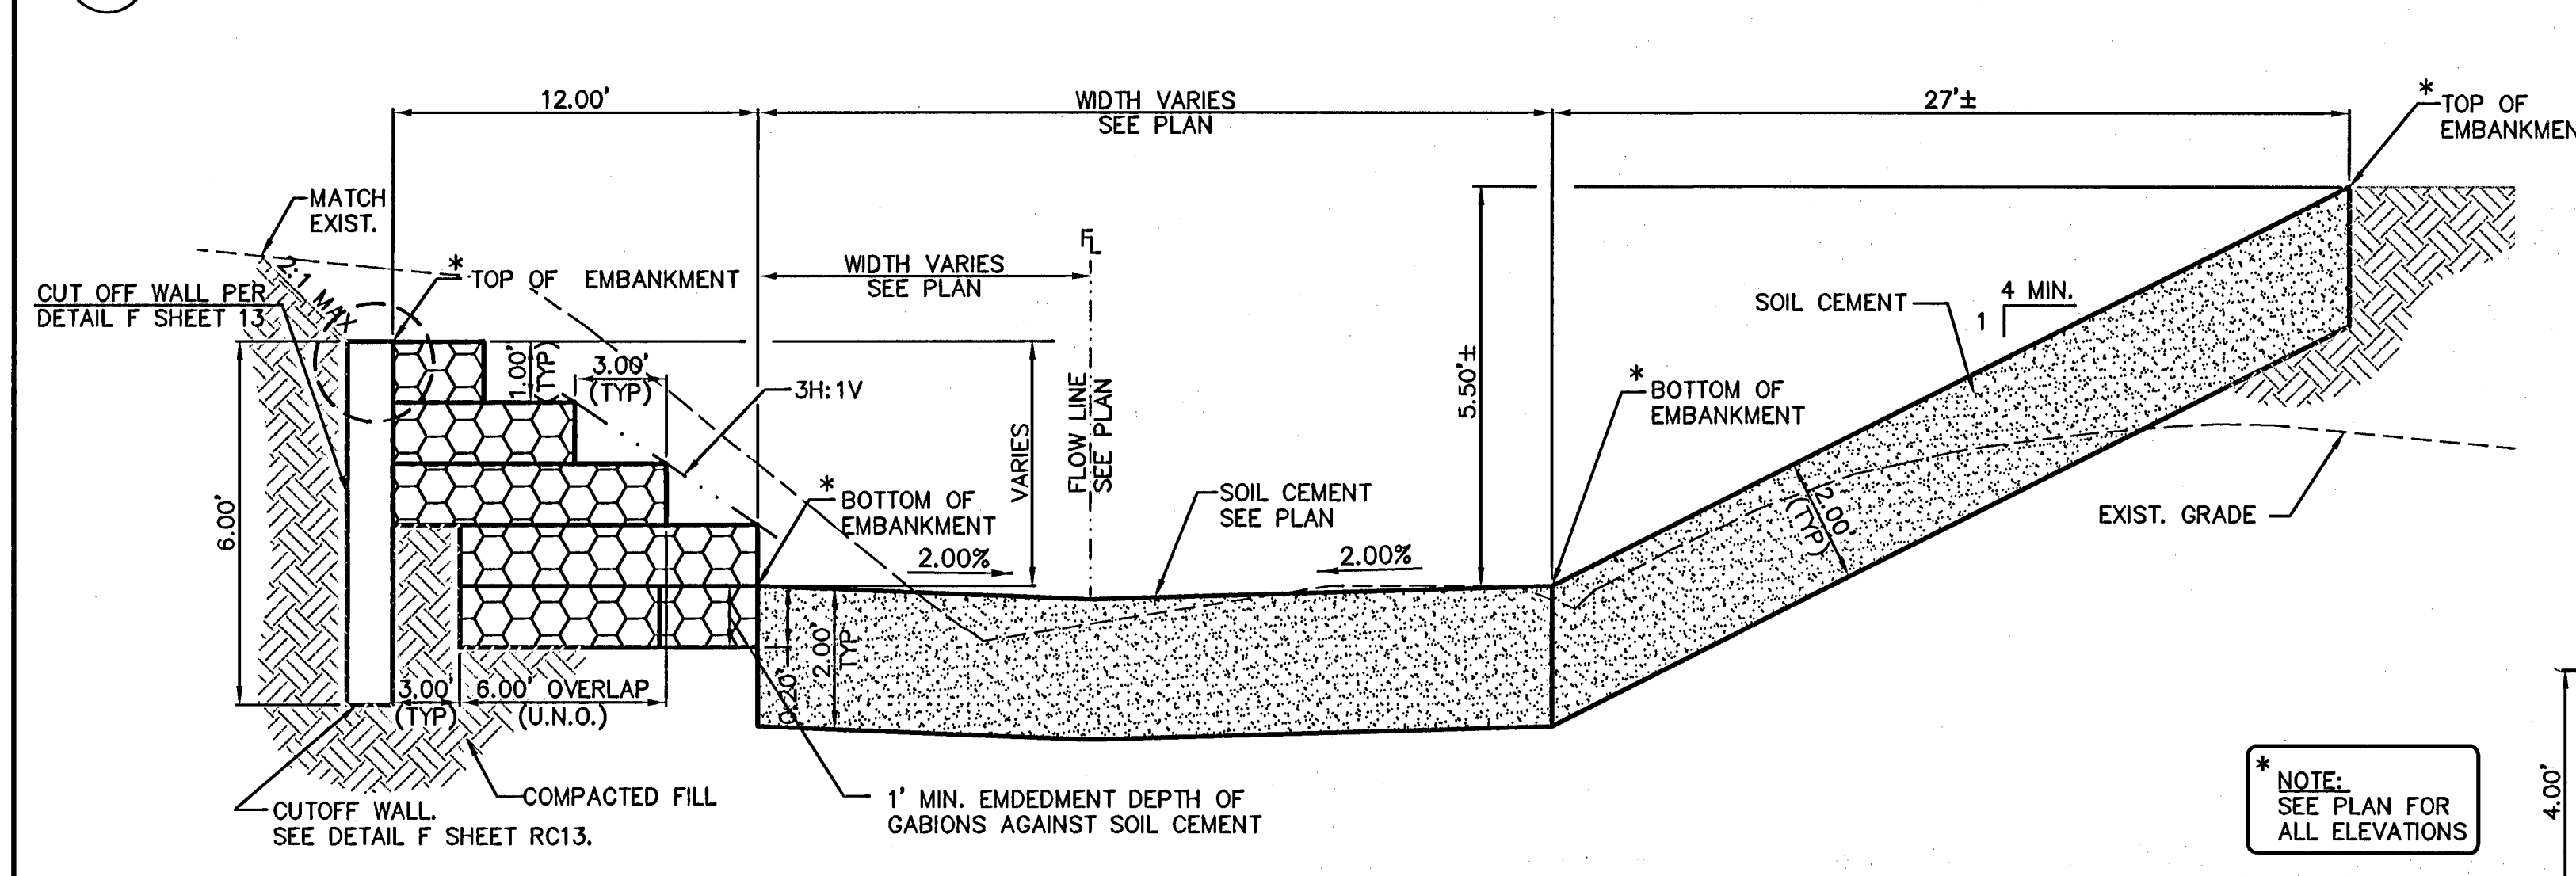

11 SECTION

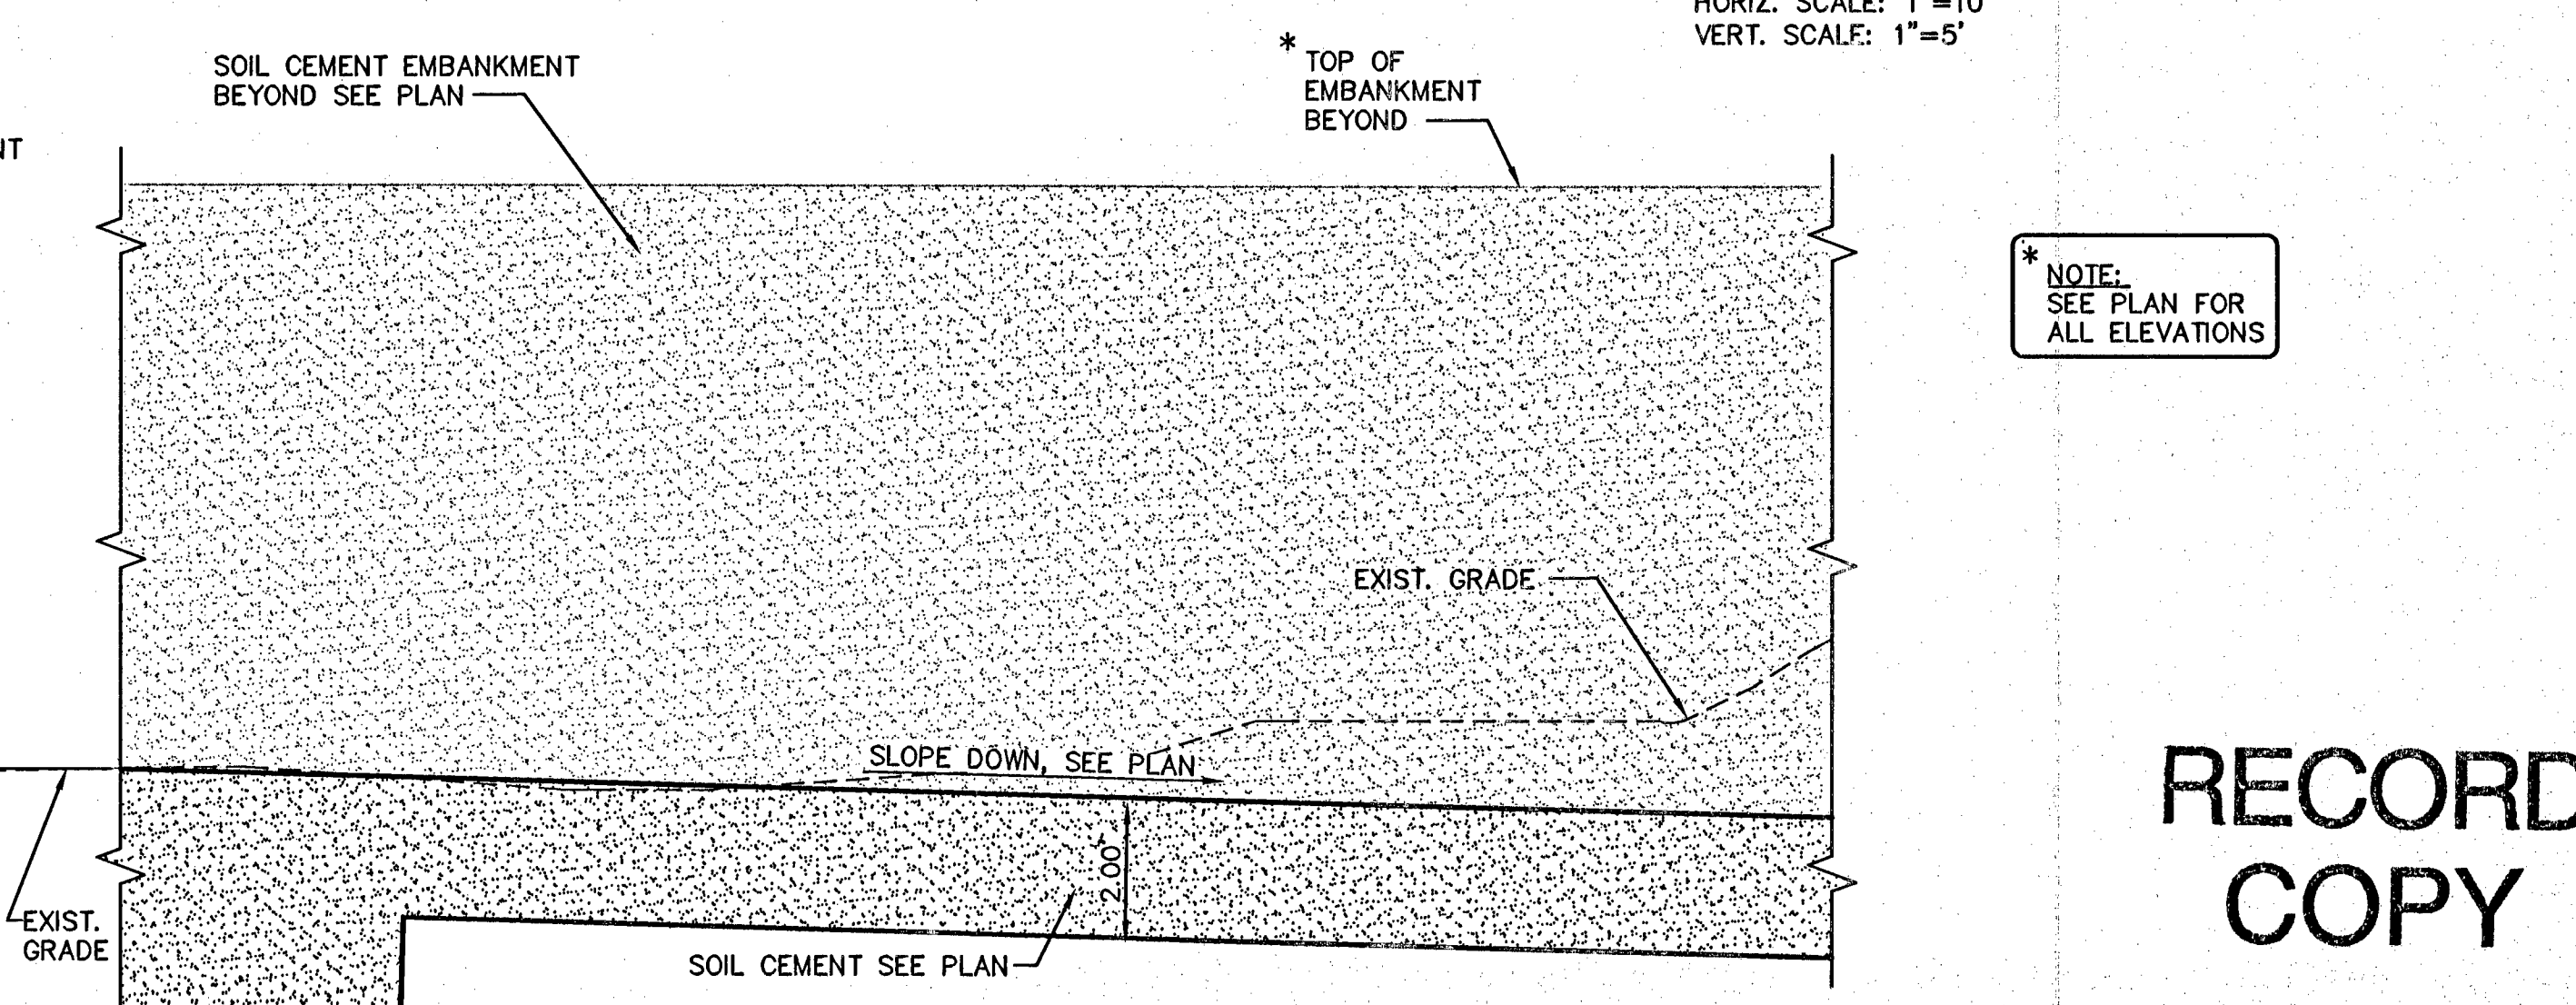

12 SECTION

RECORD COPY

Call before you Dig
593-6111
1-800-227-2600

CITY OF LAS VEGAS 400 STEWART AVENUE LAS VEGAS, NEVADA		SHEET TITLE: CHANNEL CROSS SECTIONS		PROJECT: GOWAN LONE MOUNTAIN SYSTEM BRANCH 4	
REV	DATE	BY	REVISION	Drawn by: AP	04/20/2007
				Designed by: BS	04/20/2007
				Checked by: SAP	04/20/2007
				Project No.: 404085-A001	Scale: NONE
Professional Engineer - State of Nevada No. 3218 STUART A. POWELL Exp. 12-31-07 CIVIL		SHEET RC 10		DRAWING NO. 650-94	

BID NO. 05.15341.13 #C-0246-05