


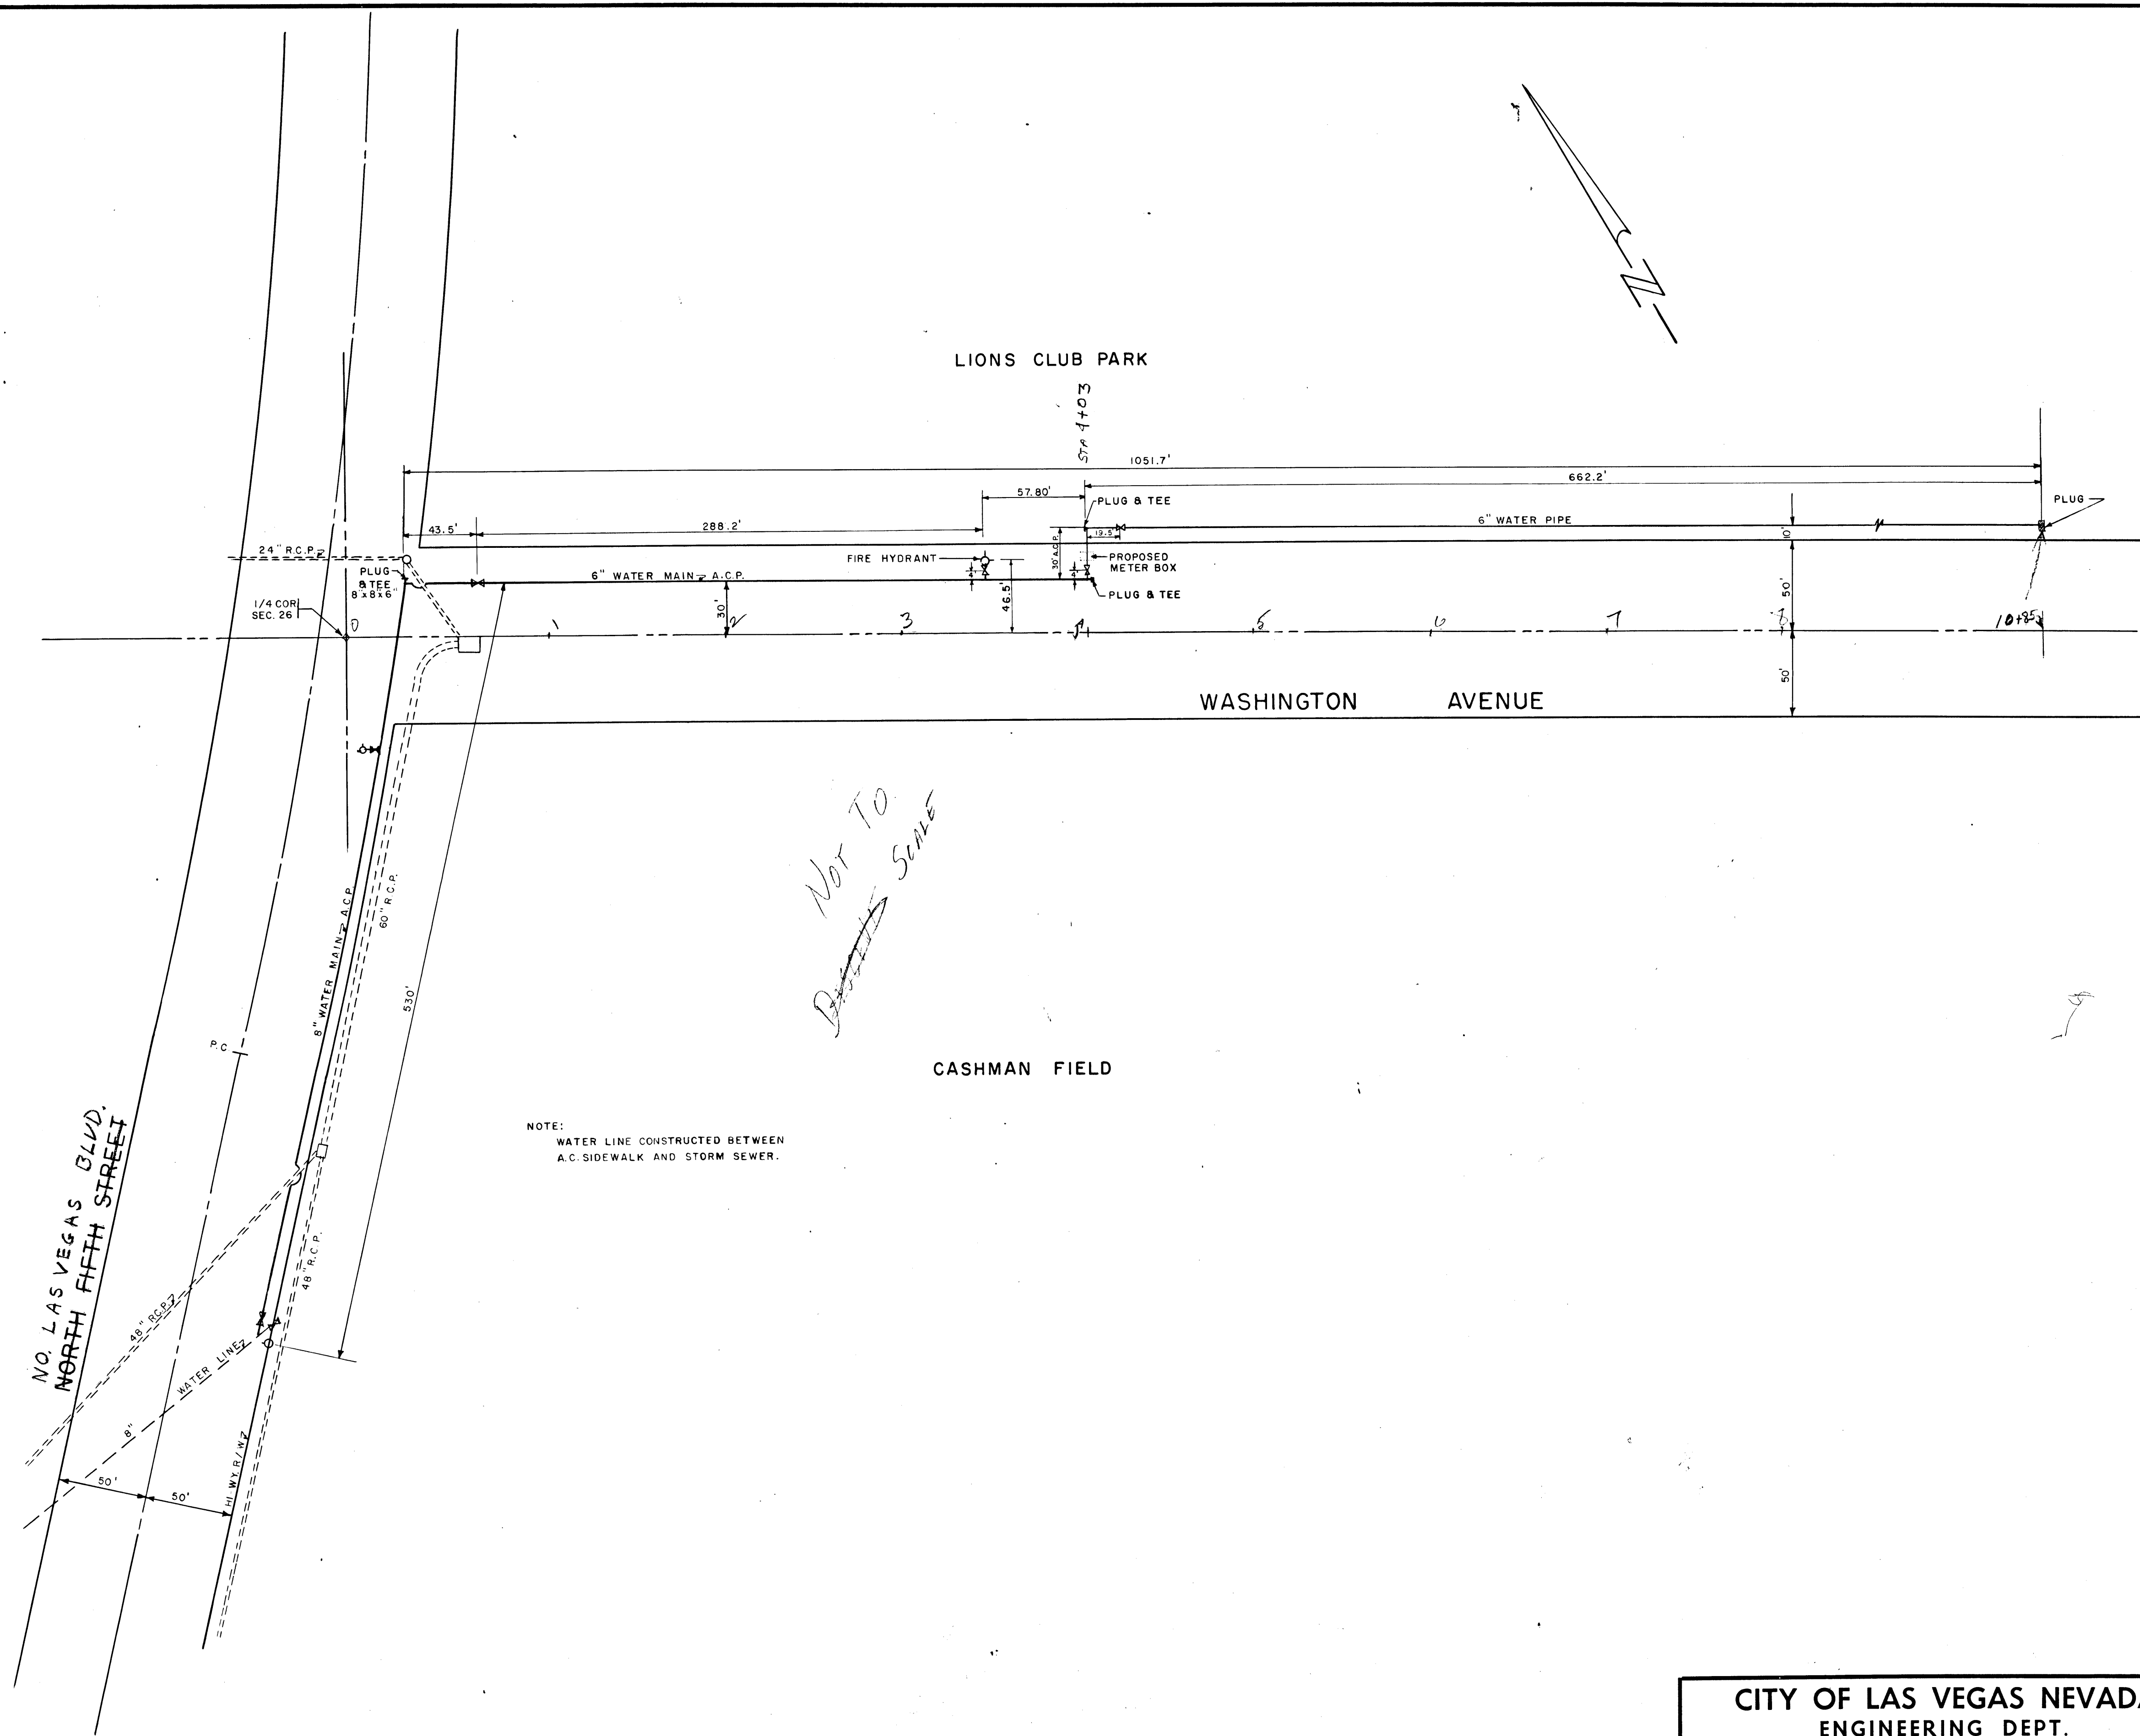

Not To  
Be Used  
Scale

NOTE:  
WATER LINE CONSTRUCTED BETWEEN  
A.C. SIDEWALK AND STORM SEWER.

8-48

| CITY OF LAS VEGAS NEVADA<br>ENGINEERING DEPT. |        |                      |
|-----------------------------------------------|--------|----------------------|
| LIONS CLUB PARK WATER LINES<br>(AS BUILT)     |        |                      |
| DESIGNED BY                                   | DATE   | SCALE 1"= 50'        |
| DRAWN BY L. HARPER                            | 4-8-59 | FIELD BOOK NO. 56-21 |
| CHECKED BY                                    |        | WORK ORDER NO.       |
| APPROVED                                      |        | DRAWING NO.          |
| CITY ENGR. <i>P. P. Hauer</i>                 |        | 650.9-W14            |