


100-143

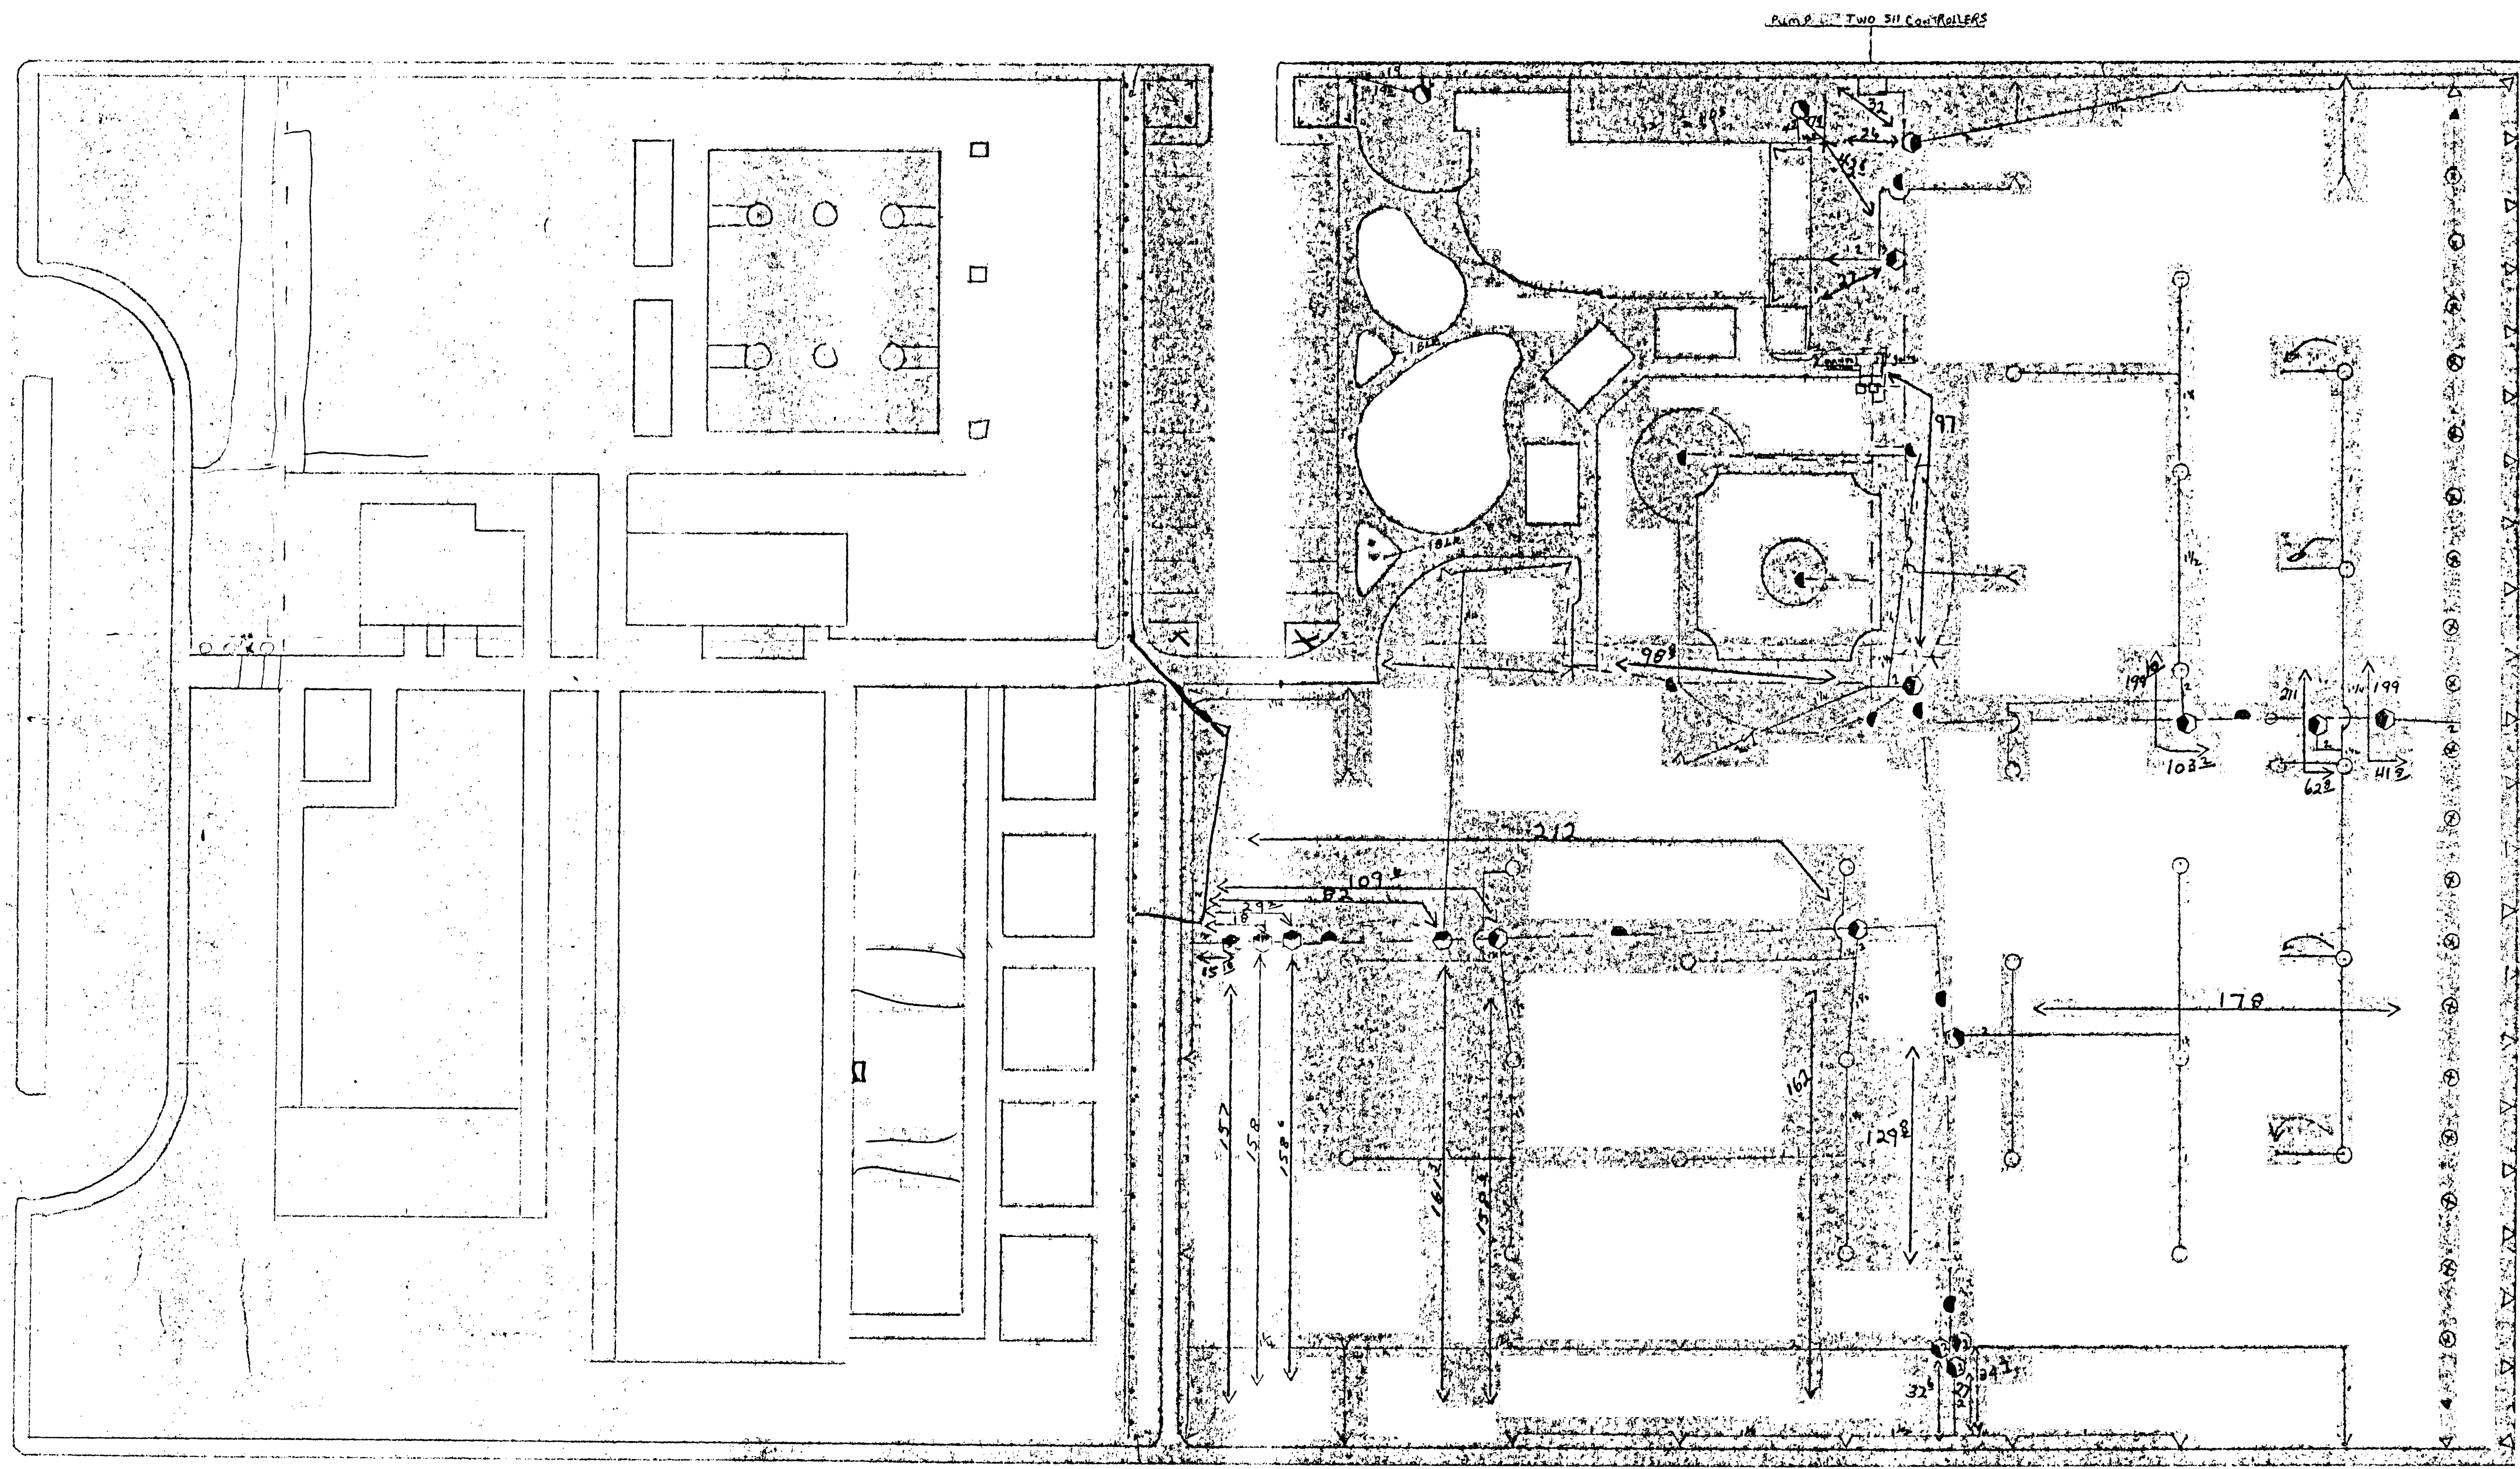

AS-BUILT SPRINKLER SYSTEM
KIT CARSON HIGH

SCALE: 1/32	APPROVED BY:	DRAWN BY:
DATE:	REVISION:	REVISION:
SPRINKLERS		
KIT CARSON		