


CITY OF LAS VEGAS NEVADA

LAMB BOULEVARD TRUNK SEWER


1962

SHEET NO.	INDEX DESCRIPTION
1	TITLE SHEET.
2	PLAN & PROFILE, LAMB BLVD., CHARLESTON BLVD. TO STA. 22+00.
3	PLAN & PROFILE, LAMB BLVD. FROM STA. 22+00 TO STA. 44+80.
4	PLAN & PROFILE, LAMB BLVD. STA. 44+80 TO STA. 53+24.95 AND WEST ON BONANZA ROAD FROM STA. 53+24.95 TO STA. 65+40.
5	PLAN & PROFILE NORTH ON 1/16th SECTION LINE FROM STA. 65+40 TO STA. 87+80.
6	PLAN & PROFILE NORTH ON 1/16th SECTION LINE FROM STA. 87+80 TO WASHINGTON AVE., THENCE WESTERLY TO SANDHILL ROAD.
7	DETAILS.

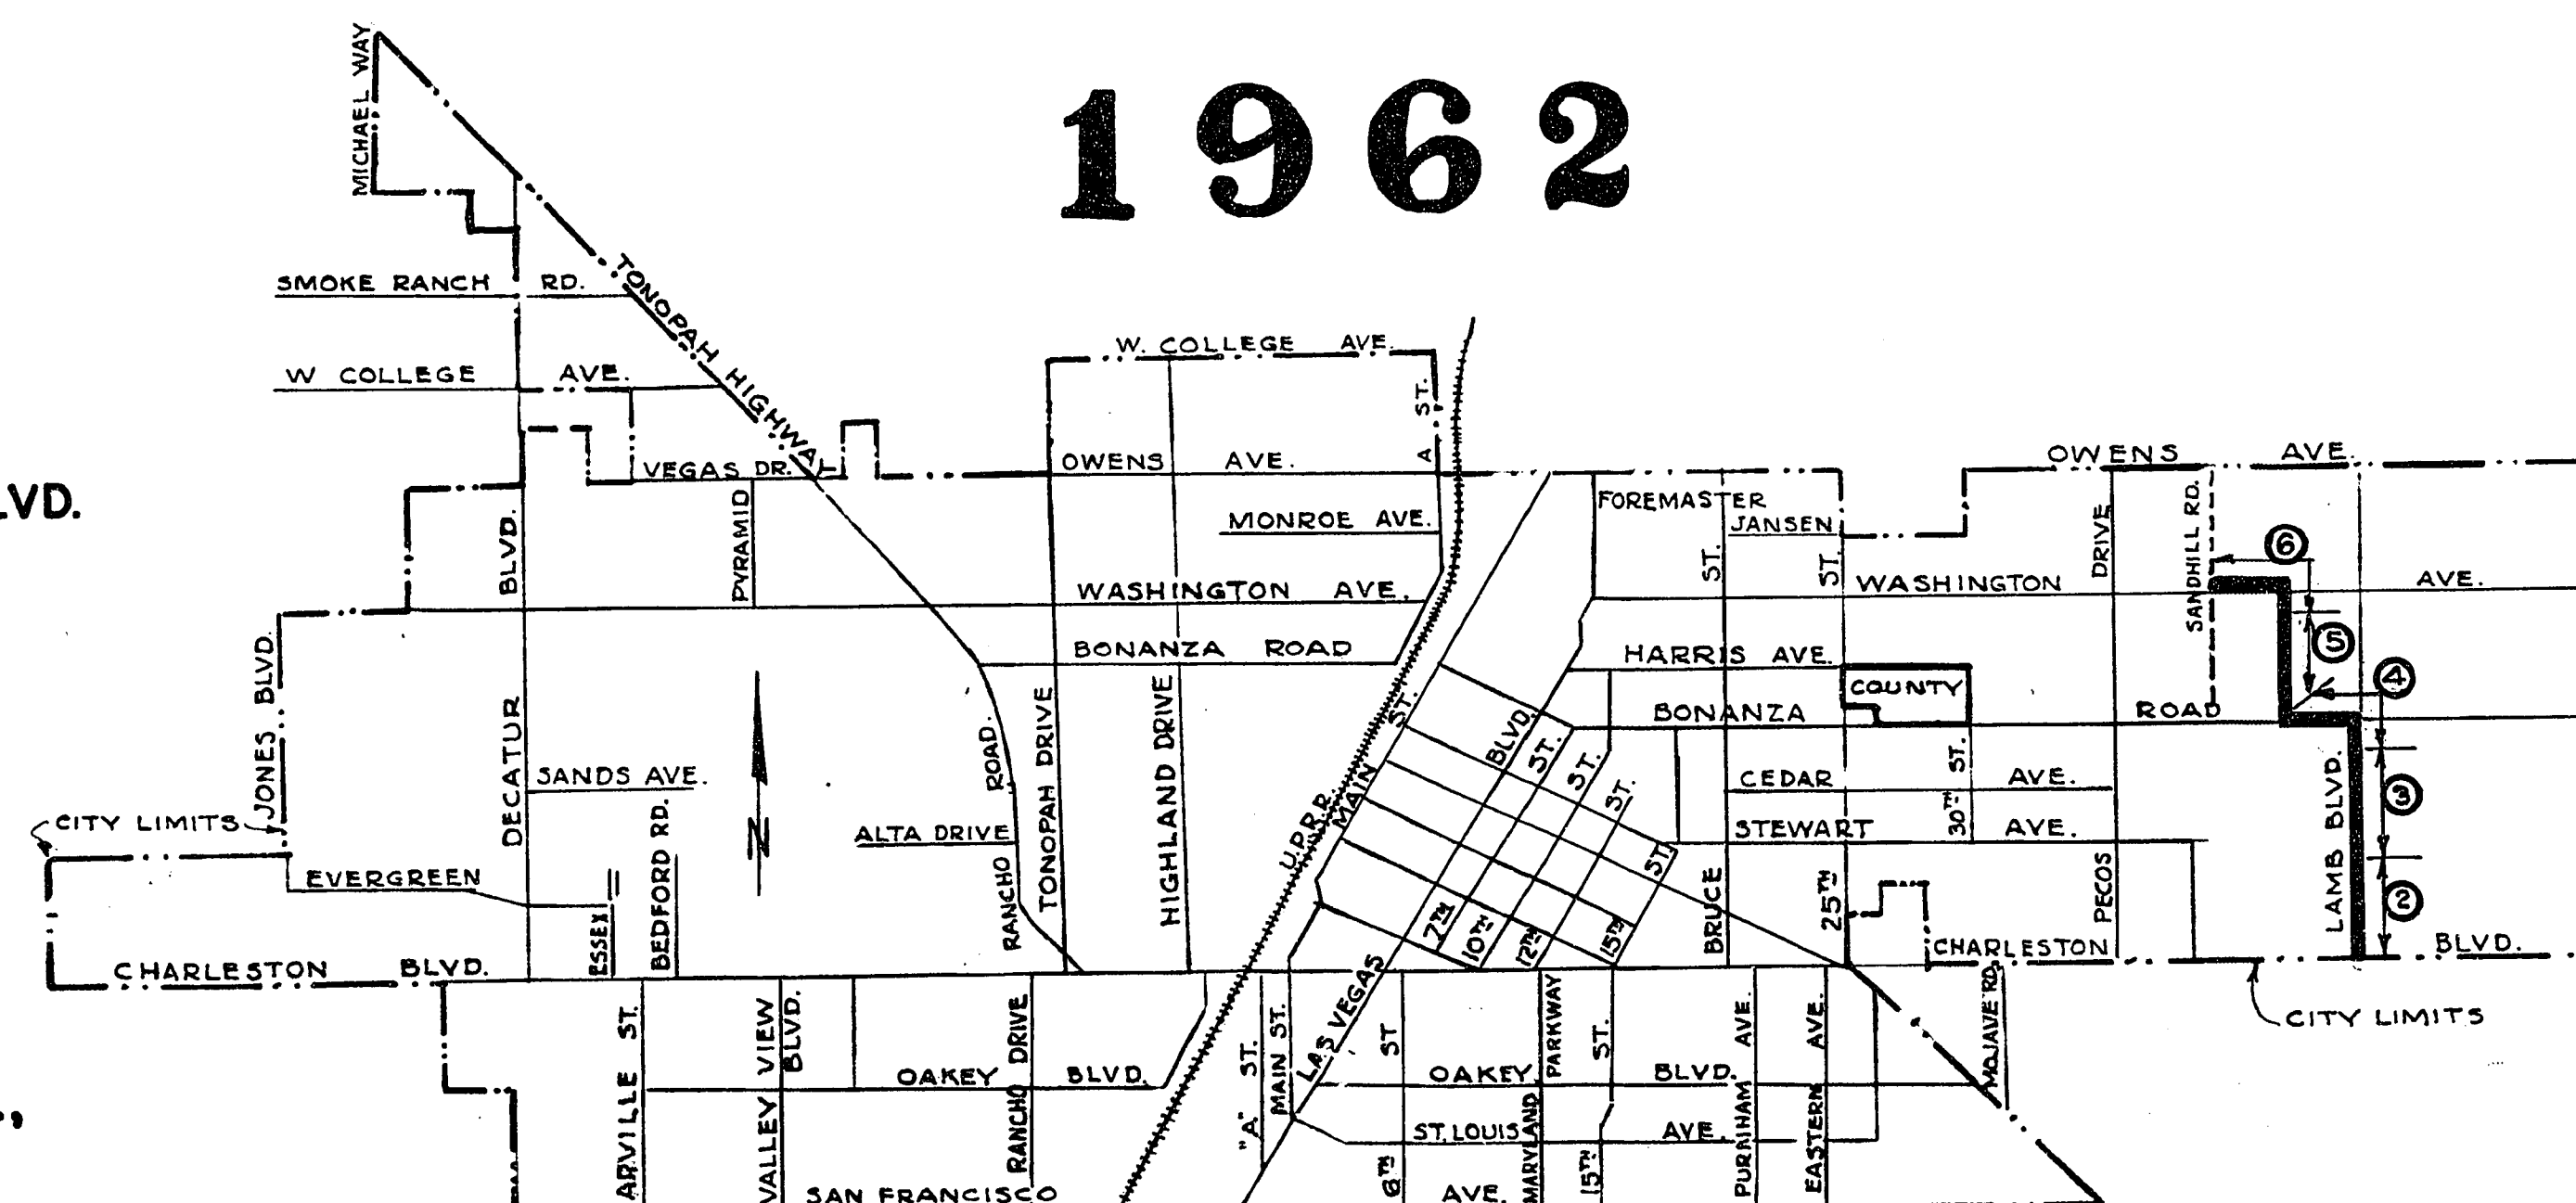

Not to Scale
KEY MAP

JOHN A. CAROLLO
Consulting Engineers
PHOENIX

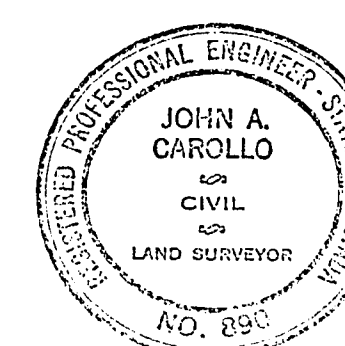

AS BUILT

DRAWING NO.

Sheet 1 of 7

MAYOR
ORAN K. GRAGSON
COMMISSIONERS
E. W. FOUNTAIN
HARRY C. LEVY
PHILIP M. MIRABELLI
REED WHIPPLE
CITY MANAGER
V. L. FLETCHER
DIRECTOR OF PUBLIC WORKS
RICHARD P. SAUER

16-1-71 307-1310