
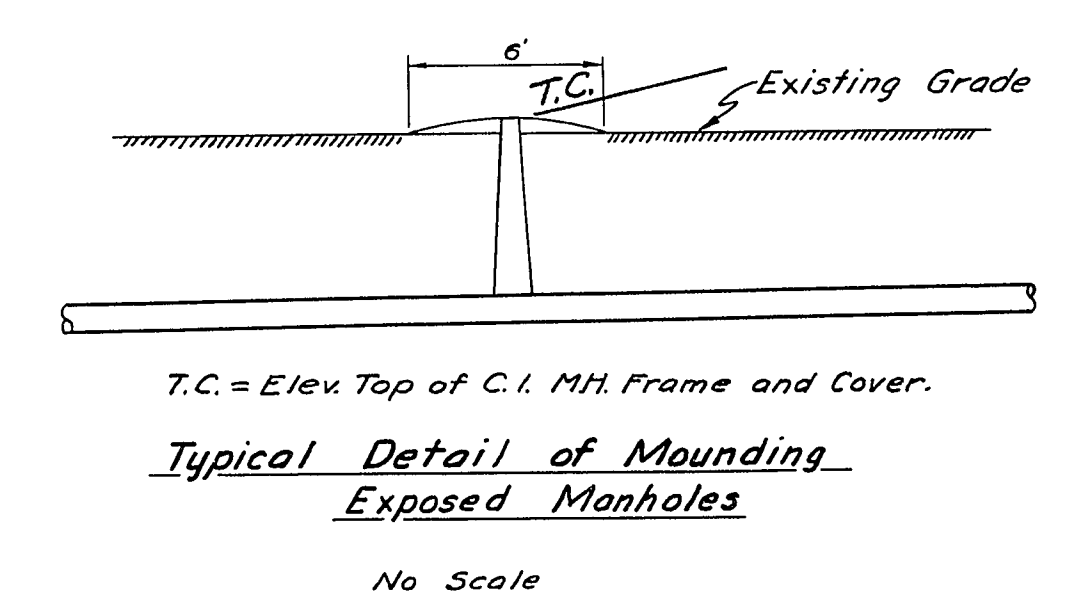
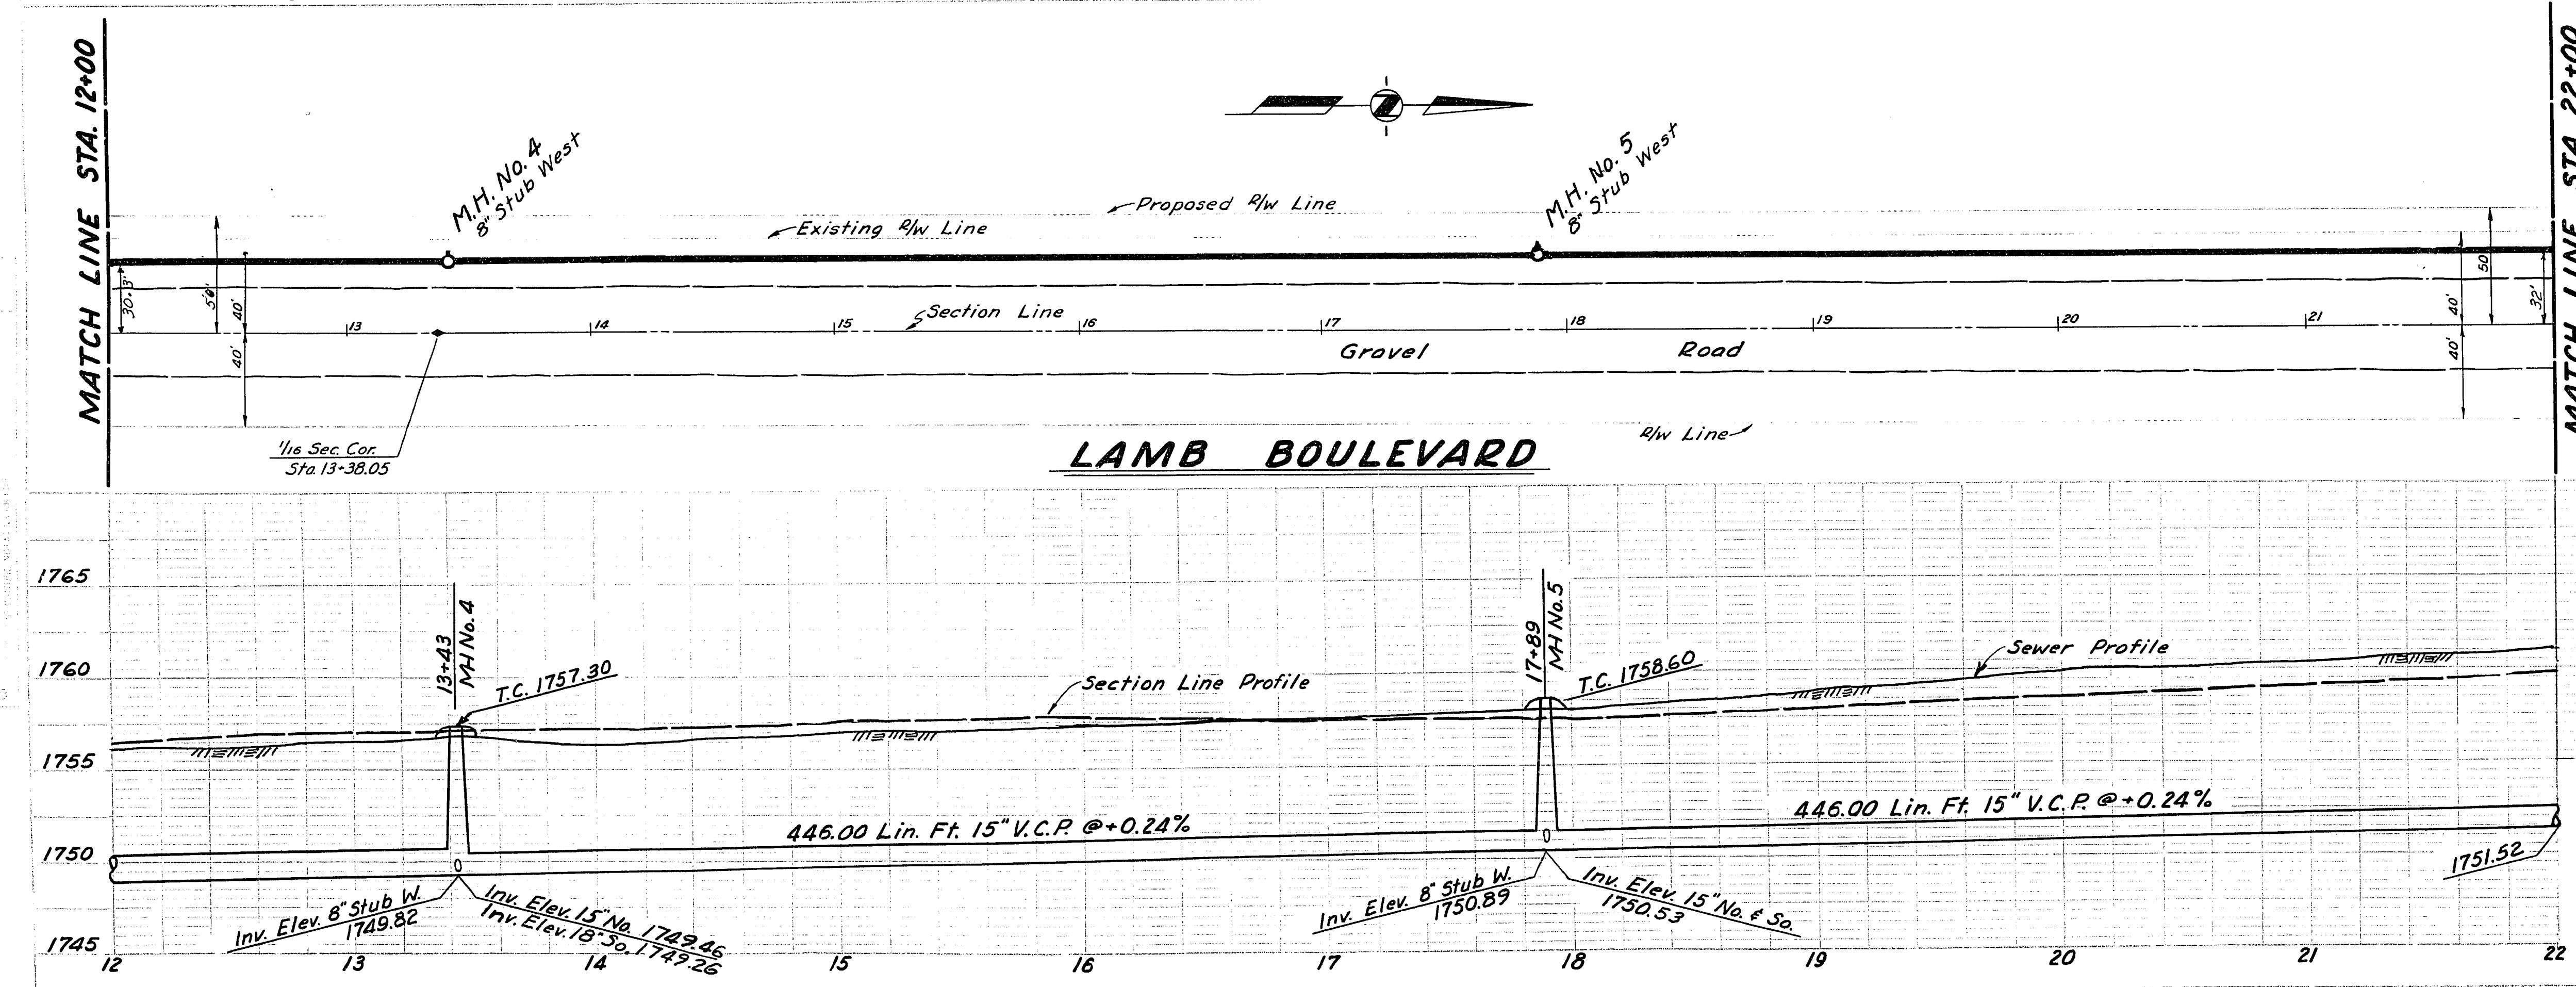


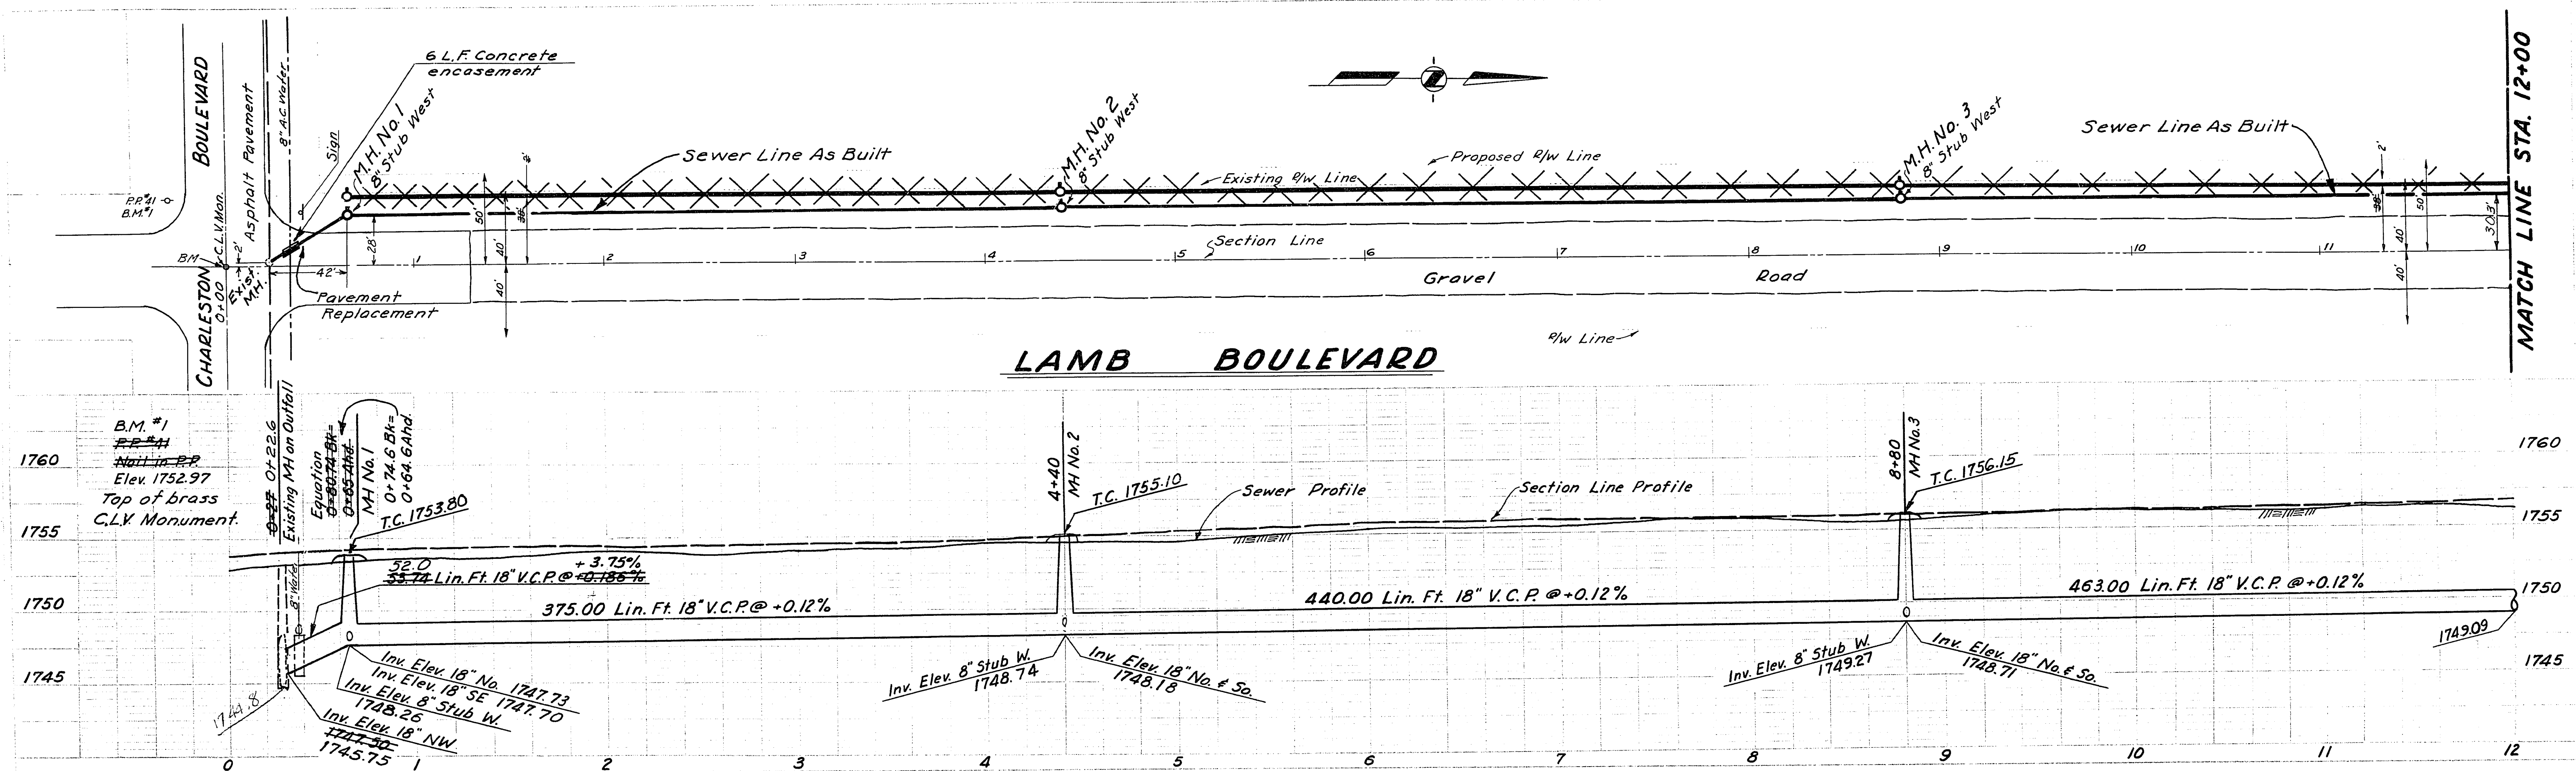

SCALE: 1" = 40' HORIZONTAL
1" = 5' VERTICAL

AS BUILT

JOHN A. CAROLLO CONSULTING ENGINEERS PHOENIX, ARIZONA				CHARLES A. ROLLING ROBERT M. CUSHING H. HARVEY HUNT	
LAS VEGAS, NEVADA					
LAMB BLVD TRUNK SEWER					
DESIGNED G.C.W.	CHECKED J.S.	DATE Sept '62	AS BUILT MAY '63	DRAWING NO.	SHEET
DRAWN N.J.S.			TRACKED D.B.C.-D.M.T.		NO. 2 OF 7

11-1-10 10-1-10