


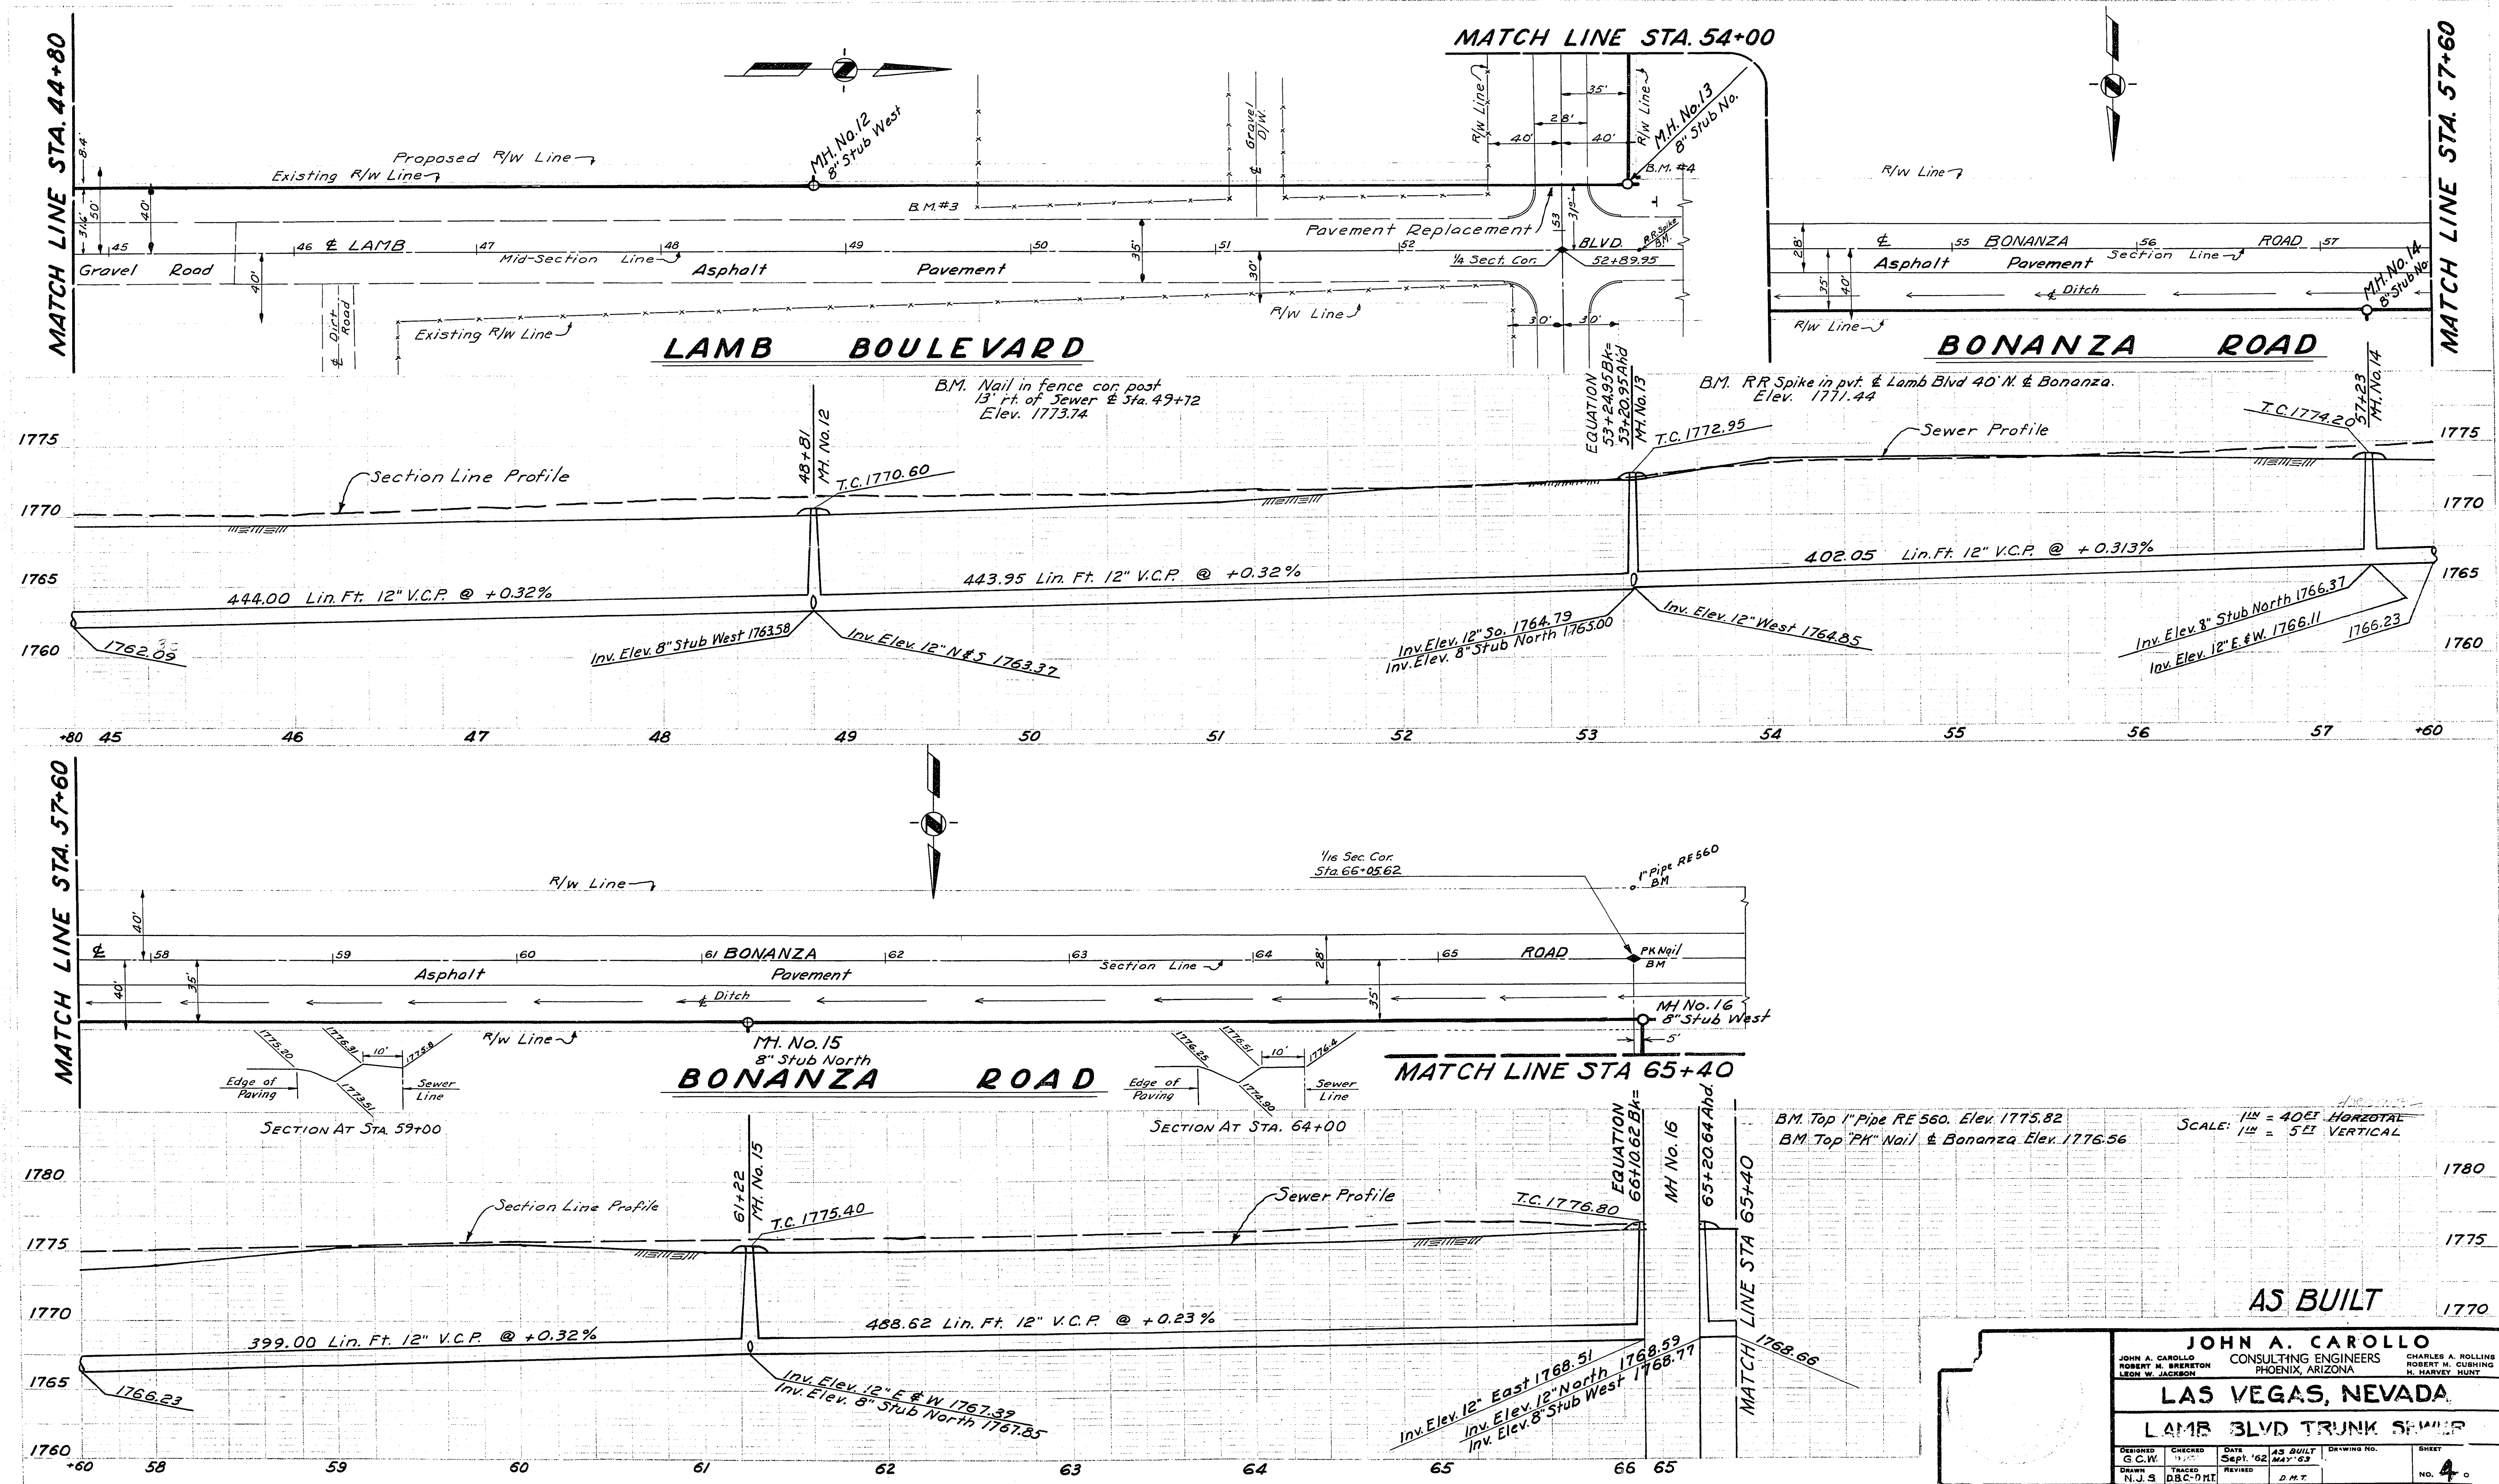

**AS BUILT**

|                                          |                   |                         |                                 |
|------------------------------------------|-------------------|-------------------------|---------------------------------|
| <b>JOHN A. CAROLLO</b>                   |                   |                         |                                 |
| CONSULTING ENGINEERS<br>PHOENIX, ARIZONA |                   |                         |                                 |
| <b>LAS VEGAS, NEVADA</b>                 |                   |                         |                                 |
| <b>LAMB BLVD TRUNK SEWER</b>             |                   |                         |                                 |
| DESIGNED<br>G.C.W.                       | CHECKED<br>N.J.S. | DATE<br>Sept. '62       | DRAWING NO.<br>43 BUILT MAY '63 |
| DRAWN<br>N.J.S.                          |                   | TRACED<br>D.B.C.-D.R.T. | SHEET<br>NO. 4                  |

161-17N 307-V310