

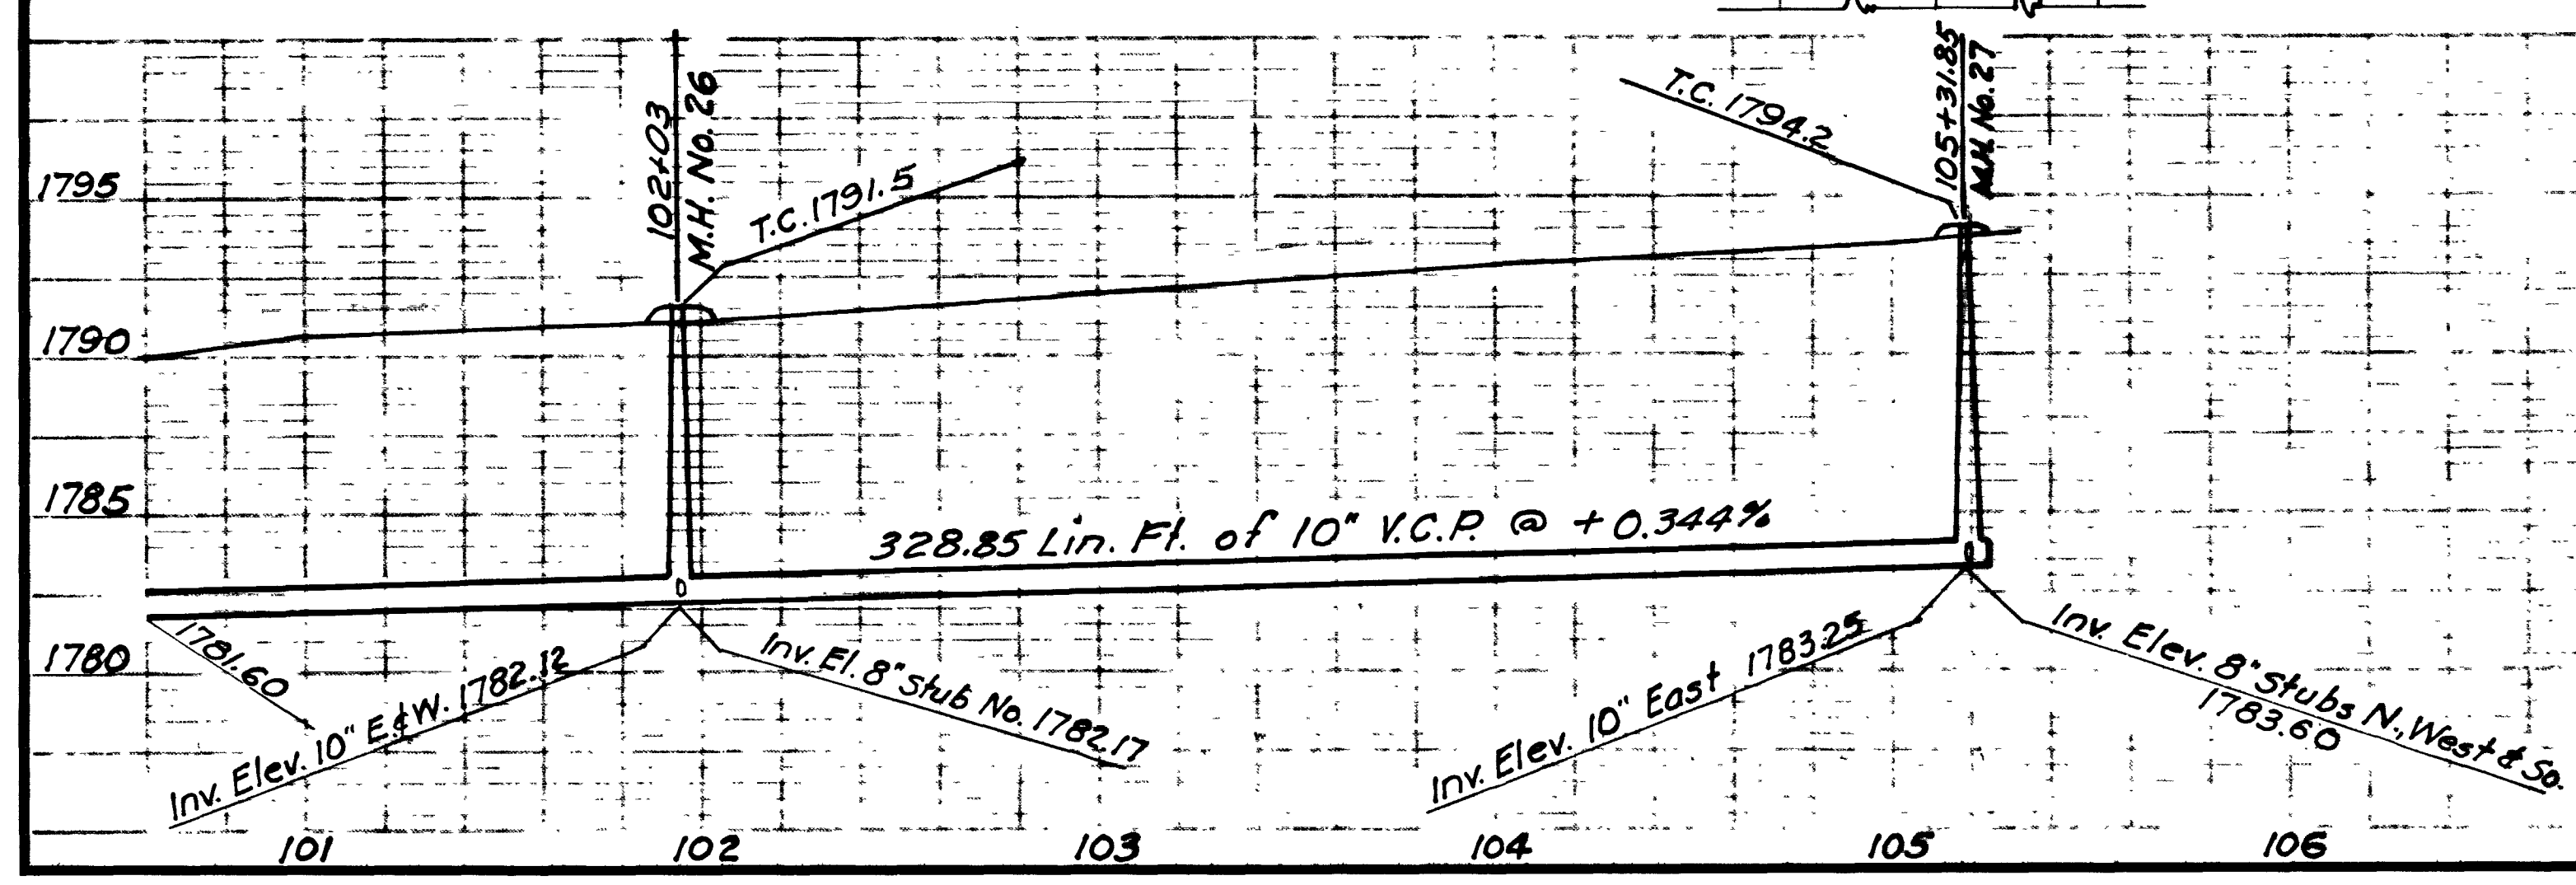
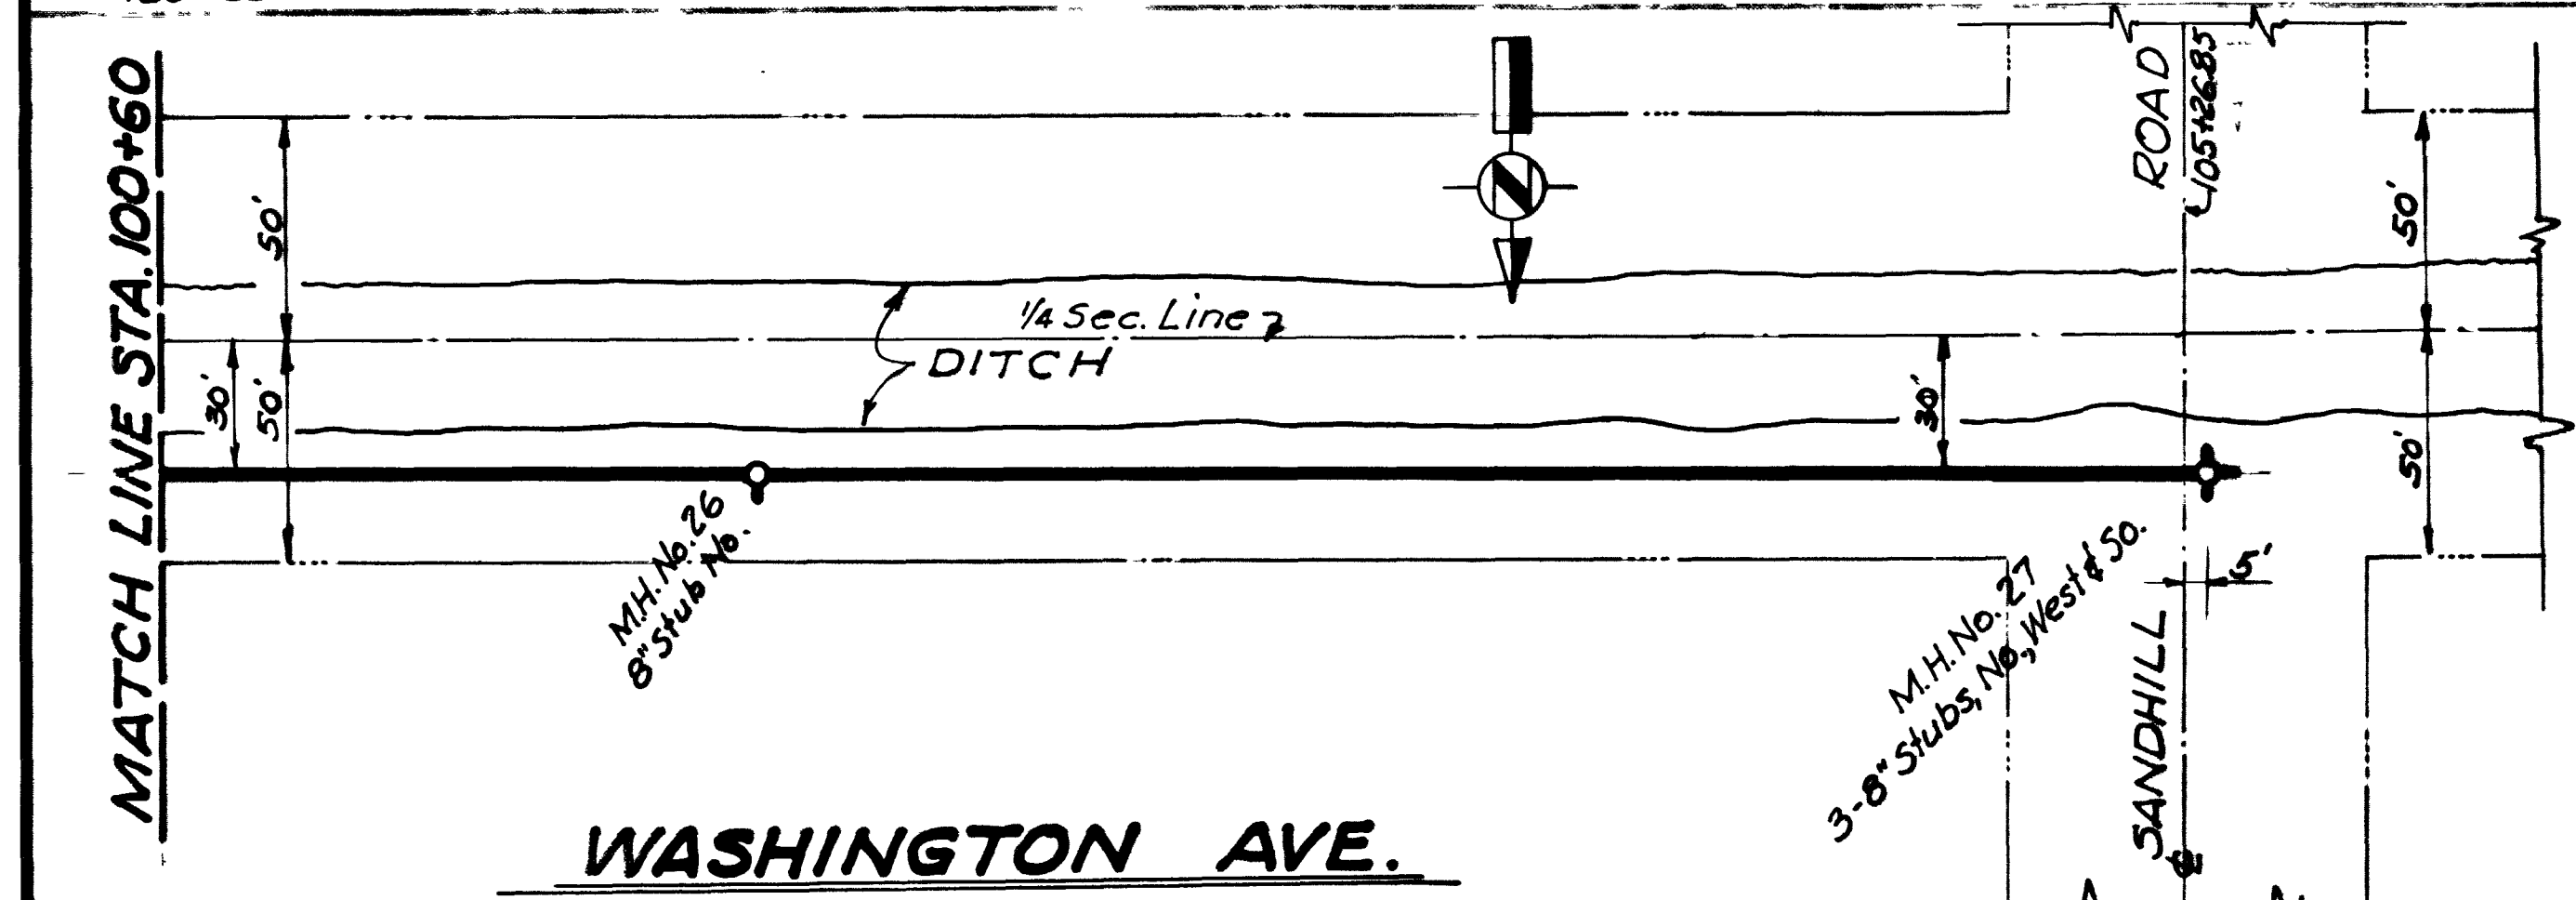
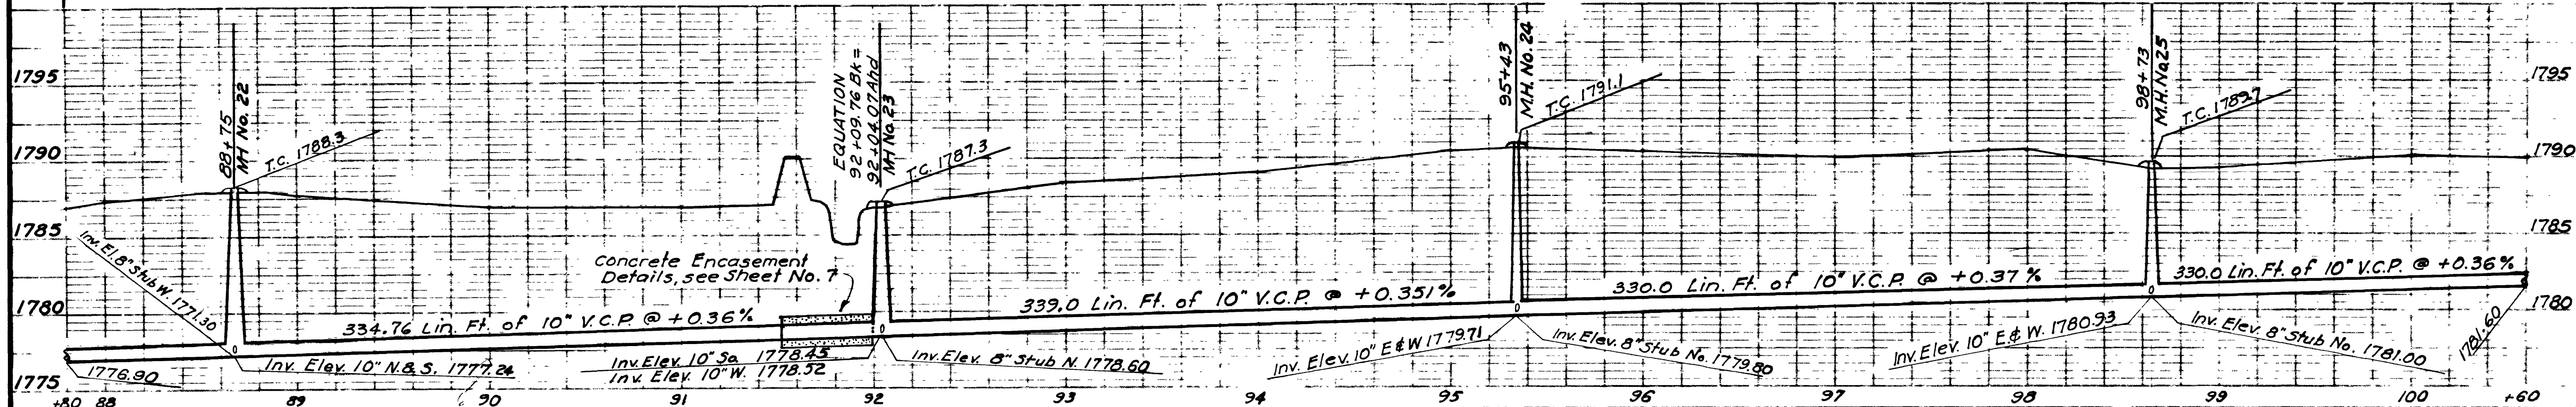


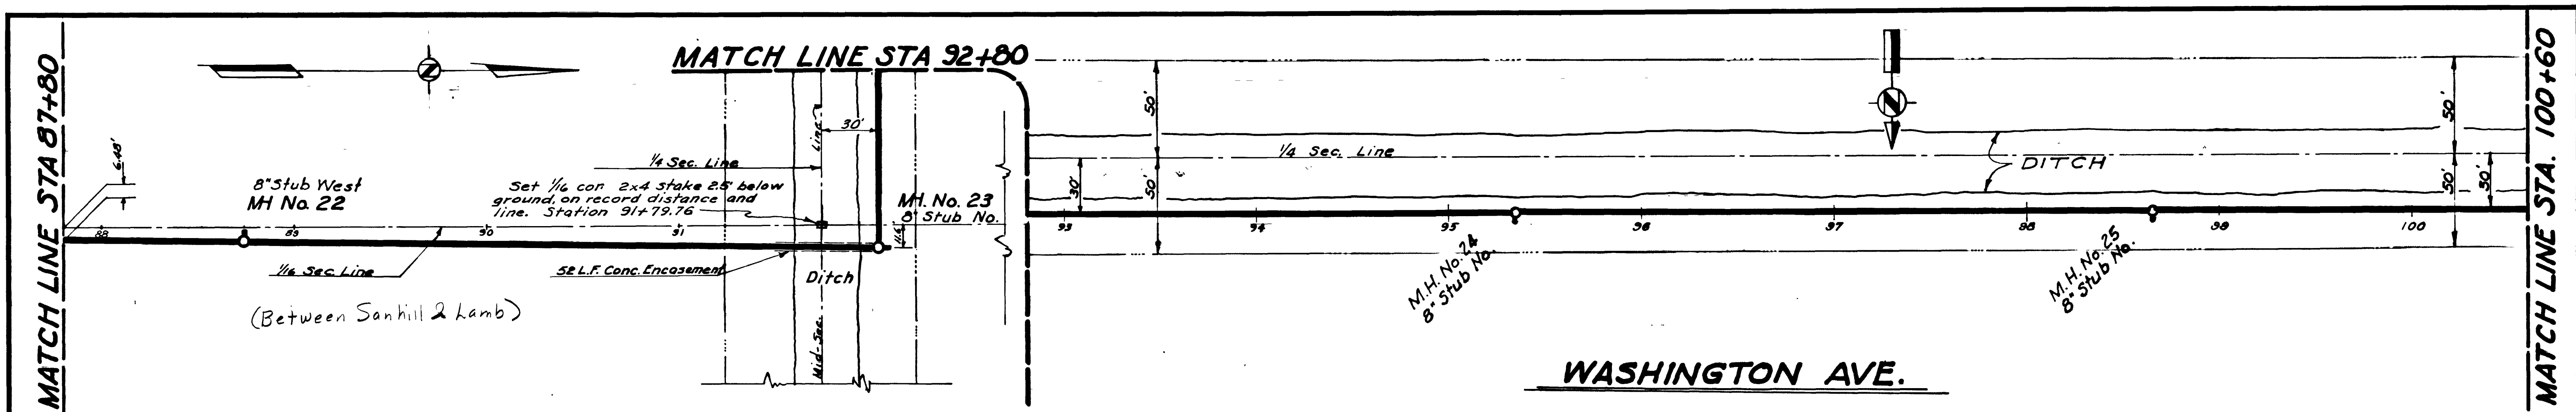

SCALE: 1" = 40' HORIZ.
1" = 5' VERT.

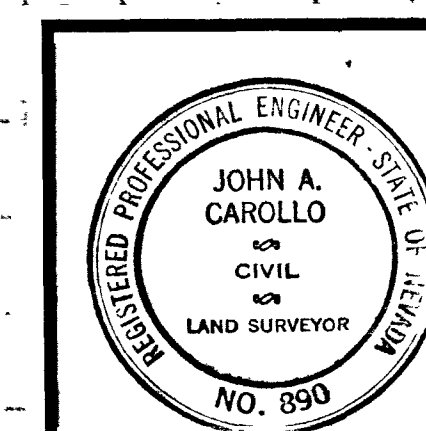

AS BUILT			
JOHN CAROLLO ENGINEER PHOENIX, ARIZONA			
LAS VEGAS, NEVADA			
LAMB BLVD. TRUNK SEWER			
DESIGNED G.C.W.	CHECKED G.C.W.	DATE NOV. 27, 1961	DRAWING NO. 307-V310
DRAWN G.C.W.	REVISED G.C.W.	REVISION D.M.T.	SHEET 6 OF 7

16-1-76 307-V310

