


PROFILE
 SCALE: HORIZ. 1"=30'
 VERT. 1"=3'

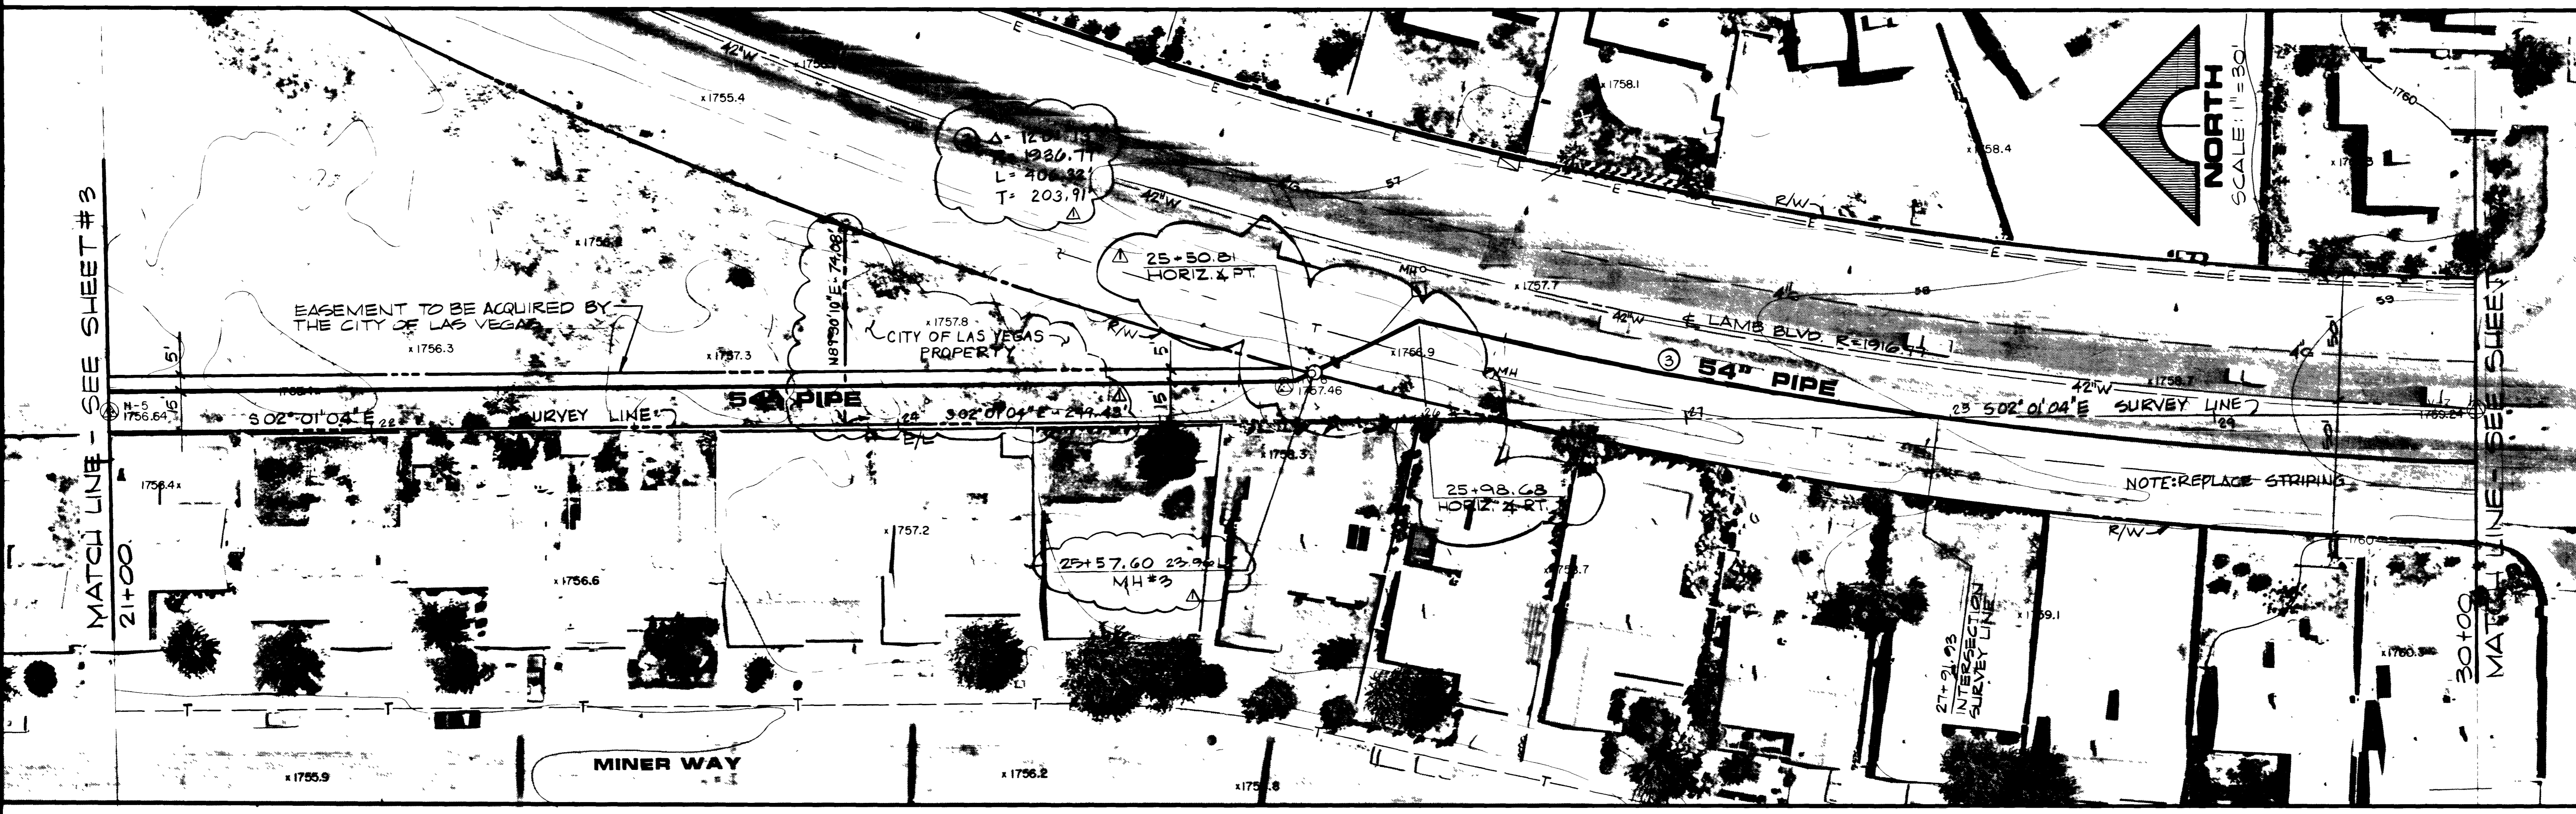

LAMB BOULEVARD

RECORD DRAWING
 307-V602

RECOMMENDED	DATE	DESCRIPTION

REVISIONS

NO.	DATE	DESCRIPTION
1	11/11/11	ISSUED FOR PERMITS
2	11/11/11	ISSUED FOR PERMITS
3	11/11/11	ISSUED FOR PERMITS

REVISIONS

NO.	DATE	DESCRIPTION
1	11/11/11	ISSUED FOR PERMITS
2	11/11/11	ISSUED FOR PERMITS
3	11/11/11	ISSUED FOR PERMITS

REVISIONS

G. C. WALLACE
 Consulting Engineers, Inc.
 1100 East Sahara Ave. • Las Vegas, Nevada 89104 • 732-3330

DEPARTMENT OF ENGINEERING SERVICES
 LAMB BLVD. RELIEF SEWER
 PLAN & PROFILE 21+00 TO 30+00

SHEET 4
 OF 12 SHEETS

JOB NO. 412200

C.A.N. 050484

91

23-1-99

