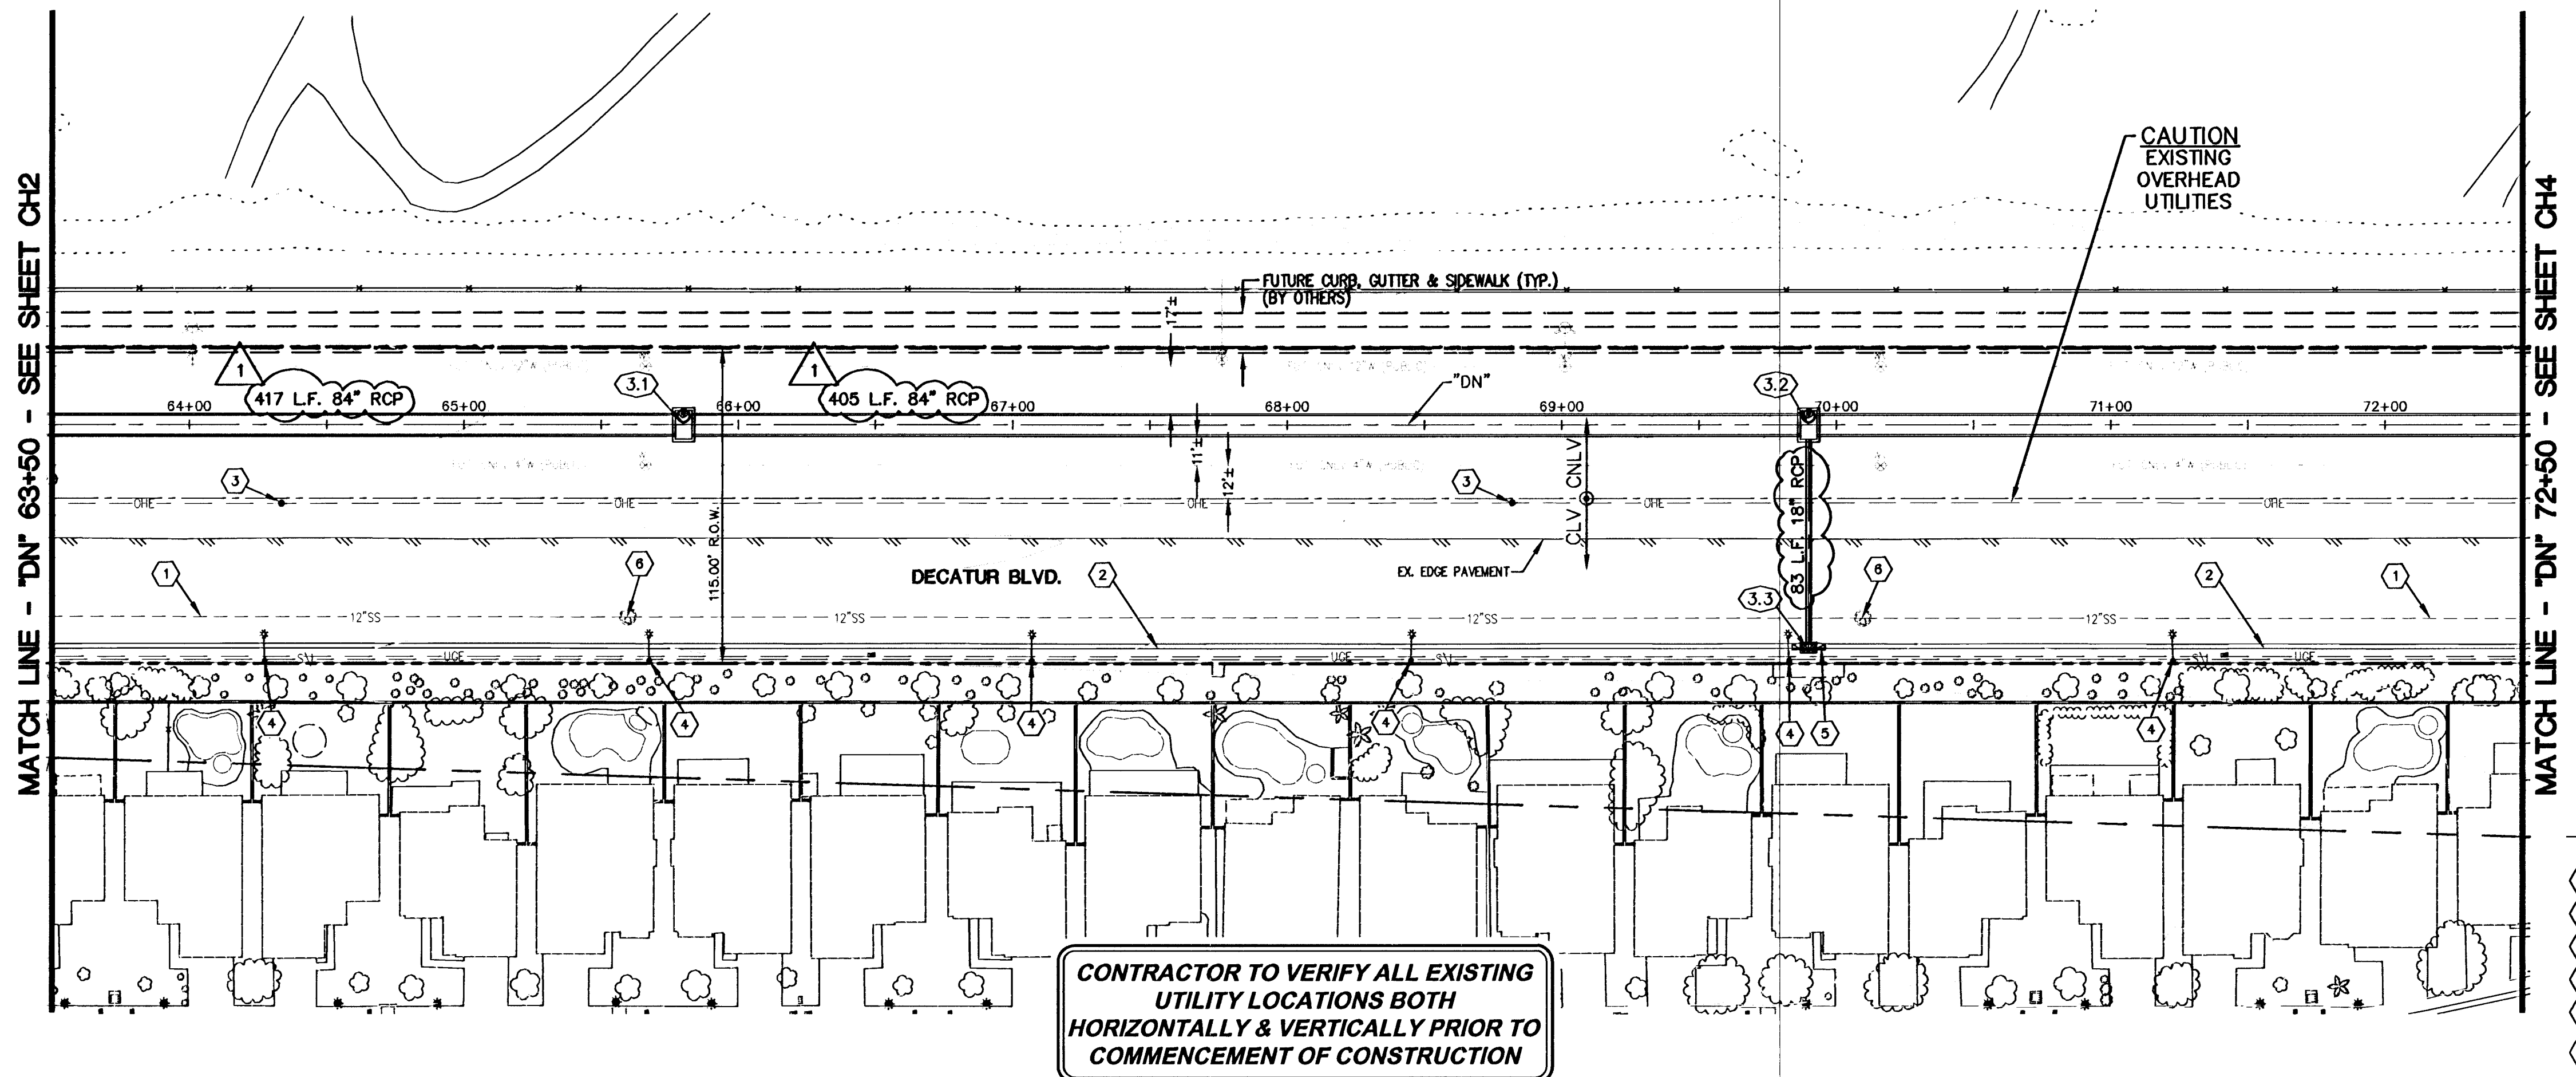



STORM DRAIN CONSTRUCTION ITEMS:

- (3.1) "DN" 65+80.10
INSTALL MODIFIED NDOT TYPE 4 SDMH
FOR STRUCTURAL DETAILS REFER TO
SHEET S6
INSTALL 403.81 L.F. 84" RCP
- (3.2) "DN" 69+89.91
INSTALL MODIFIED NDOT TYPE 4 SDMH
FOR STRUCTURAL DETAILS REFER TO
SHEET S6
INSTALL 410.81 L.F. 84" RCP
- (3.3) "DN" 69+89.91, 79.75' RT
INSTALL 5" TYPE "DM2B" D.I.
PER DETAIL ON SHEET D2
PLACE SANDBAGS AROUND D.I.
PER DETAIL ON SHEET D1
INSTALL 74.58 L.F. 18" RCP
SEE PROFILE 9 SHEET SD3

MISCELLANEOUS CONSTRUCTION NOTES:

- 1 EX. 12" SANITARY SEWER - PROTECT IN PLACE
- 2 EX. CURB, GUTTER, SIDEWALK & UTILS. - PROTECT IN-PLACE
- 3 EX. POWER POLE - PROTECT IN-PLACE
- 4 EX. STREET LIGHT - PROTECT IN PLACE
- 5 REMOVE AND REPLACE CURB, GUTTER AND SIDEWALK AS REQUIRED
FOR D.I. CONSTRUCTION, PROTECT EX. DRY UTILITIES IN PLACE
- 6 EX. SANITARY SEWER MH - PROTECT IN PLACE

**CONTRACTOR TO VERIFY ALL EXISTING
UTILITY LOCATIONS BOTH
HORIZONTALLY & VERTICALLY PRIOR TO
COMMENCEMENT OF CONSTRUCTION**

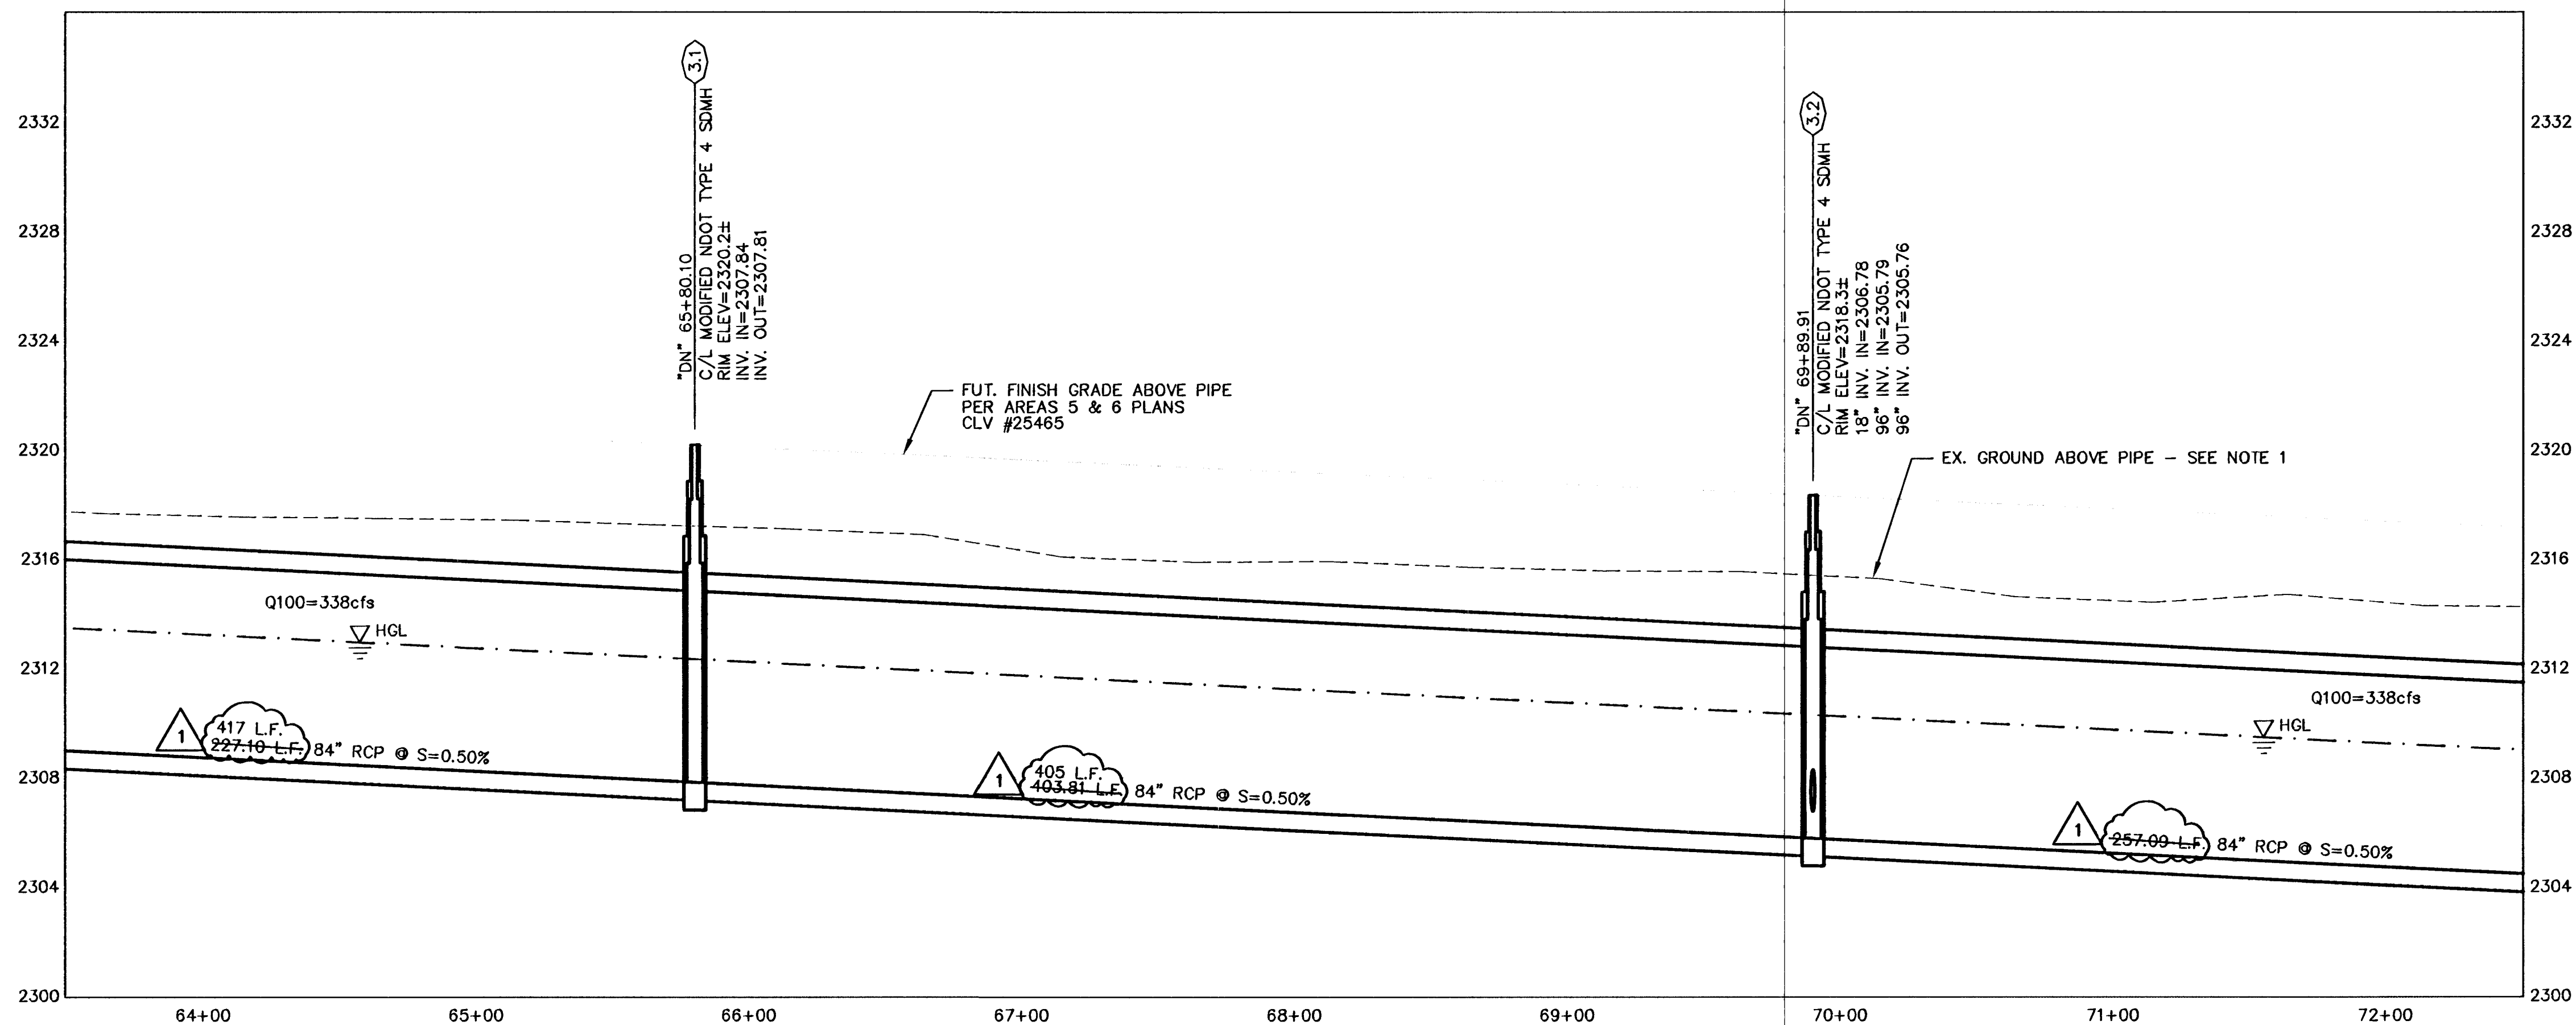

NOTE:
1. FINISHED GROUND ABOVE RCP
AND STORM DRAIN STRUCTURES
SHALL BE EXISTING GROUND OR
TWO FEET OF COVER, WHICHEVER
IS GREATER.

THE ONLY 4" W IS INTENDED TO BE
USED FOR IRRIGATION PURPOSES
ONLY. DOMESTIC CONNECTIONS
WILL NOT BE ALLOWED

Call before you Dig
Avoid cutting underground utility lines. It's costly.

Call before you Overhead
Avoid overhead power line contact. It's costly.

1-702-227-2929
NEVADA POWER ENVIRONMENT AND
SAFETY SERVICES DEPARTMENT

Call 811

1-800-227-2600
ONE CALL SYSTEM OPERATIONS
1-702-455-7544

#27037

PUBLIC WORKS DEPARTMENT LAS VEGAS, NV 89101 702-229-6272 2727 SOUTH RAINBOW BOULEVARD LAS VEGAS, NV 89146-5146 PH (702) 873-7550 FAX (702) 362-2597 WEB SITE WWW.VTNV.COM			
CONSTRUCTION PLAN & PROFILE "DN" 63+50 TO "DN" 72+50 LAS VEGAS WASH MIDDLE BRANCH DECATUR BOULEVARD ELKHORN ROAD TO WHISPERING SANDS DRIVE			
DRAWN BY: DPK DESIGNED BY: VTN CHECKED BY: VTN PROJECT NO: 6801	08/08/2008 SCALE: HORIZ. 1"=40' VERT. 1"=4'	SHEET CH3 9 OF 26 SHEETS DRAWING NO. 731-87	ORIGINAL CONSTRUCTION DRAWINGS ARE ON FILE WITH THE CITY OF LAS VEGAS. THE DOCUMENTS WERE SEALED ON 8/8/08 BY JEFFREY M. GRIEST UNDER LICENSE NO. 17155
RECORD DRAWINGS INFORMATION SUPPLIED BY CONTRACTOR - JULY 2010			