



SHOP BILL


MARK	QTY	DESCRIPTION	FT	IN	REMARKS	WT
18A	ONE	HSS 4x4x $\frac{1}{4}$	11	3 $\frac{1}{4}$	A500 GR B	
pa18	ONE	FB $\frac{5}{8}$ x5	1	7	A36	
pb18	ONE	FB $\frac{5}{8}$ x7	0	7 $\frac{1}{2}$	A36	
18B	ONE	HSS 4x4x $\frac{1}{4}$	11	3 $\frac{1}{4}$	A500 GR B	
pa18	ONE	FB $\frac{5}{8}$ x5	1	7	A36	
pb18	ONE	FB $\frac{5}{8}$ x7	0	7 $\frac{1}{2}$	A36	
18D	ONE	HSS 4x4x $\frac{1}{4}$	11	3 $\frac{1}{4}$	A500 GR B	
pa18	ONE	FB $\frac{5}{8}$ x5	1	7	A36	
pd18	ONE	FB $\frac{5}{8}$ x7	0	10	A36	

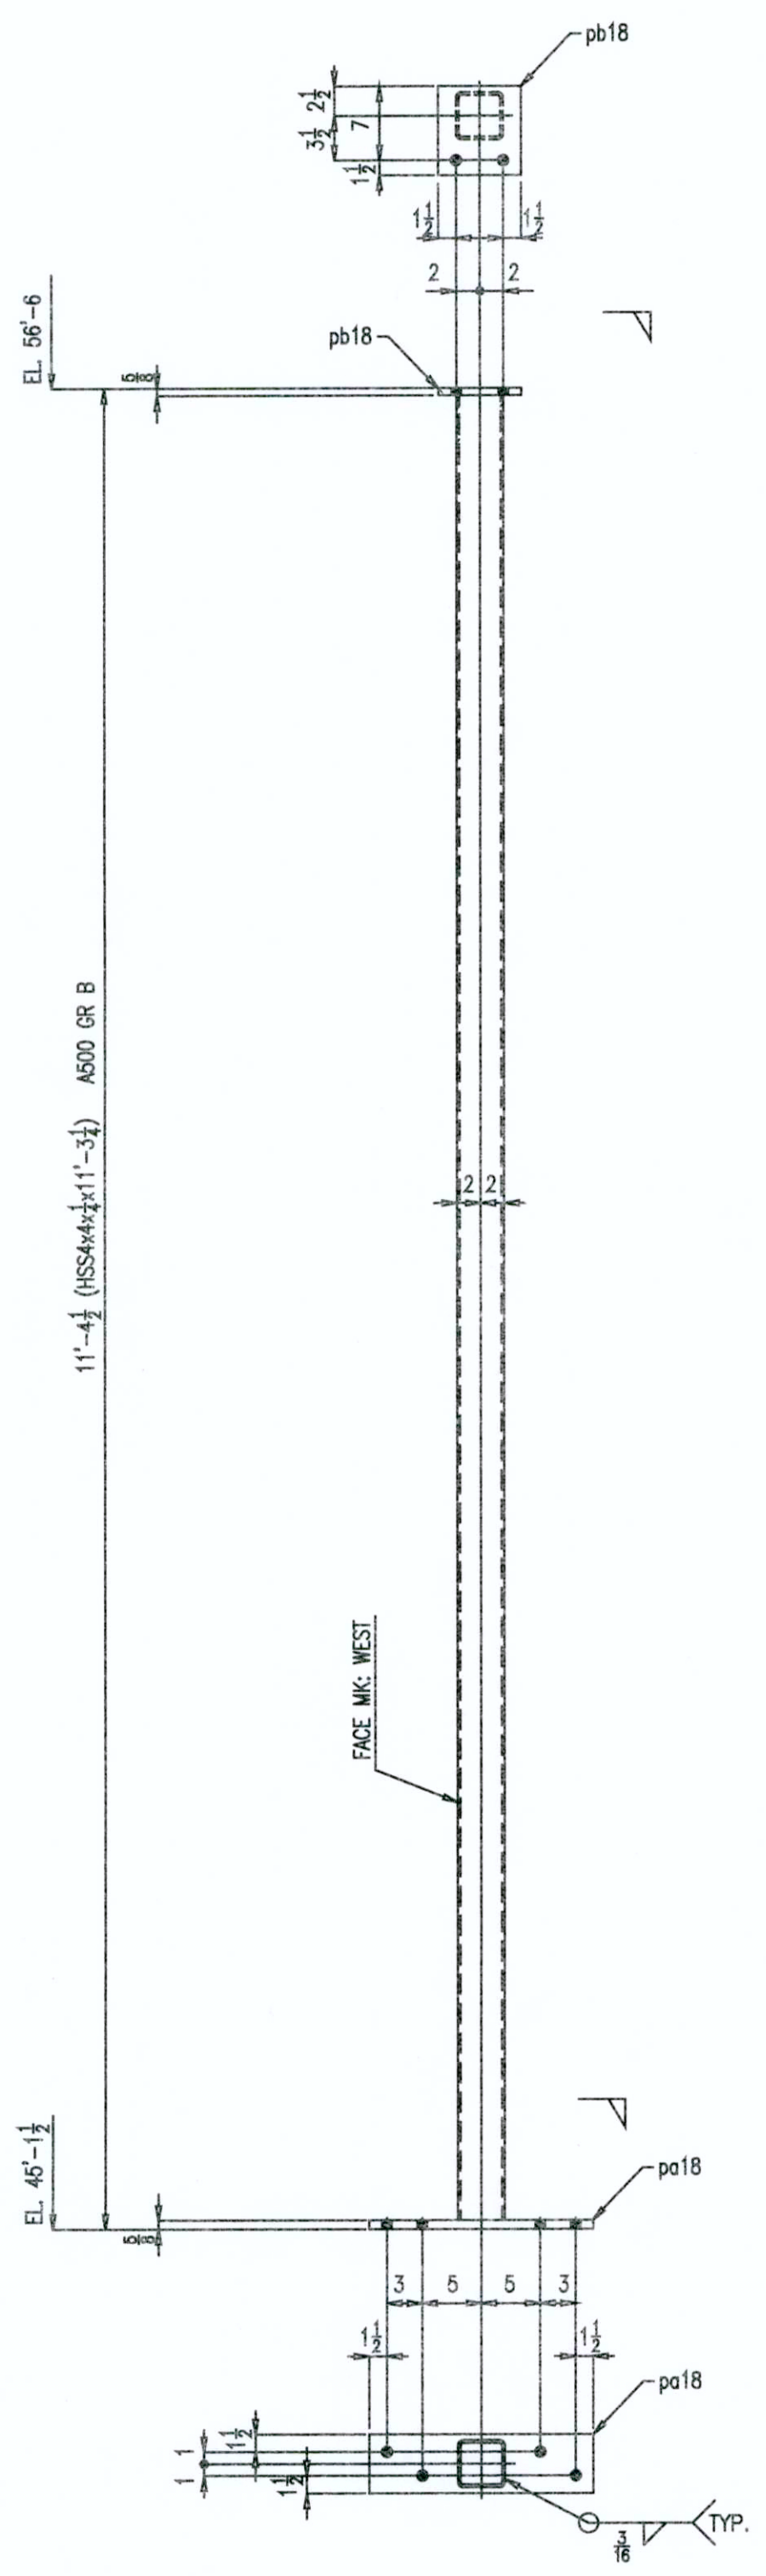

ONE - COLUMN - 18A

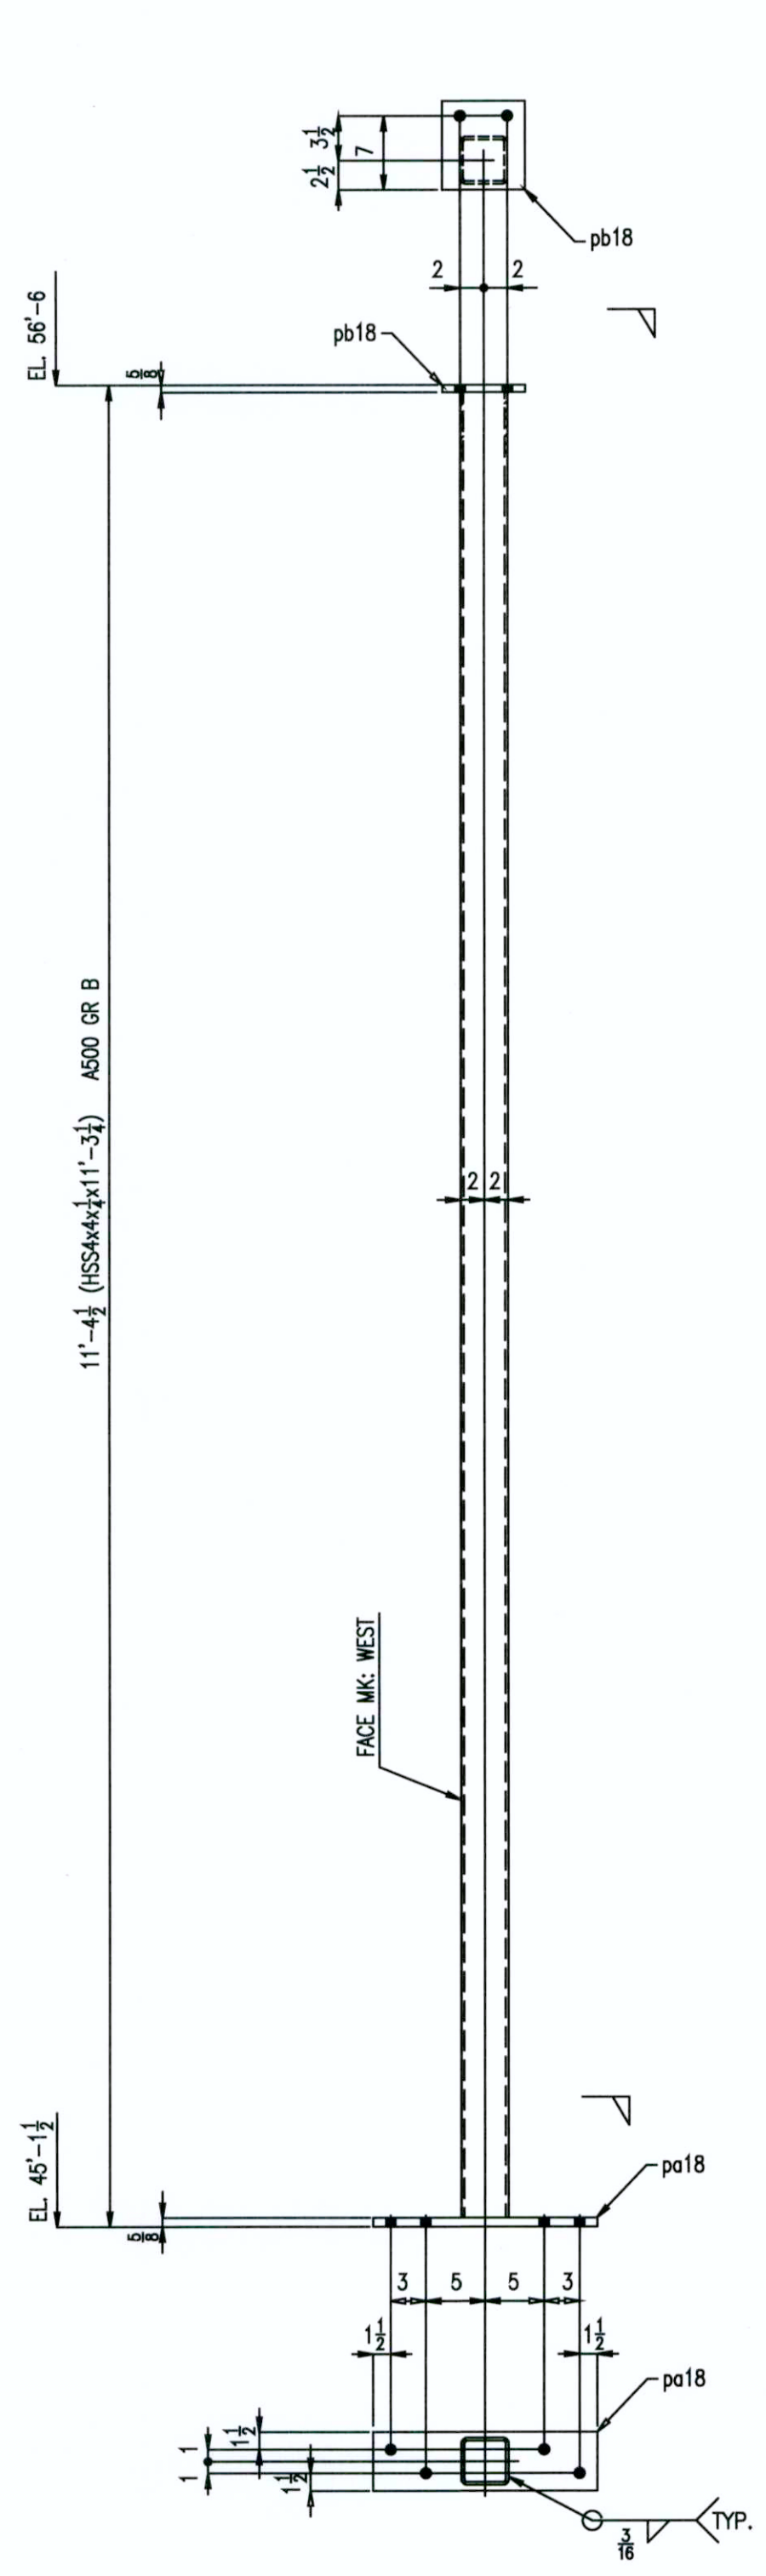

ONE - COLUMN - 18B

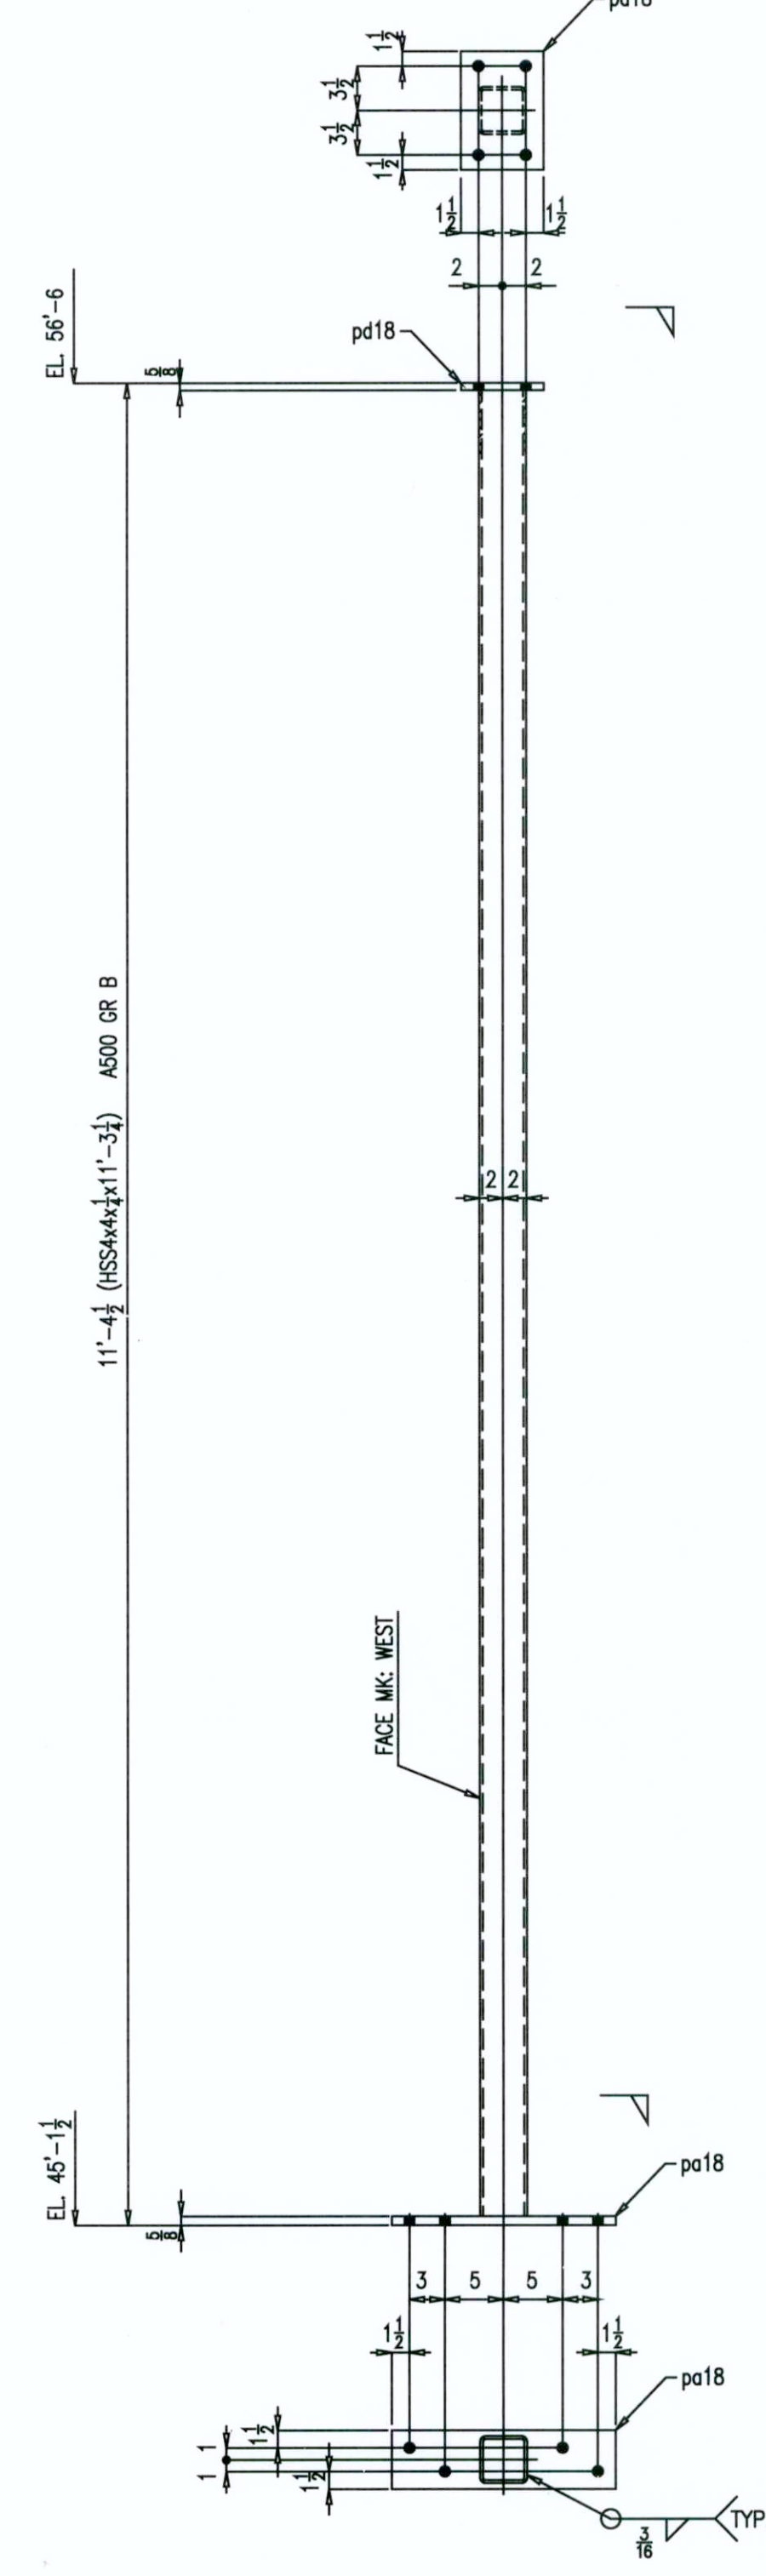

ONE - COLUMN - 18D

GUARDRAIL NOTES  
 1. LIN. FT. LENGTH INCLUDES ADDITIONAL 1'-6"  
 2. ALL G.R. JOINT TO BE WELDED & GRIND SMOOTH

APPROVAL AUTHORITY:  
 VERIFICATION OF DIMENSIONS, DETAILS, ETC  
 ARE REQUESTED WHERE INDICATED. IF EACH  
 VERIFICATION IS NOT NOTED OTHERWISE,  
 IT WILL BE ASSUMED TO BE CORRECT AS SHOWN.

AS BUILTS

THIS PROJECT SHALL BE ERECTED PER THE AISC THIRTEENTH EDITION CODE OF STANDARD PRACTICE SPECIFICALLY PARAGRAPH 7.14 AS FOLLOWS:  
 7.14 CORRECTION OF ERRORS  
 The correction of minor misfits by moderate amounts of reaming, grinding, welding or cutting, and the drawing of elements into line with drift pins, shall be considered to be normal erection operations. Errors that cannot be corrected using the foregoing means, or that require major changes in the member or Connection configuration, shall be promptly reported to the Owner's Designated Representatives for Design and Construction and the Fabricator by the Erector to enable the responsible entity to either correct the error or approve the most efficient and economical method of correction to be used by others.  
 No Backcharges Will Be Accepted Unless Approved In Writing By Steel Structures, Inc



QUALITY CERTIFICATION

PRINTS	NO.	DATE
SHOP		
FIELD		
GEN CONT		
PRJ MGR		
Q A		
1st APPR		
SHOP PRELIM		
EREC PRELIM		
O C PRELIM		
ENGR.		
PURCH.		

REFERENCE DRWG. / LOCATION	REV.	DATE	DESCRIPTION
E2	0	7/10	For FAB

MATERIAL (UNLESS NOTED)	A36
SURFACE PREPARATION	
SHOP PAINT	SHOP PRIMER U.N.
SHOP CONNECTIONS/ELECTRODES	E70XX
FIELD CONNECTIONS	
HOLES (U.N.)	1 $\frac{1}{8}$ " Ø U.N.

DETAILER	YS	DATE	6/10
CHECKER	SS	DATE	6/10
PROJECT MANAGER	SSI		

JOB NO.	1014
DRWG. NO.	18

STEEL STRUCTURES, INC.  
 5980 So. Procyon Ave. - Las Vegas, Nevada  
 (702)736-7033

CITY OF LAS VEGAS MUSIUM  
 Las Vegas, Nevada  
 APCO  
 COLUMN