

OFFICE SET

# DEPARTMENT OF PUBLIC WORKS REVIEW



As-Built Record Drawings

Project: Las Vegas Wash Middle Branch;  
Rainbow Storm Drain Elkhorn to Grand  
Teton

Bid No.: 10.1730.02

Date: July 7, 2011

Mayor:  
OSCAR B. GOODMAN

City Council:  
GARY REESE, (MAYOR PRO-TEM)  
STEVE WOLFSON  
LOIS TARKANIAN  
STEVEN D. ROSS  
RICKI Y. BARLOW  
STAVROS S. ANTHONY

City Manager:  
ELIZABETH N. FRETWELL

Director of Public Works:  
JORGE CERVANTES, P.E., P.T.O.E.

City Engineer:  
CHERI EDELMAN, P.E.

## LAS VEGAS WASH - MIDDLE BRANCH RAINBOW STORM DRAIN ELKHORN TO GRAND TETON

BID NUMBER: 10.1730.02

FUNDED BY:  
CLARK COUNTY REGIONAL FLOOD CONTROL DISTRICT

*Cheri Edelman*  
City Engineer

*John A. ...*  
Construction M

*John ...*  
Project Manager

*M. ...*  
City Traffic Eng

*Galvin ...*  
Clark County F  
Flood Control

*Denis ...*  
Clark County F  
Denis Cederbl

*Clark ...*  
Clark County E

*Ken D. O'Leary* 6-17-09  
Las Vegas Valley Water District Date  
PROJECT #14800  
(SHEETS 12, 13, SD3, SD4, SD6, SD8-SD10, SD13-SD15, SS1, SS2, SS3, SS4, SS6, SS7, R1, R2 & R4)

*Y. ...* 6/16/09  
Southern Nevada Water Authority Date  
SNWA APPROVAL IS VALID FOR ONE (1) YEAR FROM THE SIGNATURE DATE. IF CONSTRUCTION WITHIN THE EASEMENT OR RESTRICTED PIPE SAFETY ZONE IS NOT COMPLETE, PLANS MUST BE RESUBMITTED TO SNWA FOR APPROVAL.

*Michael ...* 2-16-09  
Cox Communications Las Vegas, Inc. Date

*Rick Nestlebusch* 2/12/09  
Embarq Telephone Date


THE AFFIXED EMBARQ NEVADA APPROVAL DOES NOT ASSUME OR GUARANTEE LIABILITY FOR KNOWN OR UNKNOWN CONFLICTS WITH EXISTING OR PROPOSED IMPROVEMENTS. RESOLUTION OF ANY CONFLICT WILL BE ACCOMPLISHED PURSUANT TO LOCAL ORDINANCES, NEVADA REVISED STATUTES AND/OR PUBLIC UTILITY COMMISSION STANDARD REGULATIONS.

*John ...* 2-18-09  
NV Energy-Distribution Date

*Lisa ...* 2-18-09  
NV Energy-Transmission Date


NV ENERGY ACKNOWLEDGES THAT WE HAVE RECEIVED YOUR PLANS AND WILL PROVIDE SERVICE TO ALL ELECTRICAL NEEDS ASSOCIATED WITH THIS PROJECT. NV ENERGY RESERVES THE RIGHT TO ADDRESS ANY EXISTING OR FUTURE CONFLICTS ONCE THE FINAL DESIGN IS COMPLETED. THE NEW SERVICE AND THE RESOLUTION OF ANY CONFLICTS WILL BE ACCOMPLISHED PURSUANT TO THE NEVADA PUBLIC UTILITY COMMISSION'S RULES AND REGULATIONS.

*Southwest Gas* 2-18-09  
Southwest Gas Corporation Date

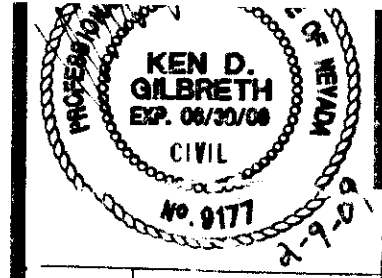

DEPARTMENT OF PUBLIC WORKS  
PROJECT: LV WASH - MIDDLE BRANCH  
RAINBOW STORM DRAIN  
ELKHORN TO GRAND TETON

COVER SHEET

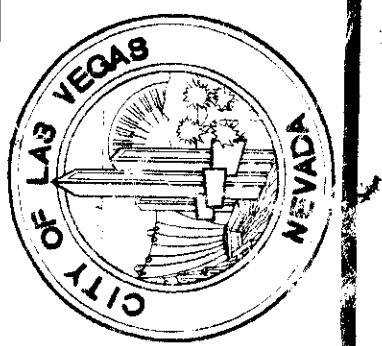

DRAWING NO. II  
731-87-1