
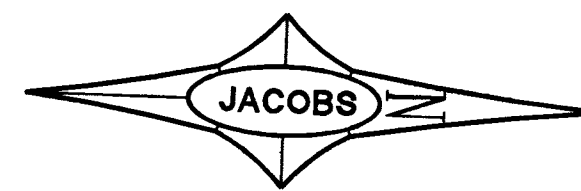



FOR CONNECTION TO LVVWD FACILITIES ONLY

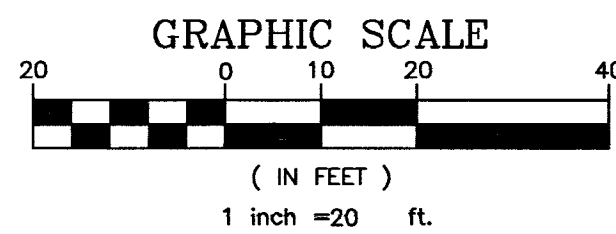

APPROVED FOR CONSTRUCTION
1ST APPROVAL 11/02/11
LVVWD ENGINEERING SERVICES MANAGER DATE
PROJECT NO. 116494

NOTES

- DISTURBED LANDSCAPING ALONG EDGE OF ROADWAY SHALL BE RESTORED TO ORIGINAL CONDITION. SEE HS PLANS.
- SEE LS-01 FOR PLANTING LEGEND.
- SEE LS-01 FOR PLANTING NOTES.
- SEE LS-01 FOR CONCRETE STAINING AND STAMPING NOTES.
- SEE CIVIL PLANS FOR MEDIAN ISLAND SIZE AND LOCATION.
- BOULDERS AND PLANTS SHALL BE PLACED A MINIMUM OF 3' FROM RPPA AND IRRIGATION CONTROLLER PEDESTAL.
- NO TREES OR DEEP ROOTED SHRUBS SHALL BE PLANTED OR PLACED IN THE SNWA EASEMENT.
- NO TREES OR DEEP ROOTED SHRUBS SHALL BE PLANTED OR PLACED OVER EXISTING OR PROPOSED LVVWD WATER LINES.
- CONCRETE MEDIAN ISLAND SHALL BE 4" CONCRETE (STAINED/STAMPED WHERE APPLICABLE) OVER 2" AGGREGATE BASE, PER USD NO. 220.

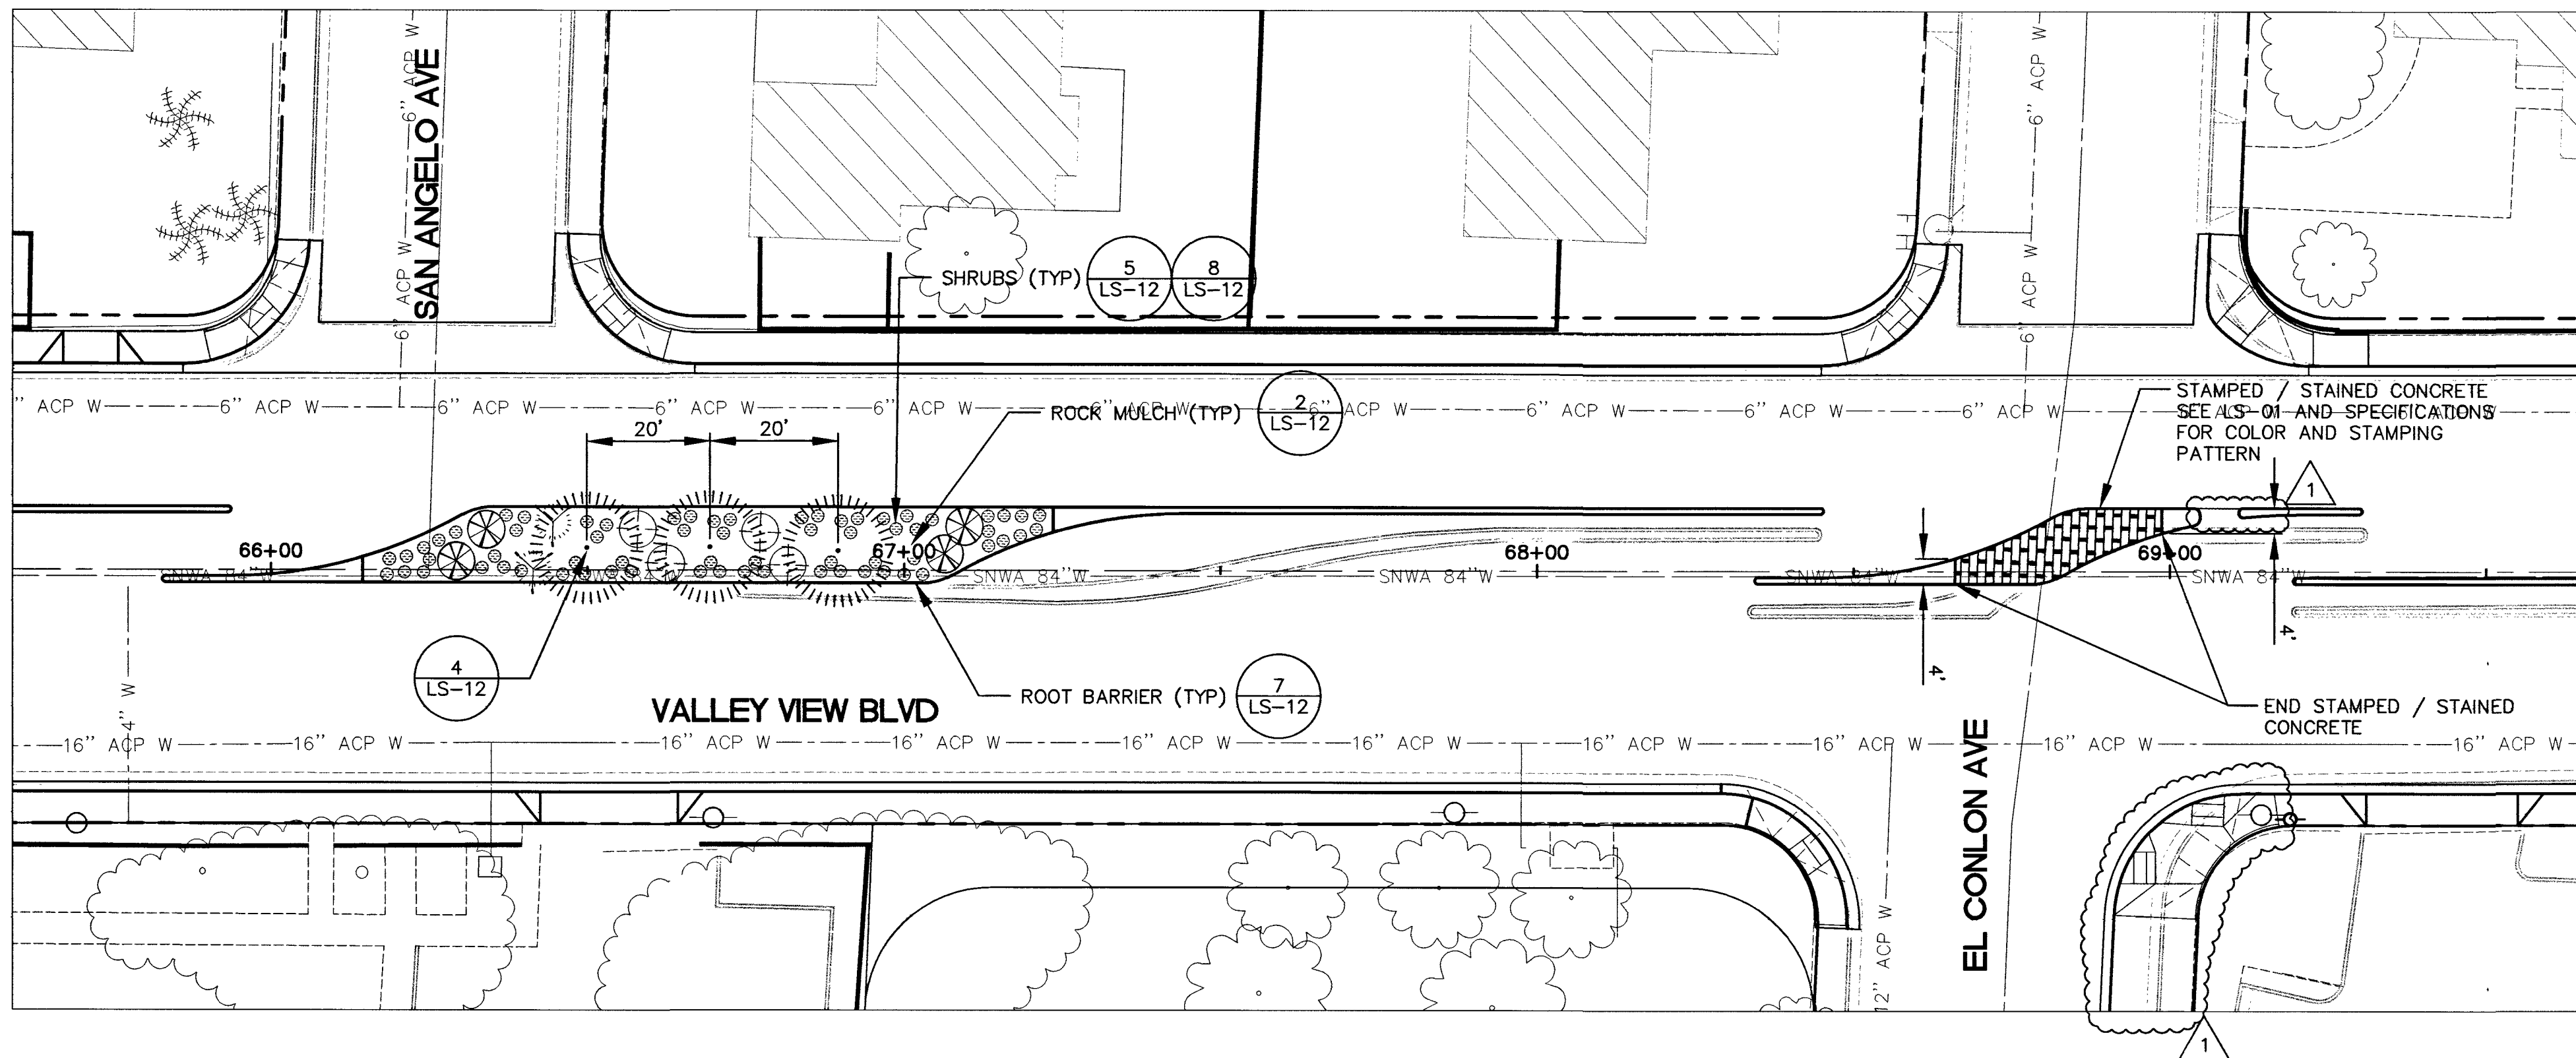

SNWA NOTES

ALL REPAIRS, REPLACEMENTS, RELOCATIONS AND/OR EXTENSIONS MUST BE DESIGNED AND MONITORED BY A NACE INTERNATIONAL-CERTIFIED CATHODIC PROTECTION SPECIALIST. ALL TESTING AND WORK IS TO BE DONE BY A NACE LEVEL II CATHODIC PROTECTION TECHNICIAN AND APPROVED BY THE SNWA CATHODIC PROTECTION TECHNICIAN PRIOR TO ACCEPTING THE INSTALLATION. ALL MATERIAL FOR THE INSTALLATION IS TO BE PROVIDED BY THE CONTRACTOR. CONTRACTOR SHALL SUBMIT ALL CERTIFICATIONS AND MATERIALS TO BE USED ON THE PROJECT FOR THE REVIEW AND ACCEPTANCE BY SNWA PRIOR TO STARTING ANY WORK. SNWA FIBER OPTIC CONDUIT RUNS ALONG THE NORTH/EAST SIDE OF THE SNWA PIPELINE.

CAUTION: SNWA TEST LEADS ARE SHALLOW.

RELOCATION OF EXISTING SNWA TEST STATIONS MUST BE DONE IN ACCORDANCE WITH SNWA STANDARD PLATES FOR CATHODIC PROTECTION.


IF EXPOSED CONTRACTOR TO PAY FOR AND REPLACE SNWA CATHODIC PROTECTION TEST STATION GROUND MATS, MAGNESIUM RIBBONS, OR ZINC RIBBONS WITH NEW GROUND MATS, MAGNESIUM RIBBONS, OR ZINC RIBBONS.

CONTRACTOR SHALL FIELD LOCATE AND PROTECT ALL SNWA/SNWS APPURTENANCES INCLUDING, BUT NOT LIMITED TO AV/AR, ACCESS MANWAYS AND CATHODIC PROTECTION SYSTEMS. ALL ABOVE GROUND STRUCTURES AND AT GRADE STRUCTURES MUST BE ADJUSTED TO NEW GRADE AT CONTRACTOR'S EXPENSE. CATHODIC PROTECTION TEST STATIONS, RECTIFIERS, AND AV/AR'S MUST BE RELOCATED TO THE SIDEWALK PER SNWA STANDARDS AND AT THE CONTRACTOR'S EXPENSE. CONTRACTOR TO NOTIFY SNWA DEVELOPMENT PLAN REVIEW AT (702) 862-3444 AT LEAST 48 HOURS PRIOR TO CONSTRUCTION ACTIVITY.

APPROVED FOR CONSTRUCTION

SOUTHERN NEVADA WATER AUTHORITY DATE
SNWA APPROVAL IS VALID FOR ONE (1) YEAR FROM THE SIGNATURE DATE. IF CONSTRUCTION WITHIN THE EASEMENT OR RESTRICTED PIPE SAFETY ZONE IS NOT COMPLETE, PLANS MUST BE RESUBMITTED TO SNWA FOR APPROVAL.


FAST
Call before you UnderGround.
1-702-432-5300
Call before you Dig
1-702-227-2029
Call 811
1-800-227-2600

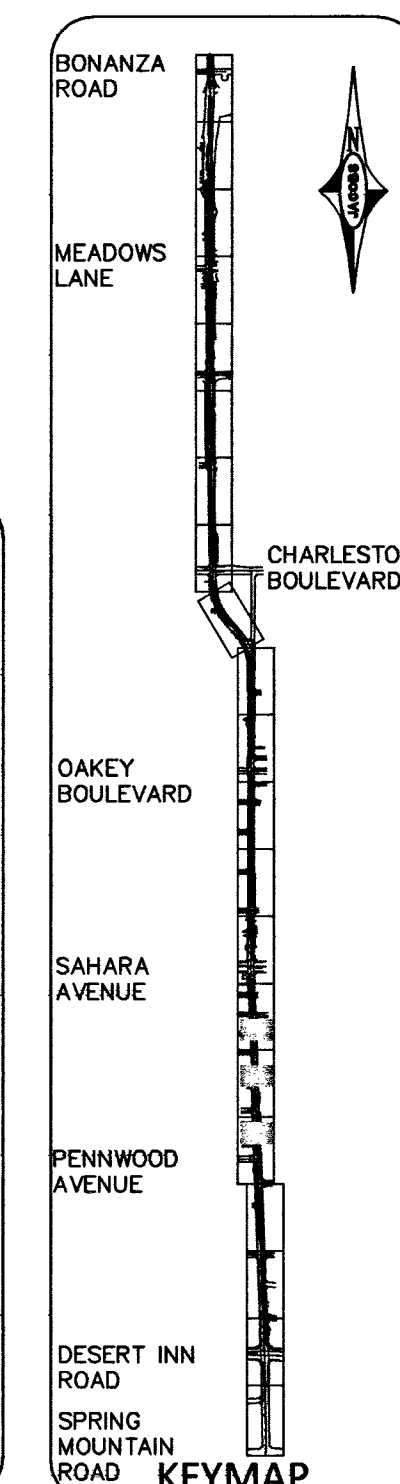

NO.	DATE	SHEET	DESCRIPTION	APP'D
1	3/4/13		ADD EL CONLON CROSSWALK	

DEPARTMENT OF PUBLIC WORKS
CAPITAL PROJECT MANAGEMENT
CITY ENGINEER: DAVID BOWERS, PE, PTOE
PROGRAM MANAGER: JEREMY LEAVITT, PE
DESIGNED BY: H. MILLER
DRAWN BY: H. MILLER
CHECKED BY: J. JENSEN
DATE: 08/12/2011
VALLEY VIEW BLVD - DESERT INN RD TO BONANZA RD

VALLEY VIEW BOULEVARD
DESERT INN RD TO BONANZA RD
PLANTING PLAN
MEDIAN ISLAND PLANTING

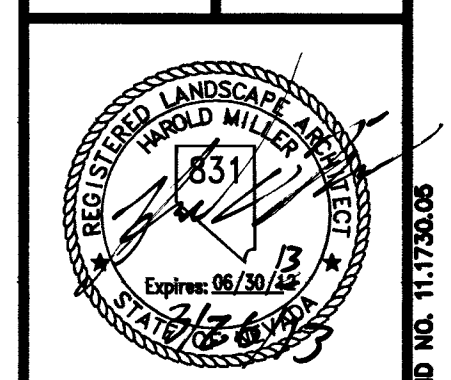

SHEET: **LS-04**
192 of 236
DRAWING NO. 107-V5627