


10-4-18

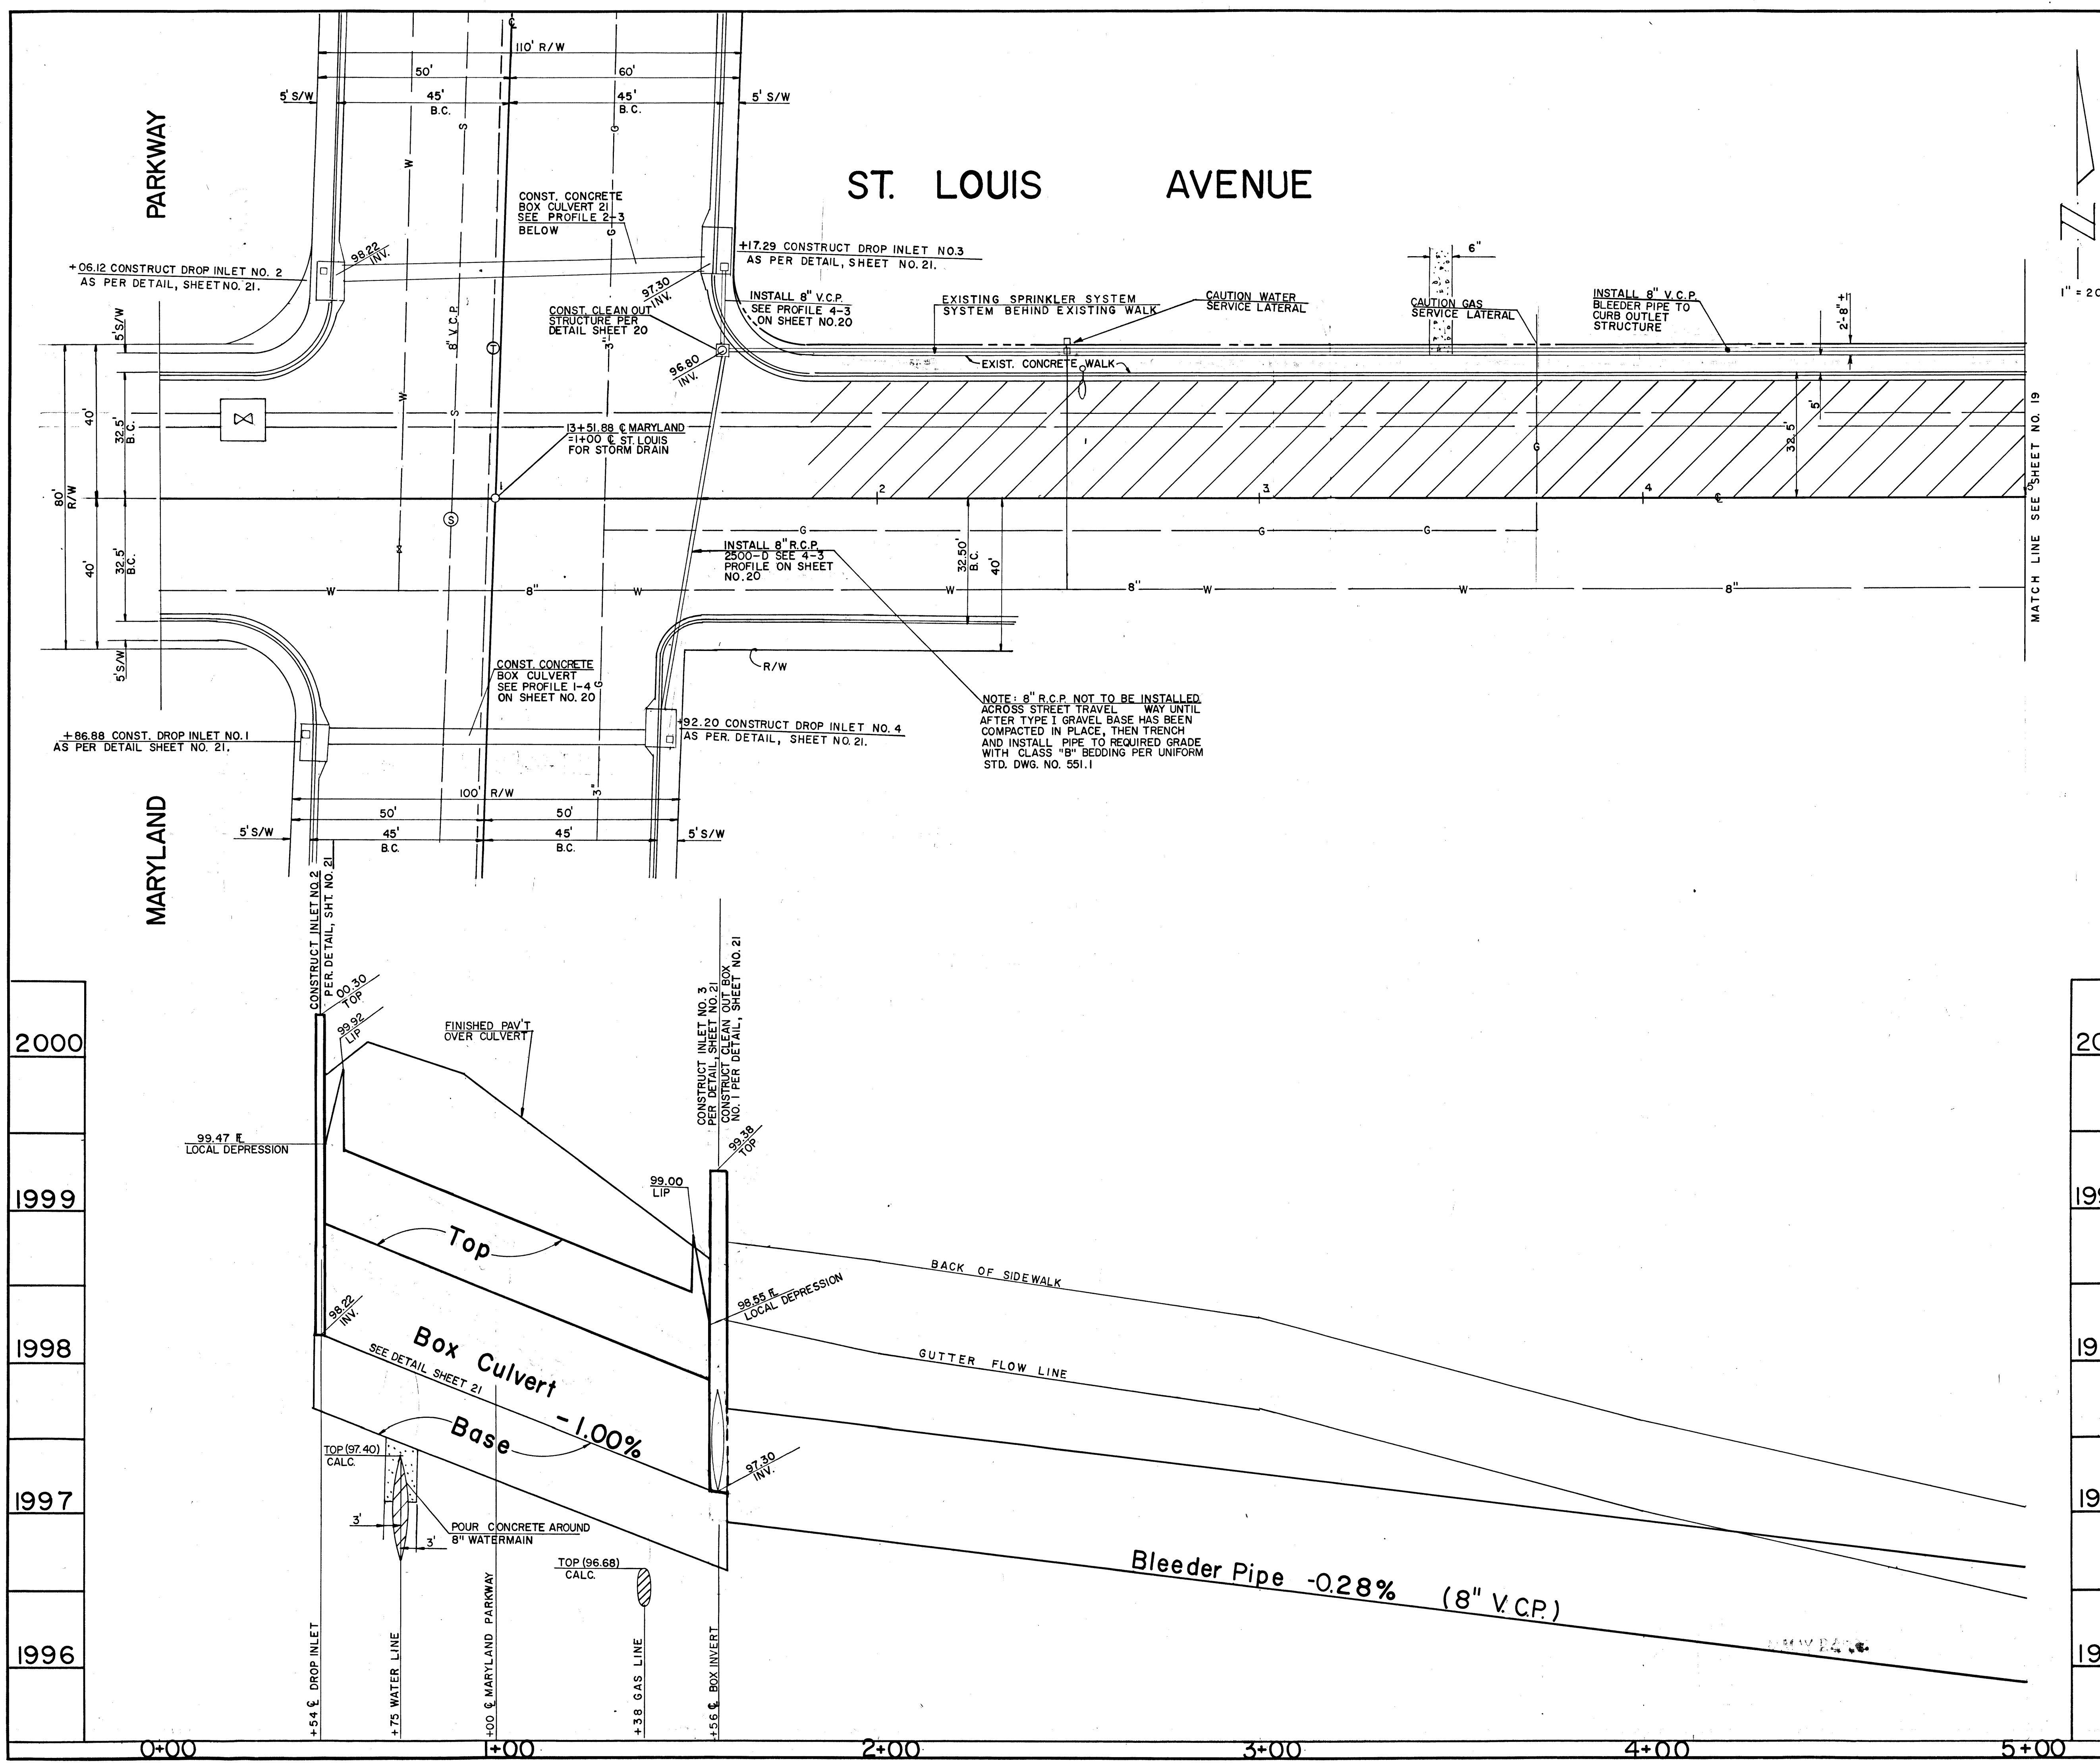

APPROXIMATE QUANTITIES		SHEETS 18 & 19	
ITEM	DESCRIPTION	UNIT	QUANTITY
500.7T	CONSTRUCT DROP INLET W=8'-8"	EA.	4
500.9T	CONSTRUCT CLEANOUT BOX	EA.	1
500.10T	CONSTRUCT OUTLET STRUCTURE	EA.	1
123.20B	INSTALL 8" VITRIFIED CLAY PIPE	L.F.	626
121.20B	INSTALL 8" REINFORCED CONC. PIPE	L.F.	100
500.11T	CONSTRUCT 9" X 48" CONC. BOX CULVERT	L.F.	194
200.11	REMOVE CONCRETE CURB & GUTTER	L.F.	24
200.11	REMOVE CONCRETE SIDEWALK	S.F.	270
340.1	CONSTRUCT CONC. CURB & GUTTER	L.F.	10
340.3	CONSTRUCT NON-ASSESSABLE S.W.	S.F.	200

REVISED QUANTITIES PER REVISION BELOW & ON SHEET NO. 6.			
ITEM	DESCRIPTION	UNIT	QUANTITY
123.20B	INSTALL 8" VITRIFIED CLAY PIPE.	L.F.	636
500.11T	CONSTRUCT 9" X 48" CONC. BOX CULVERT.	L.F.	184

2000
1999
1998
1997
1996

2000
1999
1998
1997
1996

4-26-67

CONTRACT DRAWING
MAY 24 1967

7
5
4
3

Ph. 4/26/67
10/16/67
10/16/67
10/16/67

2
3

Rev. 4-26-67
10/16/67

▽	PIPE LENGTHS, ELEVATIONS & GRADES CHANGED AS REQUIRED BY REVISION ON SHEET NO. 6.	F.T.	7-14-67	CPB
REVISIONS				
1997	REVISION NO.	DESCRIPTION	BY	DATE
CITY OF LAS VEGAS NEVADA DEPARTMENT OF PUBLIC WORKS SERVICES DIVISION				
MARYLAND PARKWAY WIDENING ST. LOUIS AVENUE STORM DRAIN				
1996	W.O. NO. 752	F.BK. NO. 66-5X	DATE	DRAWING NO.
	SC. (H) 1" = 20'	SC. (V) 2" = 1'	4/17/67	107V-731
	DES. E. LOUVIERE			FILE NO.
	DR. LANGE			
	APPROVED BY DIRECTOR OF PUBLIC WORKS			
			4-26-67	SHEET 18 OF 49

