



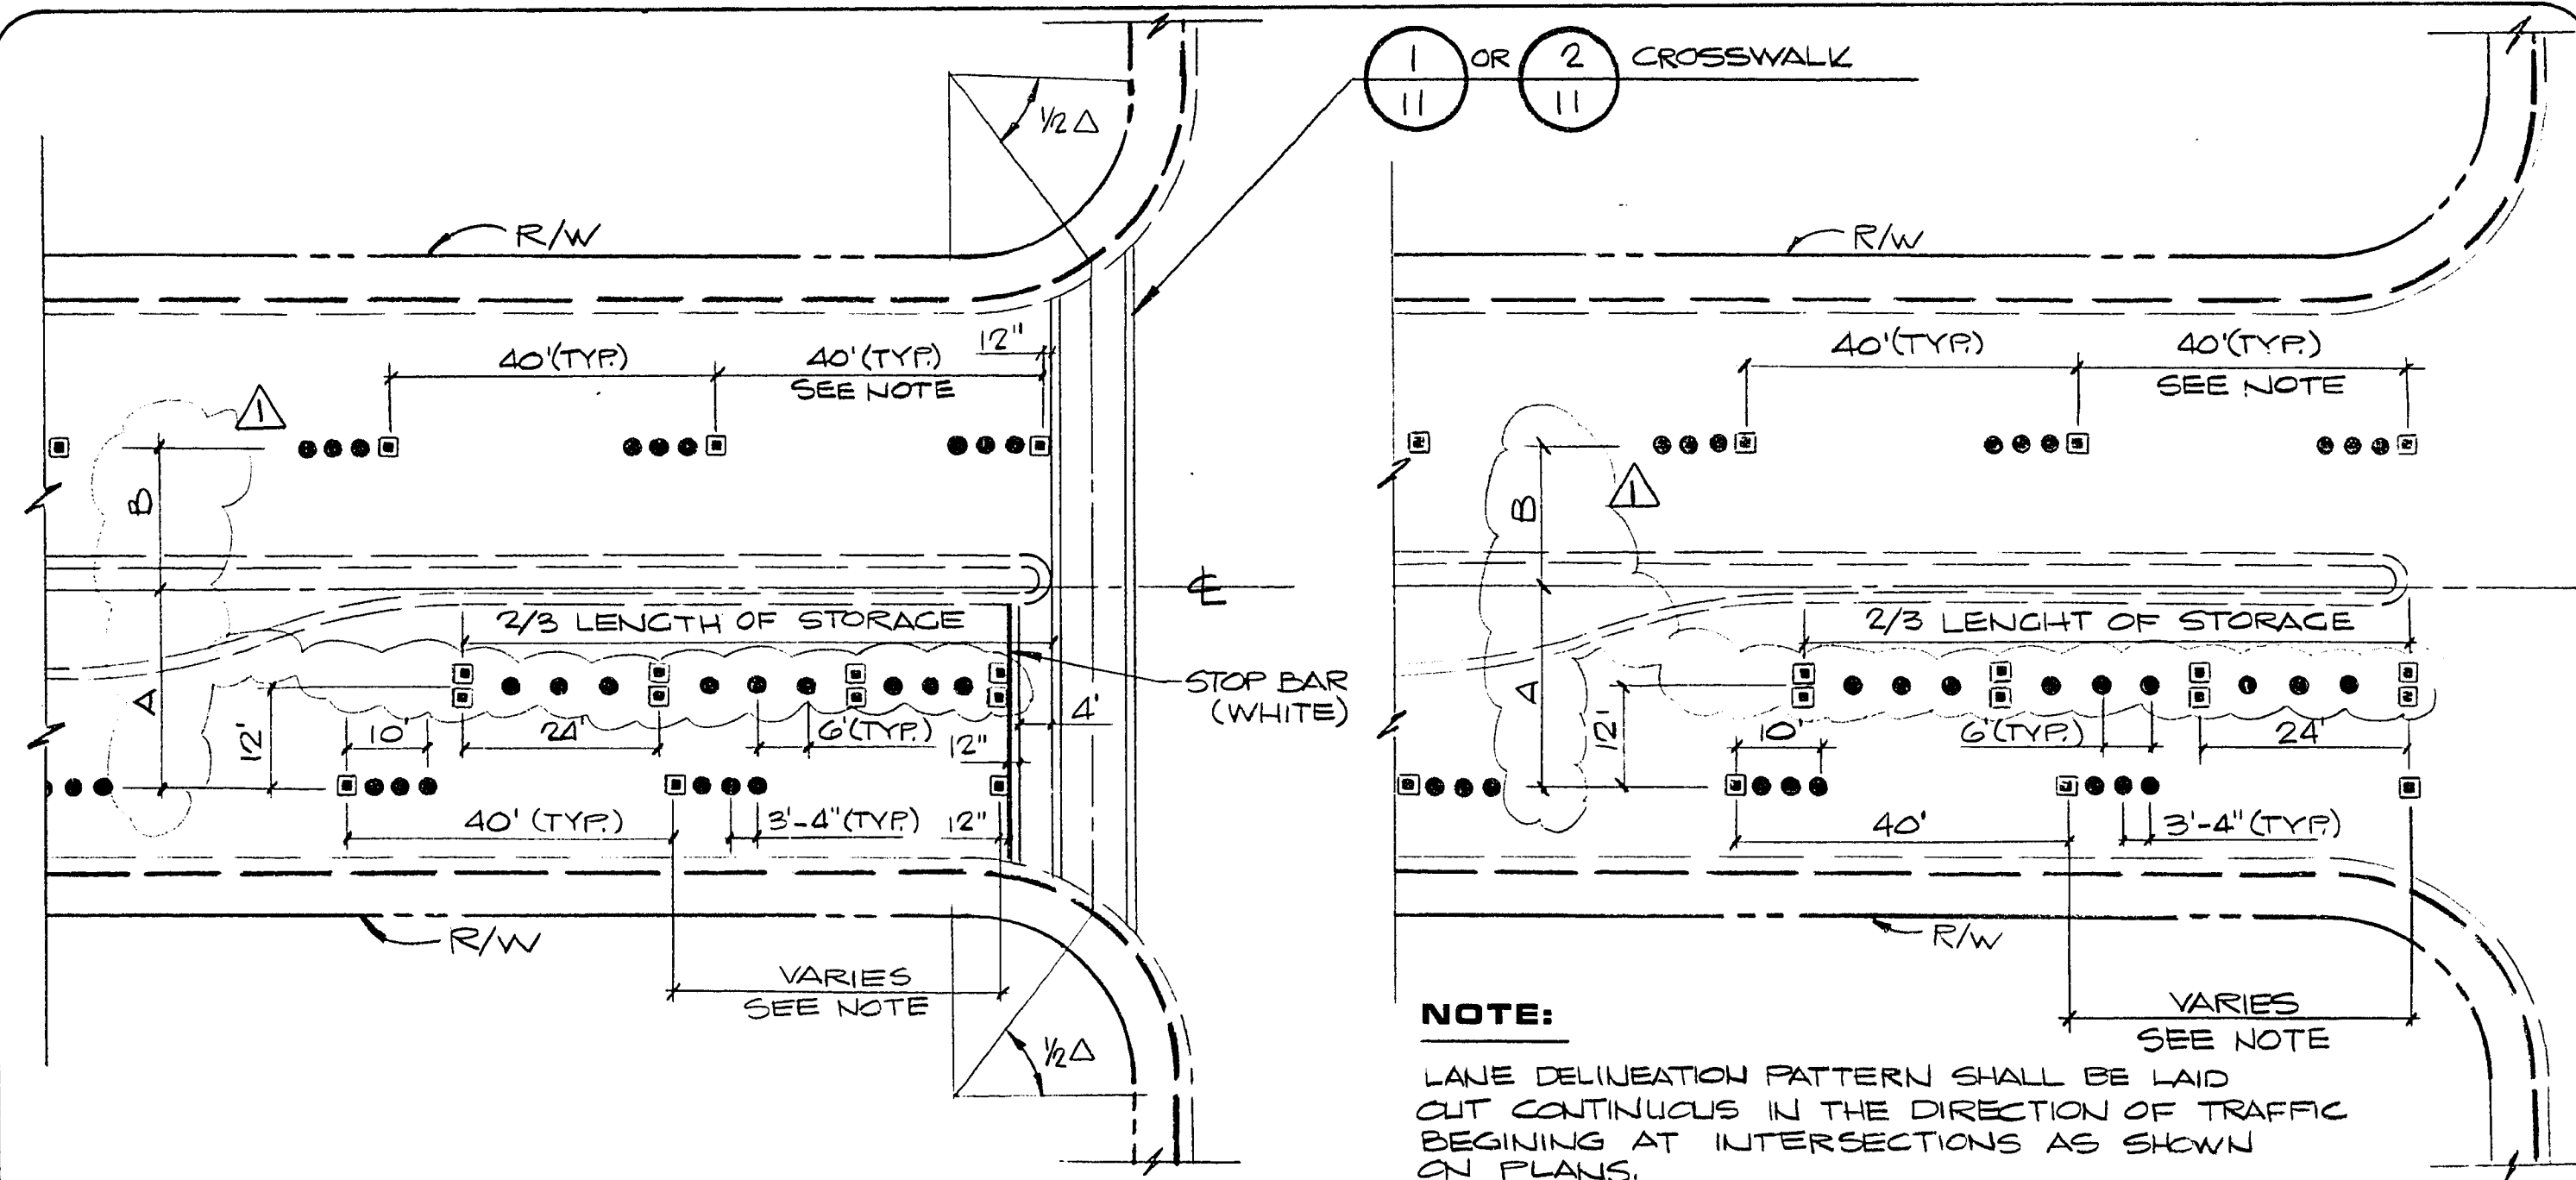

LOCATION	DIMENSION
MARYLAND PKWY	20.5'
BRUCE ST.	24'

AS BUILT DIMENSION SHOWN IN PLAN WHERE LOCATION VARIED FROM STANDARD.

- DELINEATOR SCHEDULE**
- (A) TYPE A • CIRCULAR WHITE CERAMIC MARKER
 - (B) TYPE B □ ONE WAY WHITE REFLECTOR, WHITE TOWARD ONCOMING TRAFFIC
 - (C) TYPE C ■ TWO WAY WHITE AND RED REFLECTOR, WHITE TOWARD ONCOMING TRAFFIC

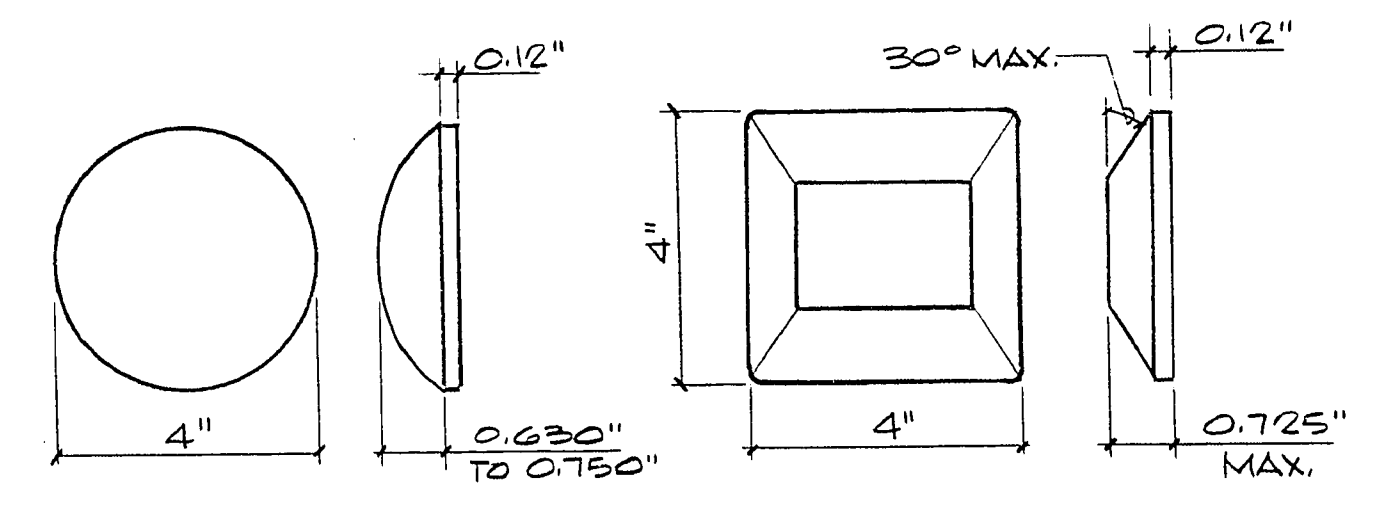

DELINEATOR LOCATION DETAIL

